
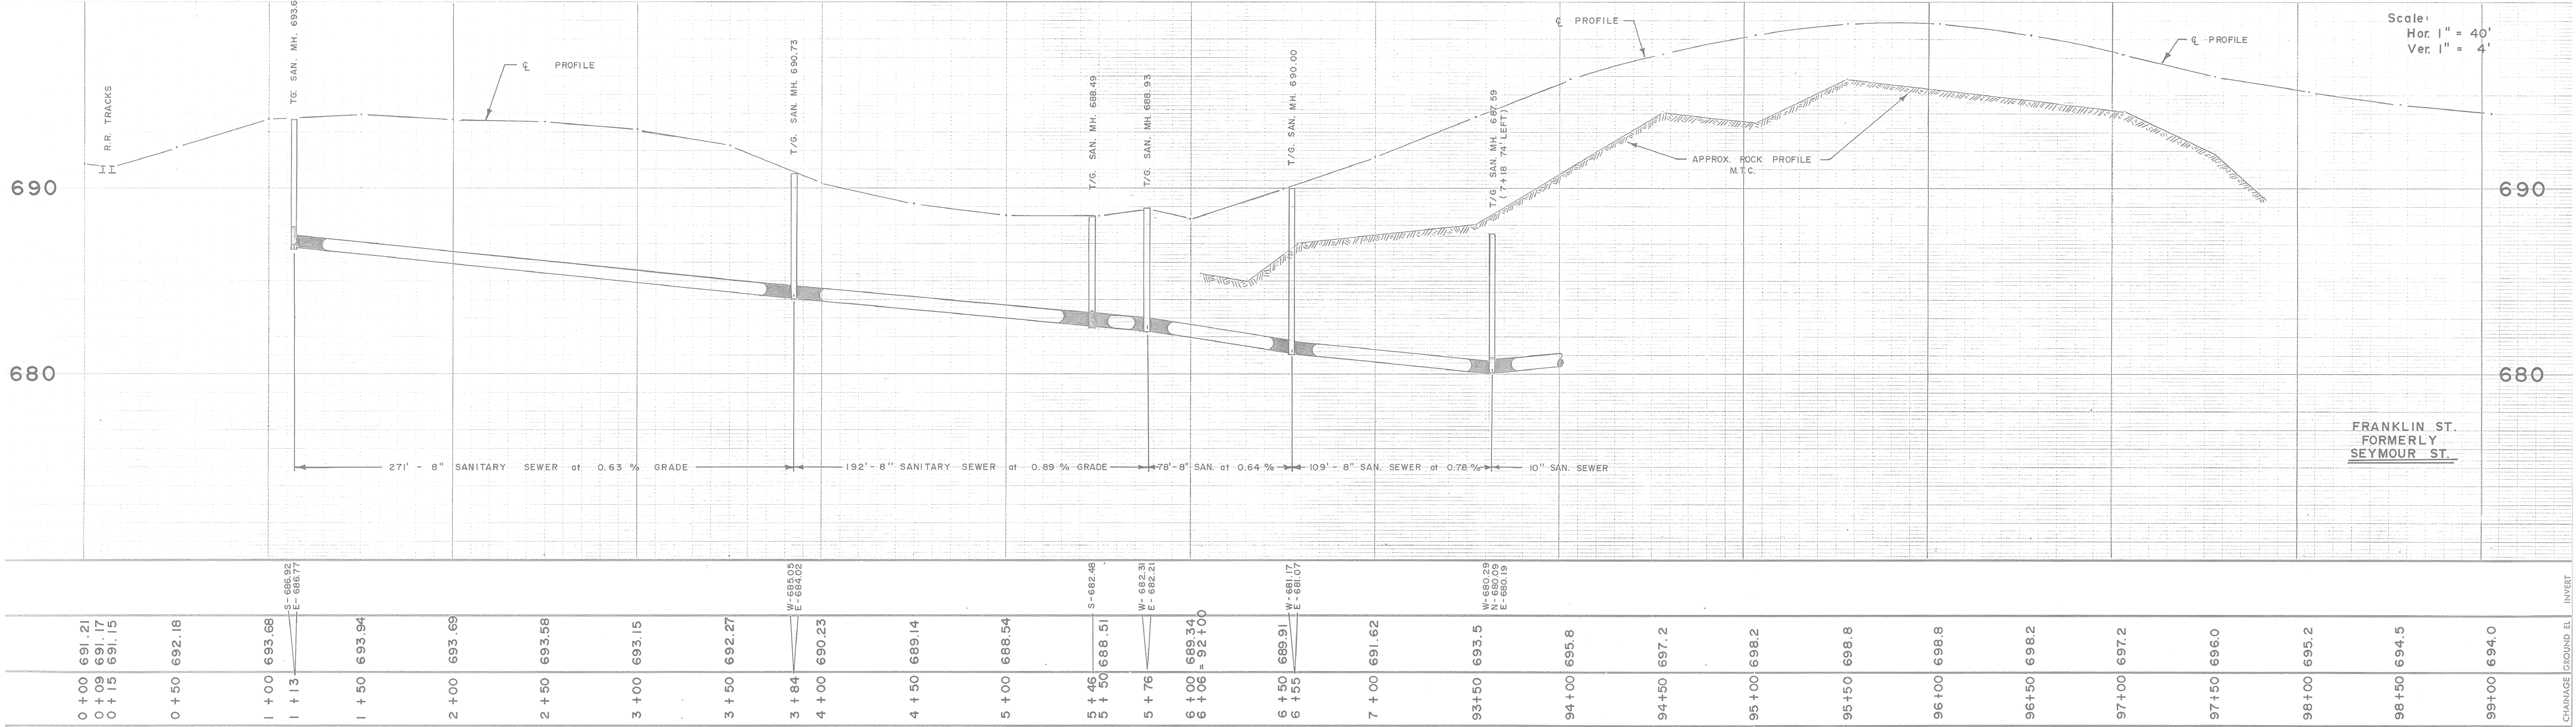


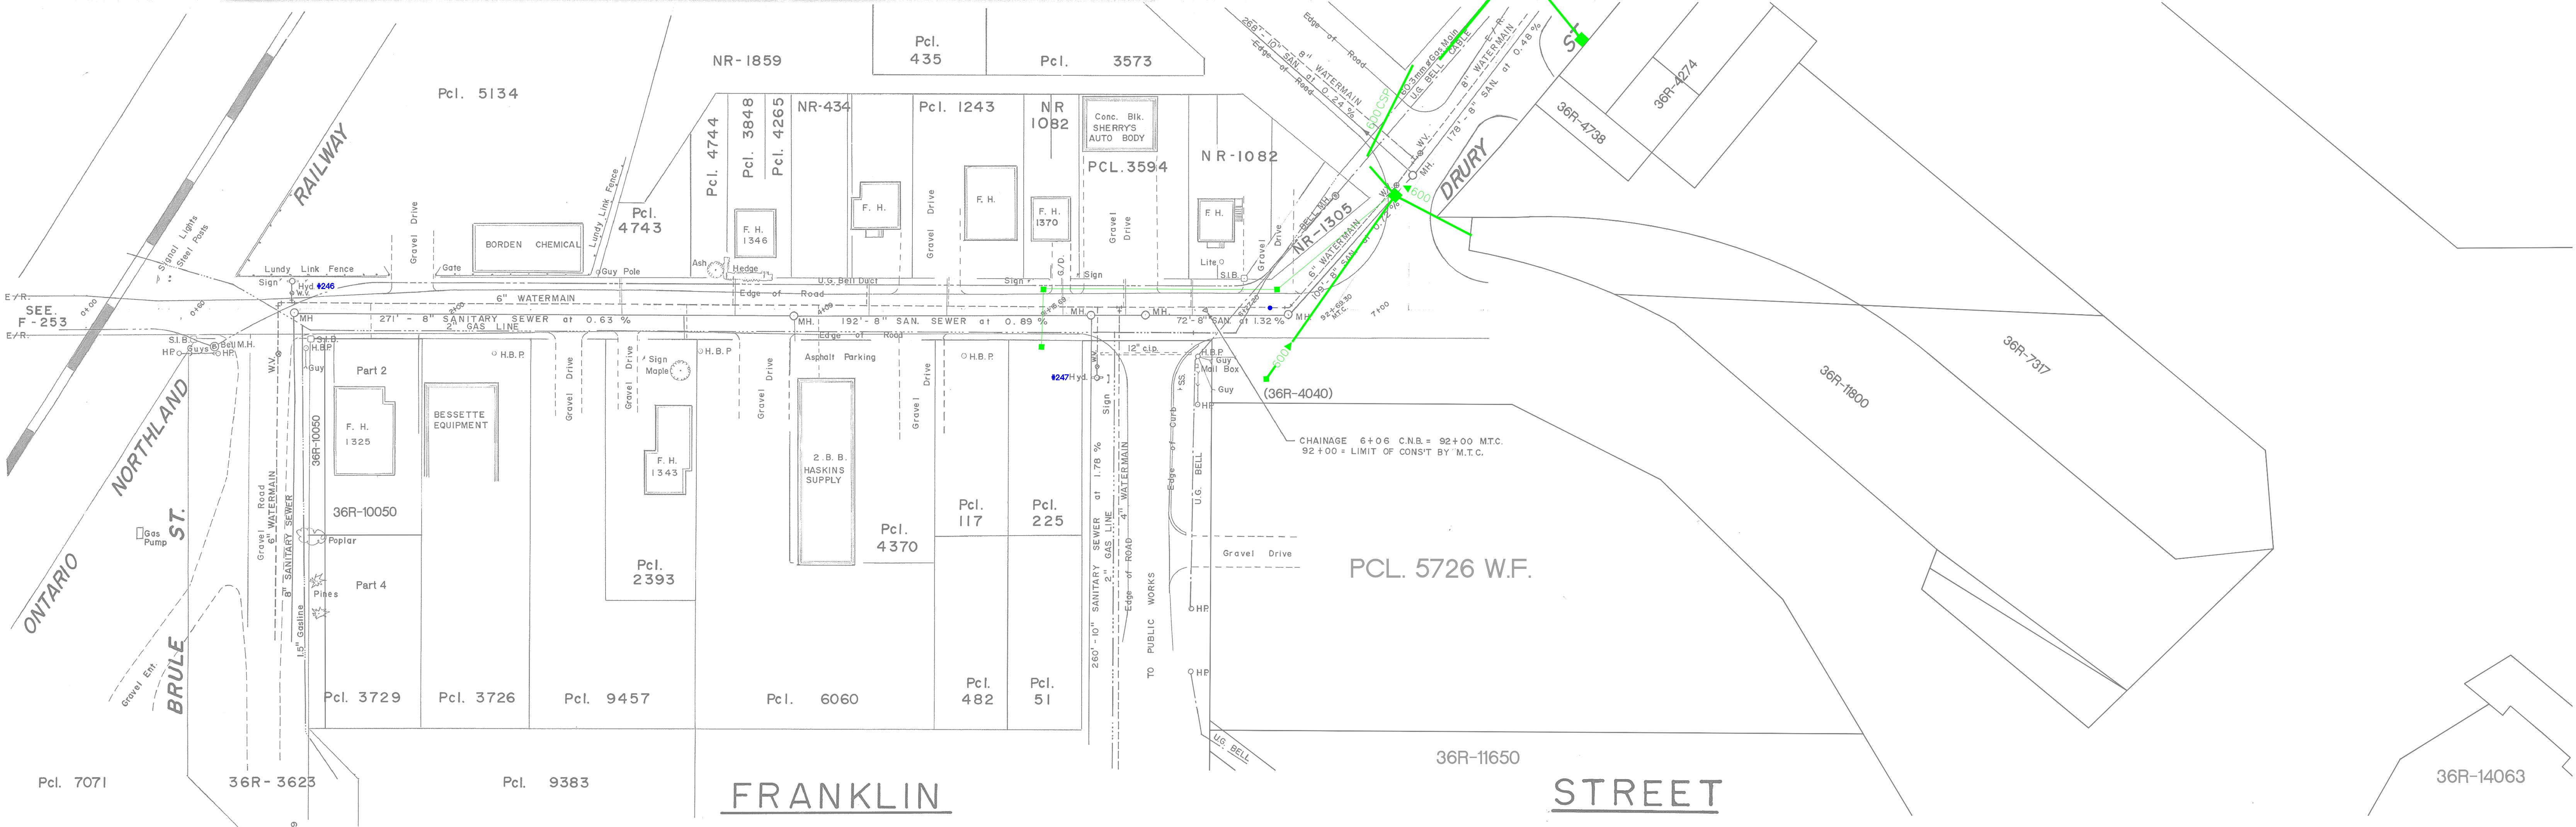

NOTES:

DISCLAIMER

The information contained on this drawing may be based upon data provided by others and may not have been verified by either as-constructed drawings or an Ontario Land Surveyor. The City of North Bay cannot accept responsibility for any errors or omissions on any information shown herein. Field verification, land surveys or excavation (with City approvals) may be required to determine actual location of any and all utilities or property lines.

1.

NEW DRAWING

FEB. 79

J. d. m.

2.

REVISE DETAIL AT BRULE ST.

JUNE 83

J.S.

3.

ADD 6" WATERMAIN AT BRULE ST.

OCT. 85

J.S.

4.

Registered plans added.

OCT. 07

r.j.o.

5.

Registered plans added.

MAY 17

M.R.

No.

REVISION

DATE

INITIAL

APPROVED

FRANKLIN STREET

BRULE STREET TO BYPASS at SEYMOUR ST.

REG'D PLAN N^a 36R-4040, 36R-3623

NR-1305

CITY OF NORTH BAY

ENGINEERING DEPARTMENT

SCALE: 1" = 40'

DATE: FEB. 1979

DRAWN BY: J. d. m.

Ckd. BY:

FIELD BOOK No.

252

DRAWING No.

F - 254

REV.

DATE: FEB. 1979