
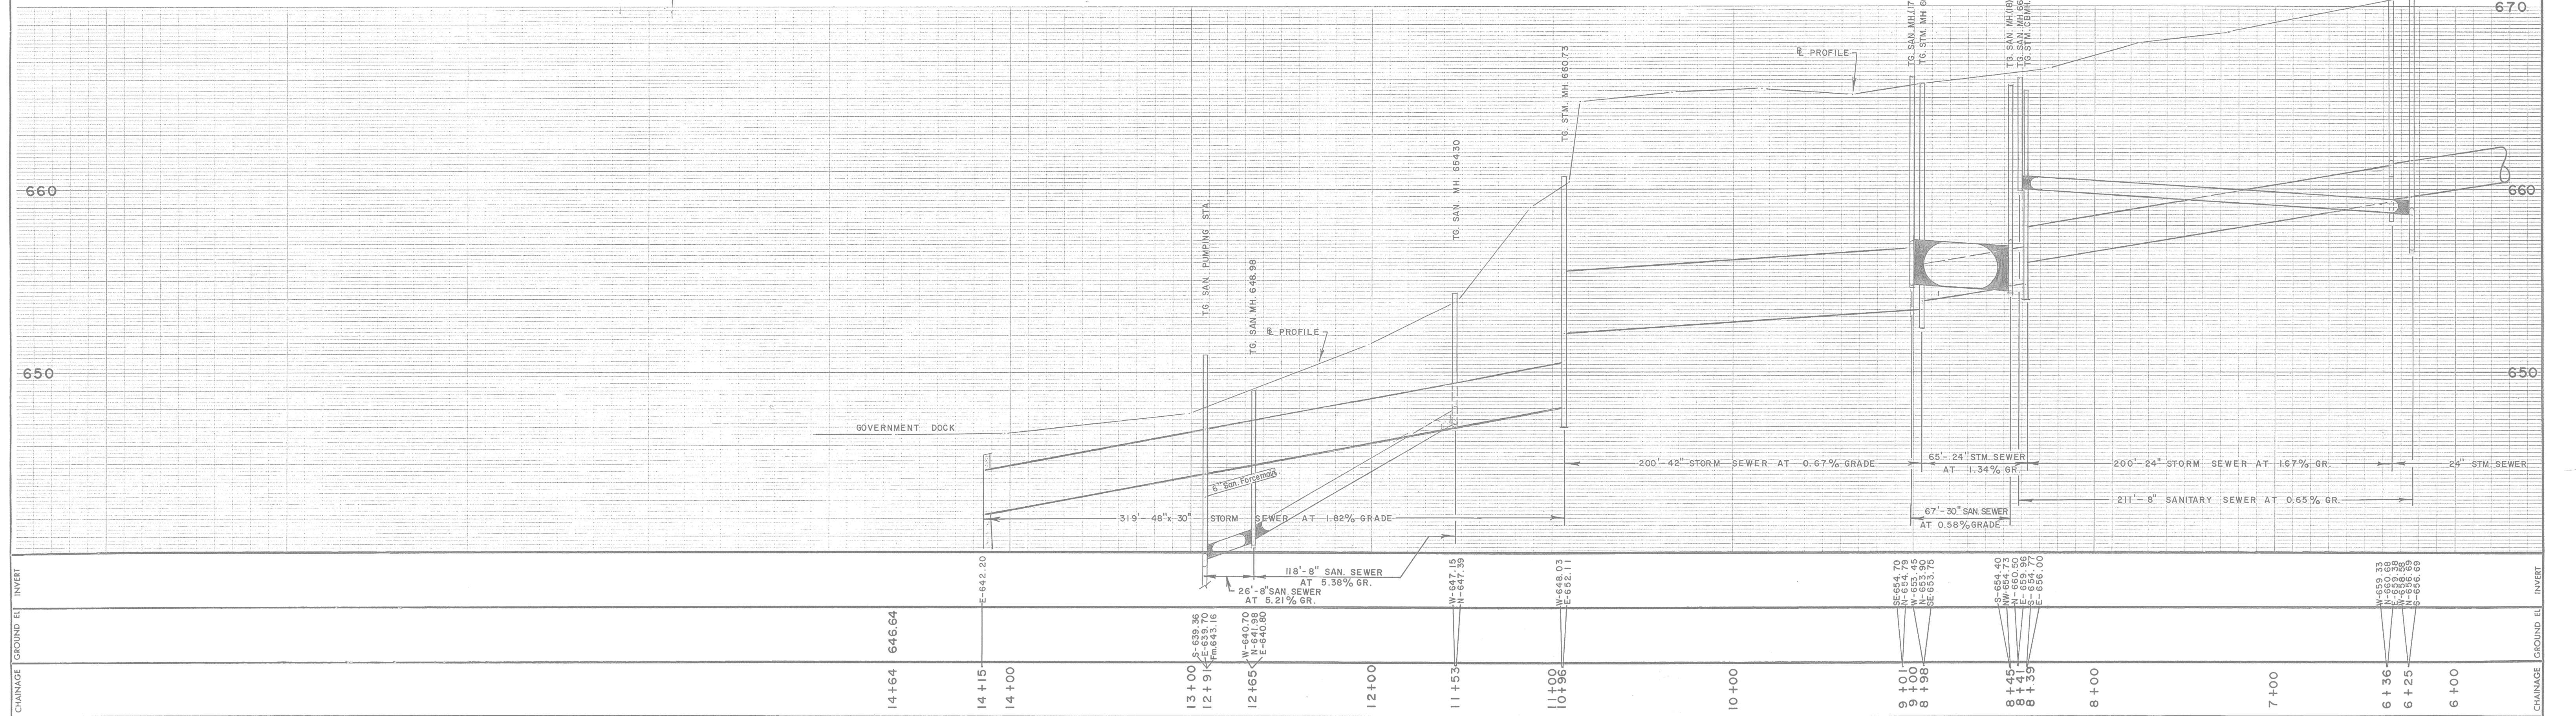


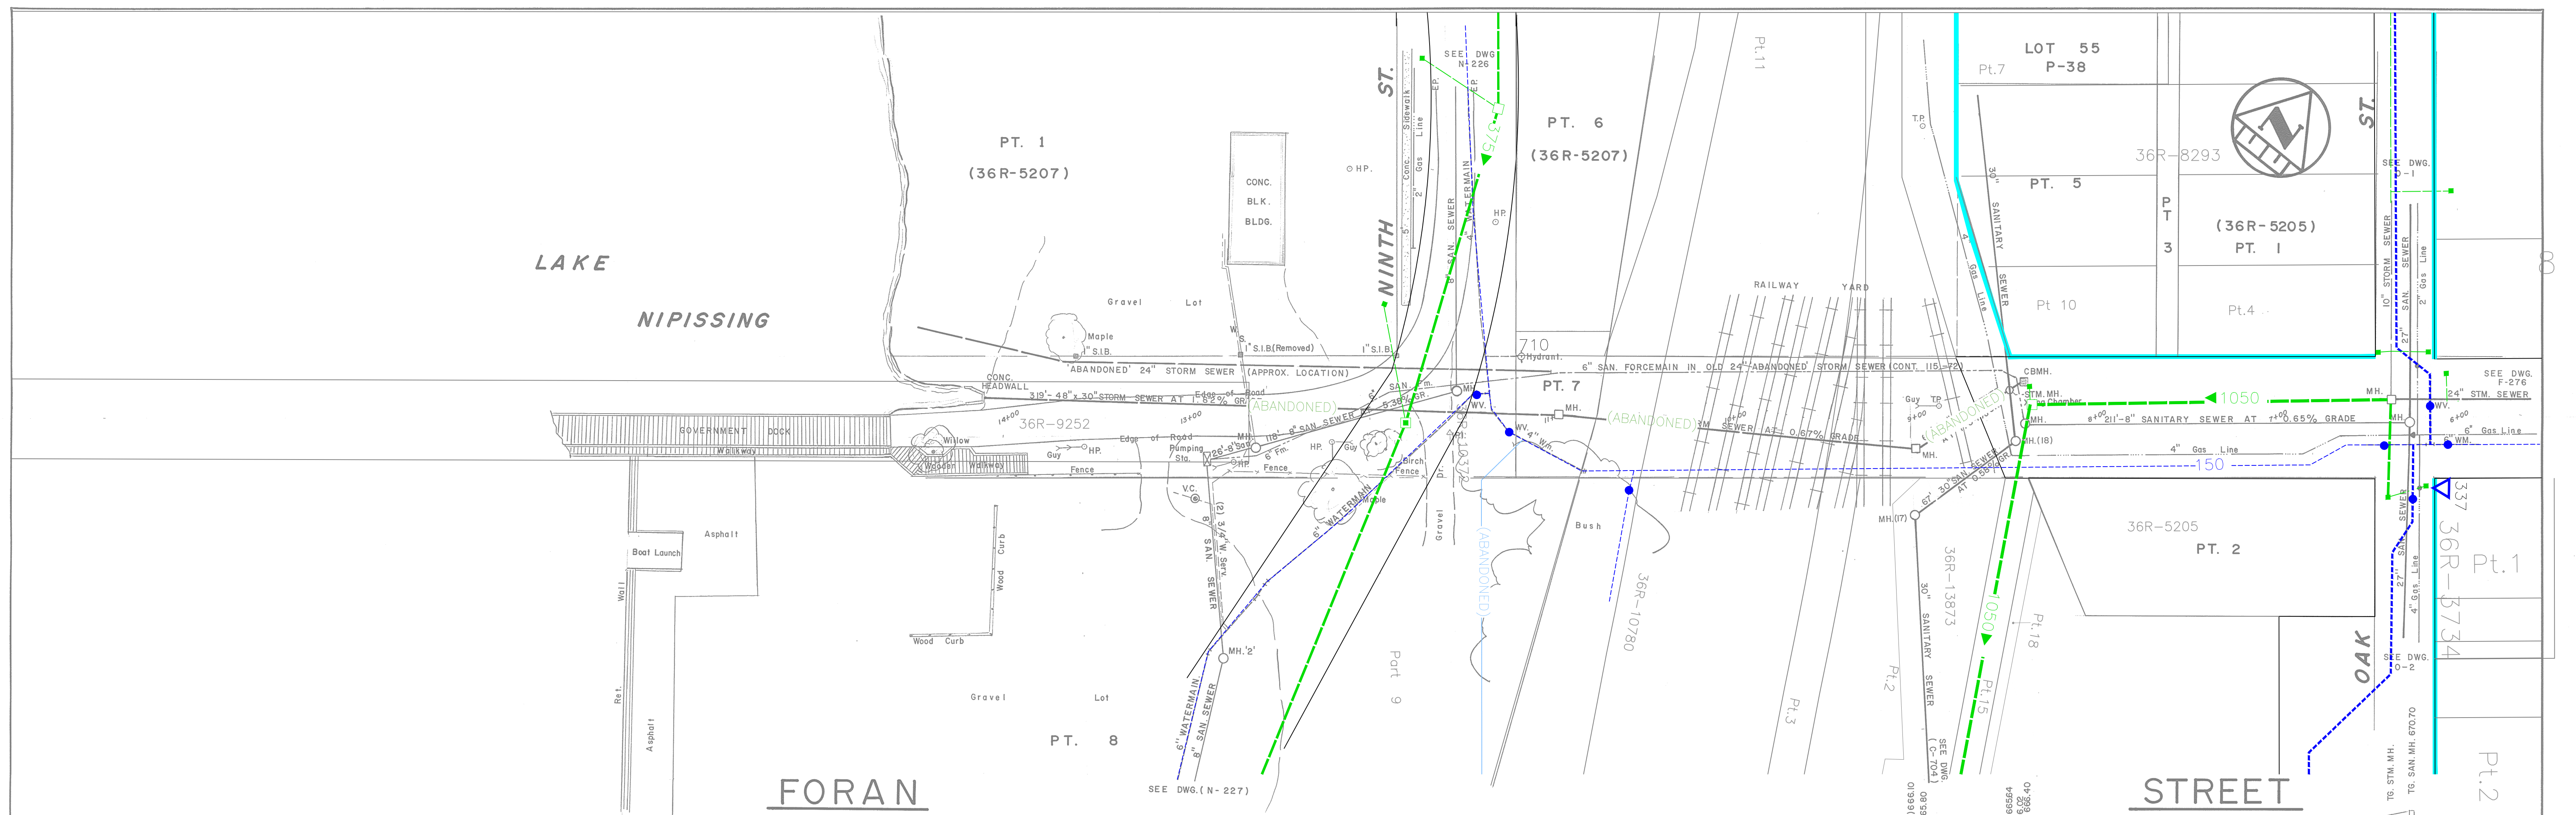

NOTES:

DISCLAIMER

The information contained on this drawing may be based upon data provided by others and may not have been verified by either as-constructed drawings or an Ontario Land Surveyor. The City of North Bay cannot accept responsibility for any errors or omissions on any information shown herein. Field verification, land surveys or excavation (with City approvals) may be required to determine actual location of any and all utilities or property lines.

I.	WATERFRONT AS CONST'D. BK. 276 Con. 101-85	JUN. 85	Rick. B.	APPROVED
No.	REVISION	DATE	INITIAL	

APPROVED

FORAN STREET

OAK	STREET	TO	GOVERNMENT DOCK
-----	--------	----	-----------------

CITY OF NORTH BAY

ENGINEERING DEPARTMENT

SCALE: Hor: 1" = 40'
Ver: 1" = 4'

DATE: OCT. 84.

DRAWN BY: Rick B.
CK'D. BY:

FIELD BOOK No.

DRAWING No.

F-277 REV.

W TRANSLAR 175-7-