
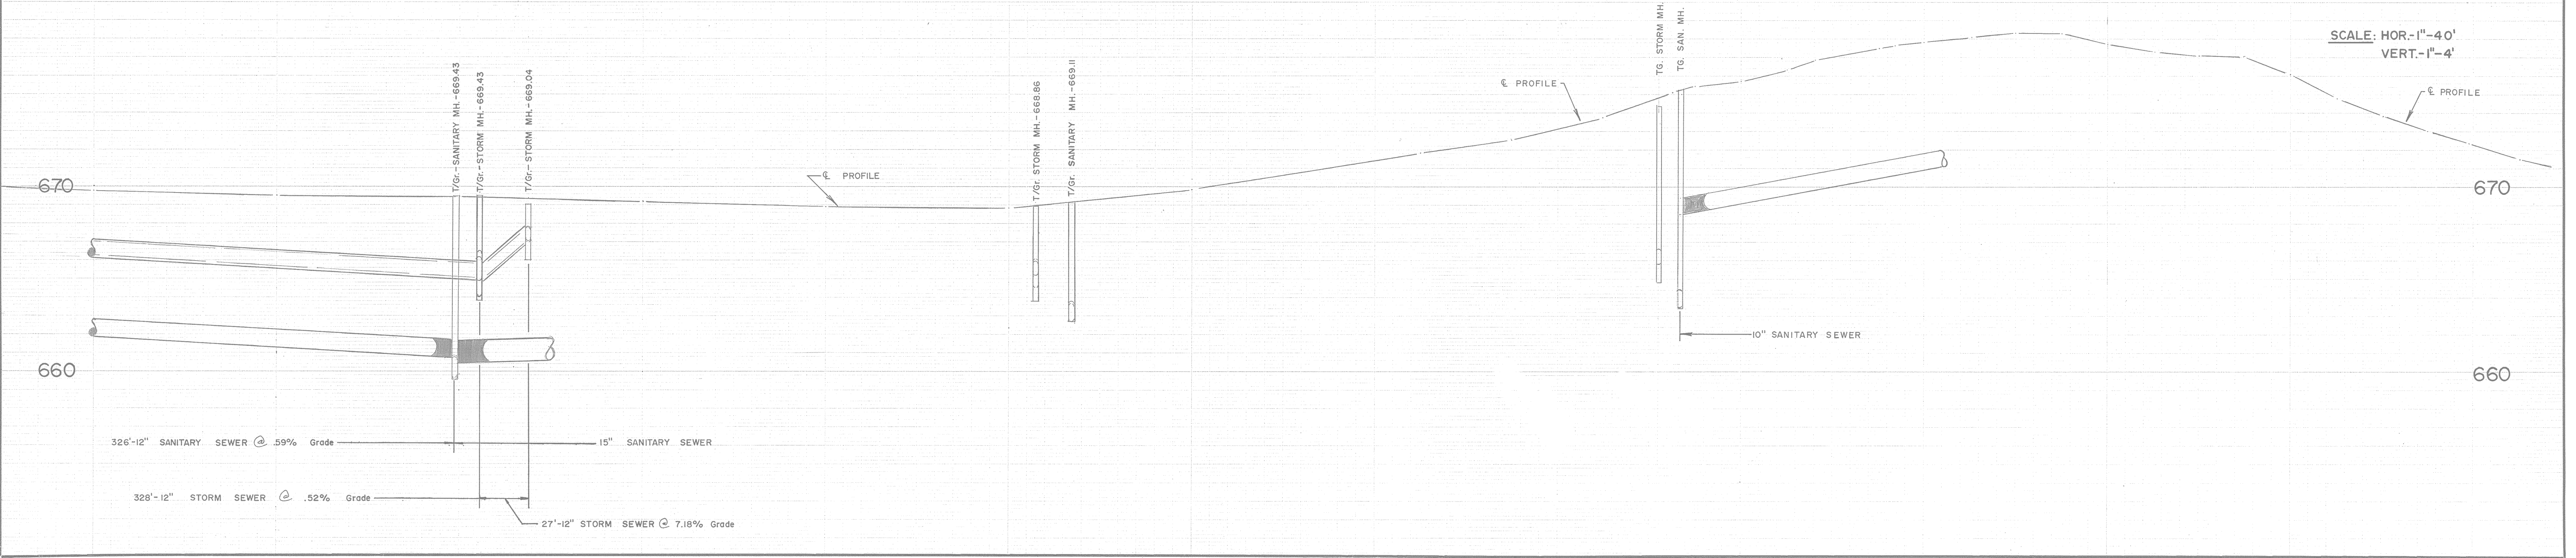


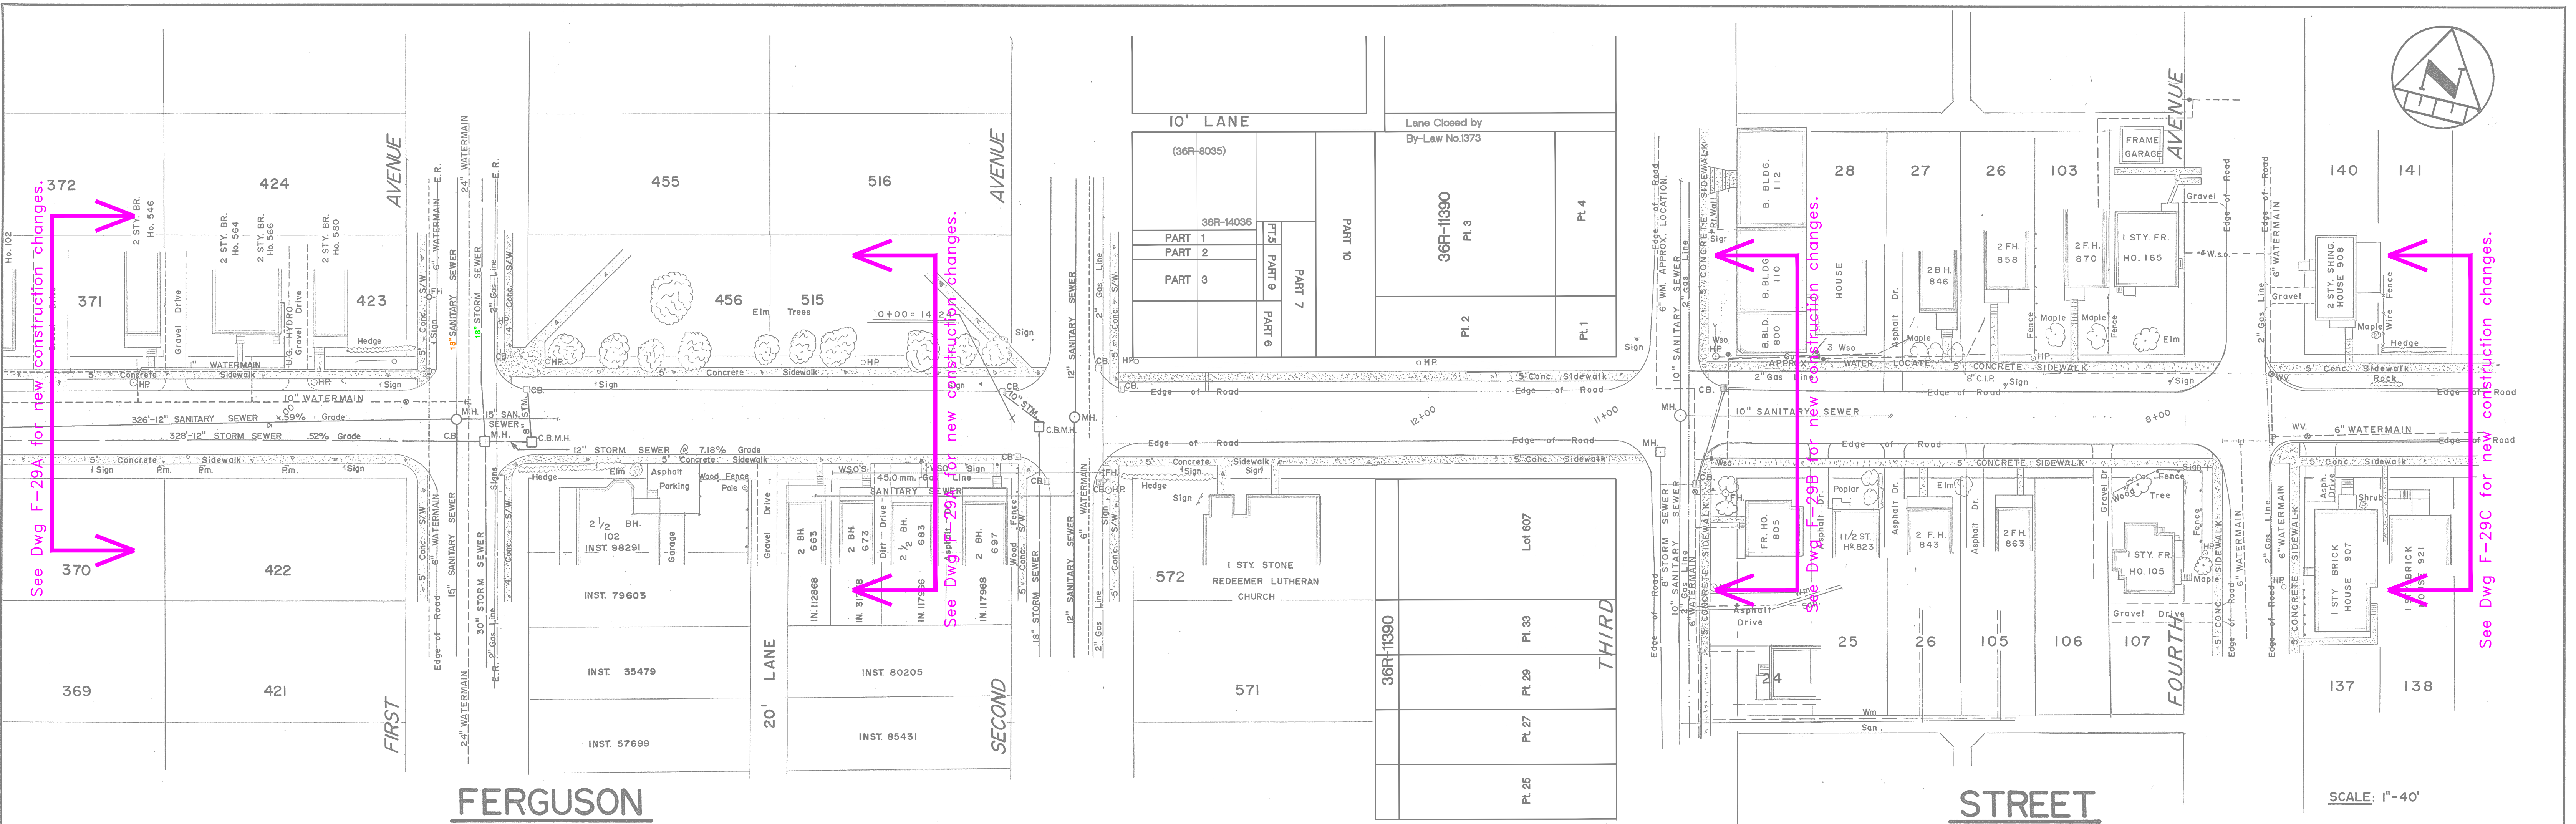

CHAINAGE	GROUND EL	INVERT
5 + 00	669.78	
4 + 00	669.50	
3 + 02		N-669.79 S-669.59 S-669.40
3 + 00	669.44	N-669.43 S-669.23 S-669.01
2 + 89		N-669.79 S-669.59 S-669.40
2 + 62		N-669.79 S-669.59 S-669.40
2 + 00	669.20	
1 + 00	668.89	
0 + 00	668.83	
14 + 24		N-668.85 S-668.65
14 + 09		N-668.73 S-668.53
13 + 90		
13 + 24	669.83	
12 + 00	671.86	
11 + 50	672.55	
11 + 00	673.79	
10 + 70		S-665.60 N-665.48 S-665.43 S-665.54
10 + 63	675.12	
10 + 58	675.43	
10 + 50		
10 + 25	675.75	
10 + 00	676.36	
9 + 85	676.83	
9 + 50	677.48	
9 + 41	677.65	
9 + 25	677.81	
9 + 00	678.10	
8 + 75	678.33	
8 + 50	678.29	
8 + 25	677.72	
8 + 00	677.28	
7 + 75	677.07	
7 + 50	677.02	
7 + 25	676.09	
7 + 00	674.79	
6 + 75	673.81	
6 + 50	673.04	
6 + 29	672.38	
6 + 00	671.45	

NOTES:

DISCLAIMER

The information contained on this drawing may be based upon data provided by others and may not have been verified by either as-constructed drawings or an Ontario Land Surveyor. The City of North Bay cannot accept responsibility for any errors or omissions on any information shown herein. Field verification, land surveys or excavation (with City approvals) may be required to determine actual location of any and all utilities or property lines.

8.

REVISED WATER LOCATION AT THIRD (More)

OCT. 93

MOR 2017

RICK B. M.R.

CHAINAGE EQUATION

1

NEW DRAWING

AUG. 73

R.J.M.

APPROVED

2

AS CONST'D 10" Wm. (FIRST TO WORTHINGTON)

OCT. 77

A.P.

3

THIRD AVE. TO FOURTH AVE. (DETAIL)

APR. 78

A.P.

4

HYDRO POLE LINE REVISION.

JULY 78

J.D.M.

5

E PROFILE & DETAIL 3rd TO 4th BK 256 1980

FEB. 80

R.F.B.

6

REVISED 6" WATERMAIN @ FOURTH AVE.

FEB. 80

A.P.

7

SAN. SEWER & W.M. LOCATE BY R.W.D. 2nd Av. West

APR. 84

R.F.B.

No.

REVISION

DATE

INITIAL

FERGUSON STREET

WORTHINGTON ST. TO FOURTH AVENUE

REG'D PLAN NO: 10 & 21

CITY OF NORTH BAY

ENGINEERING DEPARTMENT

SCALE: AS SHOWN

DATE: AUG. 73

DRAWN BY: R.J.M.

FIELD BOOK NO. 224

DRAWING NO. F-29

REV.