
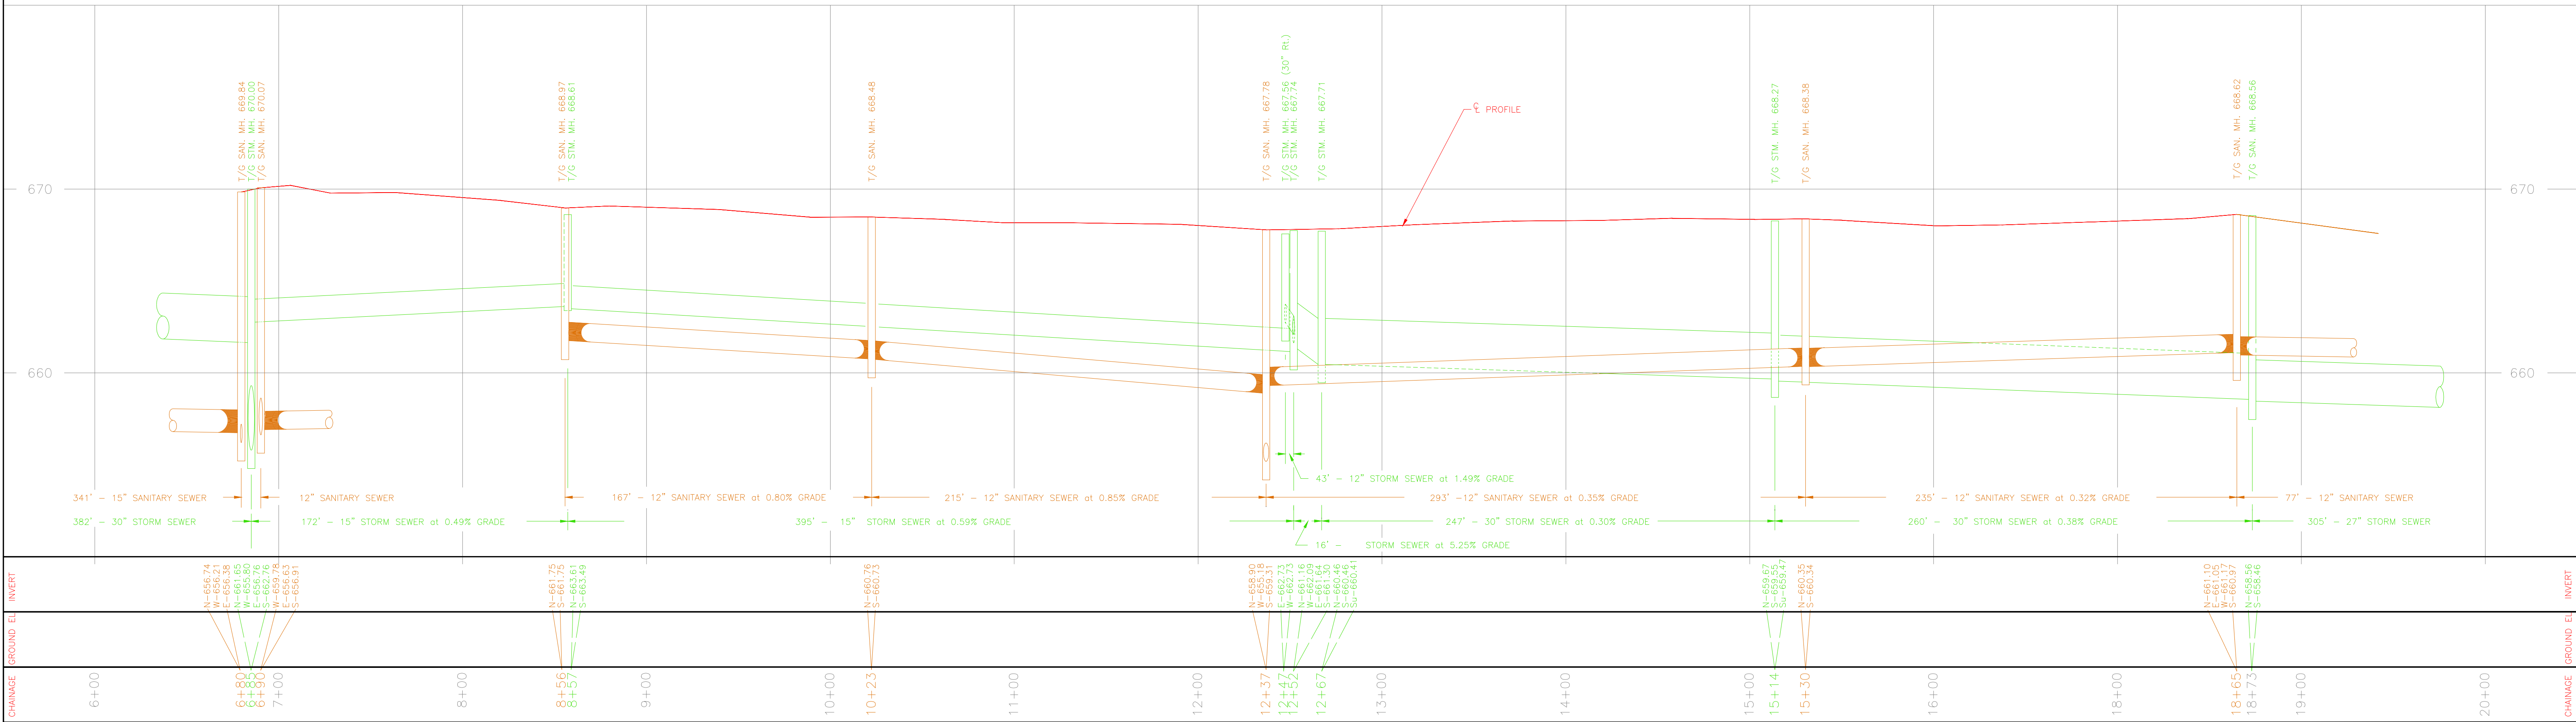


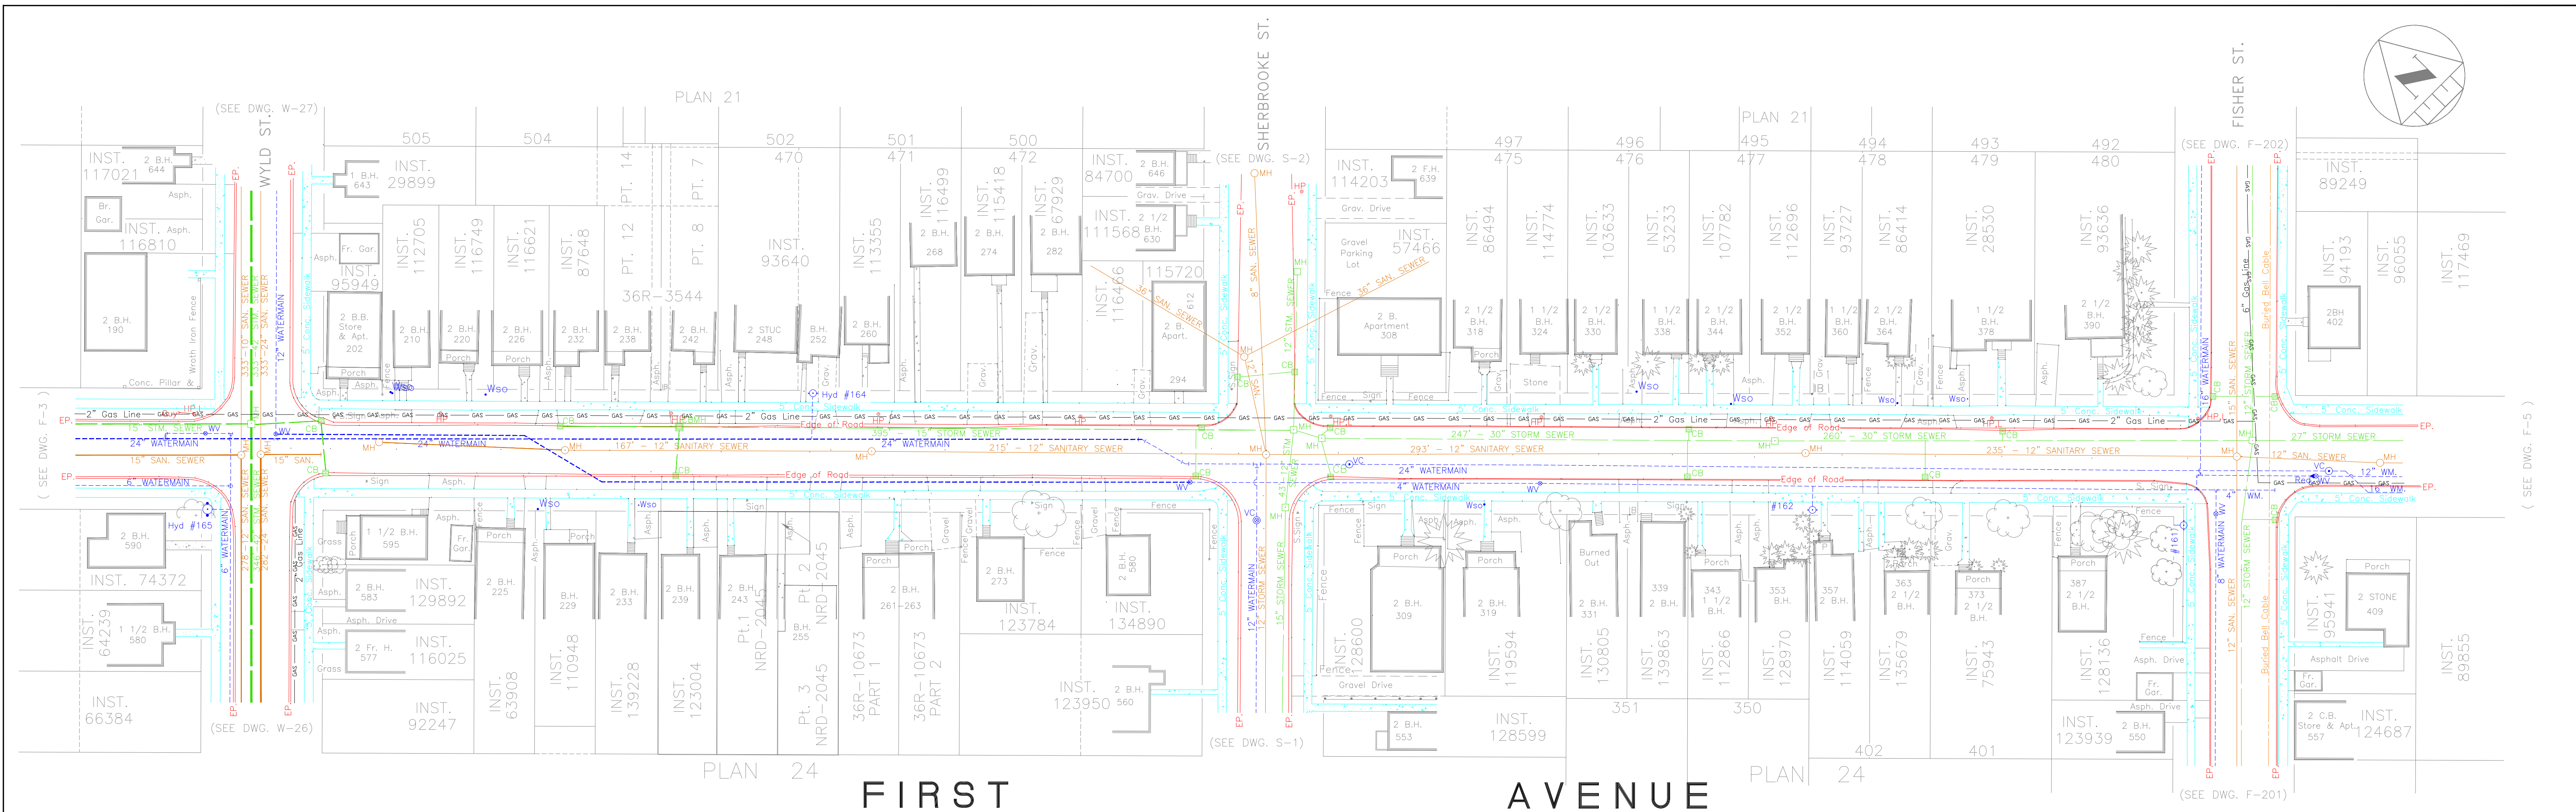

APPROVED :		NOTES:				1 NEW DWG. — NEW DETAIL,ELEVS. & INVERTS NOV. '95 PLC		FIRST AVENUE WYLD ST. TO FISHER ST.		CITY OF NORTH BAY ENGINEERING AND ENVIRONMENTAL SERVICES			
2 Partially updated with as-built info, Replaced by "First Ave As Built 2014.dwg" Sept.'15 JJM		2		2		2							
Disclaimer The information contained on this drawing may be based upon data provided by others and may not have been verified by either as-constructed drawings or an Ontario Land Surveyor. The City of North Bay cannot accept responsibility for any errors or omissions on any information shown herein. Field verification, land surveys or excavation (with City approval) may be required to determine actual location of any and all utilities or property lines.										SCALE: 1" = 40" HOR. 1" = 4" VERT. DATE: NOV. , 1995			
										DRAWN BY: PLC CK'D. BY: RFB		FIELD BOOK No. DRAWING No. F - 4 I:\CAD\PP Drawings\F-4	