
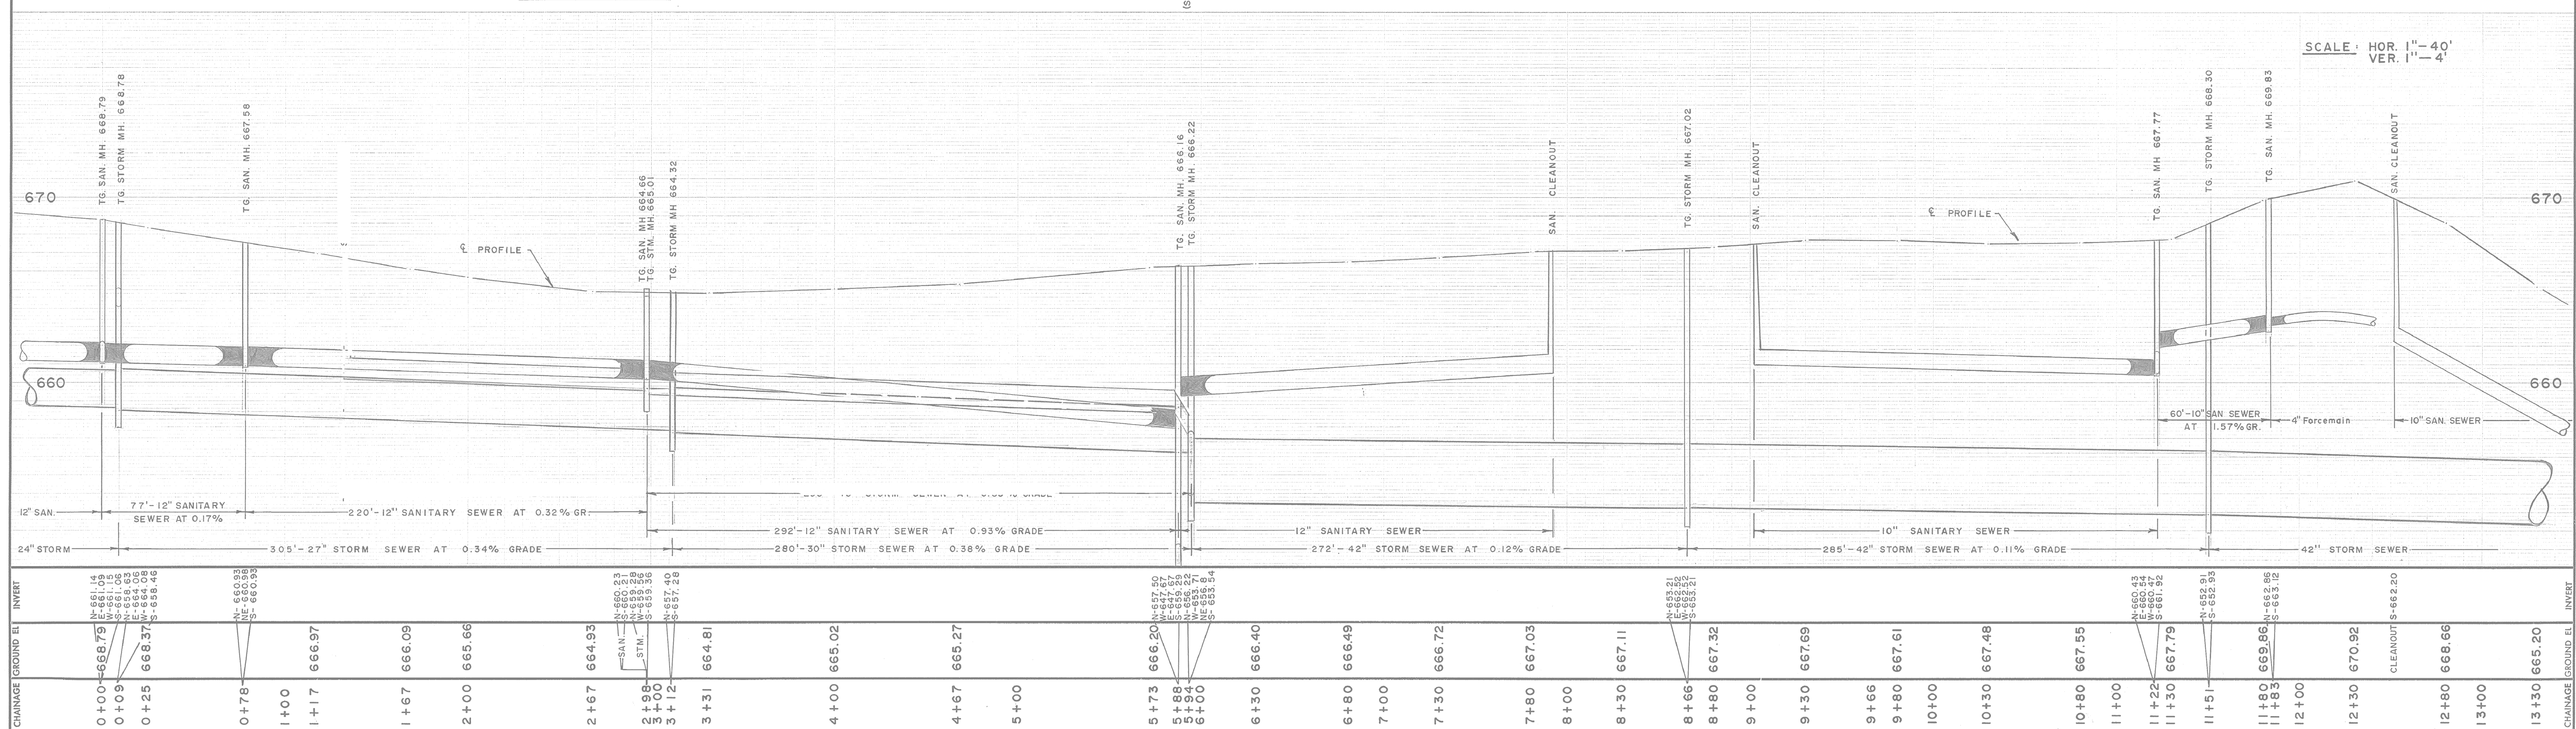


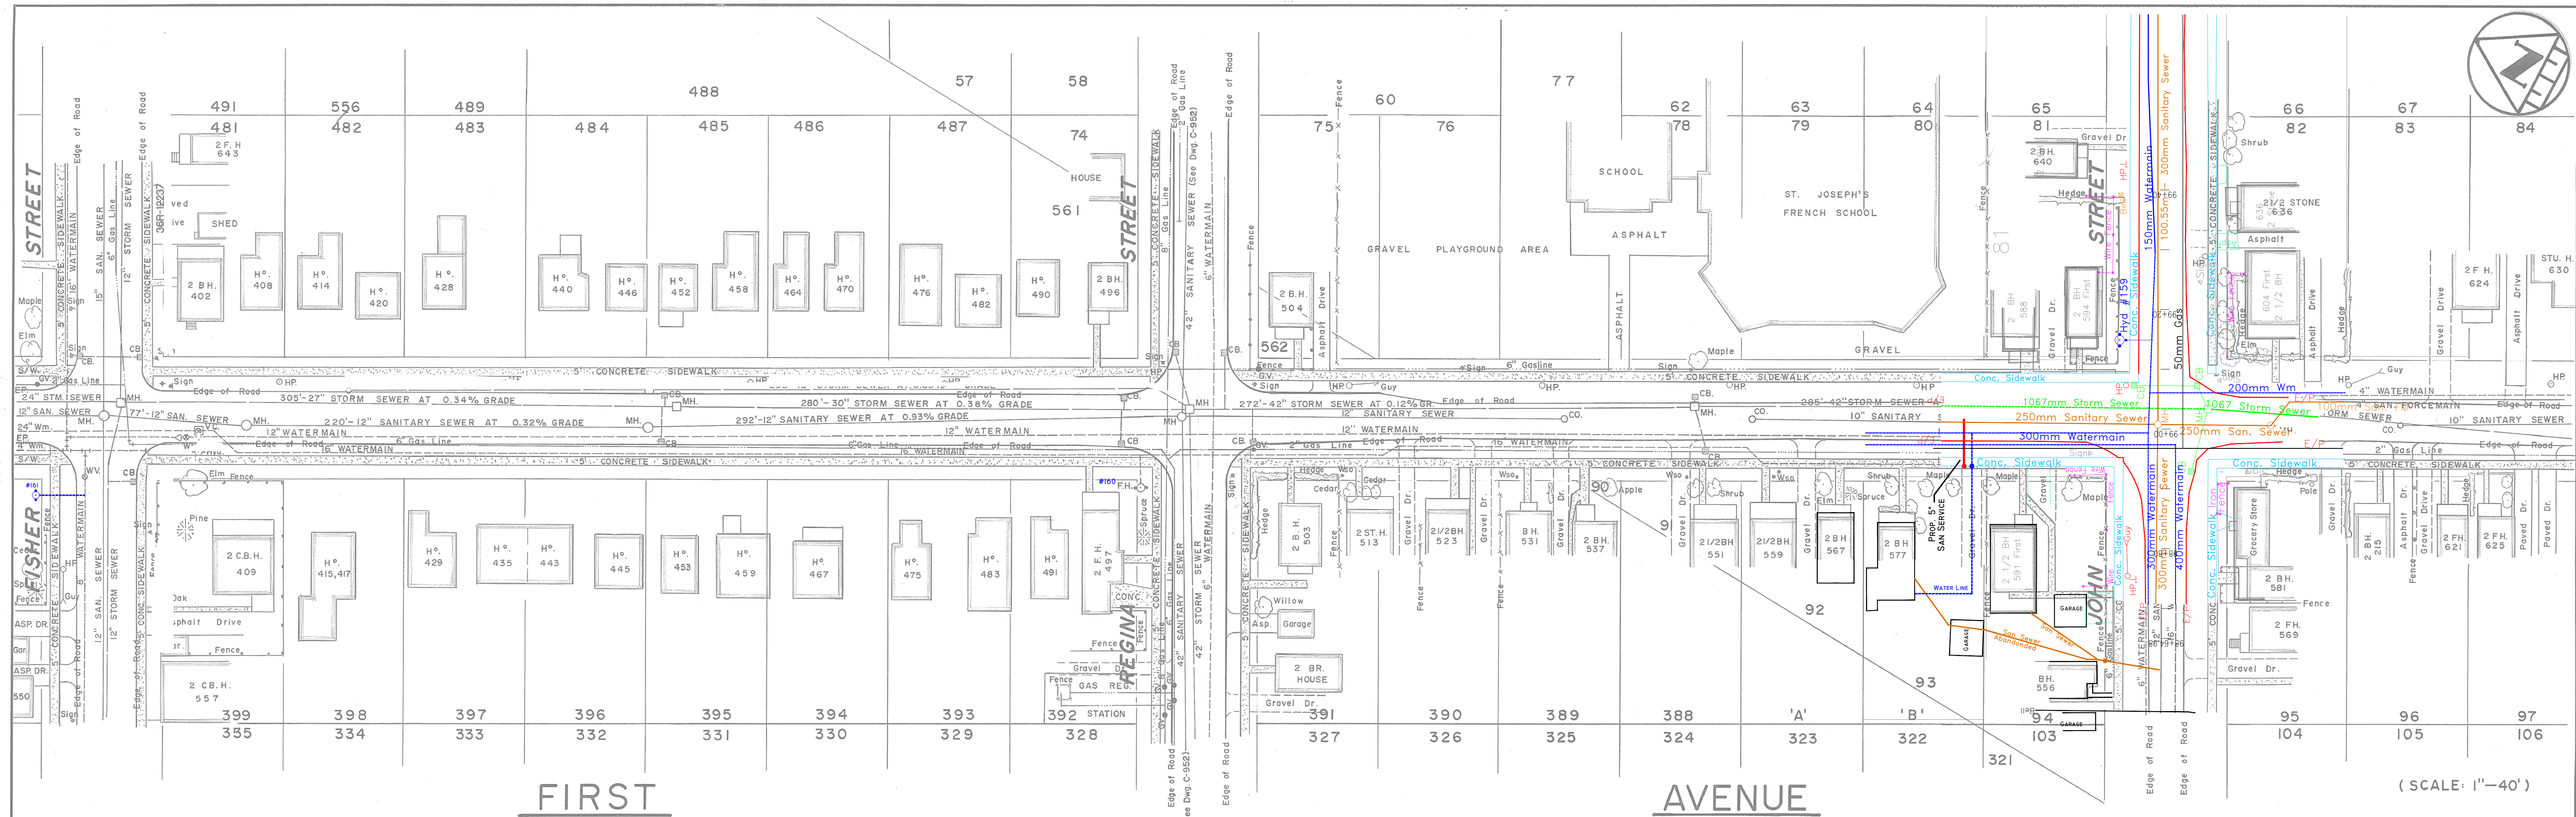

DWG: 140.	NOTES: DISCLAIMER The information contained on this drawing may be based upon data provided by others and may not have been verified by either as-constructed drawings or an Ontario Land Surveyor. The City of North Bay cannot accept responsibility for any errors or omissions on any information shown herein. Field verification, land surveys or excavation (with City approvals) may be required to determine actual location of any and all utilities or property lines.		8	UPDATED STORM BETWEEN FISHER AND REGINA	AUG '15	G.W.C.	1.	NEW DRAWING FROM NORTHLAND ENG. DWG.	AUG 77	R.F.B.	APPROVED
							2.	AS CONST. STORM SEWER, REGINA - JOHN 72	AUG. 77	R.F.B.	
							3.	AS CONST. 16" WATERMAIN 1975	AUG. 77	R.F.B.	
							4.	ADD 6" Gasline - REGINA to JOHN	JUNE 85	J.S.	
							5.	REGISTERED PLAN ADDED.	OCT. 07	R.J.O.	
							6.	SEWER AND WATER LOCATION FOR H0.577 FIRST AVE EAST	SEPT 08	Rick B	
							7.	UPDATED JOHN ST. INTERSECTION	OCT 09	G.W.C.	
			No.	REVISION	DATE	INITIAL	No.	REVISION	DATE	INITIAL	

FIRST AVENUE	
FISHER STREET TO JOHN STREET	
REG'D. PLAN N0. 20,21	

CITY OF NORTH BAY	
ENGINEERING DEPARTMENT	
SCALE: AS SHOWN	DATE: AUG 77.
DRAWN BY: Rick B.	FIELD BOOK No.
C.D. BY:	210, 221, 247,
F - 5	
REV.	