


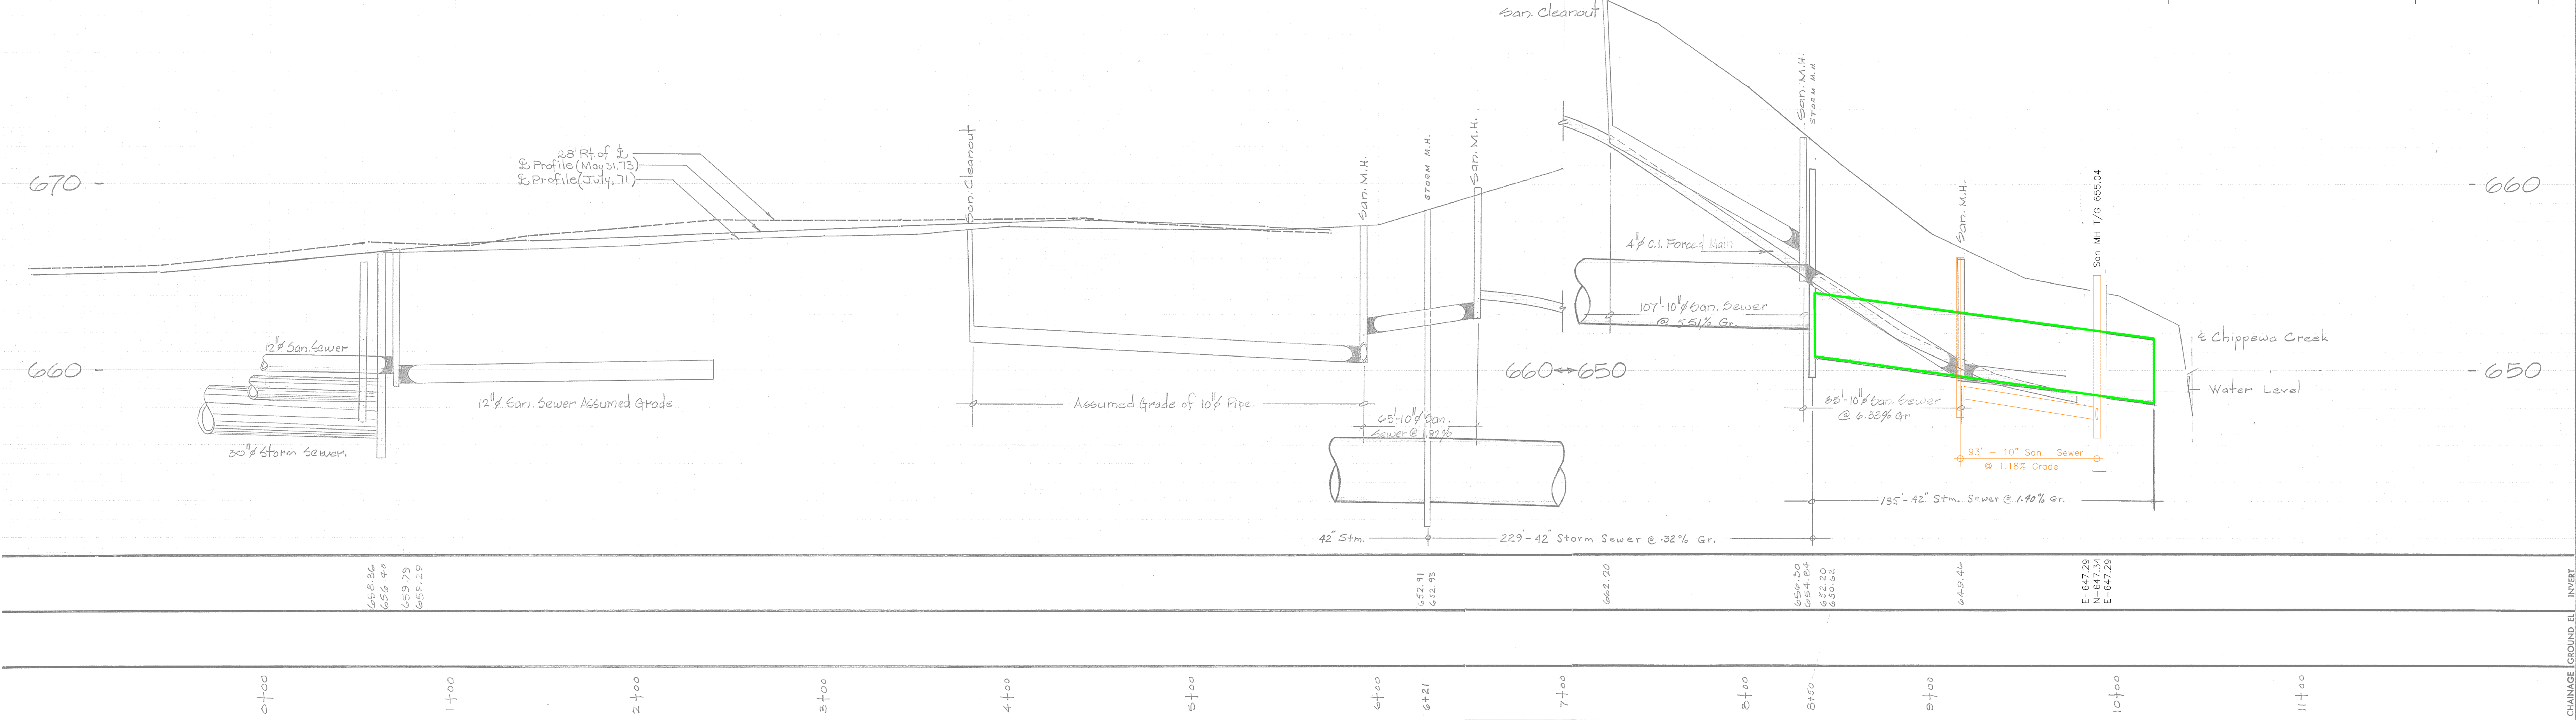

NOTES:

DISCLAIMER

The information contained on this drawing may be based upon data provided by others and may not have been verified by either as-constructed drawings or an Ontario Land Surveyor. The City of North Bay cannot accept responsibility for any errors or omissions on any information shown herein. Field verification, land surveys or excavation (with City approvals) may be required to determine actual location of any and all utilities or property lines.

REVISIONS

No.	REVISION	DATE	INITIAL
1.	2" Profile & 28' R/L	MAY/13	GR
2.	As Const. 16" WATERMAIN	Oct 15	R.F.B.
3.	Detail & Sanitary Sewer & Playground & Creek	Dec 05	PLC.
4.	Registered Plan Added	Oct. 07	hjo.

APPROVED

FIRST AVENUE
REGINA STREET TO CHIPPEWA CR.

REG'D PLANS No. 20 & 21
LOTS 19 & 20 CON'D

CITY OF NORTH BAY
ENGINEERING DEPARTMENT

SCALE: 1" = 40'
DATE: JULY/11

DRAWN BY: [Signature]
CK'D. BY: [Signature]

FIELD BOOK No. #210
DRAWING No. F-6

REV.