
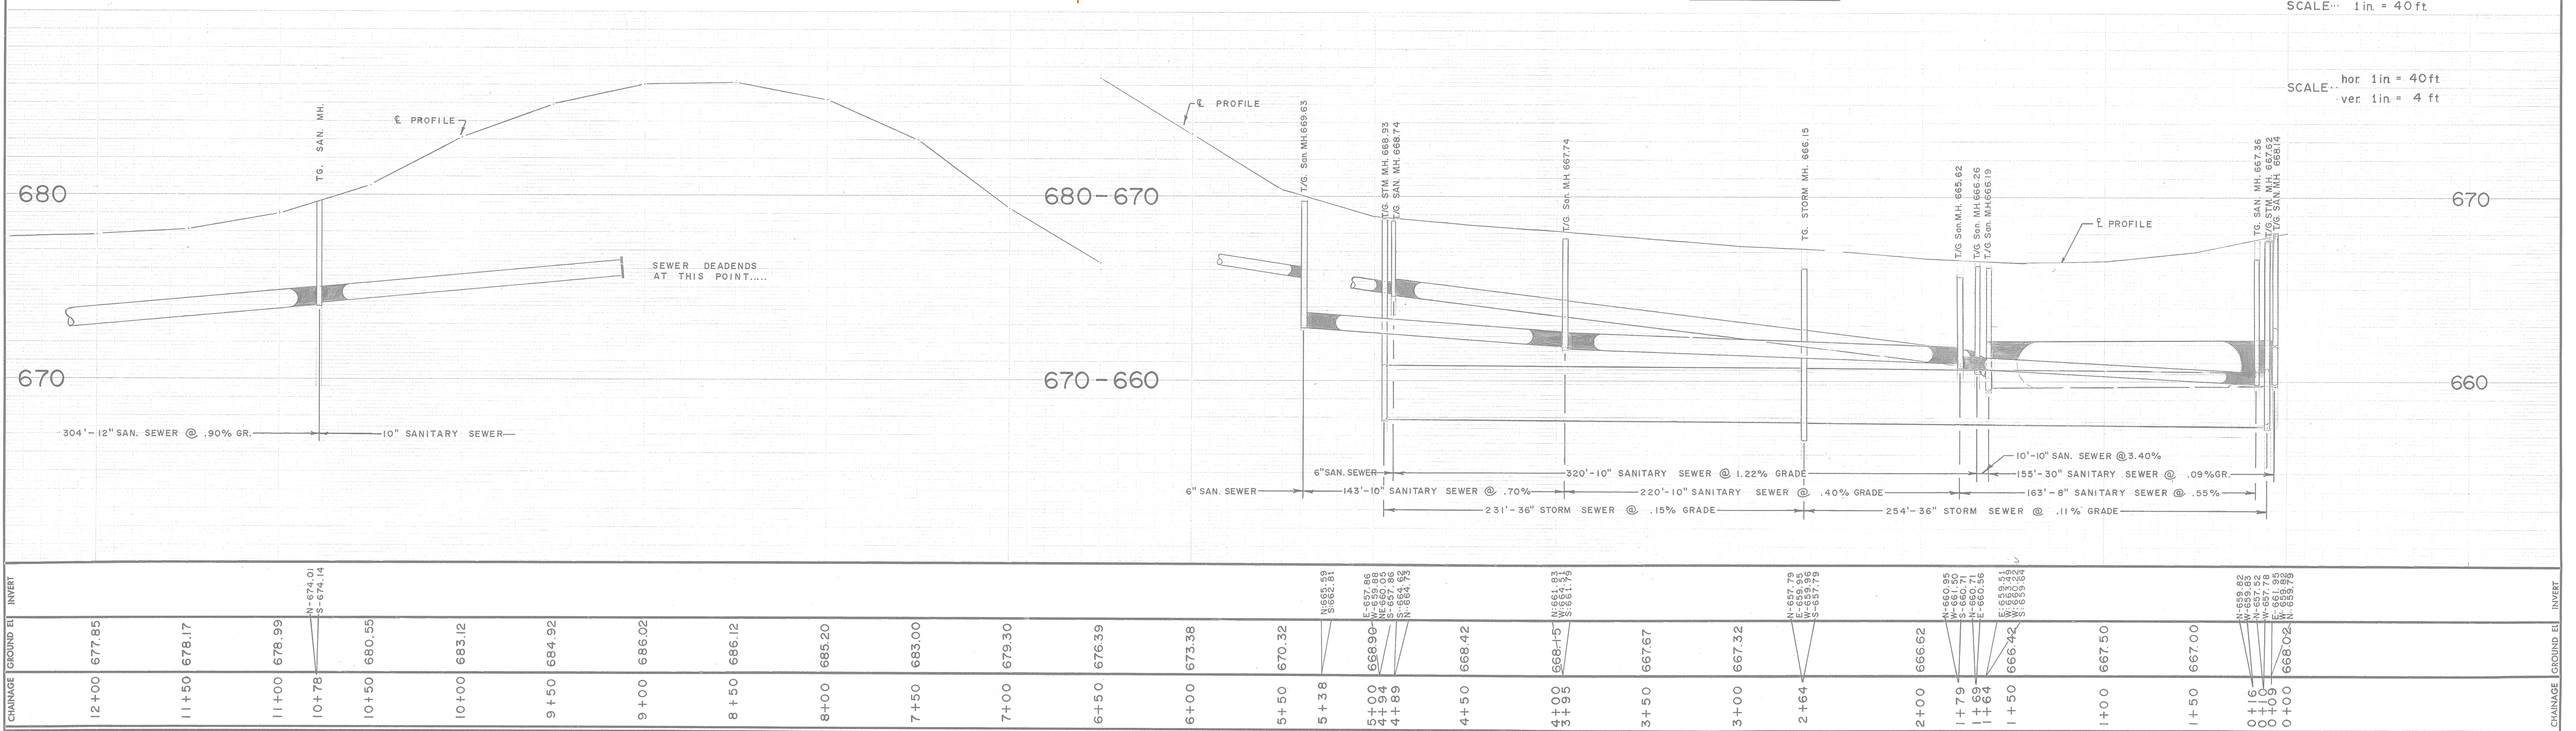


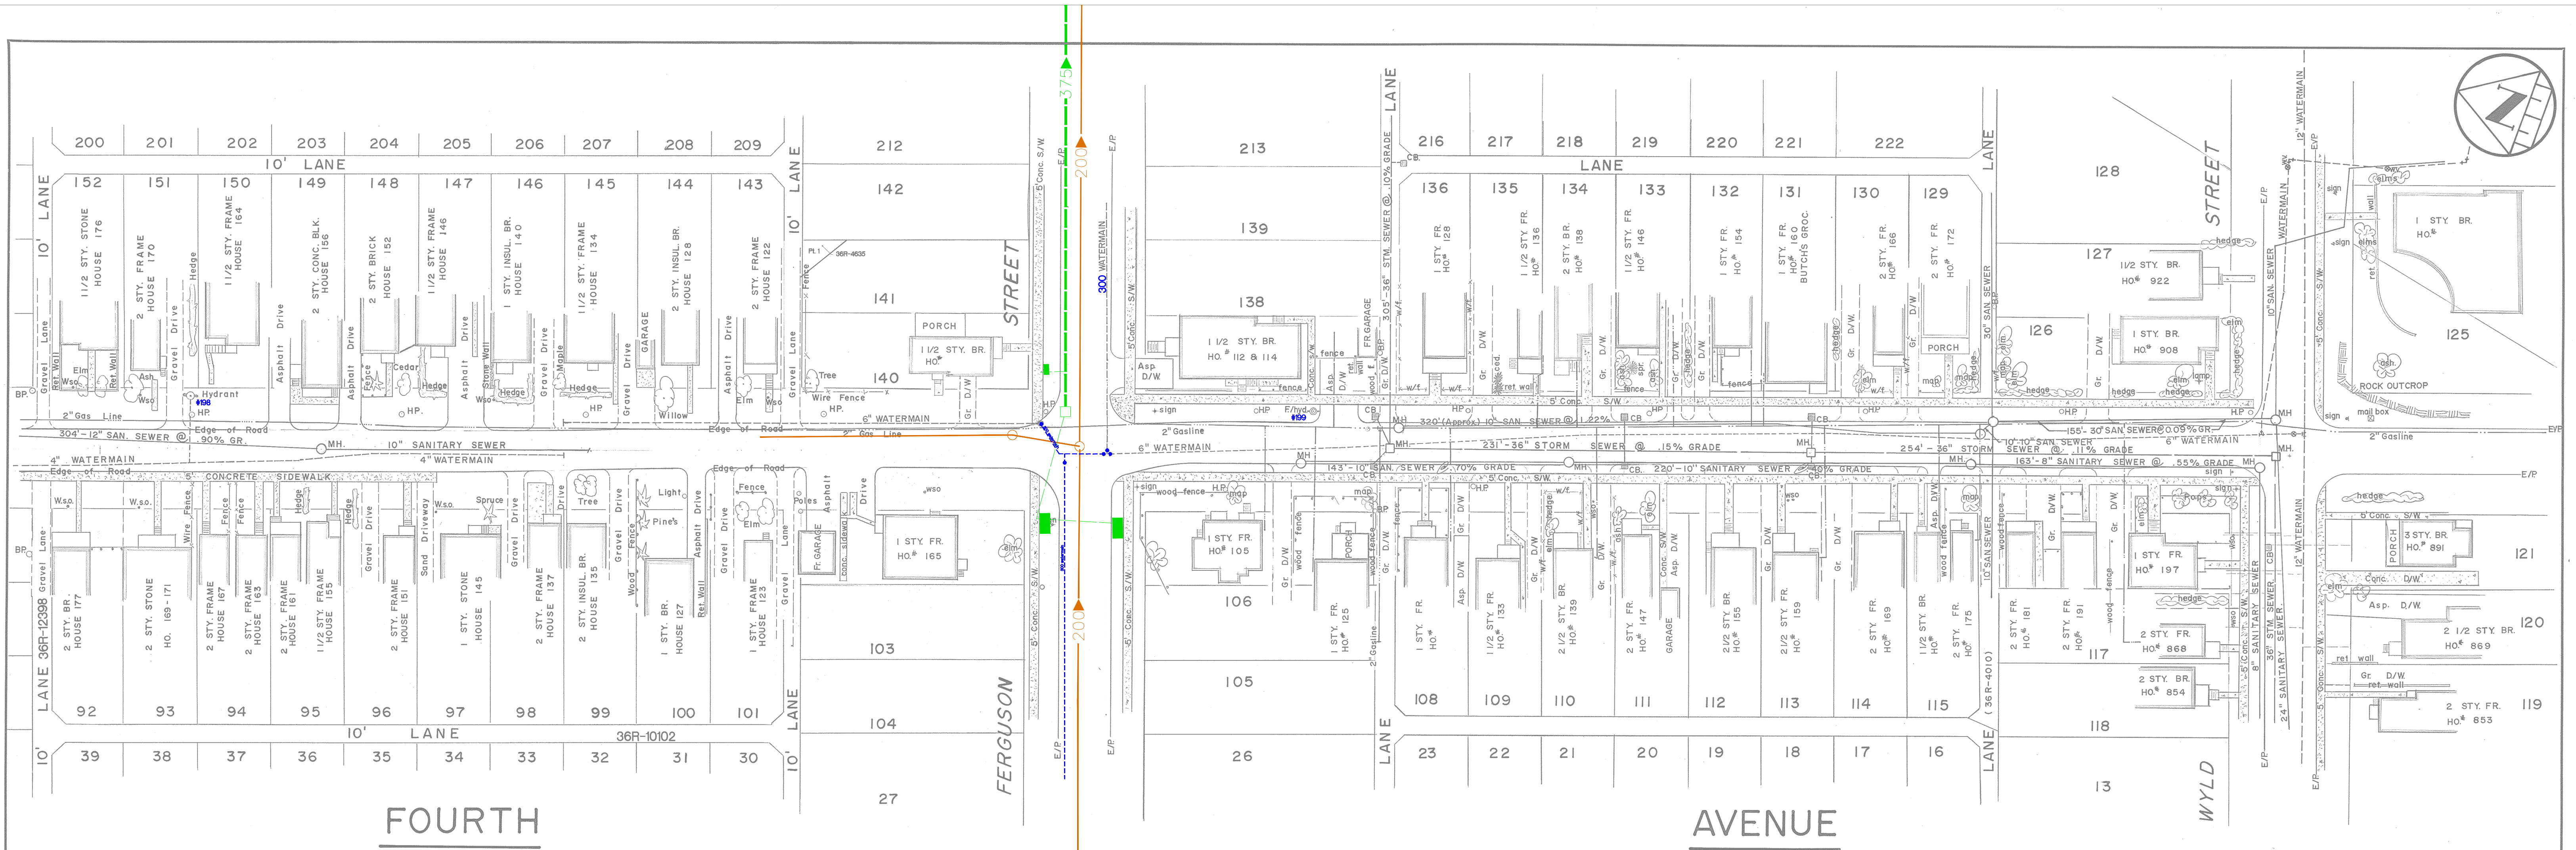

DWC: 1/0	NOTES:				APPROVED		FOURTH AVENUE FERGUSON ST. TO WYLD ST.		CITY OF NORTH BAY ENGINEERING DEPARTMENT	
	DISCLAIMER The information contained on this drawing may be based upon data provided by others and may not have been verified by either as-constructed drawings or an Ontario Land Surveyor. The City of North Bay cannot accept responsibility for any errors or omissions on any information shown herein. Field verification, land surveys or excavation (with City approvals) may be required to determine actual location of any and all utilities or property lines.		1. NEW DRAWING	14/9/73	G.R.	REG,D PLAN N ^o . 48 8 62	SCALE: AS SHOWN	DATE: SEPT. 1972		
			2. REVISION (10" San. Sewer & MH.)	20/12/73	G.R.					
			3. GAS SERVICES 3/4"	FEB. 76	R.F.B.					
			4. AS CONSTRUCTED STORM & SANITARY	MAR. 76	R.F.B.					
			5. COMPLETED DWG. - FERGUSON - 12+00	MAY. 76	R.F.B.					
			6. REVISED 6" Wm. LOCATION (FERG. - WYLD ST.)	FEB. 80	A.P.					
			7. Registered Plan added.	Oct. 07	r.j.o.					
			No. REVISION	DATE	INITIAL					

DRAWN BY: G.R.	FIELD BOOK No.	DRAWING No.	REV.
C.D. BY:	222, 242	F-77	