
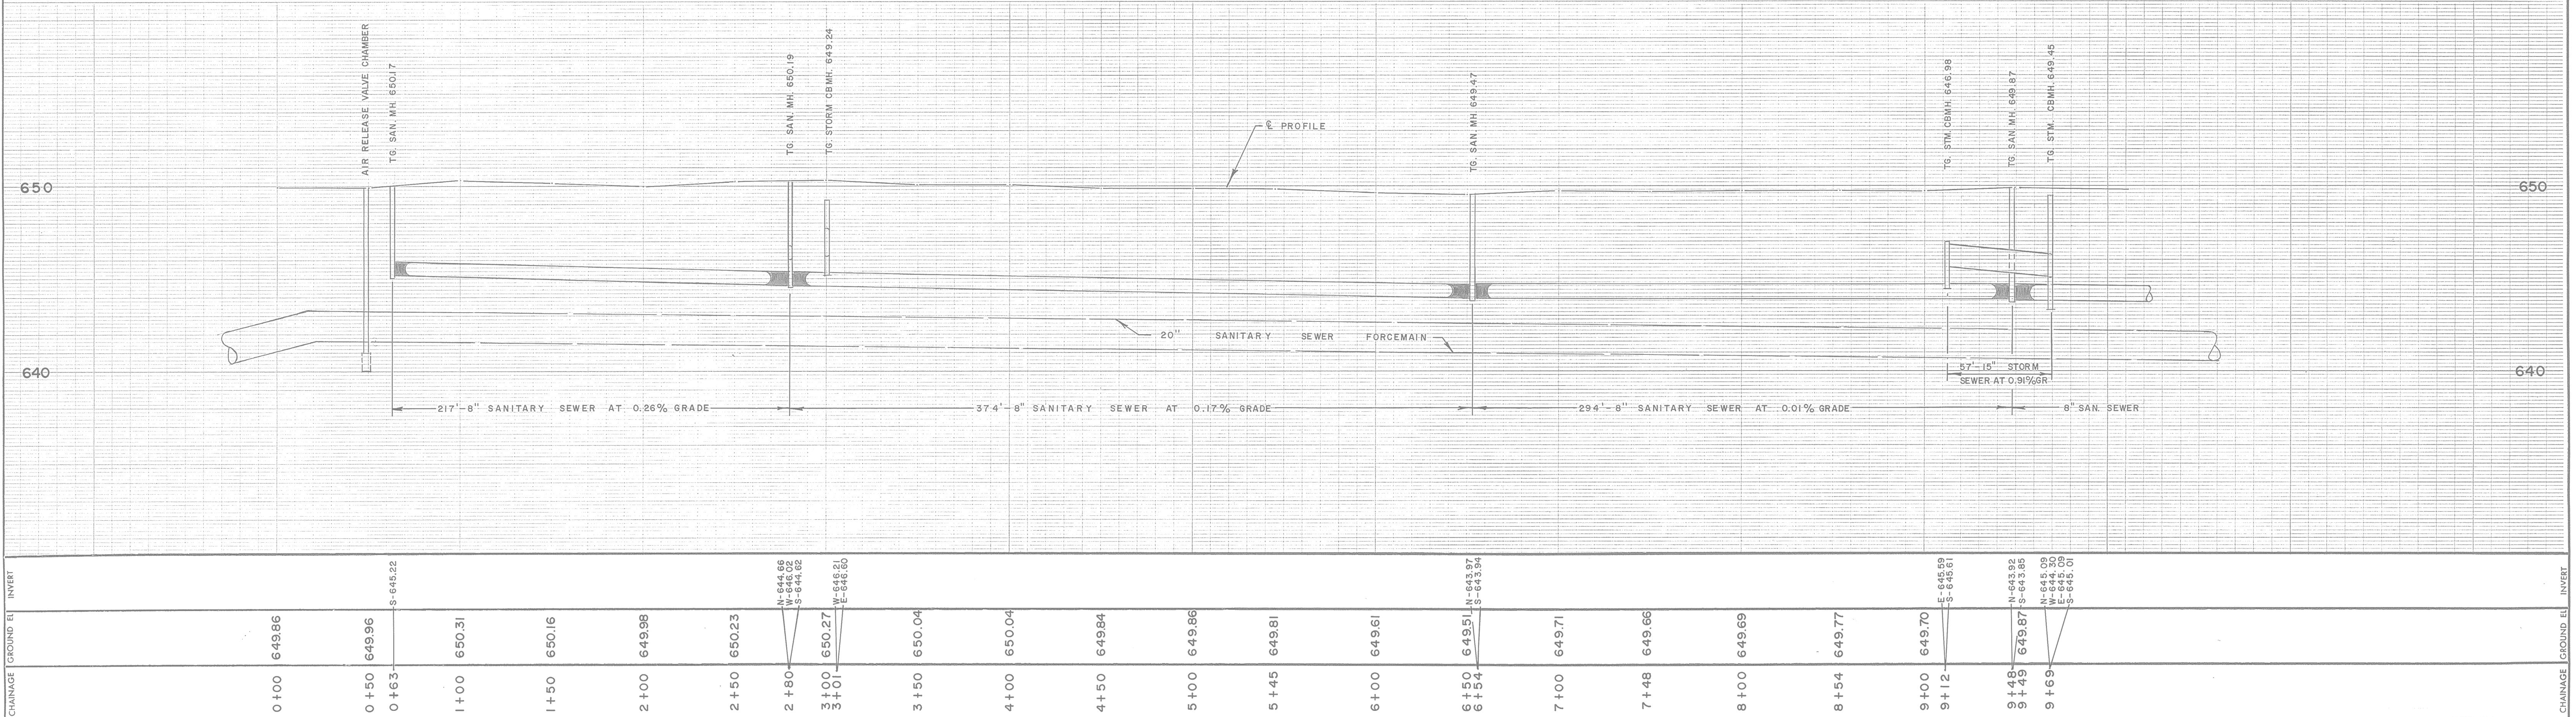
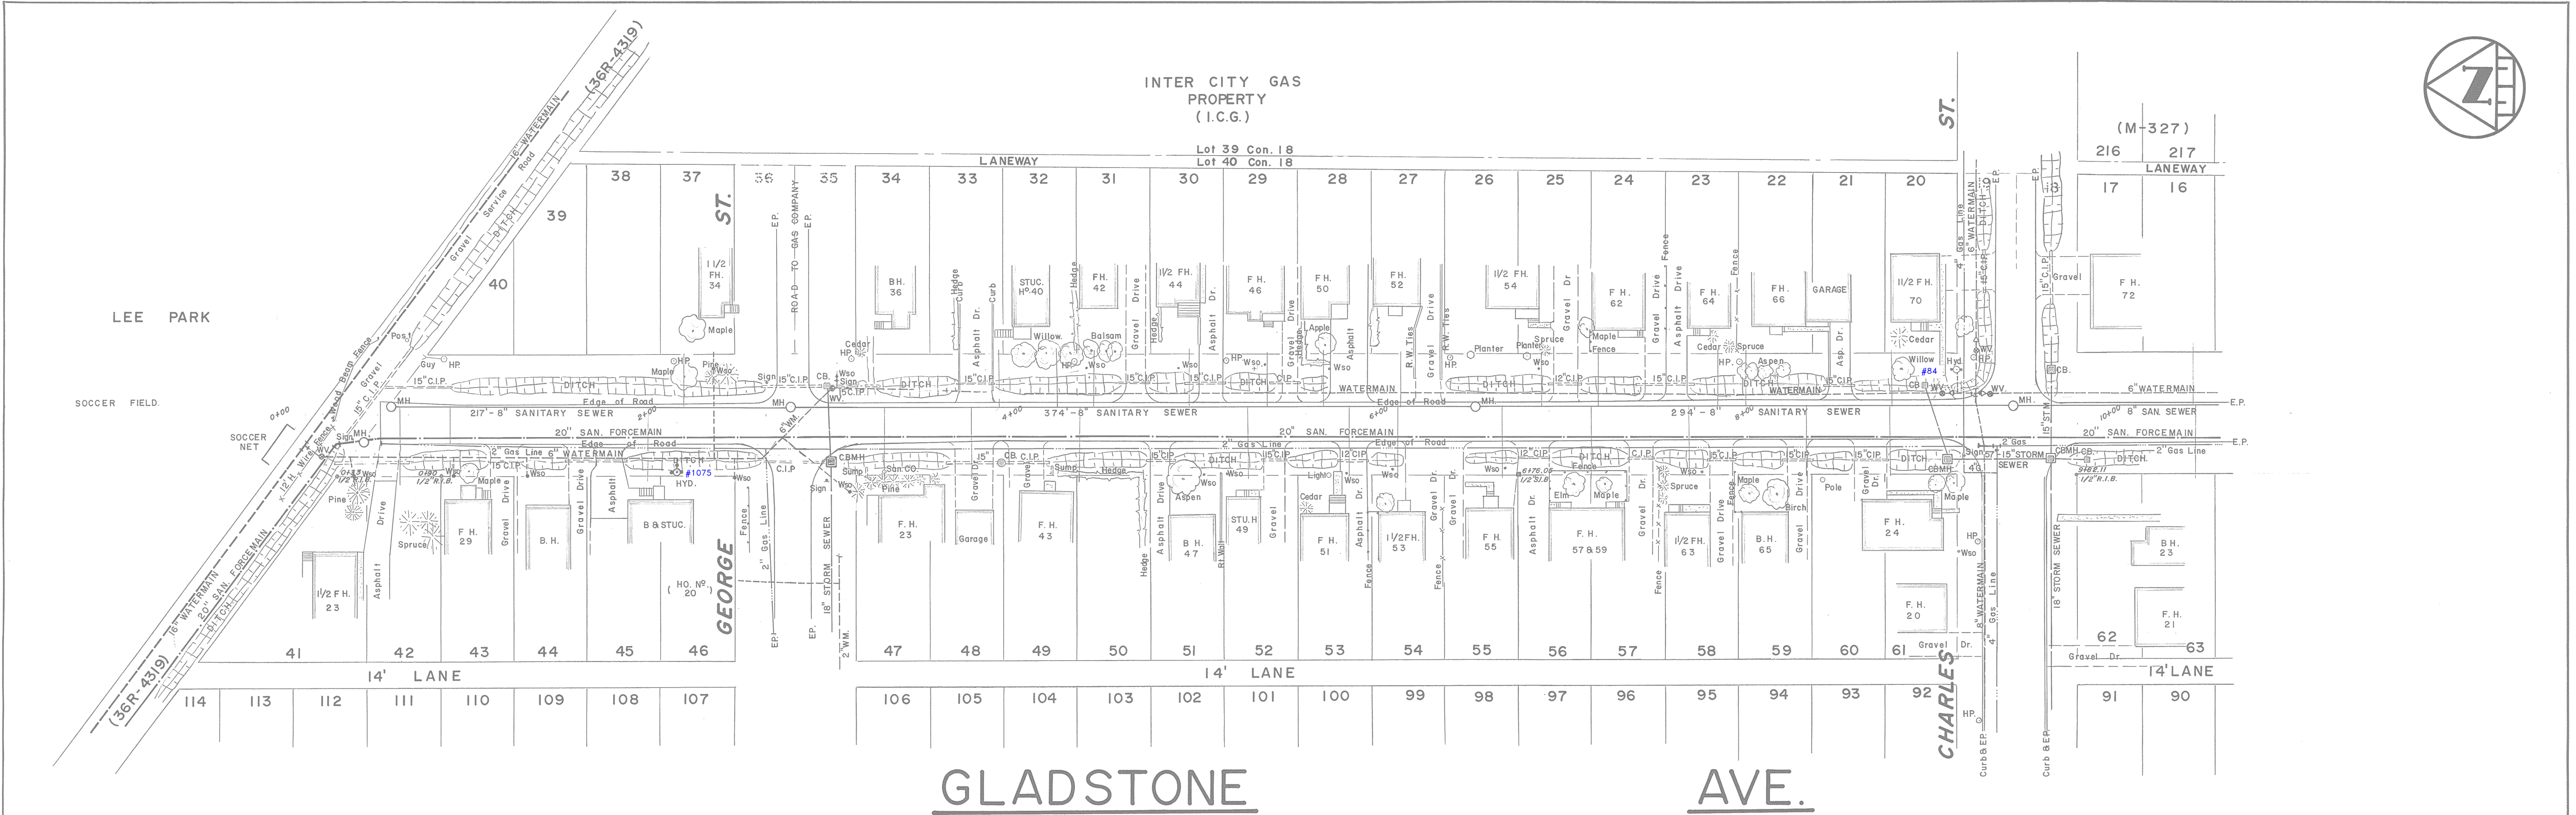


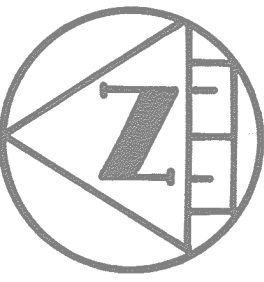

DWG: 10'	NOTES: DISCLAIMER The information contained on this drawing may be based upon data provided by others and may not have been verified by either as-constructed drawings or an Ontario Land Surveyor. The City of North Bay cannot accept responsibility for any errors or omissions on any information shown herein. Field verification, land surveys or excavation (with City approvals) may be required to determine actual location of any and all utilities or property lines.	1. SAN. SEWER HOUSE SERVICES FROM CLARK , LACKSTROM & BRAUND DWG. (Dec. 61) MAY 86. Rick B.			APPROVED	GLADSTONE AVENUE		CITY OF NORTH BAY	
		2. AS CONST'D. 6"WM. GEORGE To PARK BK 282 NOV. 87 Rick B.				LEE PARK TO CHARLES ST.		ENGINEERING DEPARTMENT	
								SCALE: HOR. 1"=40' VER. 1"=4'	
								DATE: MAY. 86	
		DRAWN BY: Rick B.		FIELD BOOK No.		DRAWING No.		REV.	
		CK'D. BY:		255, 280		G-126			
		No.		REVISION		DATE		INITIAL	