



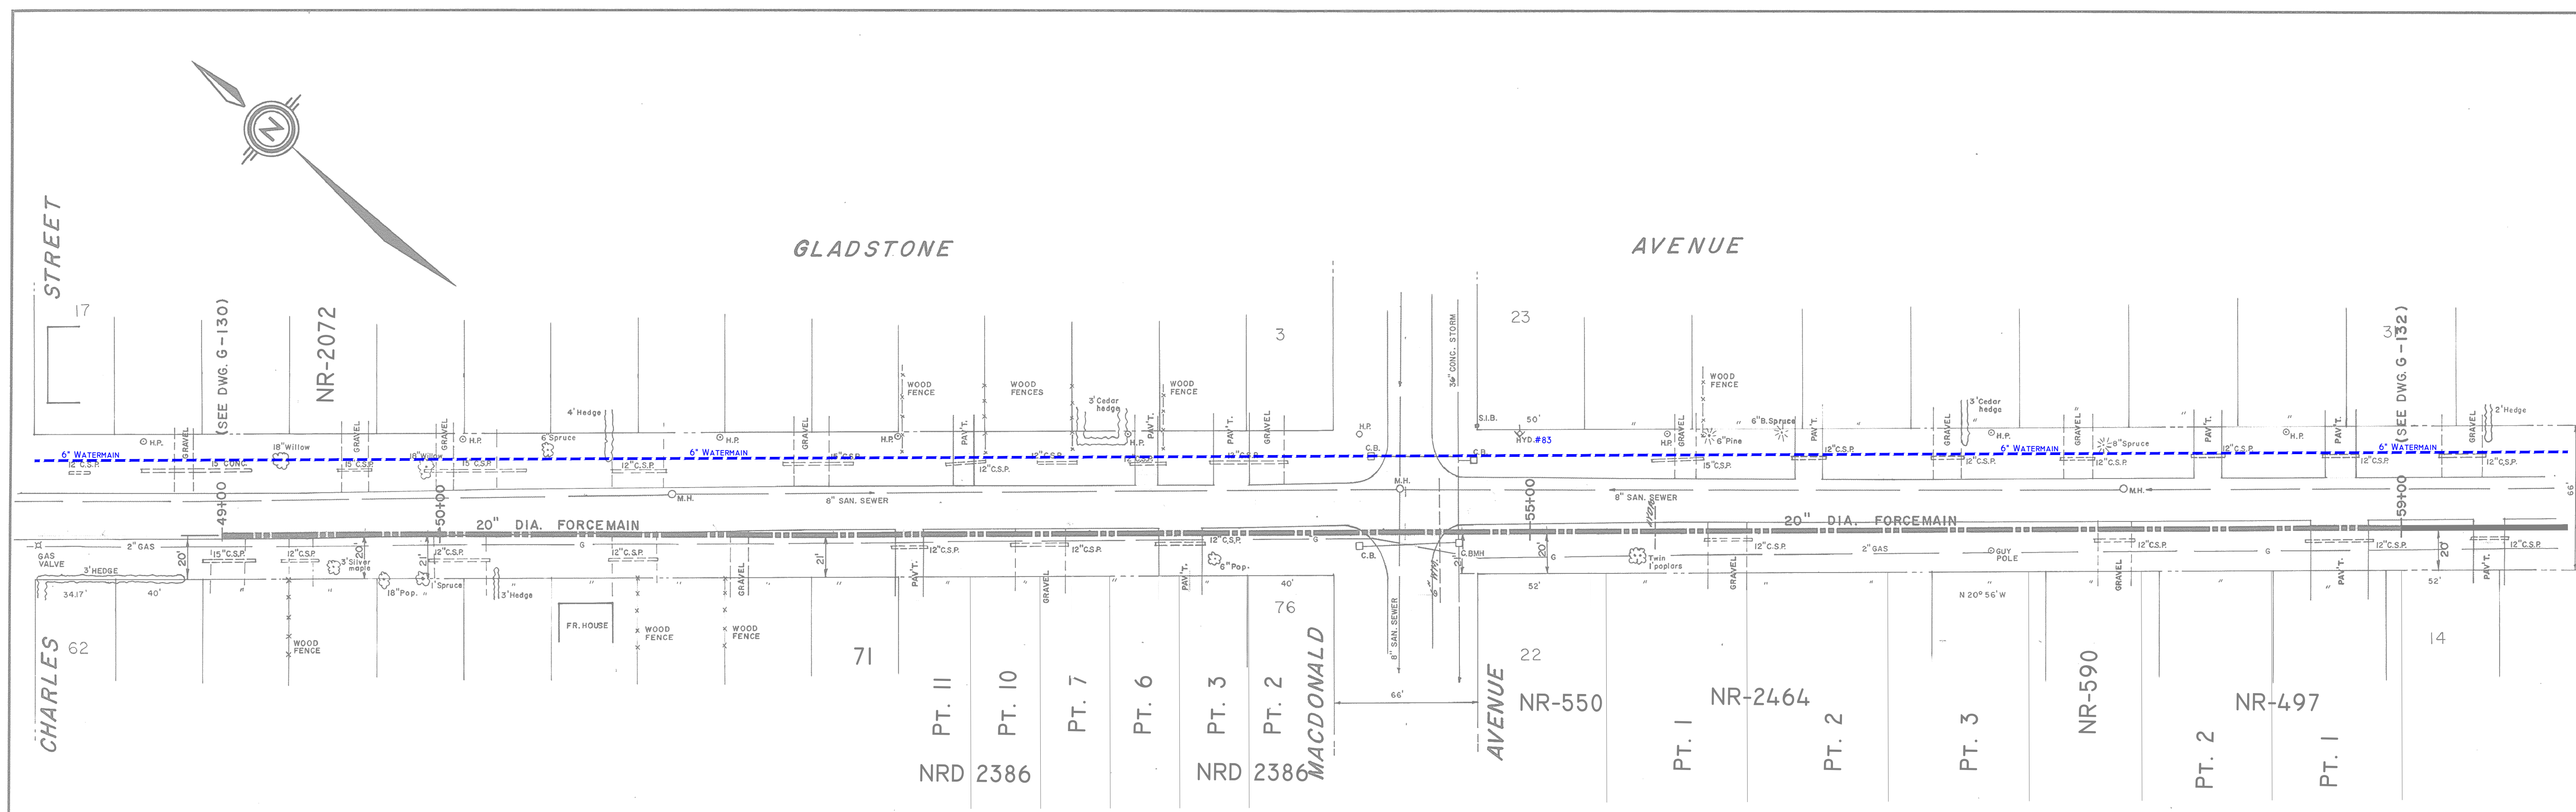

BM TOP OF OPERATING NUT ON HYDRANT AT
COR. MACDONALD AND GLADSTONE
ELEV. 653.10

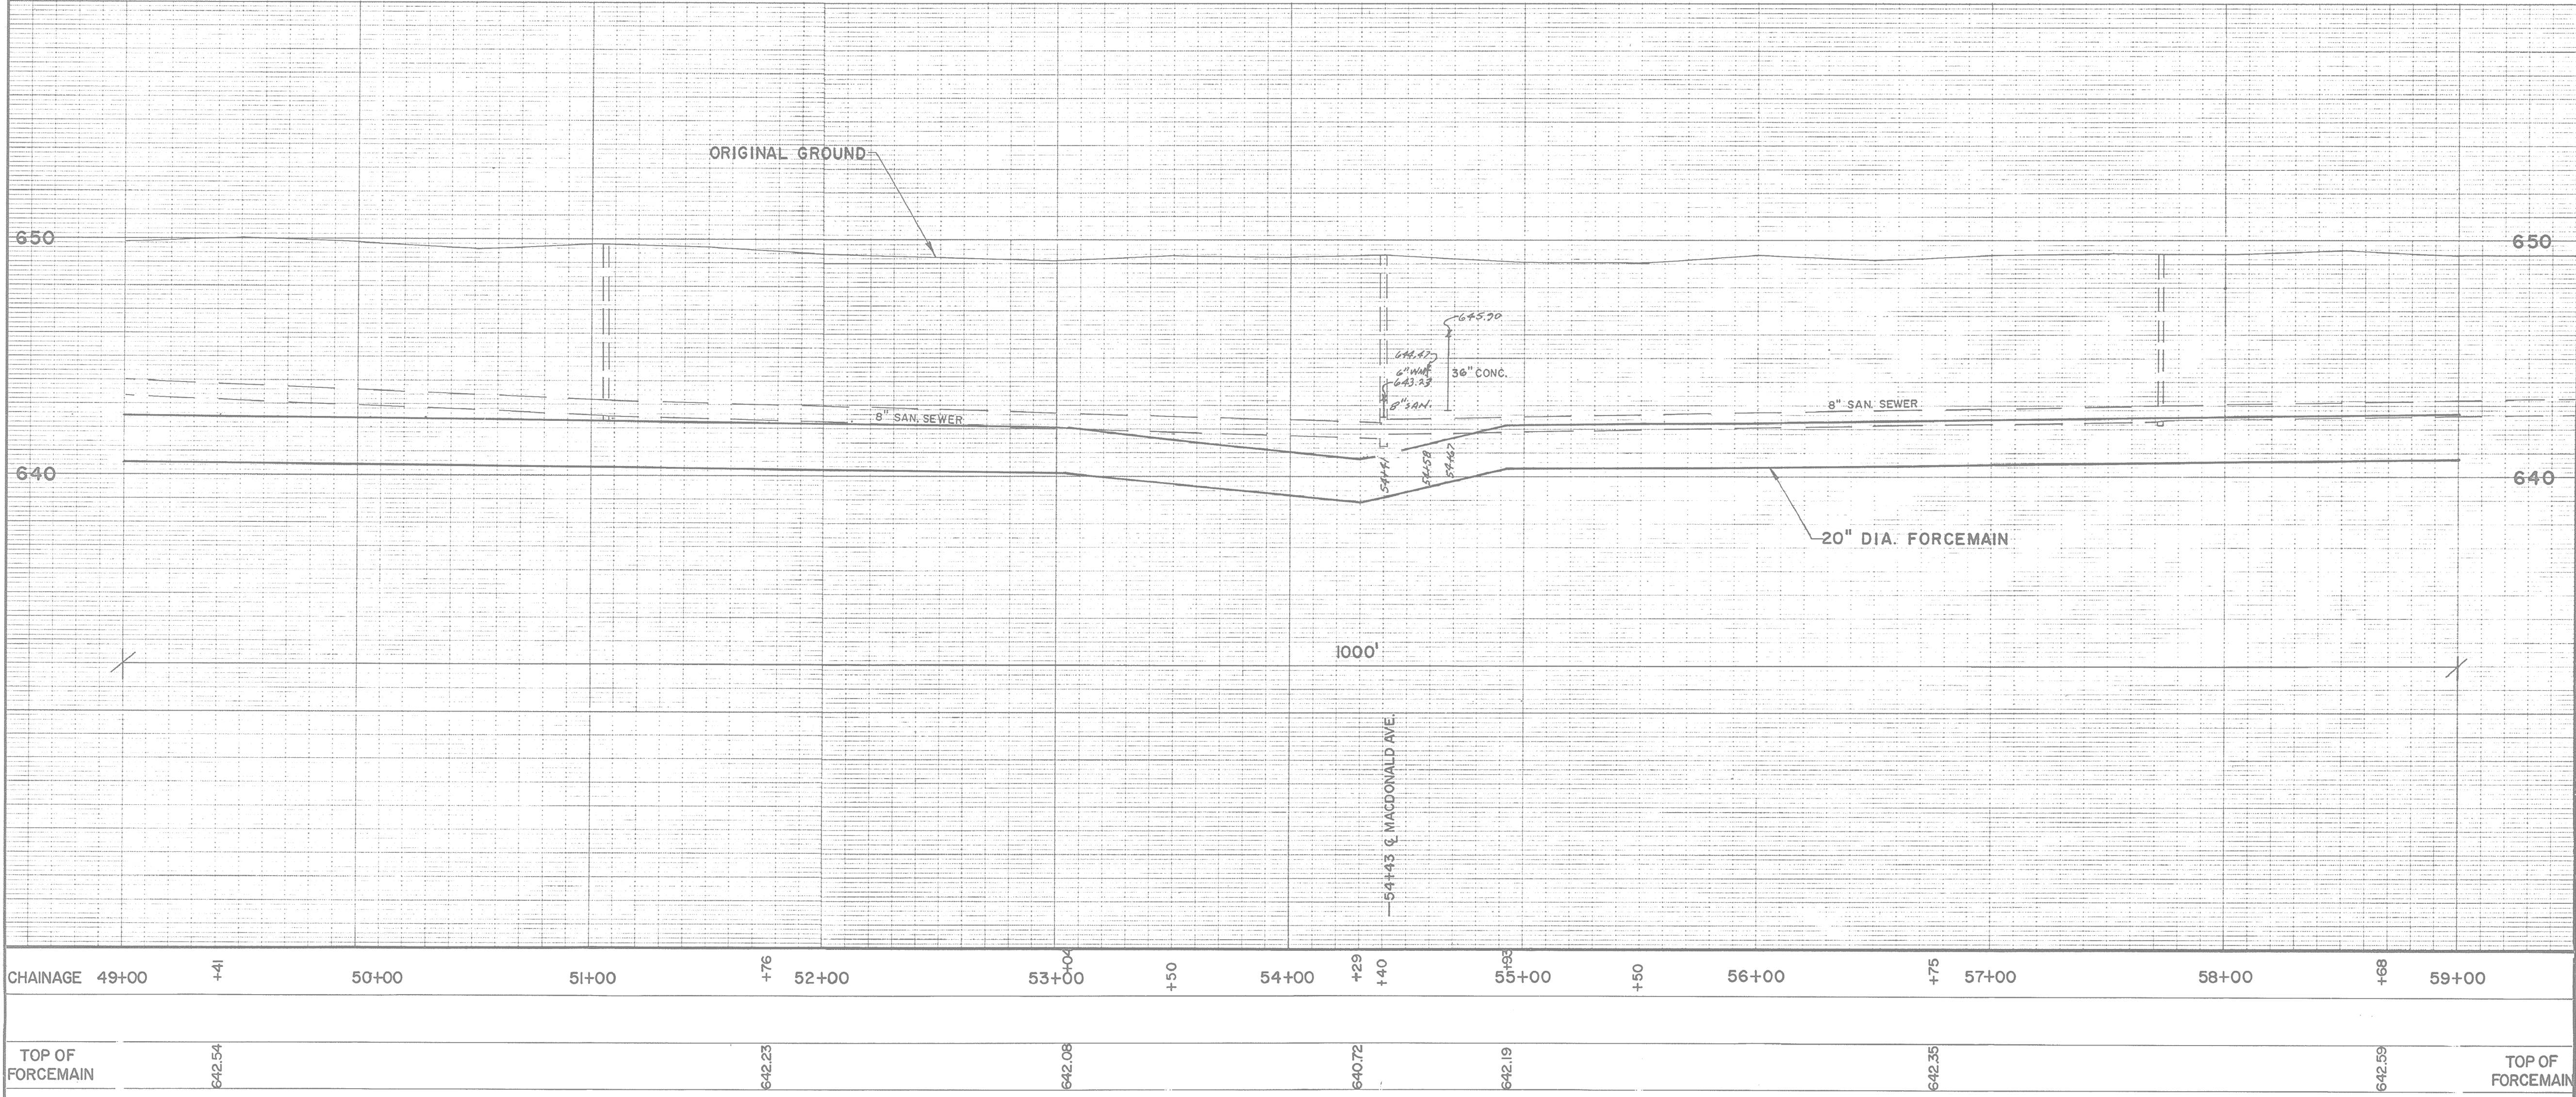

DISCLAIMER
The information contained on this drawing may be based upon data provided by others and may not have been verified by either as-constructed drawings or an Ontario Land Surveyor. The City of North Bay cannot accept responsibility for any errors or omissions on any information shown herein. Field verification, land surveys or excavation (with City approvals) may be required to determine actual location of any and all utilities or property lines.

GLADSTONE AVE. CHARLES ST. TO ETHEL ST.			
4.	G.W.C.	UPDATED LEGAL FABRIC	MAR. 2015
3.	R.J.O.	REGISTERED PLANS AND WATERMAIN ADDED.	OCT. 2008
2	R.E.A.	AS CONSTRUCTED.	MAR. '78
1	B.A.	FM GRADE CHANGE - ADDENDUM No. 1	F.V.M. 21 OCT. '76
MK.		REVISIONS	
BY		APP	DATE
CITY OF NORTH BAY			
MARSHALL AVE. PUMPING STATION & FORCEMAIN			
20" DIA. FORCEMAIN STA. 49+00 TO STA. 59+00			
Northland Engineering Ltd. CONSULTING ENGINEERS AND PLANNERS			
NORTH BAY		SUDBURY	
DESIGN:	F.V.M.	CHECKED:	F.V.M.
DRAWN:	B.A. P.L.C.	APPROVED:	
SCALE:	1" = 40' HOR. 1" = 4' VERT.	CONTRACT NO.	I
PROJECT NO.	1464-6	SHEET NO.	G-131