
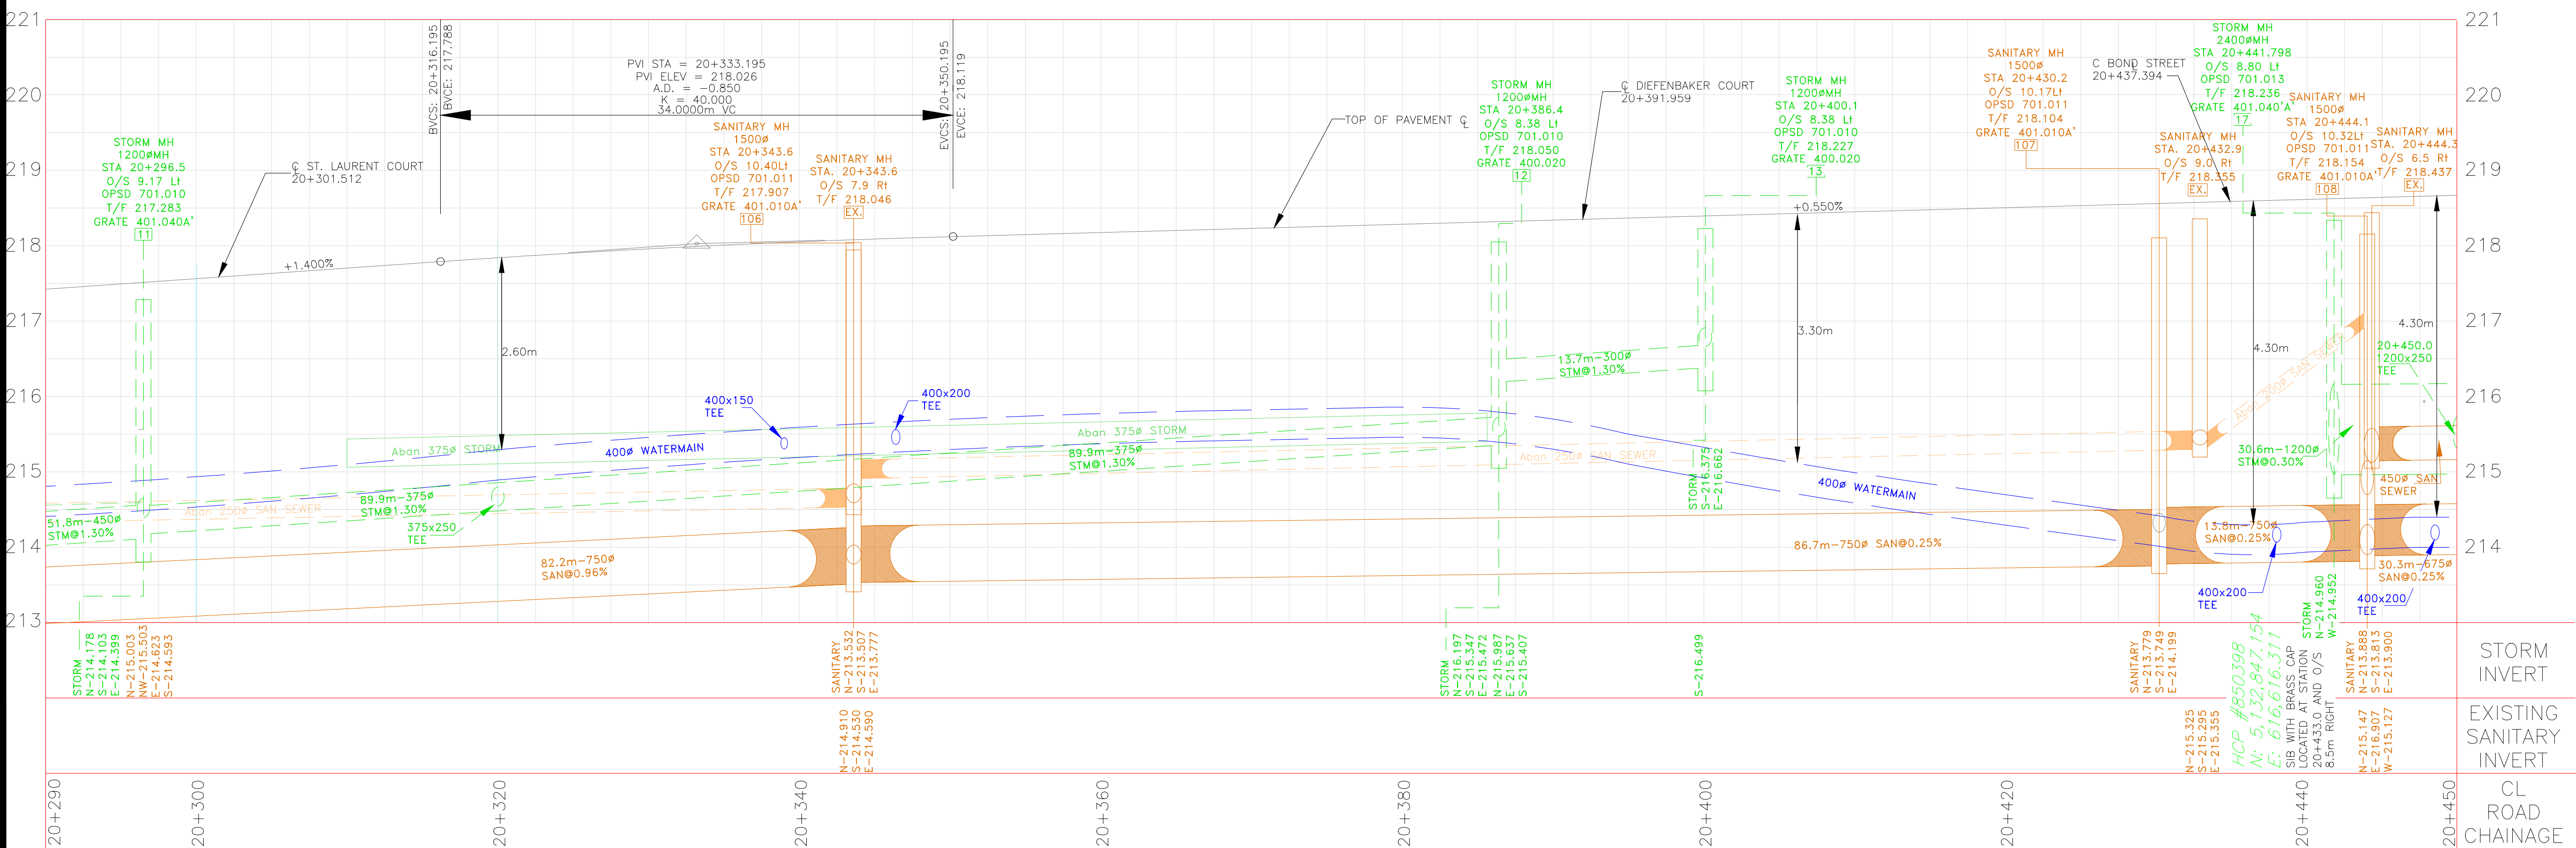


SEE DRAWING G-1489

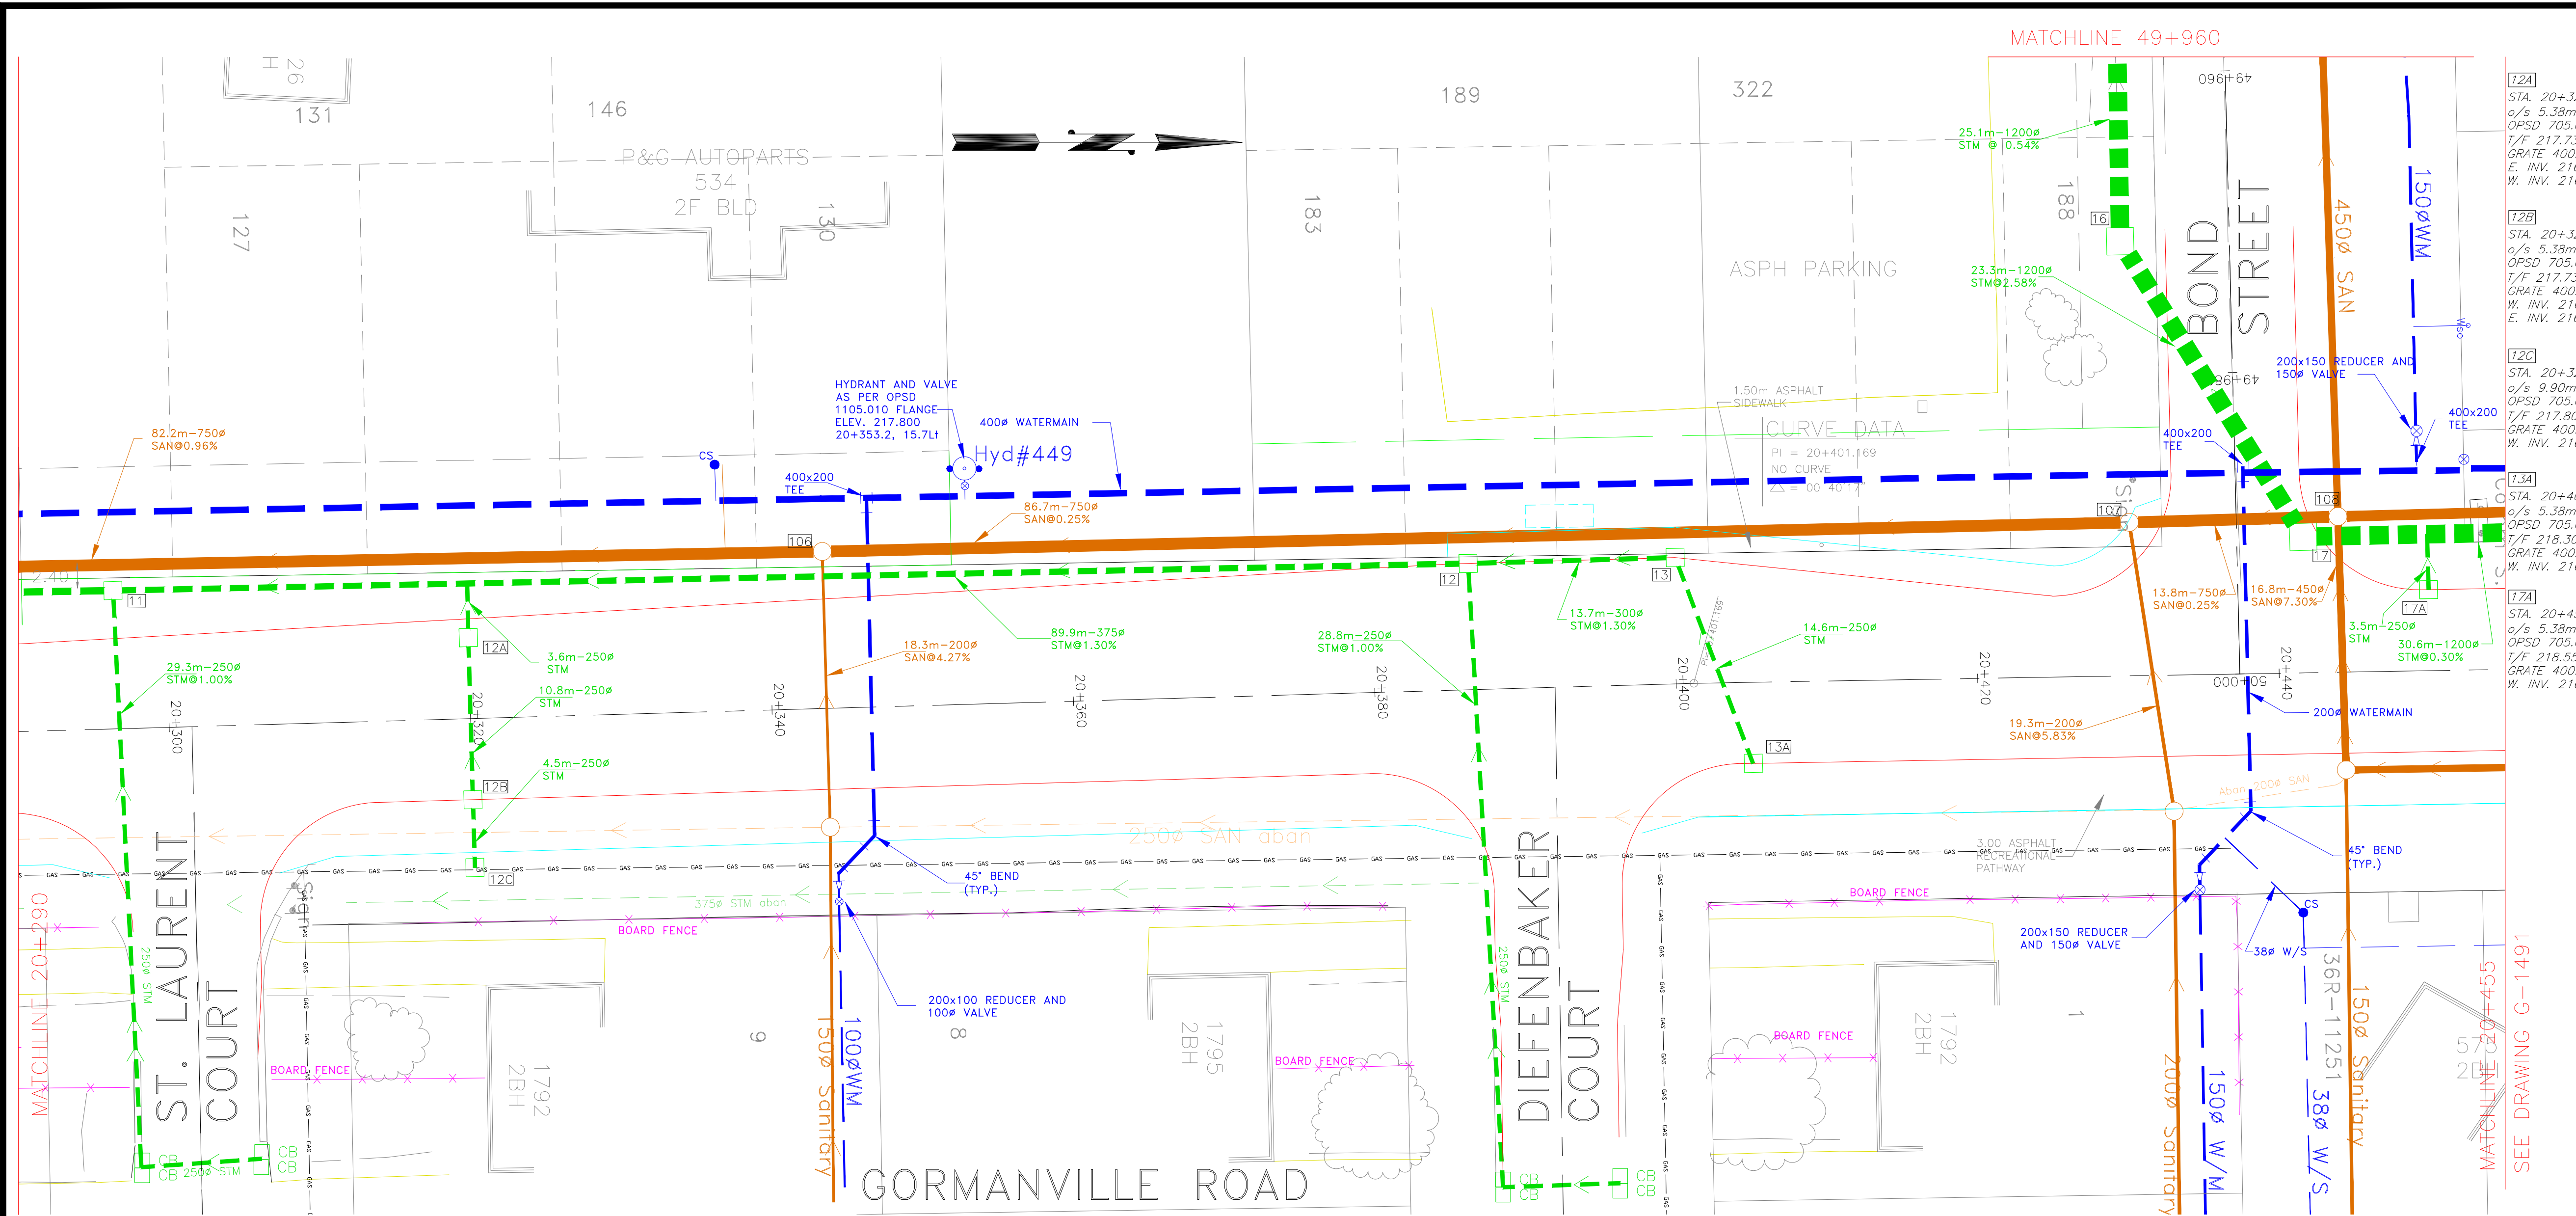

DESIGNED		RRS	
DRAWN		MJM/RSI	
CHECKED		RRS	
APPROVED		SGW	
R E V I S I O N S			
No.	DATE	BY	DESCRIPTION
1	FEB 2/08	RRS	ISSUED FOR TENDER
2	FEB 26/08	RRS	REVISED BUS SHELTER REFERENCE
3	MAY 28/08	RRS	ISSUED FOR CONSTRUCTION
4	NOV 4/10	GWC	AS-BUILT

THE POSITION OF POLE LINES, CONDUITS, WATERMAINS, SEWERS AND OTHER UNDERGROUND AND OVERGROUND UTILITIES AND STRUCTURES IS NOT NECESSARILY SHOWN ON THE CONTRACT DRAWINGS, AND WHERE SHOWN, THE ACCURACY OF THE POSITION OF SUCH UTILITIES AND STRUCTURES IS NOT GUARANTEED. BEFORE STARTING WORK, THE CONTRACTOR SHALL INFORM THEMSELVES OF THE EXACT LOCATION OF ALL SUCH UTILITIES AND STRUCTURES, AND SHALL ASSUME ALL LIABILITY FOR DAMAGE TO THEM

The Corporation
of the City of
North Bay

Just North Enough to be PERFECT

200 McINTYRE ST. E. NORTH BAY, ONTARIO
PHONE: 474-0400 FAX: 495-0936

Gormanville Road Reconstruction
Main Street to
North of College Drive

Disclaimer The information contained on this drawing may be based upon data provided by others and may not have been verified by either as-constructed drawings or an Ontario Land Surveyor. The City of North Bay cannot accept responsibility for any errors or omissions on any information shown herein. Field verification, land surveys or excavation (with City approvals) may be required to determine actual location of any and all utilities or property lines.

AS-BUILT

STA. 20+290 to STA. 20+455

Jp2g Consultants Inc.
ENGINEERS • PLANNERS • PROJECT MANAGERS
PETERBORO • OTTAWA

SCALE
HORIZ. 1:250
VERT. 1:50

DATE NOVEMBER 5, 2010
PROJECT 2064164A
PLOTTED

DRAWING No. **G-1490**