


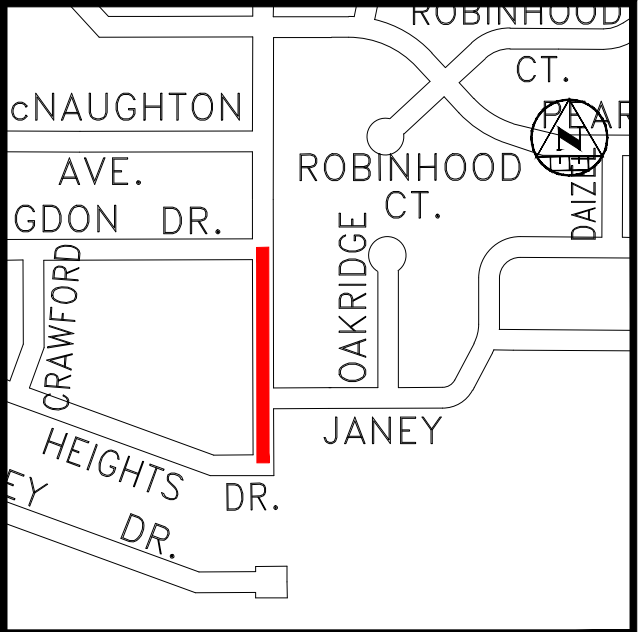


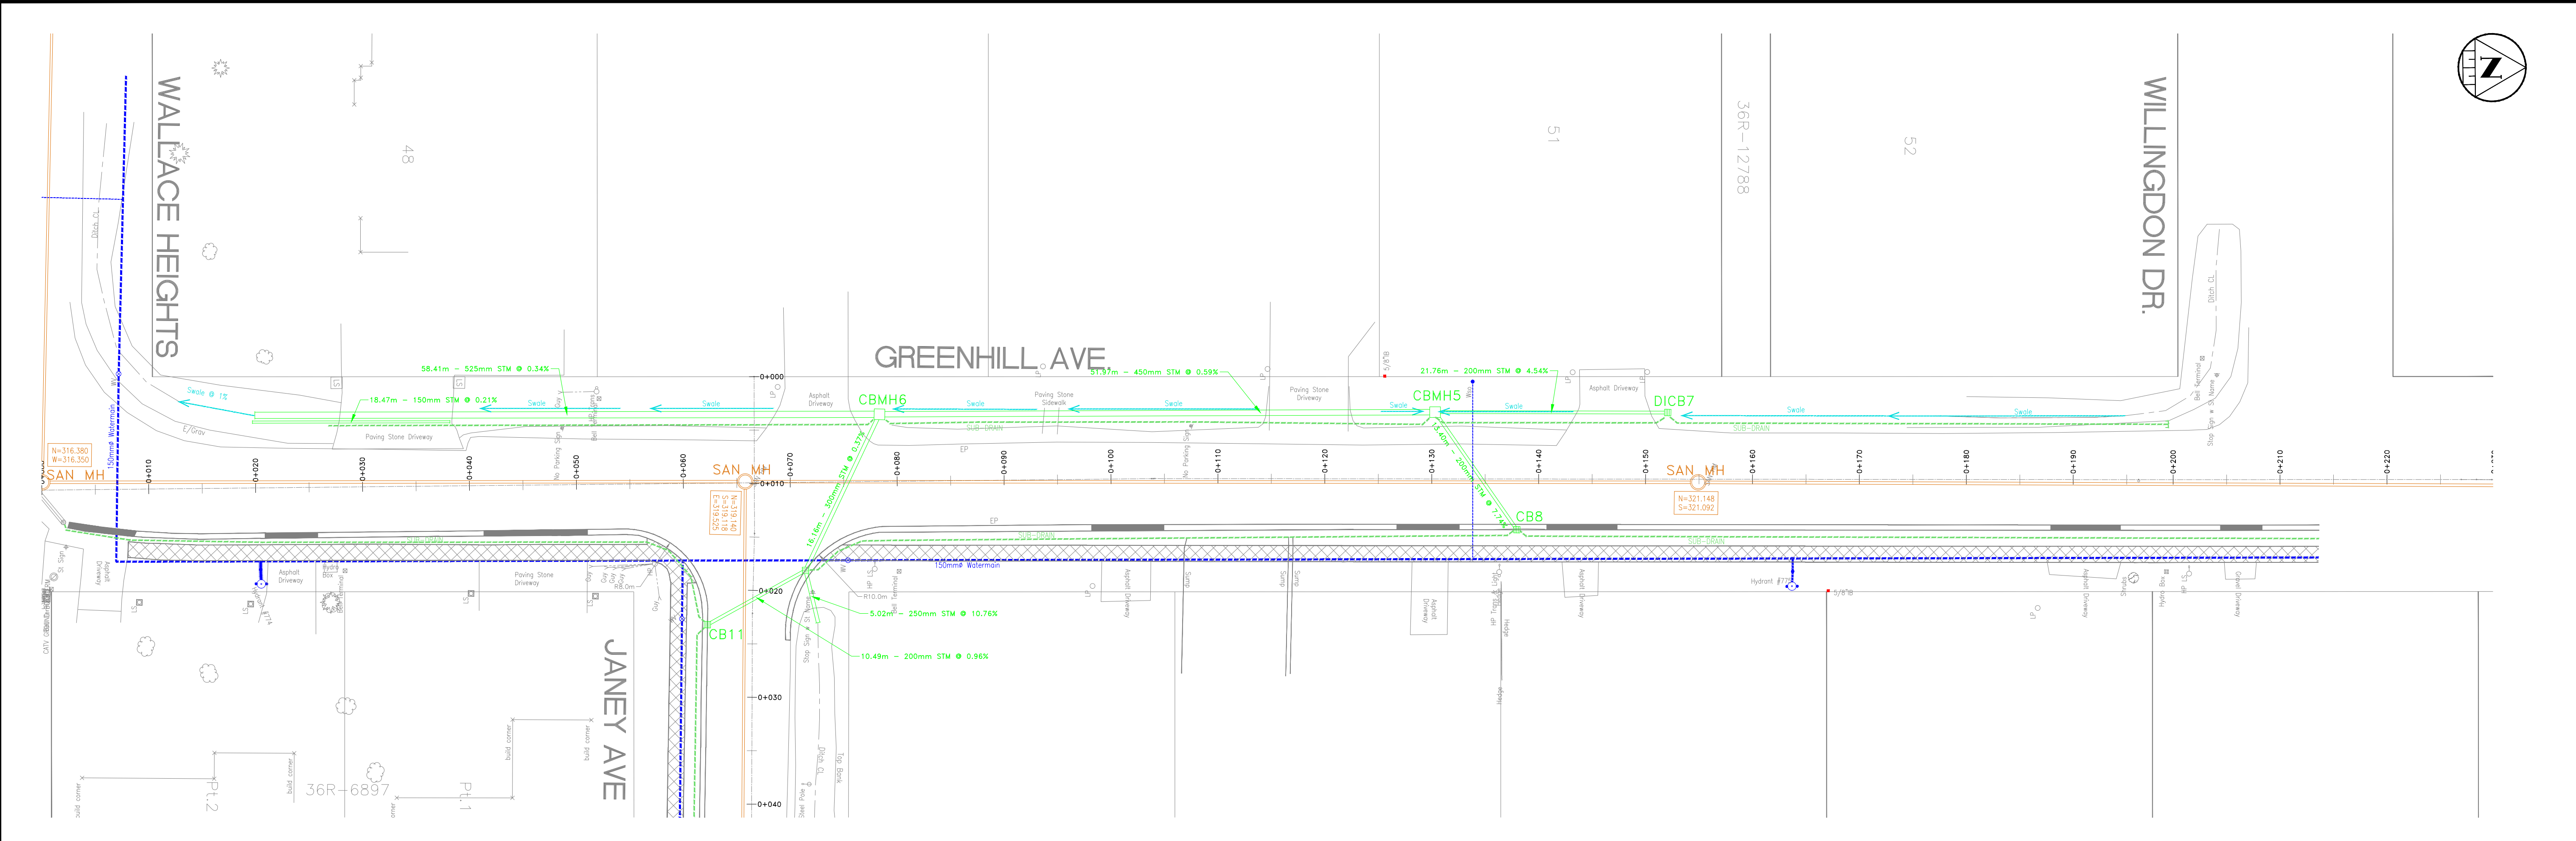

KEY PLAN	
LEGEND	
	STORMWATER PIPE
	Sanitary Pipe
	Watermain & Valve
	Lot / Concession Lines
STORM LINES	
	CATCH BASIN
	STORM MANHOLE
	CATCHBASIN MANHOLE
	Sanitary Manhole
	Edge of Pavement
	CURB & GUTTER WITH DROP
	Hydro Pole/Light
	San service w c/o
	Water service w WSO
	CONCRETE SIDEWALK
	SUB-DRAIN

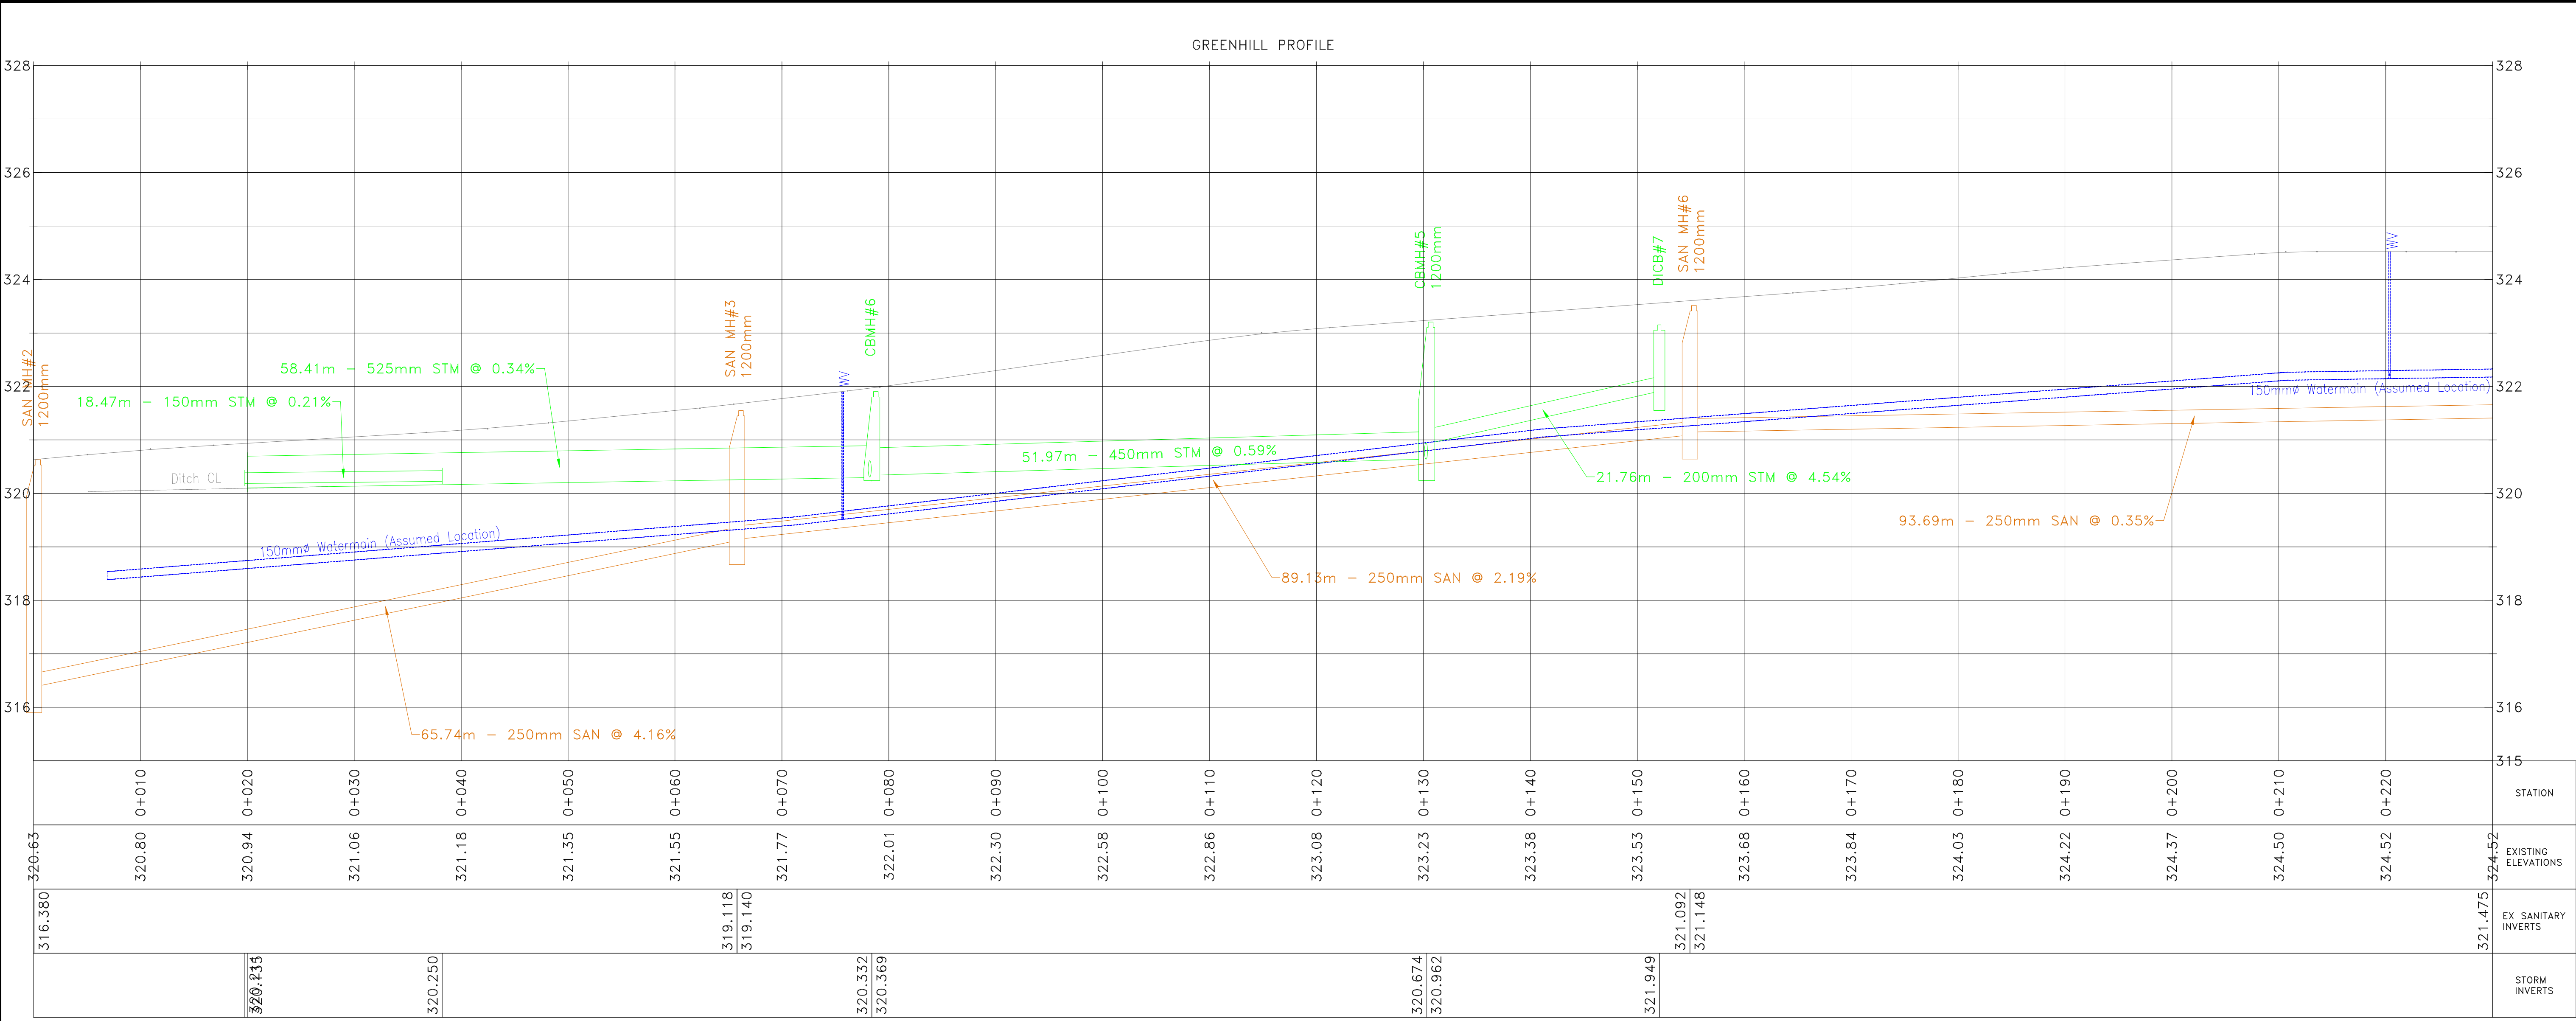

REVISIONS			
no.	date	by	description
1	06/19	GWC	As-Built

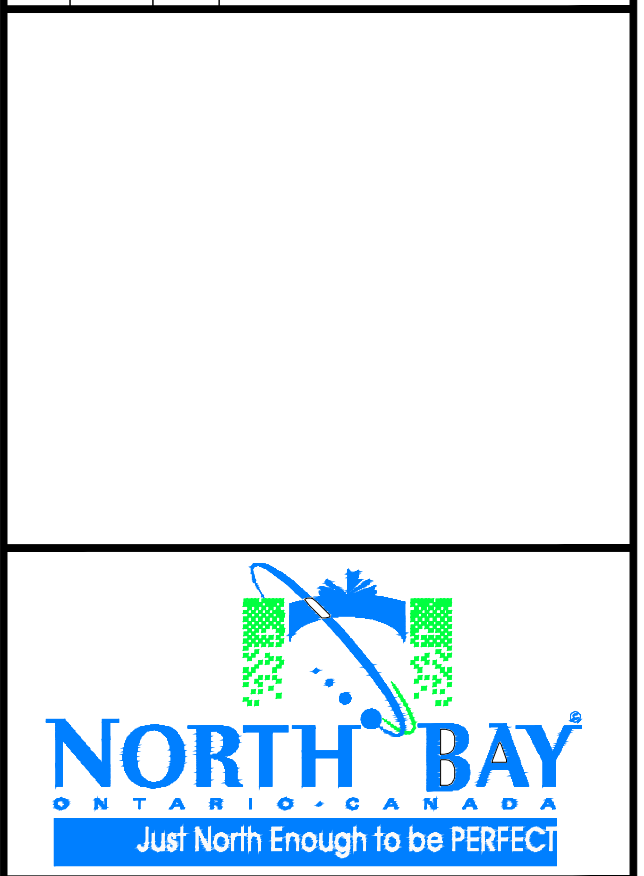

**SIDEWALK AND
DITCHING
GREENHILL AVE**

AS-BUILT

GREENHILL	
Sta: 0+000 to 0+230	
designer G.W.C./G.M.	drawn by: G.W.C.
checked by: G.M.	approved by: R.G.P.
scale 	
date 09/13/2016	drawing number G-579