


LAKE
NIPISSING

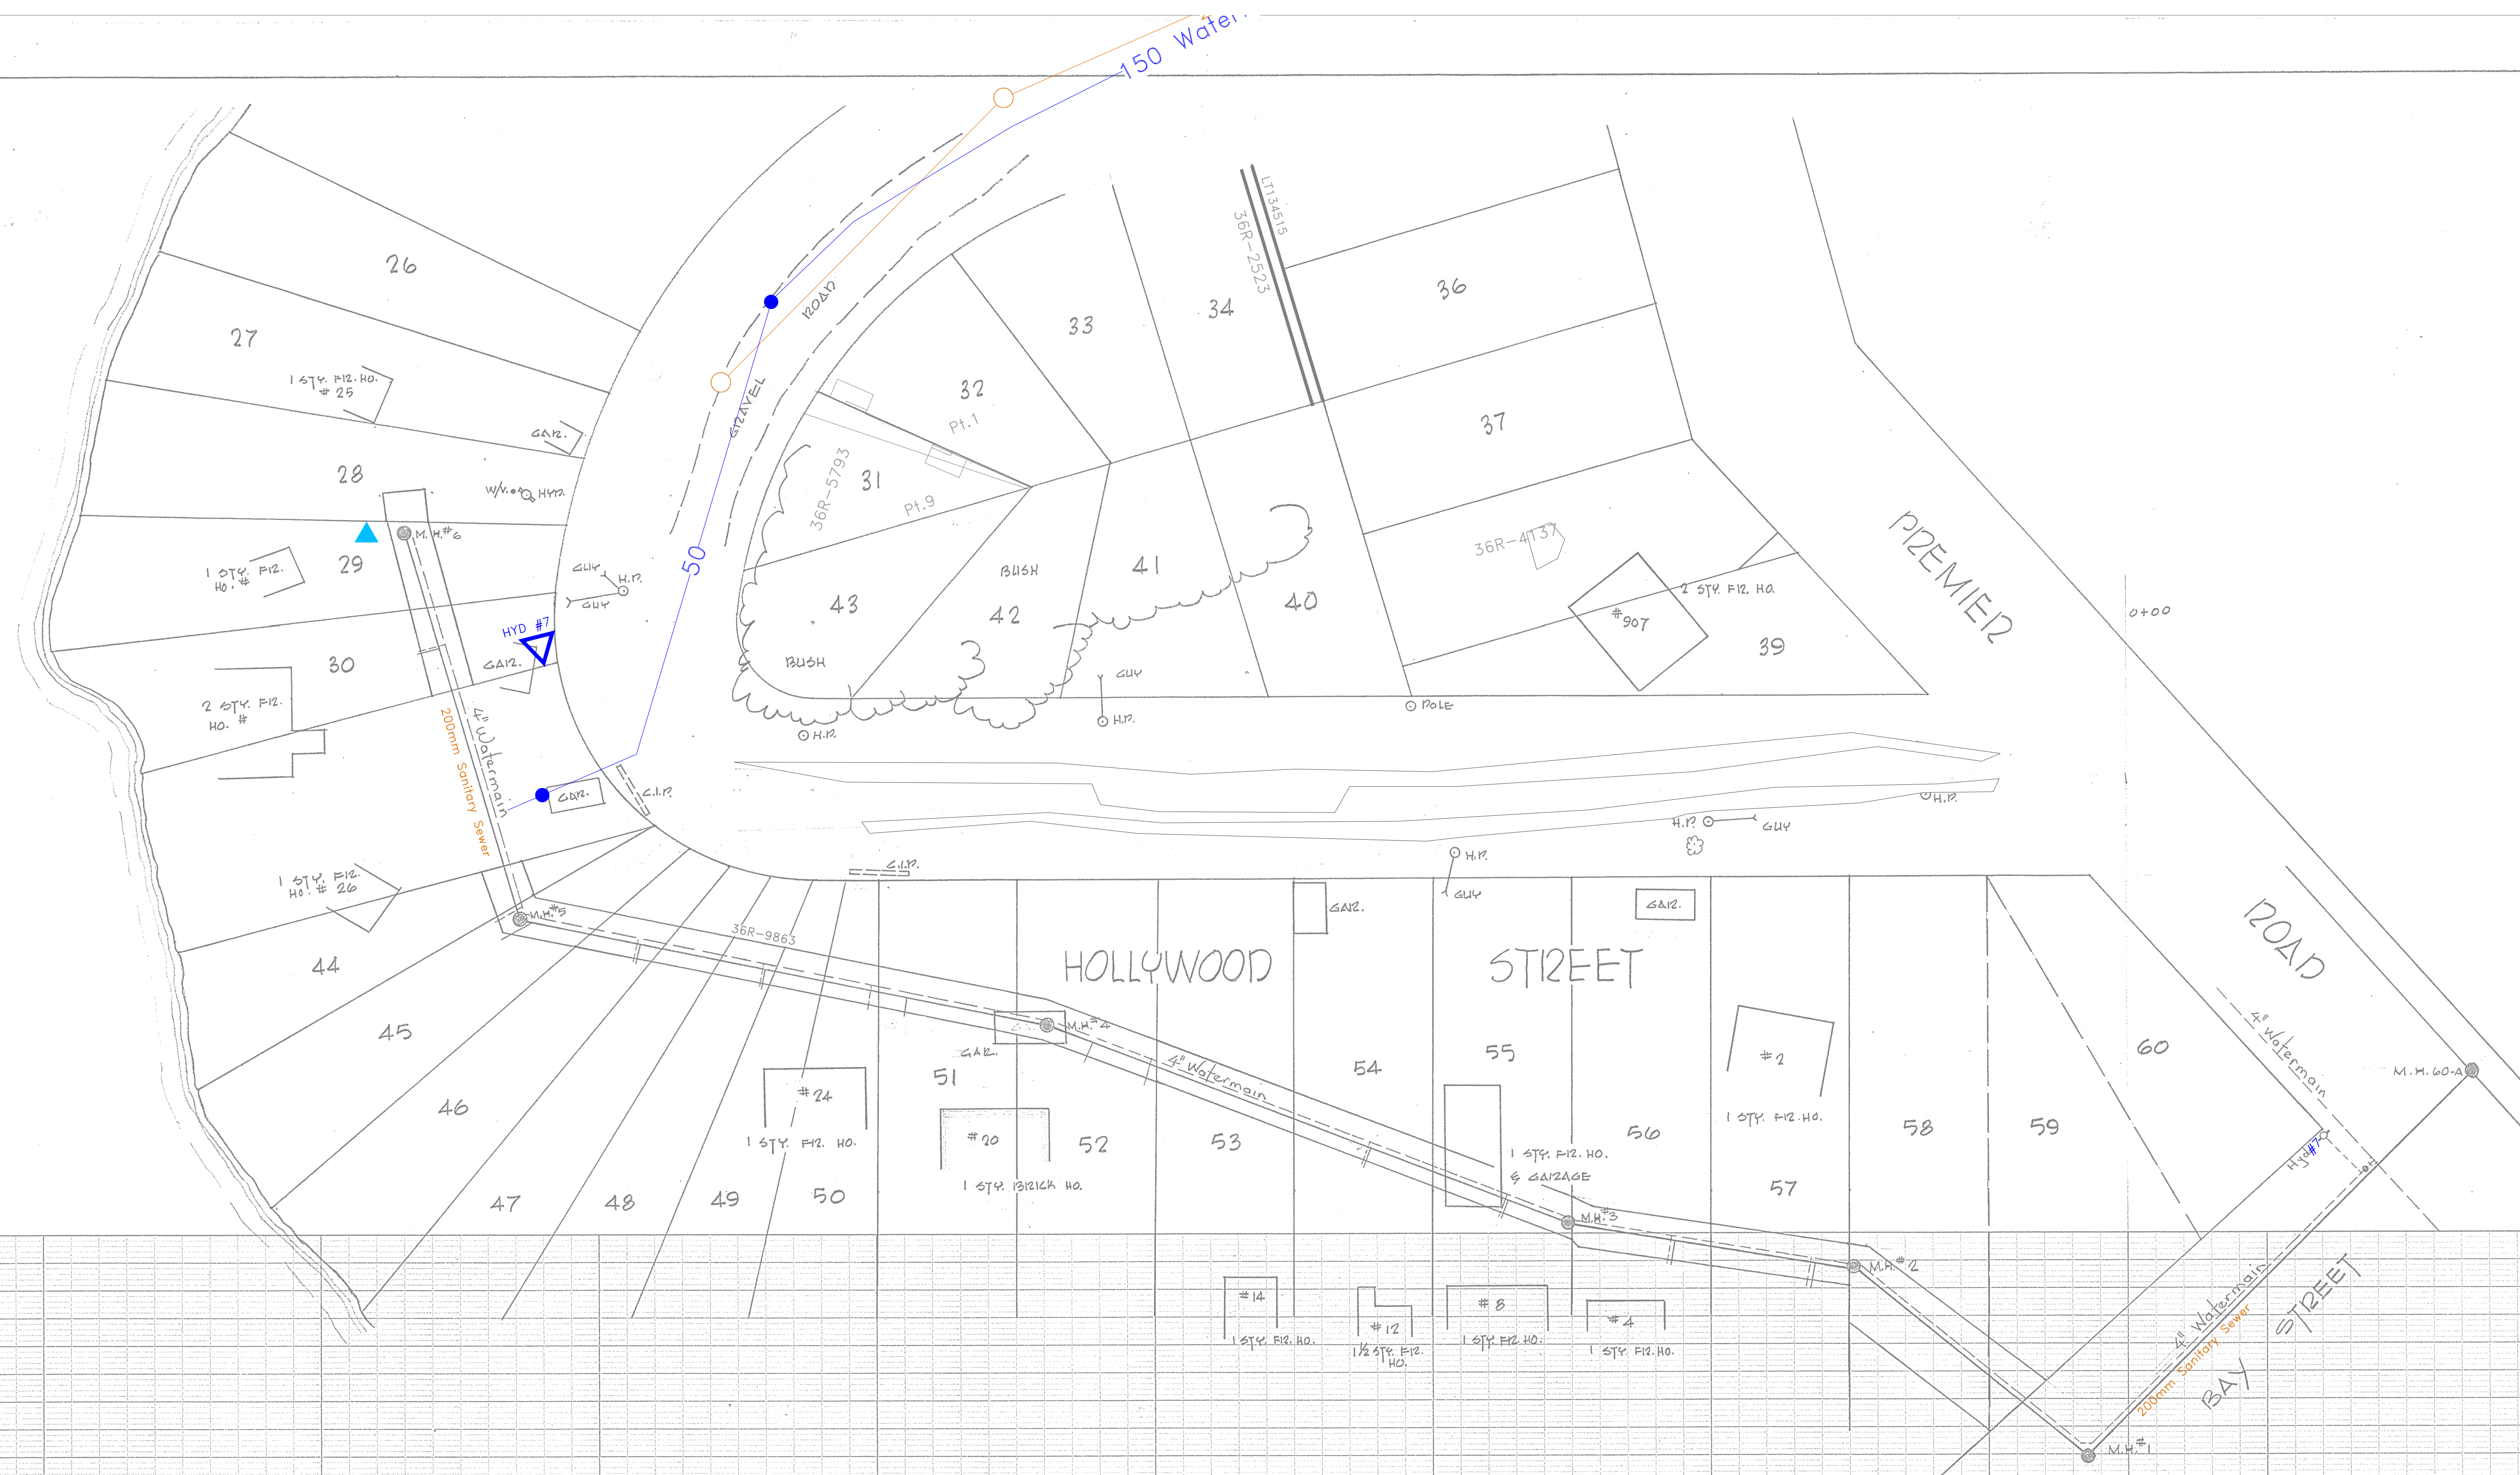

SCALE: 1 INCH = 40 FT.

SCALE:
HORIZ. 1 IN. = 40 FT.
VERT. 1 IN. = 4 FT.

DISCLAIMER

The information contained on this drawing may be based upon data provided by others and may not have been verified by either as-constructed drawings or an Ontario Land Surveyor. The City of North Bay cannot accept responsibility for any errors or omissions on any information shown herein. Field verification, land surveys or excavation (with City approval) may be required to determine actual location of any and all utilities or property lines.


Note: For information on San Sewer 300 W. Farnis Service TIES

EASEMENT PROFILE

ROAD PROFILE

ROAD PROFILE

EASEMENT PROFILE

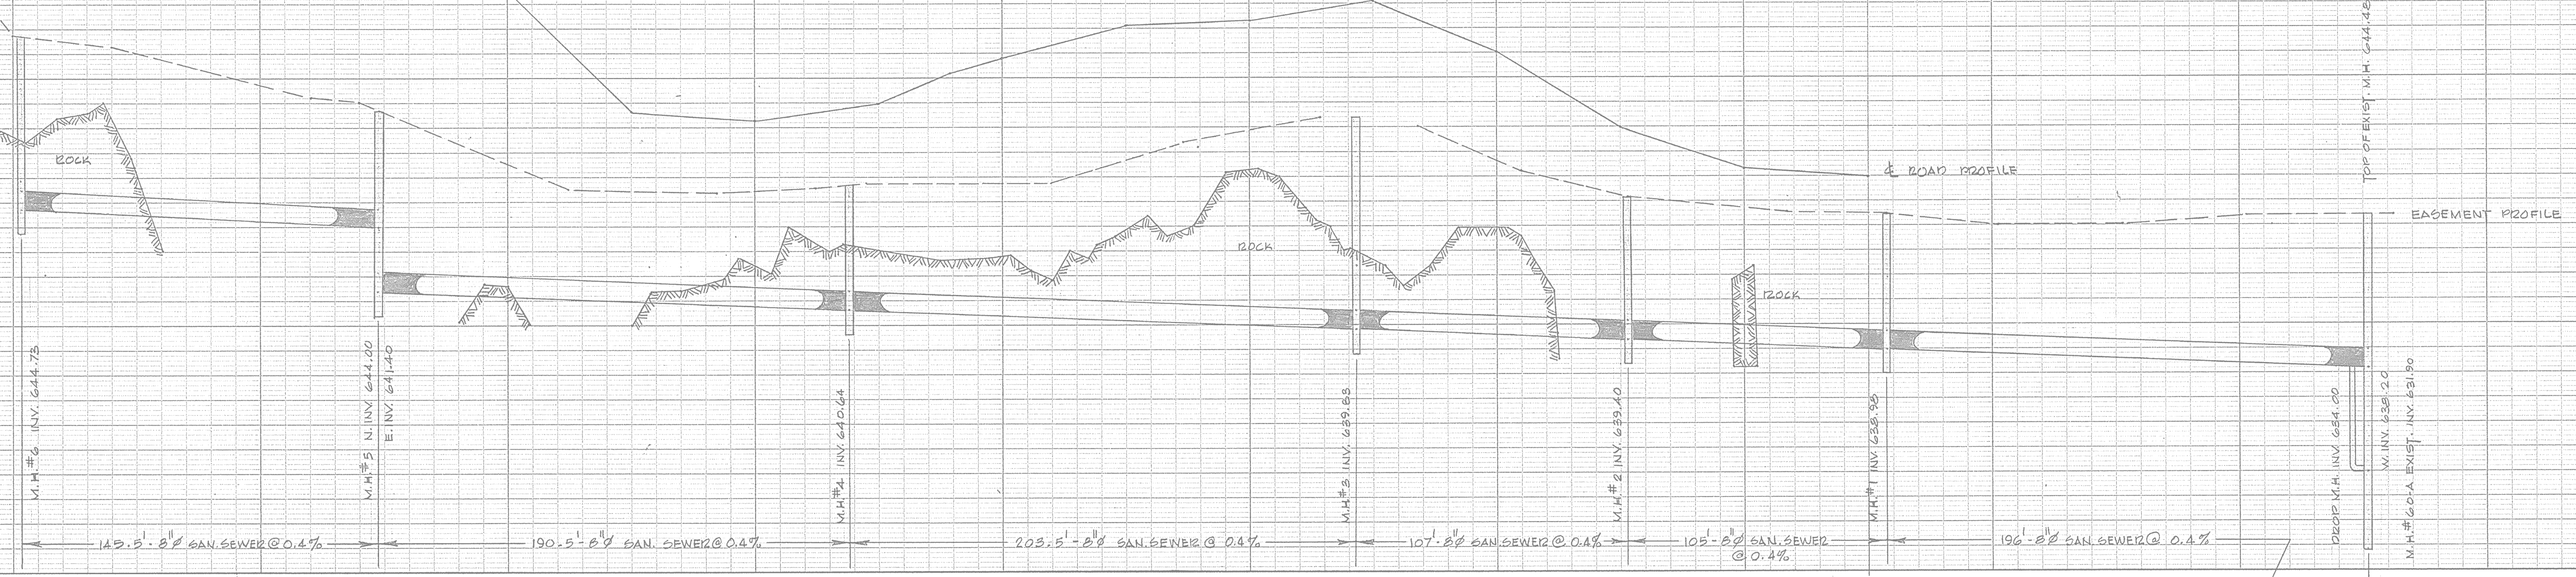

CORPORATION CITY OF NORTH BAY - ONTARIO			
HOLLYWOOD STREET			
PREMIER ROAD TO BAY STREET			
BENCH MARK			
DATE	REVISIONS	BY	CHKD.
JAN. 1989	AS CONVT. SAN SEWER	E.P.	P. D.
DRAWN BY			
Bryan Duke			
DATE			
JUNE 12/88	AS NOTED	175	H-276

KEUFFEL & ESSER CO.
NEW YORK

TRADE STANDARD MARK
REGISTERED OFF.
PROFILE, PLATE A 4 X 20
MADE IN U.S.A.

KEUFFEL & ESSER CO.
NEW YORK

TRADE STANDARD MARK
REGISTERED OFF.
PROFILE, PLATE A 4 X 20
MADE IN U.S.A.

KEUFFEL & ESSER CO.
NEW YORK

H-276