
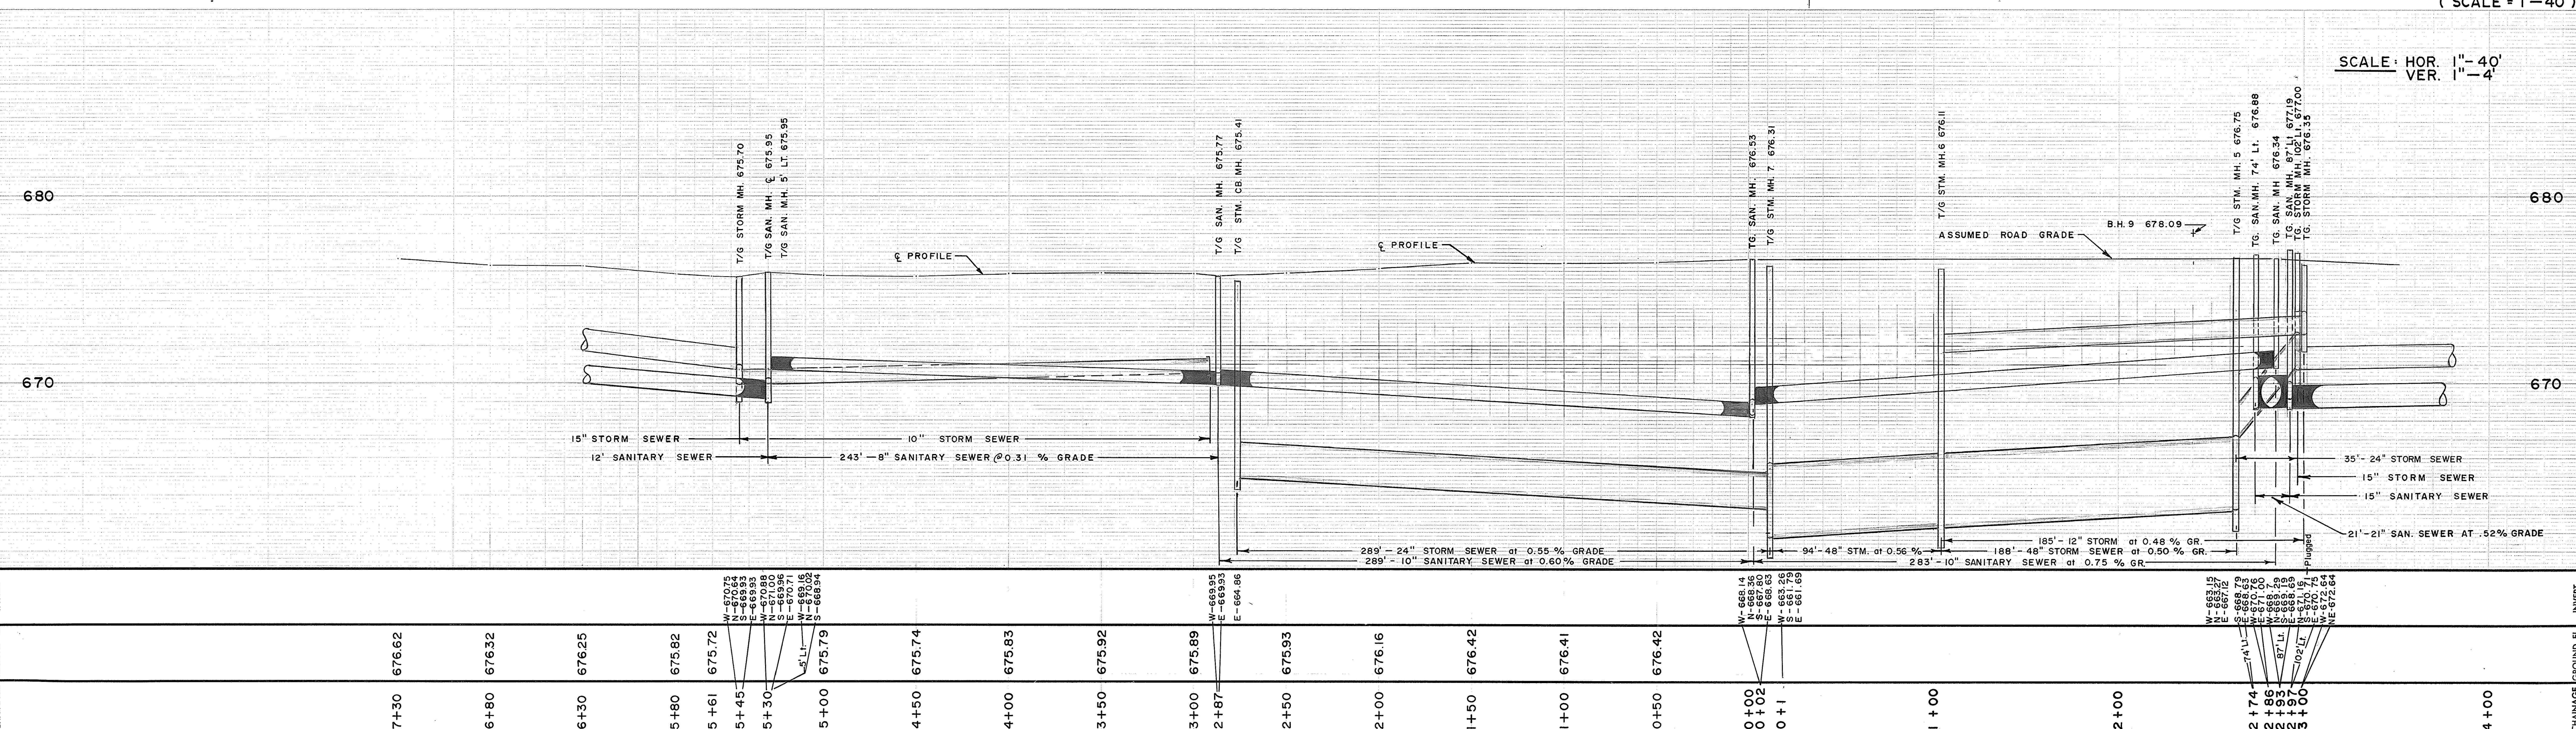


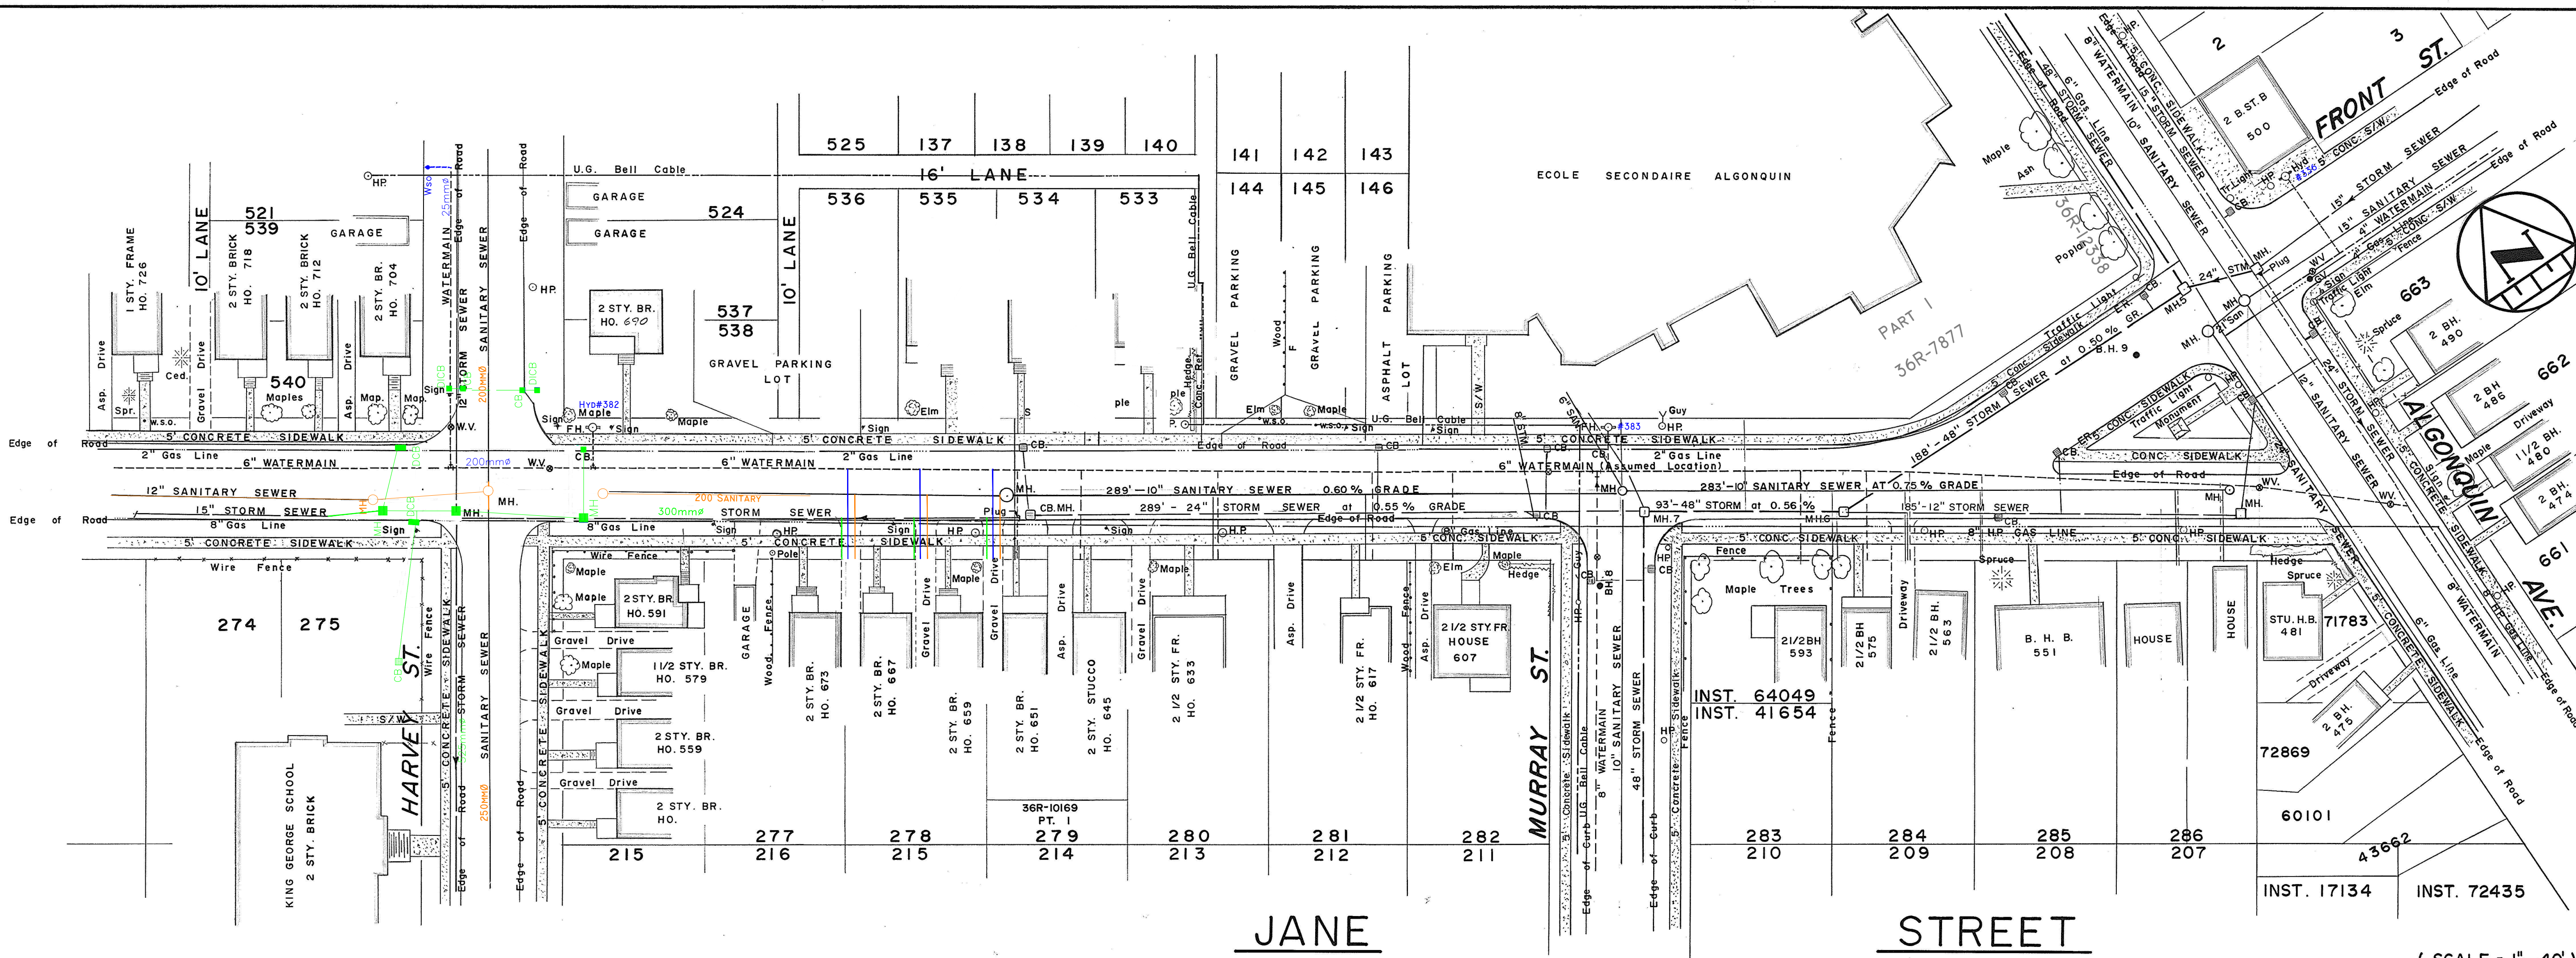

NOTES:	1. NEW DRAWING				MAR. 77		R.F.B.		APPROVED				
	2. ADDED FROM MURRAY ST. TO HARVEY ST.				APR. 78		A.P.						
DISCLAIMER	3. PLOTTED EXISTING HYD. AT MURRAY ST.				AUG. 78		J.D.M.						
	4. AS CONSTRUCTED CONTRACT 123-79				NOV. 80		J.D.M.						
The information contained on this drawing may be based upon data provided by others and may not have been verified by either as-constructed drawings or an Ontario Land Surveyor. The City of North Bay cannot accept responsibility for any errors or omissions on any information shown herein. Field verification, land surveys or excavation (with City approvals) may be required to determine actual location of any and all utilities or property lines.	5. CORRECTED HARVEY INTERSECTION DETAIL				OCT. 13		G.W.C.						
D.M.C. 1/0'	No.				REVISION		DATE		INITIAL				
JANE STREET ALGONQUIN AVENUE TO MURRAY STREET REG'D PLAN N ^o . 77, 64, 13.										CITY OF NORTH BAY ENGINEERING DEPARTMENT SCALE: AS SHOWN DATE: MAR. 77.			
DRAWN BY: Rick B. CKD. BY:										FIELD BOOK No. 245 B 250		DRAWING No. J-101	