
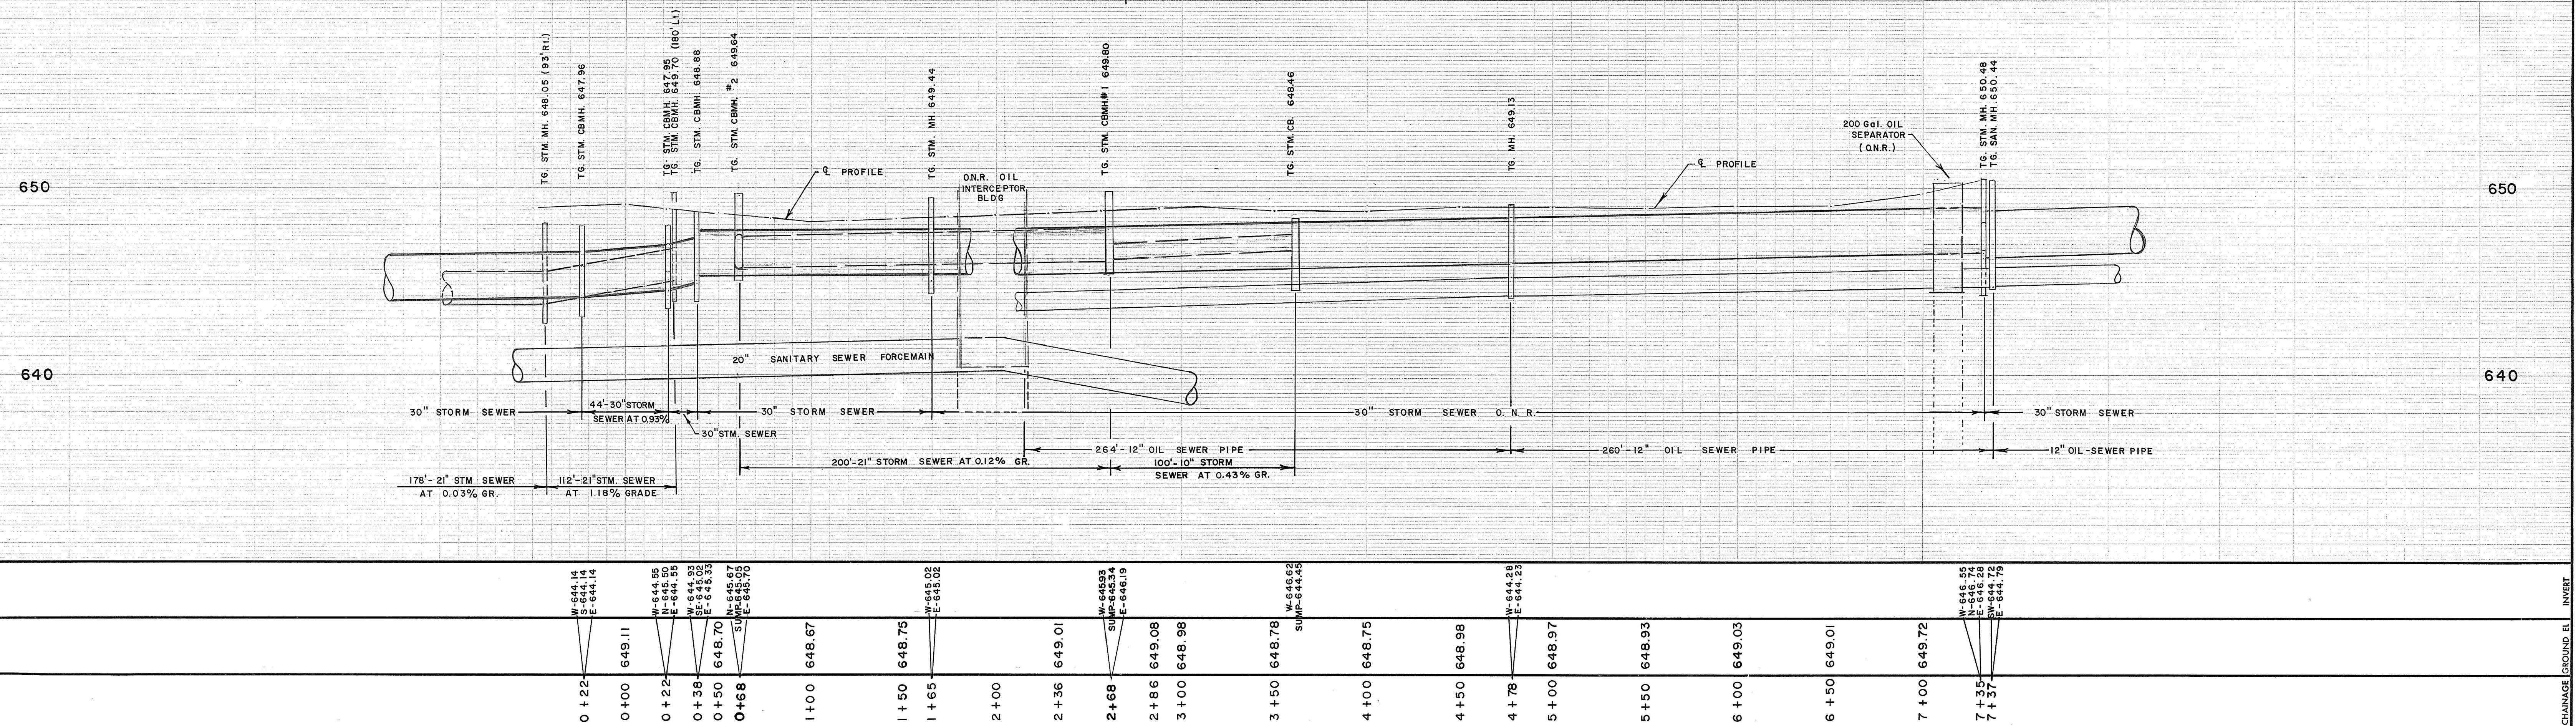


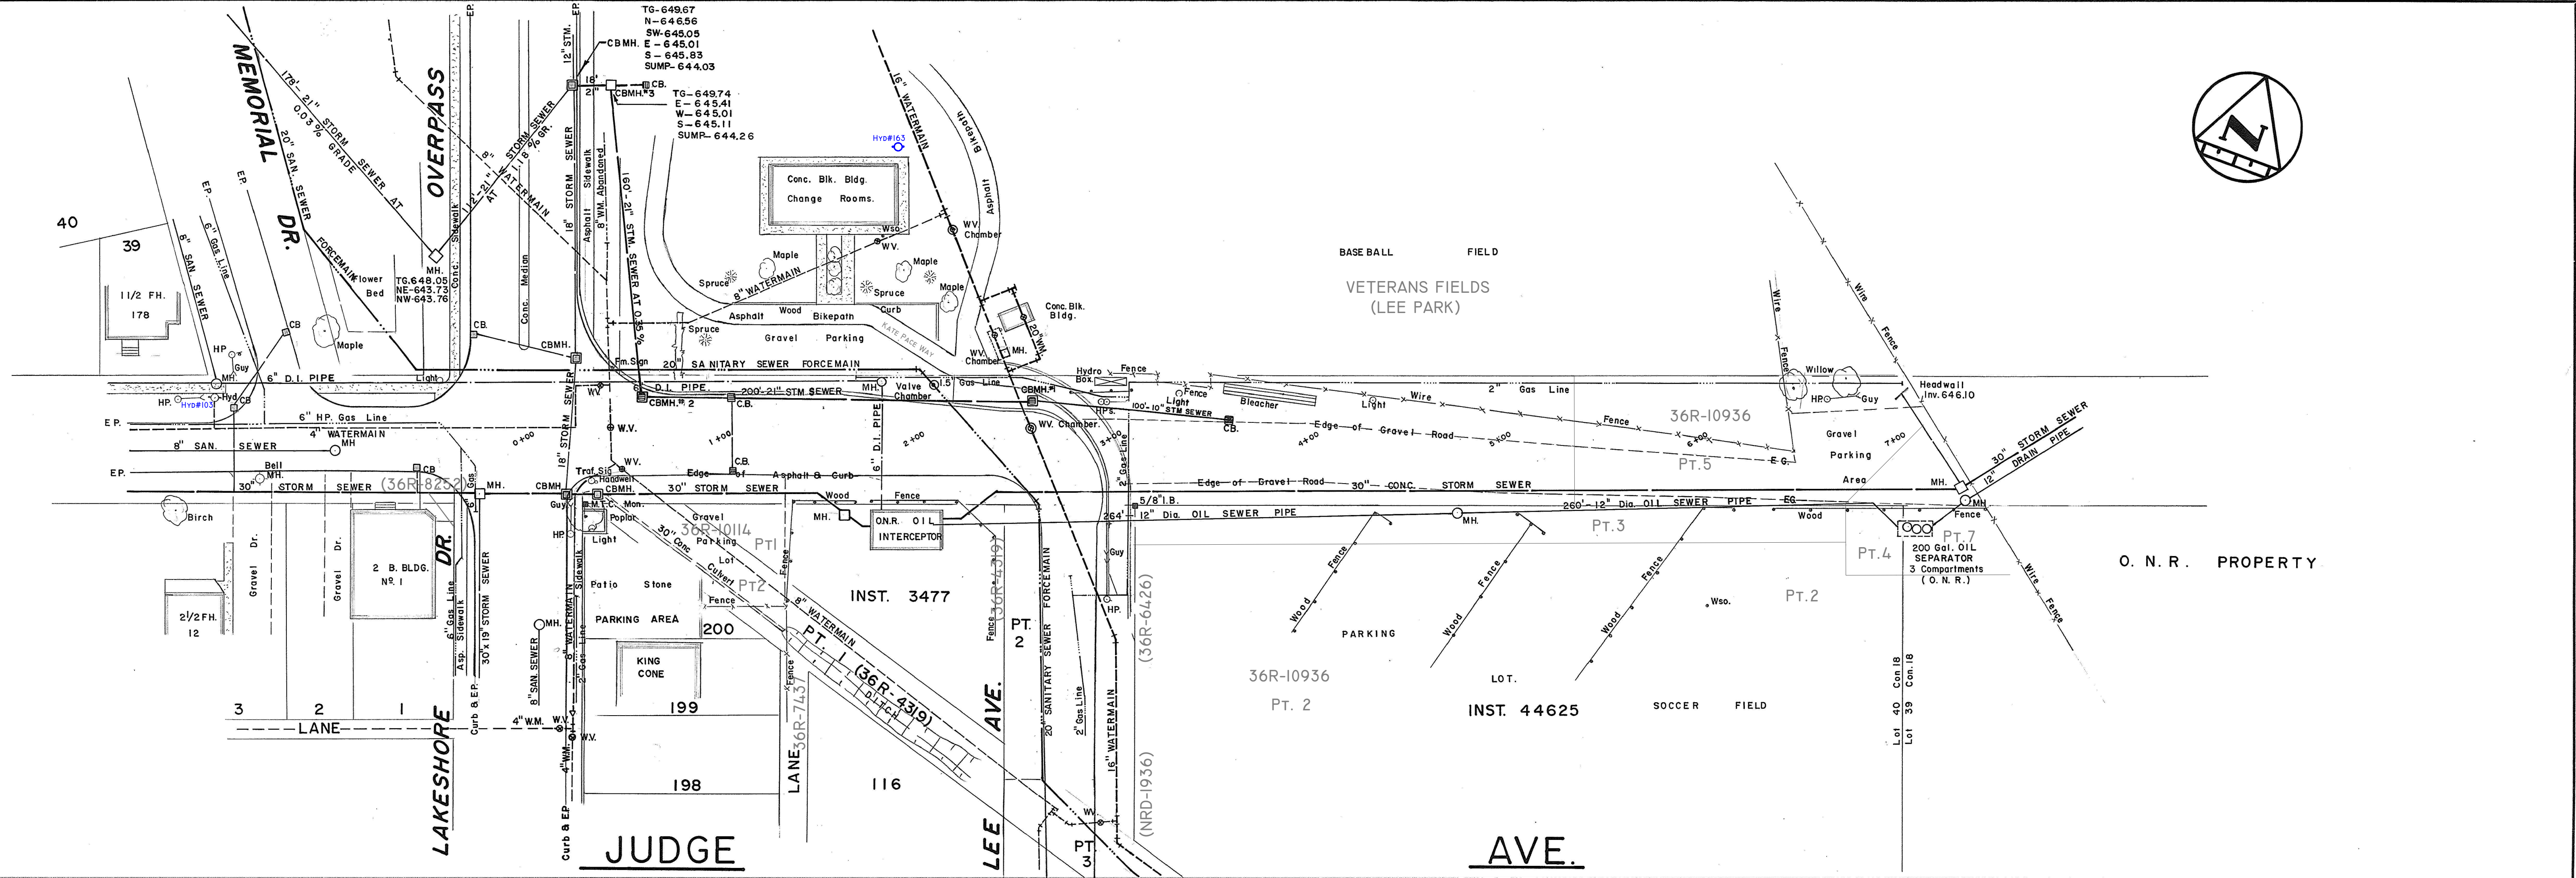

NOTES:

DISCLAIMER

The information contained on this drawing may be based upon data provided by others and may not have been verified by either as-constructed drawings or an Ontario Land Surveyor. The City of North Bay cannot accept responsibility for any errors or omissions on any information shown herein. Field verification, land surveys or excavation (with City approvals) may be required to determine actual location of any and all utilities or property lines.

1.	REVISED CURB and BIKEPATH N. SIDE OF JUDGE	March '01	J.STR
2.	UPDATED LEGAL, ADDED FH AND LABELS	MARCH '15	G.W.C.
No.	REVISION	DATE	INITIAL

JUDGE AVENUE	
MEMORIAL DR. TO O.N.R. PROPERTY	

CITY OF NORTH BAY	
ENGINEERING DEPARTMENT	
SCALE: HOR. 1"= 40'	DATE: JUNE 83.
VER. 1"= 4'	
DRAWN BY: Rick B. CK'D. BY:	FIELD BOOK No. 267
DRAWING No. J-28	REV.