
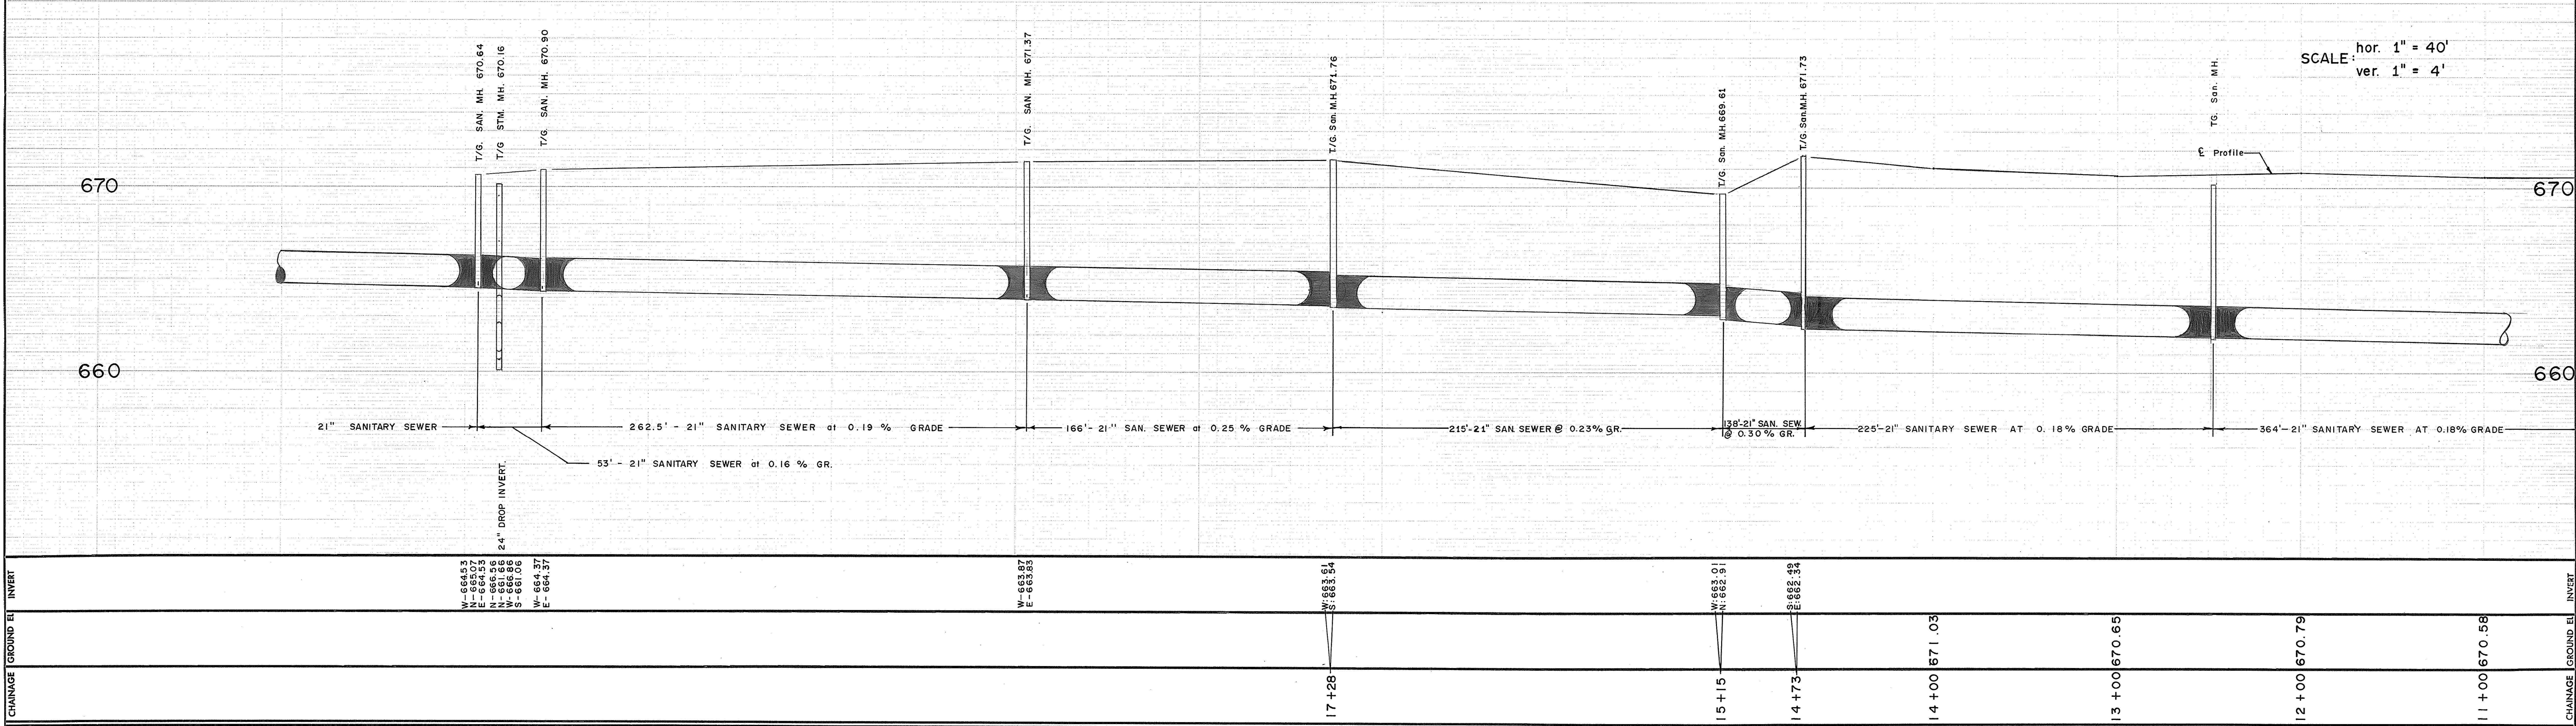
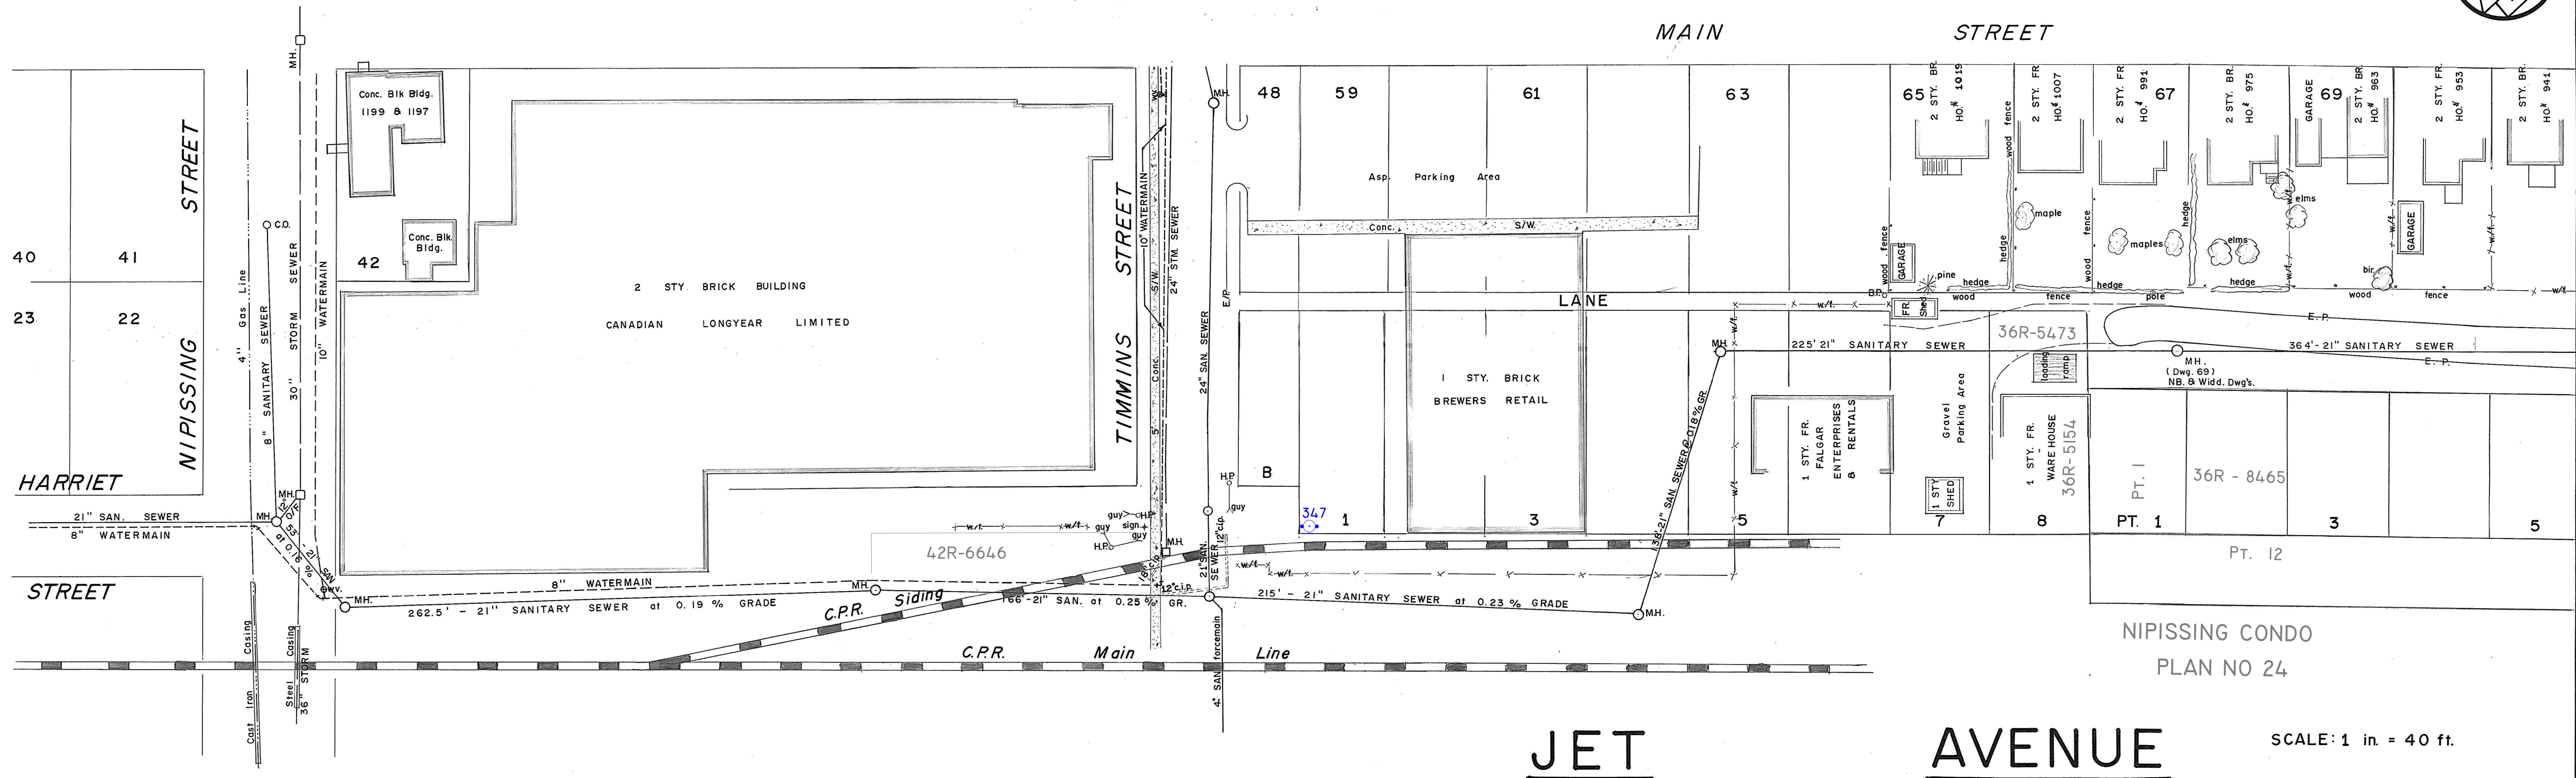


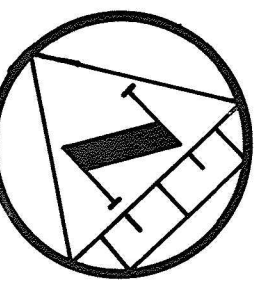

NOTES:	DISCLAIMER The information contained on this drawing may be based upon data provided by others and may not have been verified by either as-constructed drawings or an Ontario Land Surveyor. The City of North Bay cannot accept responsibility for any errors or omissions on any information shown herein. Field verification, land surveys or excavation (with City approval) may be required to determine actual location of any and all utilities or property lines.			
				
DMC: Wp	NEW DRAWING			
	21" SAN. LOCATION BEHIND LONGYEAR		FEB / 80	j.d.m.
	REGISTERED PLANS ADDED		OCT 2008	R.J.O.
No.	REVISION		DATE	INITIAL
		24/5/74 G.W.R.		APPROVED
		JET AVENUE		
		ELEVENTH ST. TO TIMMINS ST		
		REG.D. PLAN N° 36R-3357		
		13		
		38		
		CITY OF NORTH BAY		
		ENGINEERING DEPARTMENT		
		SCALE: AS SHOWN		DATE: MAY 1974
		DRAWN BY: G.W.R.		FIELD BOOK NO.
		CK'D. BY:		234
				J-53