
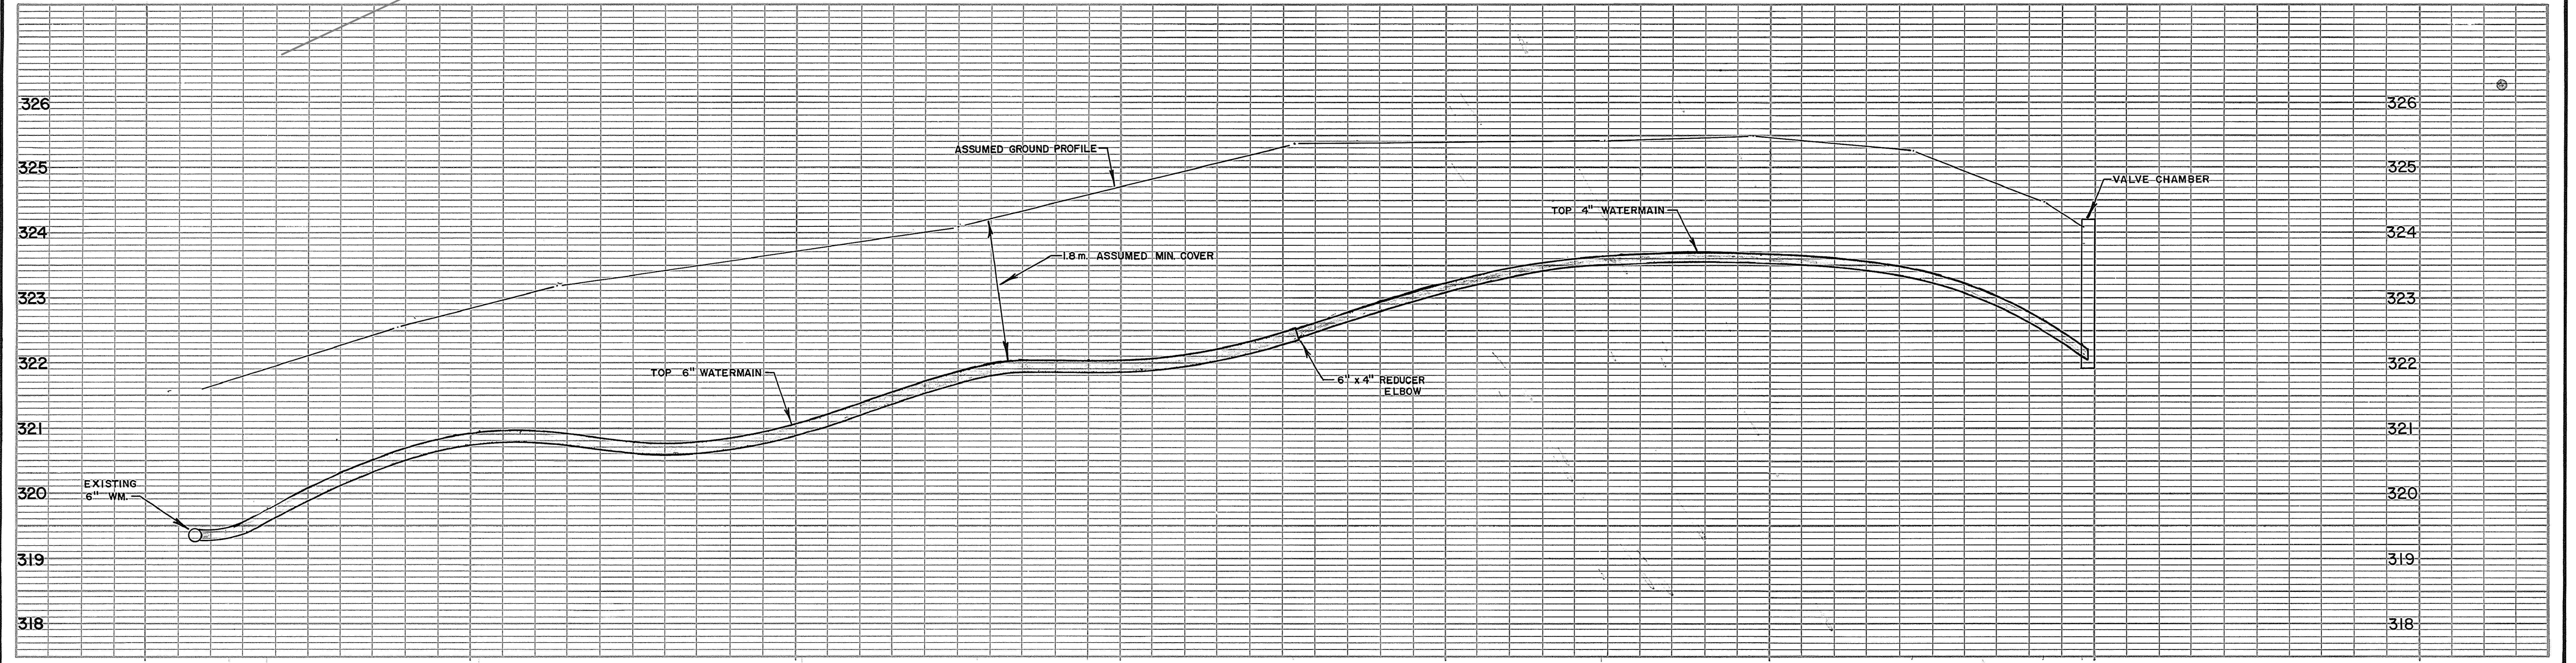


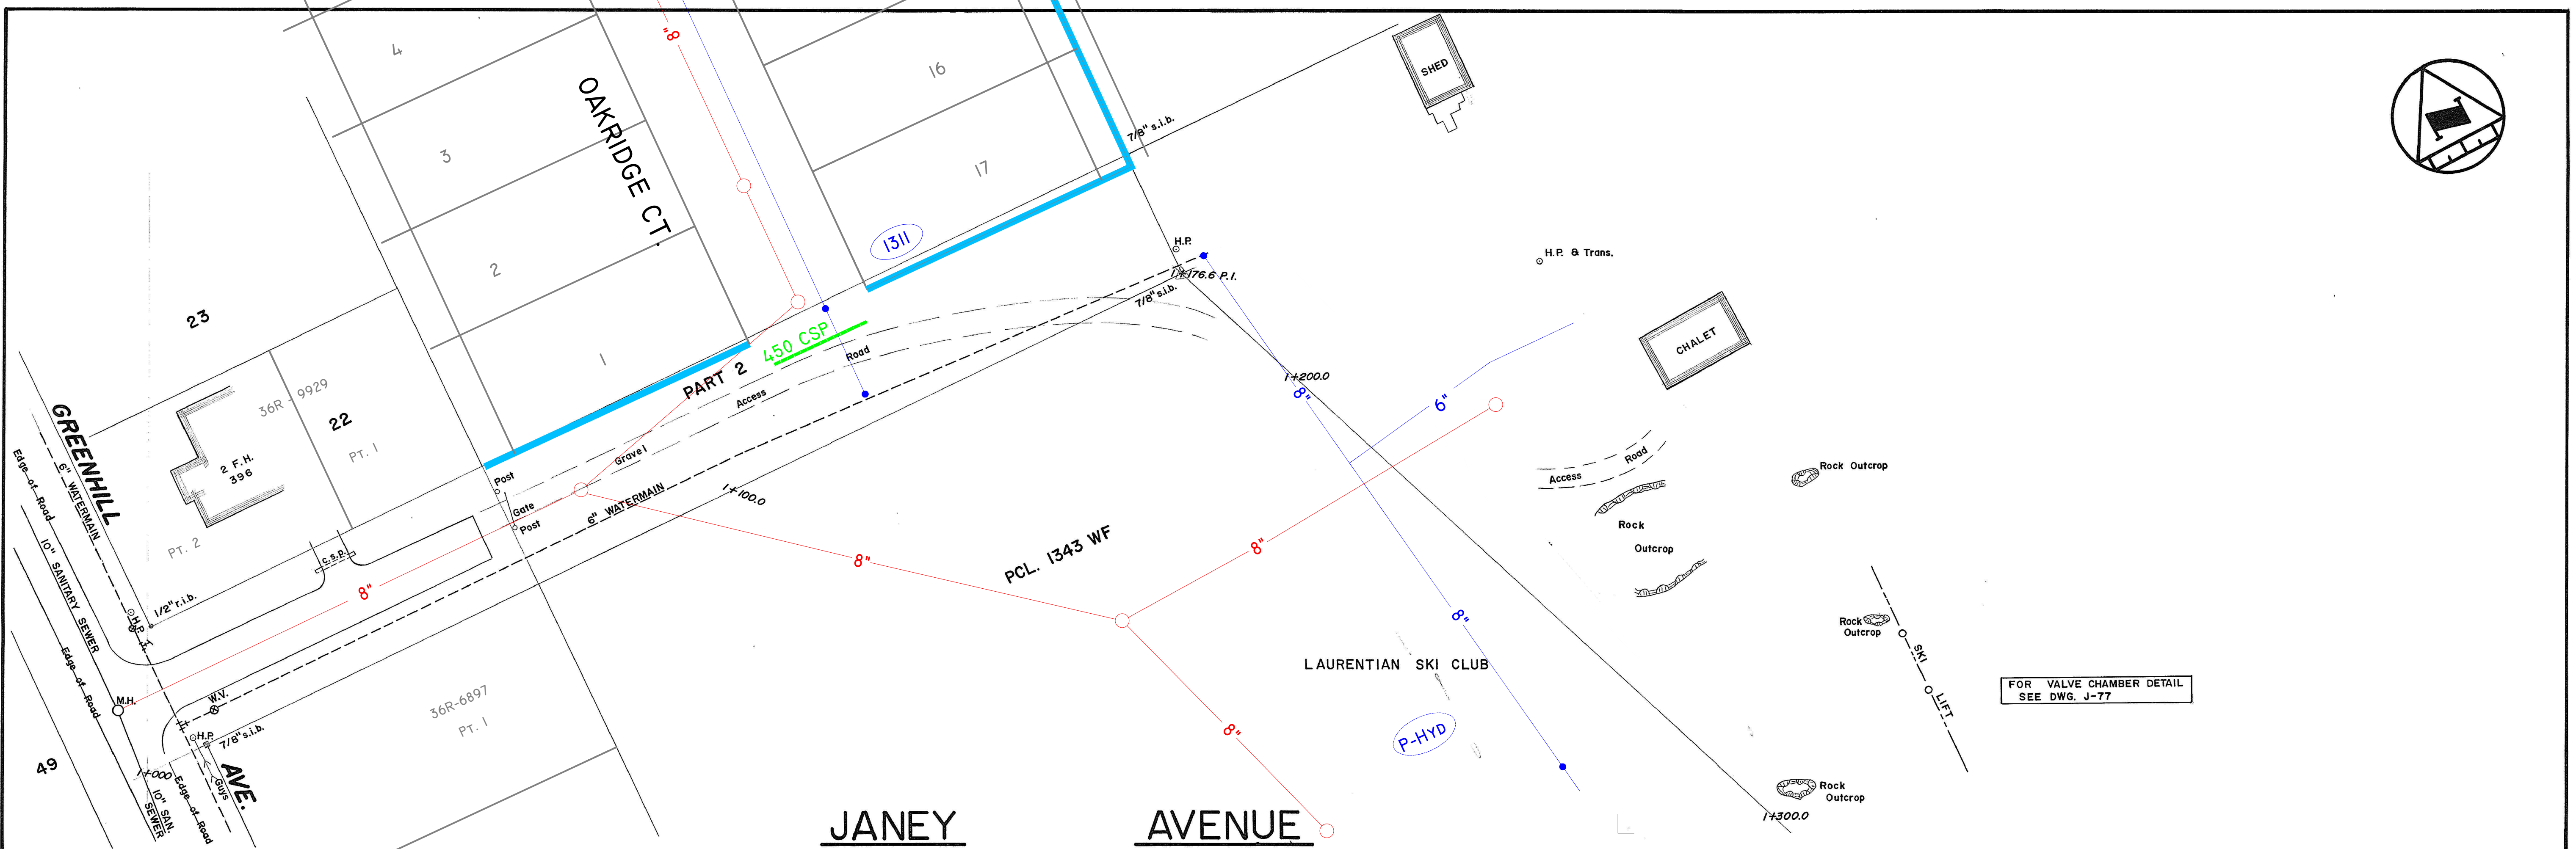

CHAINAGE	TOP WM ELEVATION	CHAINAGE	TOP WM ELEVATION
1+000.0		1+200.0	
1+007.6	319.464	1+224.0	323.615
1+012.7	319.481	1+250.0	
1+018.6	319.771	1+271.9	323.460
1+051.4	320.949	1+292.0	322.665
1+101.0	321.081	1+298.8	322.293
1+128.0	321.989		
1+143.0	322.040		
1+150.0			

NOTES

DISCLAIMER

The information contained on this drawing may be based upon data provided by others and may not have been verified by either as-constructed drawings or an Ontario Land Surveyor. The City of North Bay cannot accept responsibility for any errors or omissions on any information shown herein. Field verification, land surveys or excavation (with City approvals) may be required to determine actual location of any and all utilities or property lines.

Prepared By: CITY OF NORTH BAY
ENGINEERING DEPARTMENT

200 MCINTYRE ST. E.
NORTH BAY, ONTARIO
474-0400

No.	REVISION	DATE	INITIAL
1.	AS CONST. WATERMAIN 1984 BK.278	DEC. 84	J.S.
2.	REGISTERED PLANS, SAN. WATER ADDED	OCT 2008	R.J.O.

Drawn By: J.S.	SCALE: METRIC	DATE: DEC. 84	DRAWING NO. J-80
Ck'd. By: R.B.	Hor. - 1 : 500 Ver. - 1 : 50		

CITY OF NORTH BAY

ENGINEERING DEPARTMENT

JANEY AVENUE

GREENHILL AVE. to END