

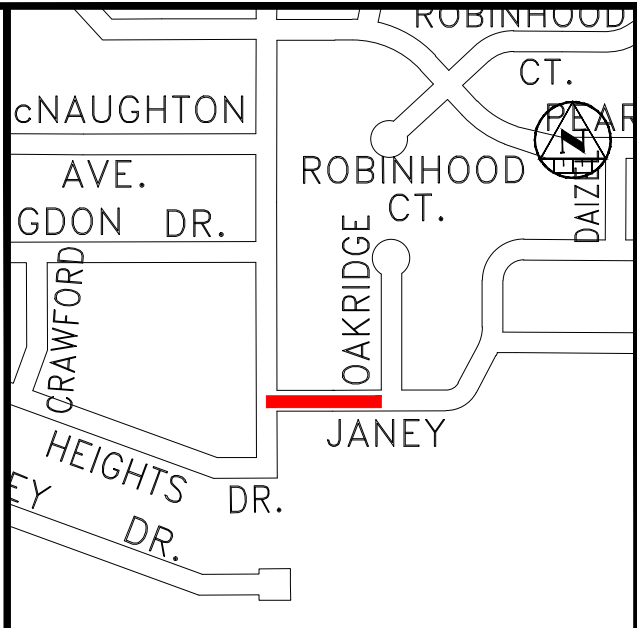
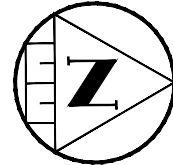


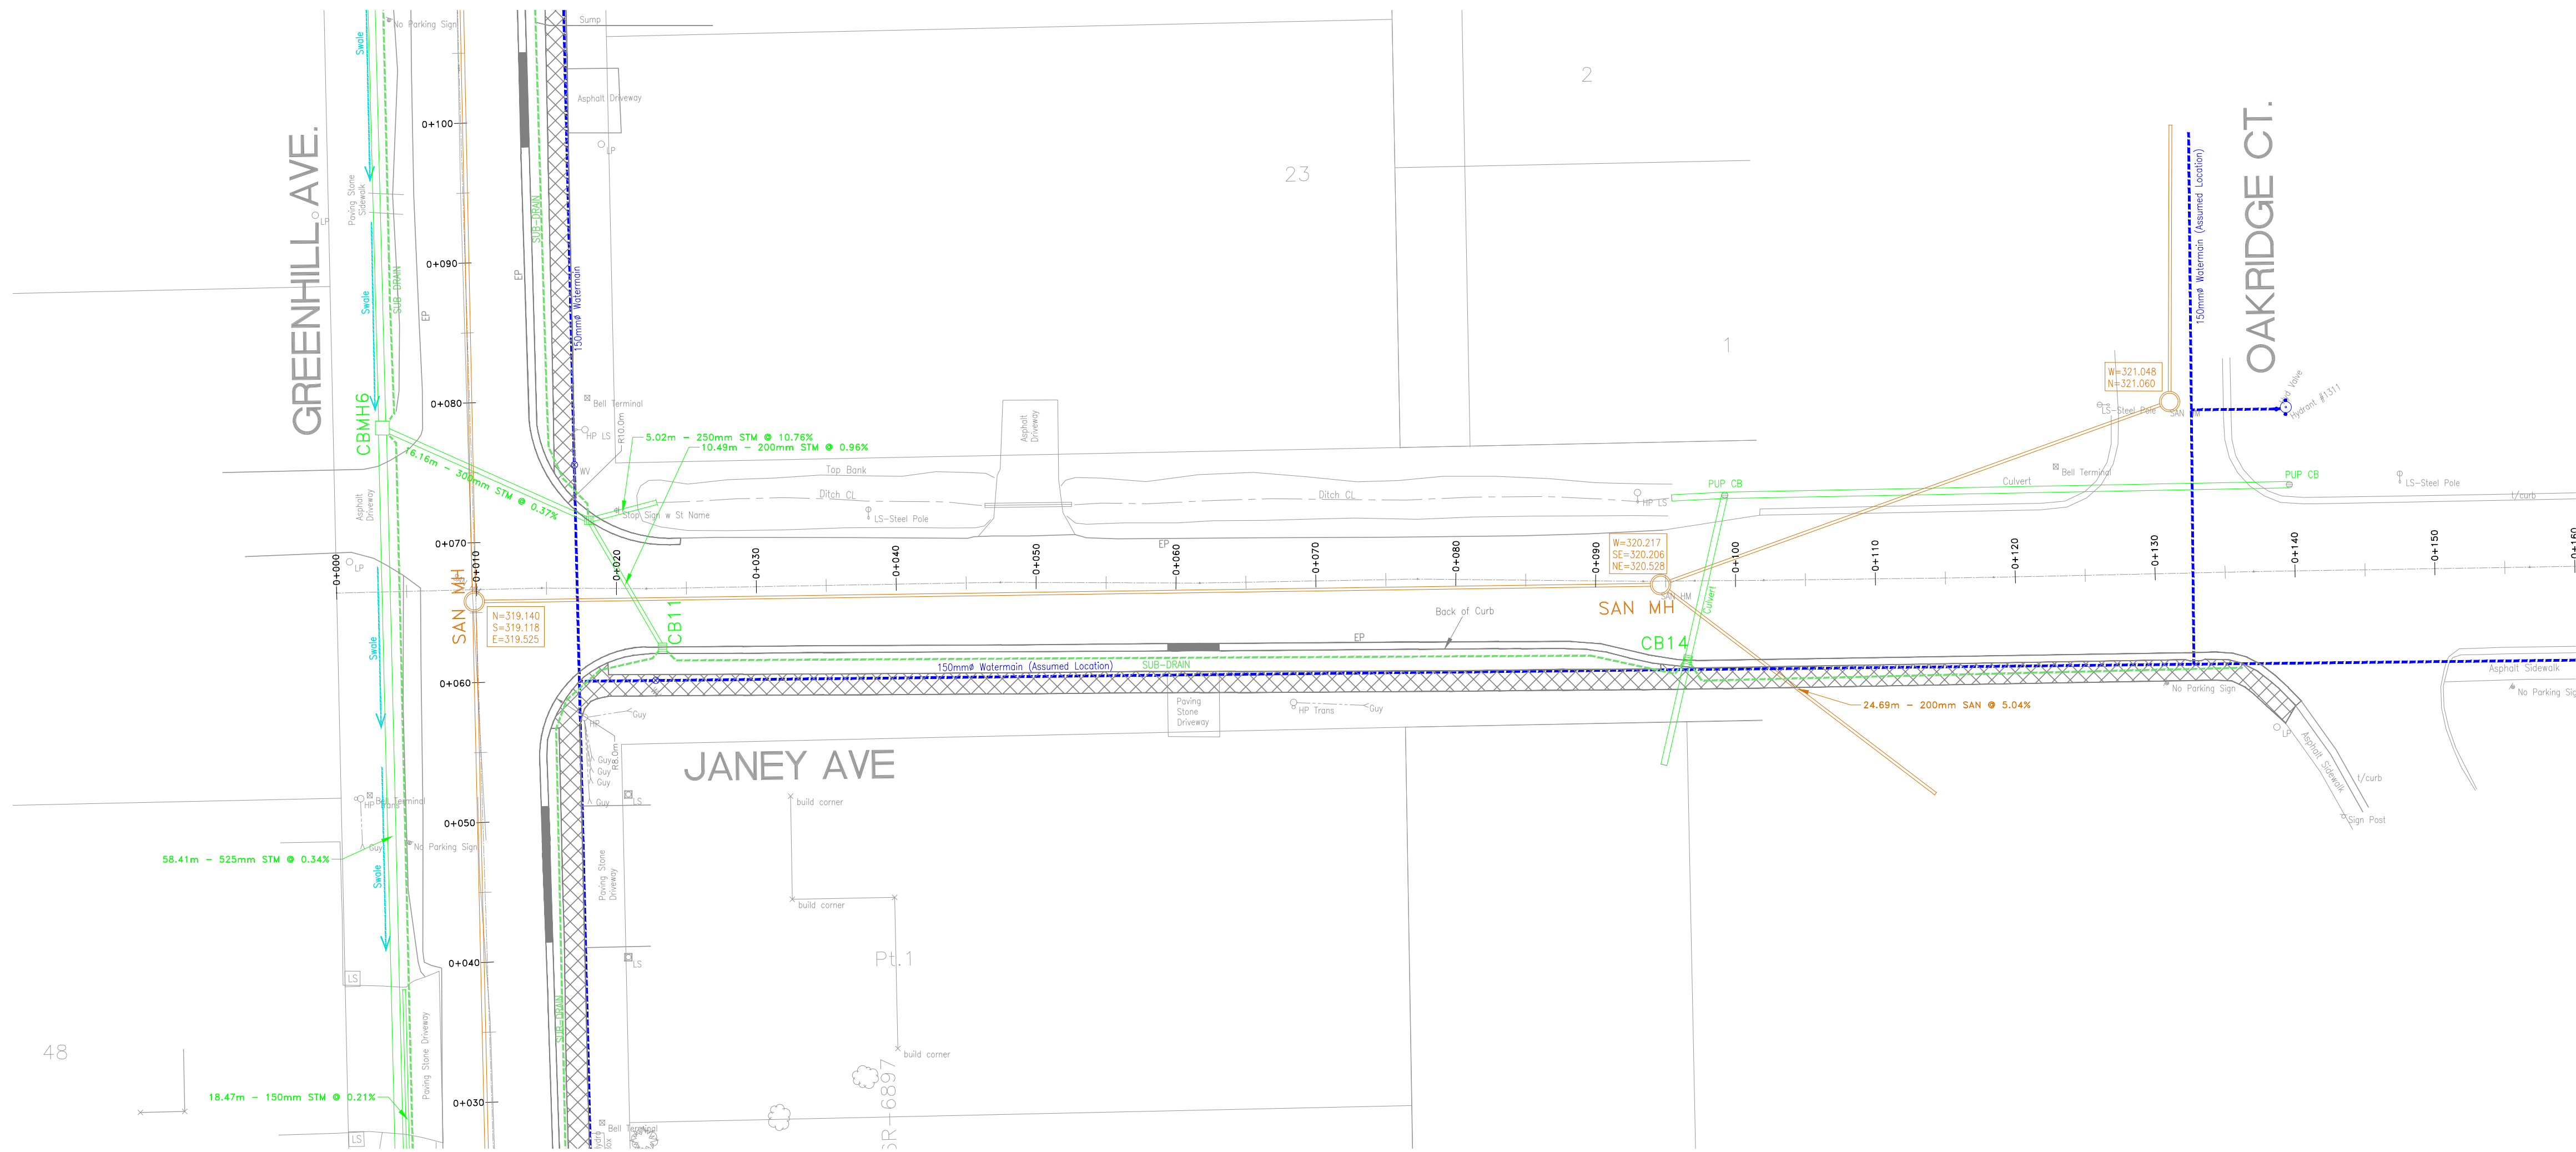

- KEY PLAN  
LEGEND
- STORMWATER PIPE
  - Sanitary Pipe
  - Watermain & Valve
  - Lot / Concession Lines
  - STORM LINES
  - CATCH BASIN
  - STORM MANHOLE
  - CATCHBASIN MANHOLE
  - Sanitary Manhole
  - Edge of Pavement
  - CURB & GUTTER WITH DROP
  - Hydro Pole/Light
  - San service w c/o
  - Water service w WSO
  - CONCRETE SIDEWALK
  - SUB-DRAIN

REVISIONS

| no. | date  | by  | description |
|-----|-------|-----|-------------|
| 1   | 06/19 | GWC | As-Built    |
|     |       |     |             |
|     |       |     |             |
|     |       |     |             |
|     |       |     |             |

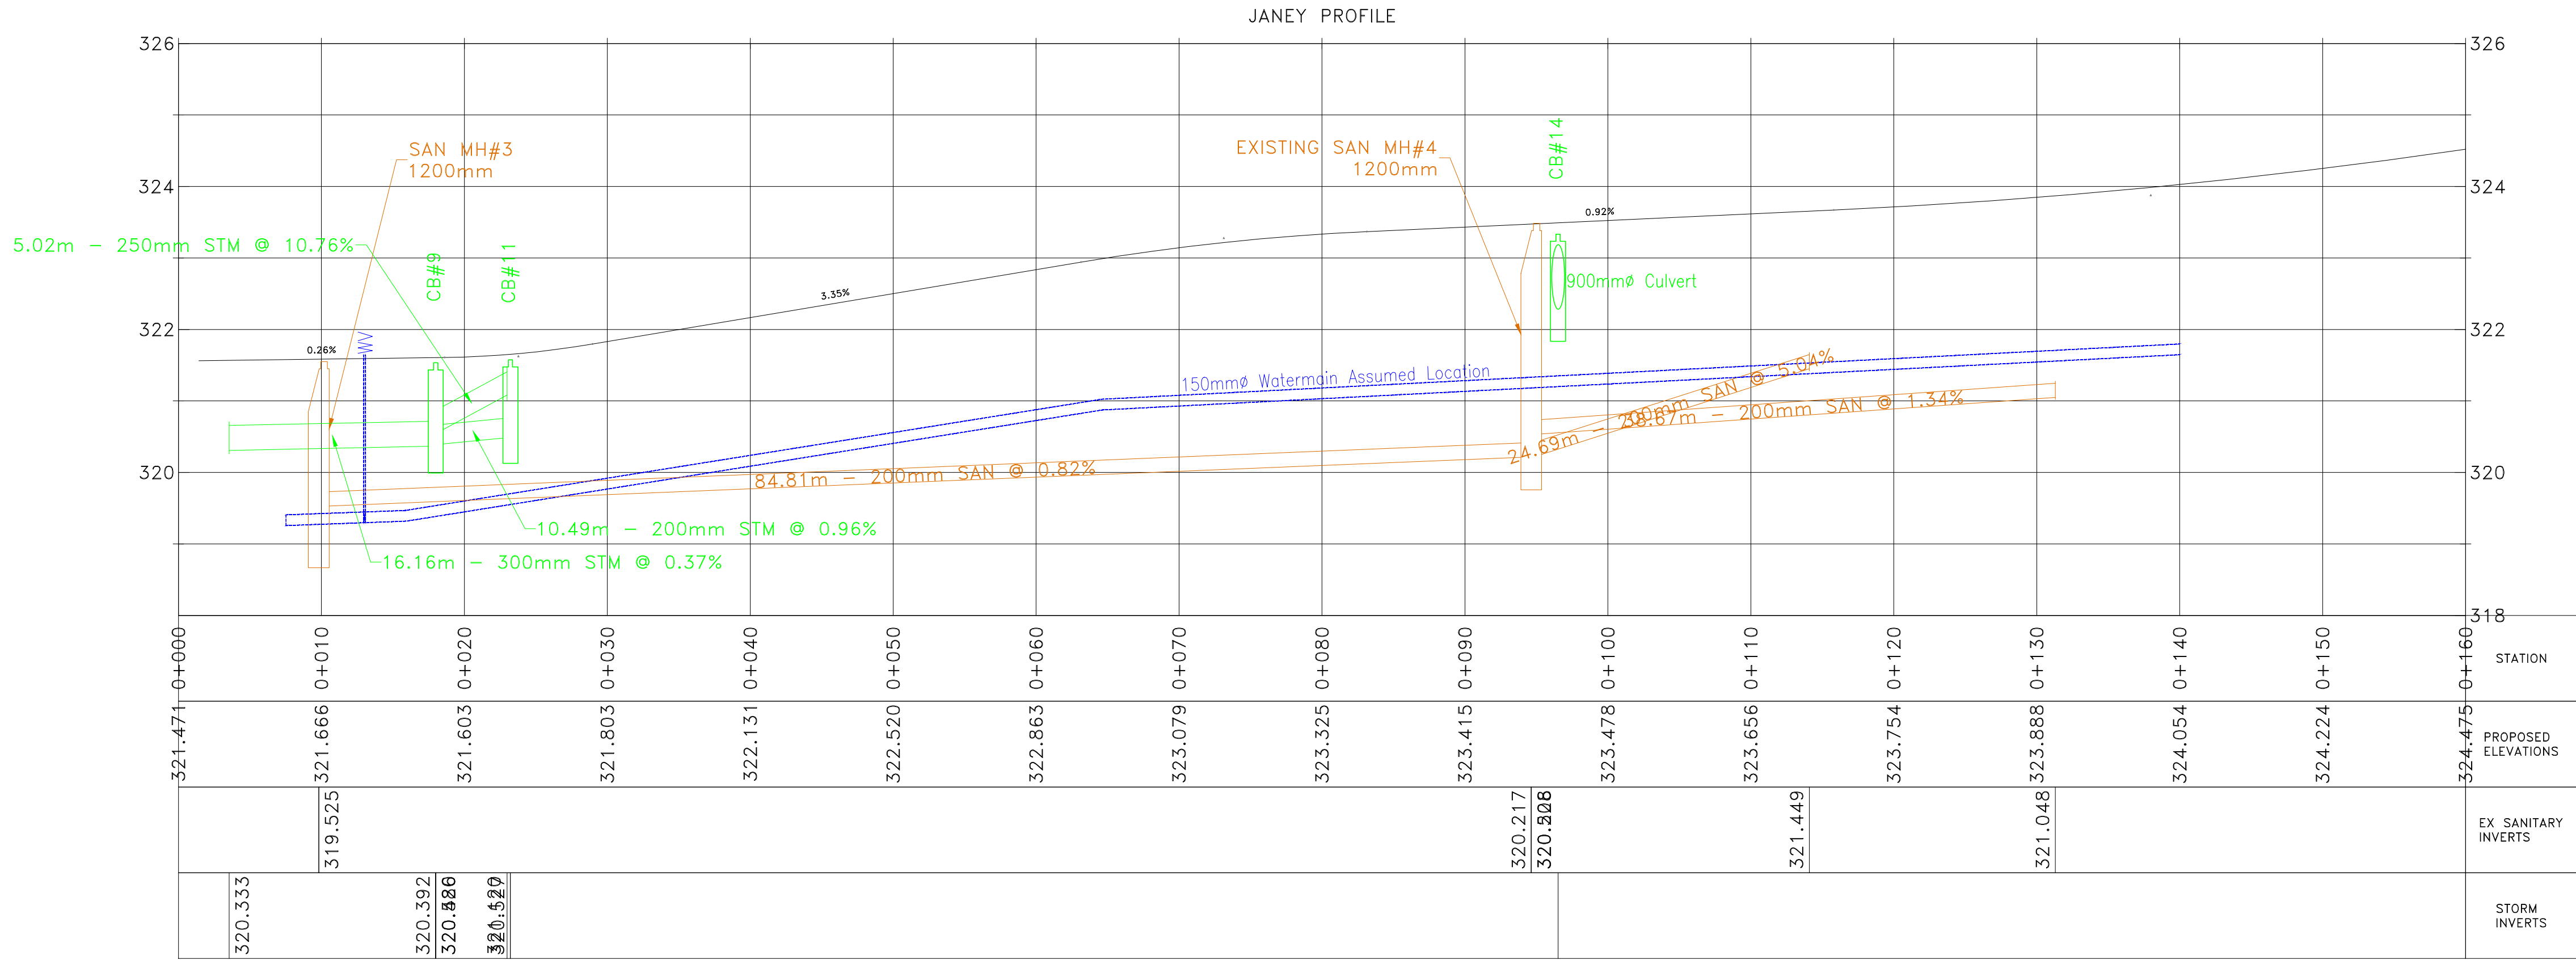

SIDEWALK AND  
DITCHING  
JANEY AVE

AS-BUILT

JANEY

Sta: 0+000 to 0+160

|                         |                        |
|-------------------------|------------------------|
| designer<br>G.W.C./G.M. | drawn by:<br>G.W.C.    |
| checked by:<br>G.M.     | approved by:<br>R.G.P. |

|       |  |
|-------|--|
| scale |  |
|-------|--|

|                    |                        |
|--------------------|------------------------|
| date<br>09/13/2016 | drawing number<br>J-81 |
|--------------------|------------------------|