



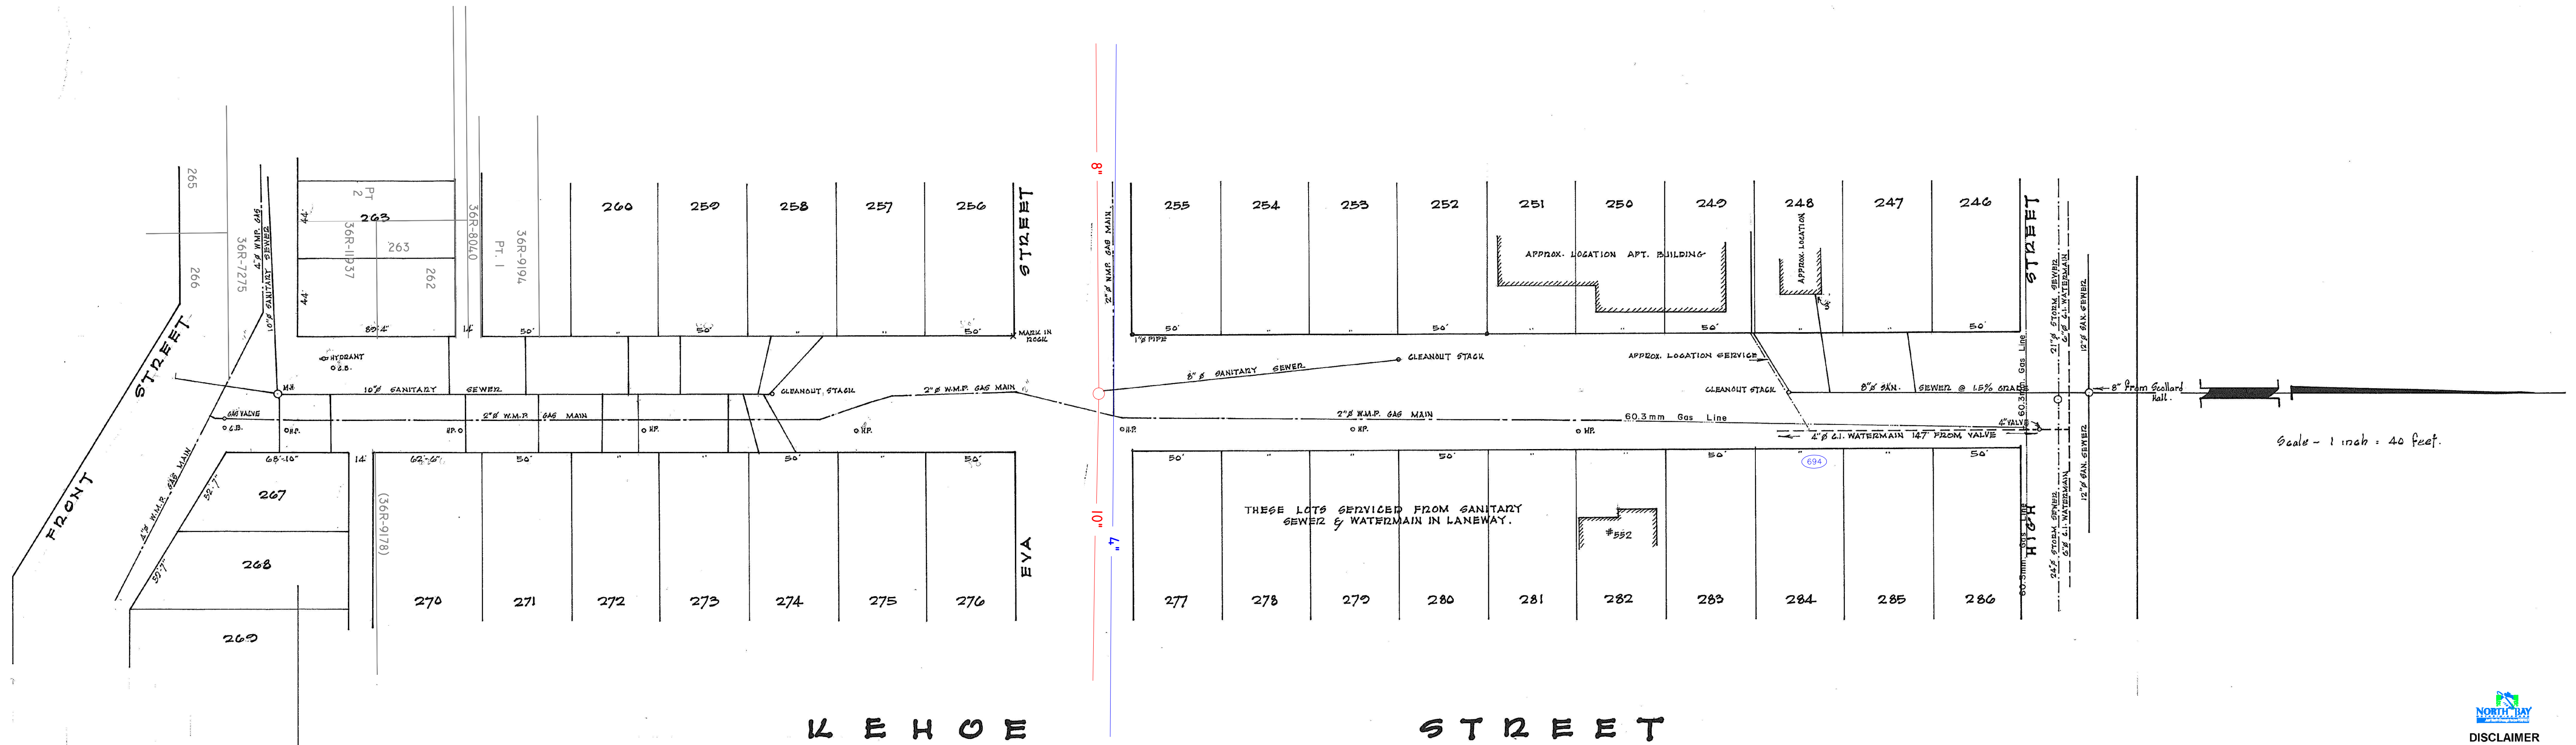

DISCLAIMER

The information contained on this drawing may be based upon data provided by others and may not have been verified by either as-constructed drawings or an Ontario Land Surveyor. The City of North Bay cannot accept responsibility for any errors or omissions on any information shown herein. Field verification, land surveys or excavation (with City approval) may be required to determine actual location of any and all utilities or property lines.

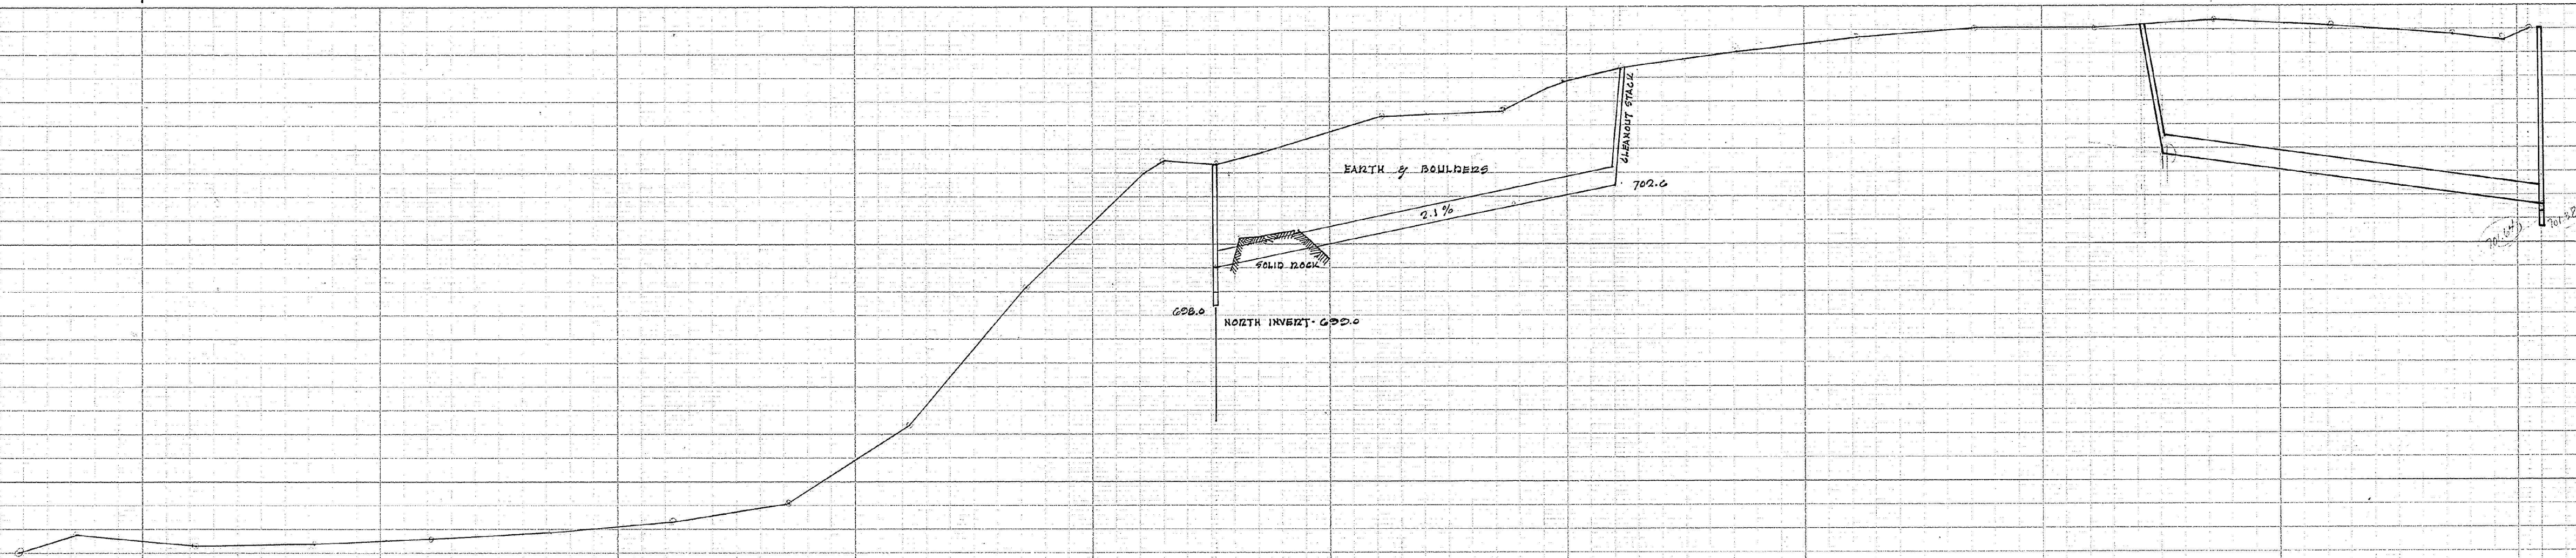

BENCH MARK			
DATE	REVISIONS	DWG. BY.	DWG. NO.
NOV. 2008	SANITARY WATER REG. PLANS ADDED	RJO	
CORPORATION OF THE CITY OF NORTH BAY, ONTARIO			
PLAN & PROFILE			
KEHOE STREET			
FROM			
FRONT STREET TO HIGH STREET			
DWG. BY. R. Saunders	APP. BY.	DATE	FIELD NO. & NO.
SCALE As shown	APPROVED BY.		DWG. NO. K-127
CITY ENGINEER			