


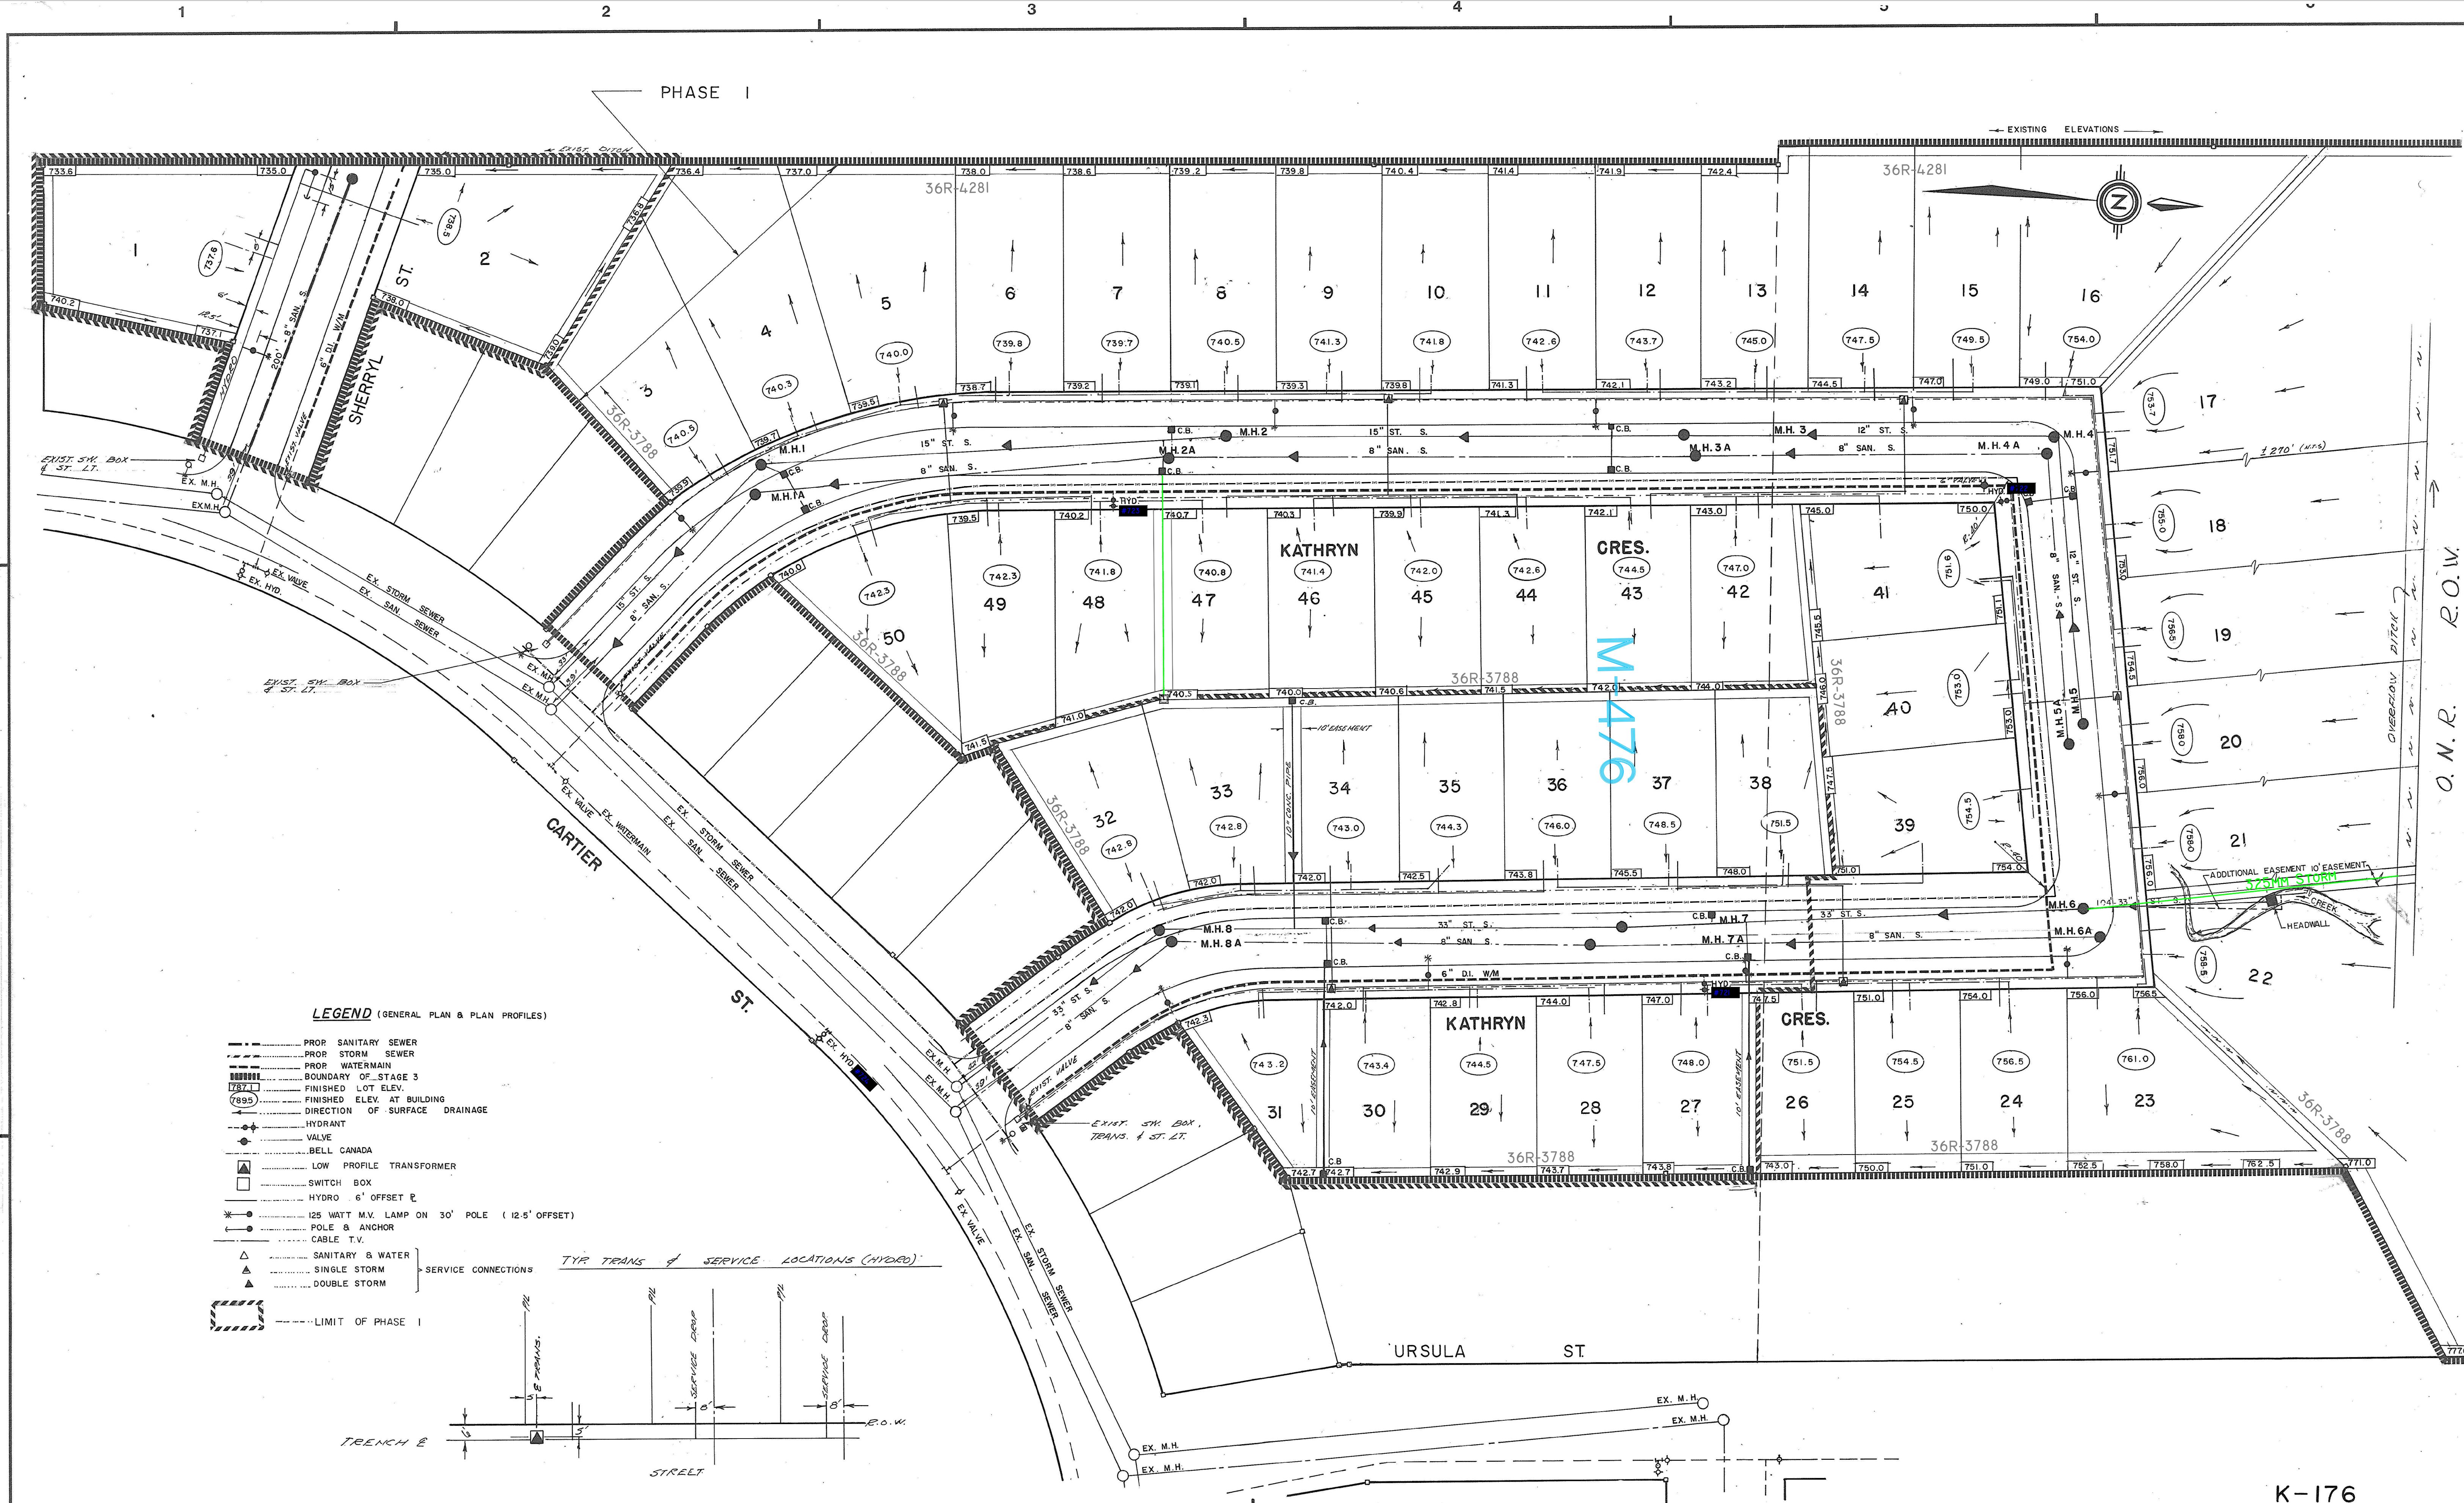

Notes:

DISCLAIMER

The information contained on this drawing may be based on data provided by others and may not have been verified by either as-constructed drawings or an Ontario Land Surveyor. The City of North Bay cannot accept responsibility for any errors or omissions on any information shown herein. Field verification, land surveys or excavation (with City approvals) may be required to determine actual location of any and all utilities or property lines.

HYDRO PLANT APPROVED
[Signature]
DATE: *Jul 17/74*

BELL PLANT APPROVED
[Signature]
DATE: *Jul 23/74*

BELL TELEPHONE CO.

THE POSITION OF POLE LINES, CONDUITS, WATERMAINS, SEWERS AND OTHER UNDERGROUND AND OVERGROUND UTILITIES AND STRUCTURES IS NOT NECESSARILY SHOWN ON THE CONTRACT DRAWINGS, AND, WHERE SHOWN, THE ACCURACY OF THE POSITION OF SUCH UTILITIES AND STRUCTURES IS NOT GUARANTEED. BEFORE STARTING WORK, THE CONTRACTOR SHALL INFORM HIMSELF OF THE EXACT LOCATION OF ALL SUCH UTILITIES AND STRUCTURES, AND SHALL ASSUME ALL LIABILITY FOR DAMAGE TO THEM.

No	Zone	Revision	Date	Initial
1	4-B	REAR LOT CATCH BASIN	Nov 75	don
2		LIMIT OF PHASE I ADDED	Oct 74	RAB
3		AS CONSTRUCTED	Nov 75	don
4		REGISTERED PLANS ADDED	Nov 08	R.J.O.

Approved

REGISTERED PROFESSIONAL ENGINEER
R. G. CHARLTON
PROVINCE OF ONTARIO

REGISTERED PROFESSIONAL ENGINEER
K. L. BRANNON
PROVINCE OF ONTARIO

CITY OF NORTH BAY

GENERAL PLAN
&
LOT - GRADING PLAN

Proctor & Redfern Limited

Consulting Engineers
Toronto North Bay

Scale 1" = 40'

Date: APRIL / 74

Drawn By DJF
Ckd. By

Field Book

Drawing No. **B-74132-K-176**

Rev 3