

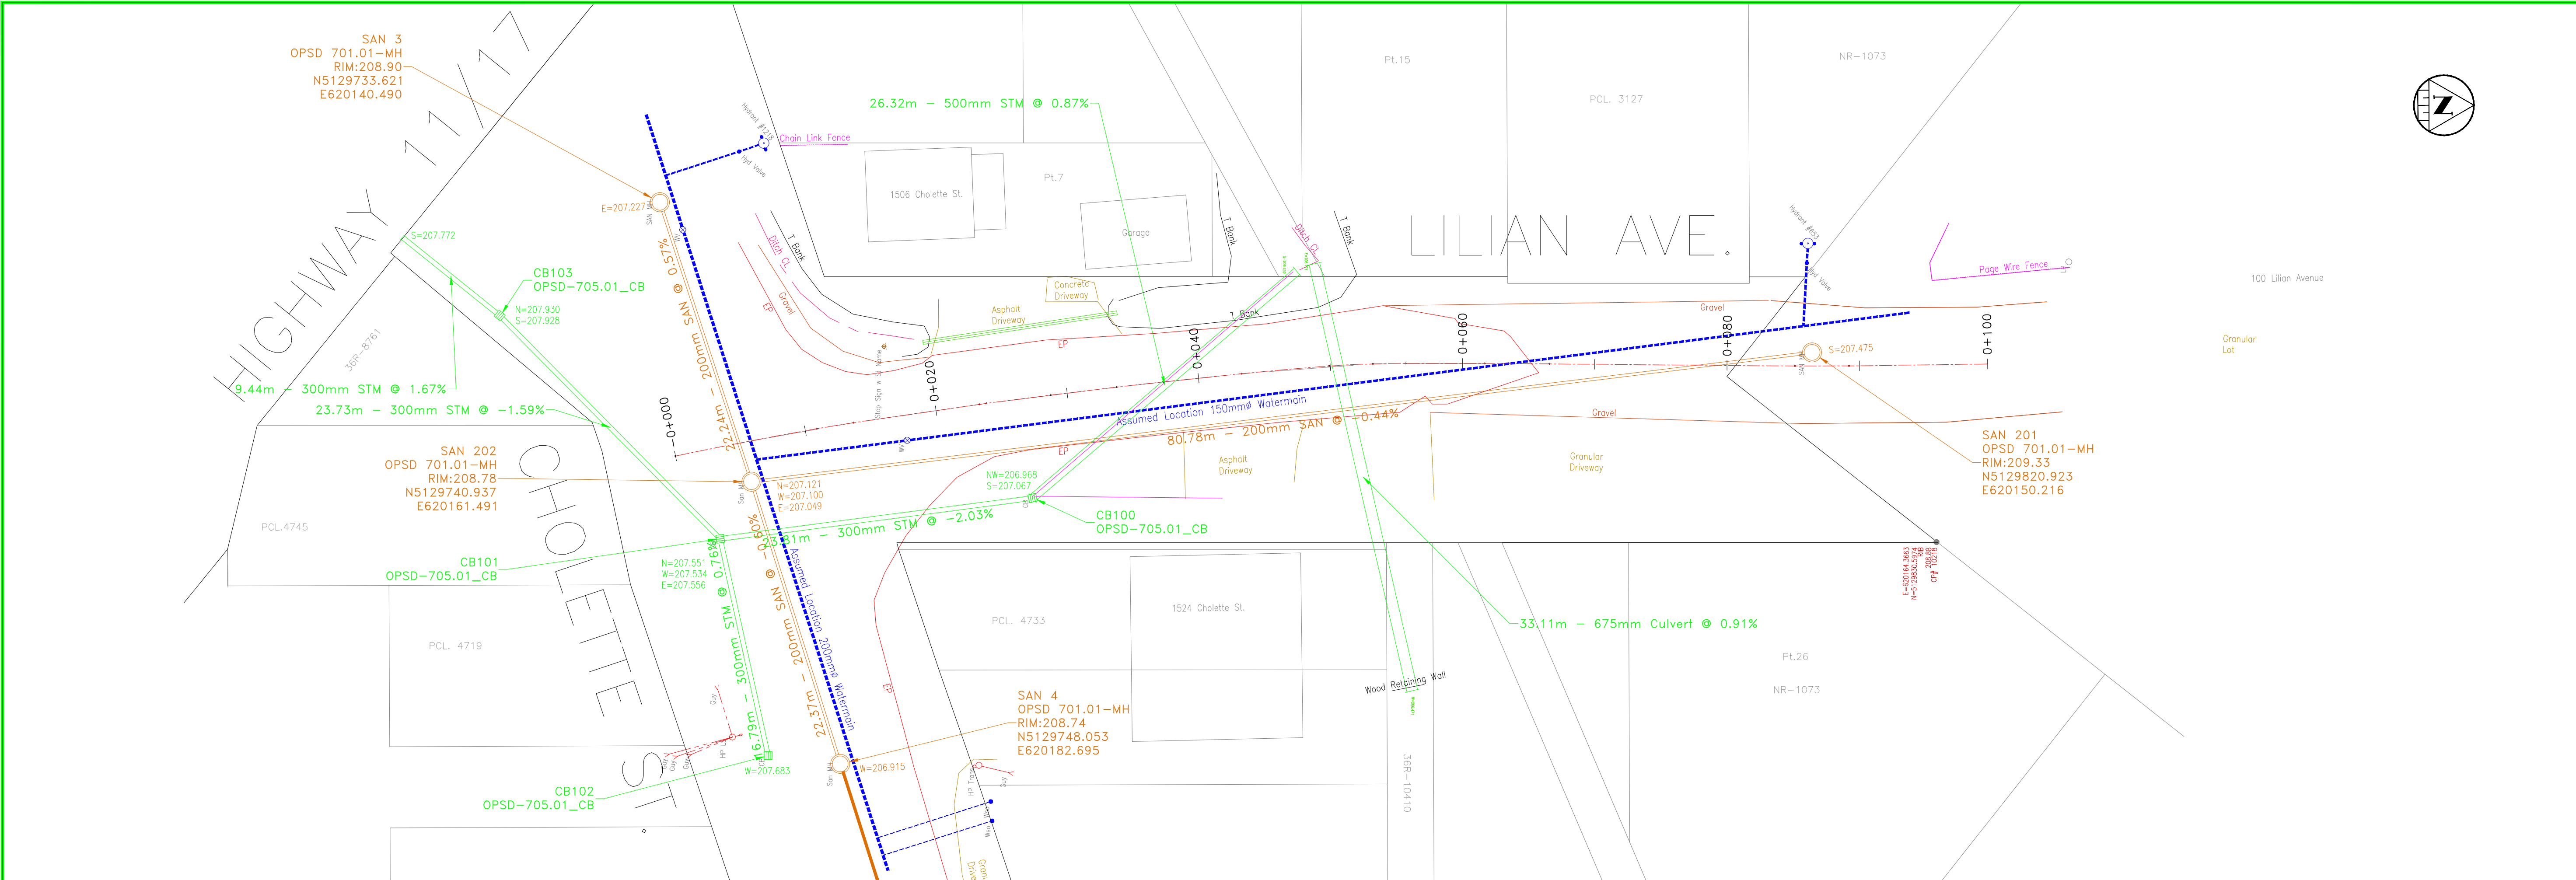


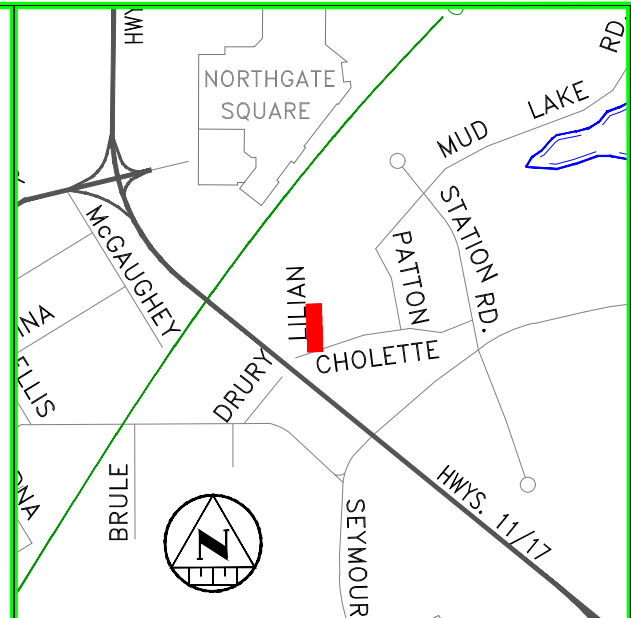

Lilian Ave. CL PROFILE

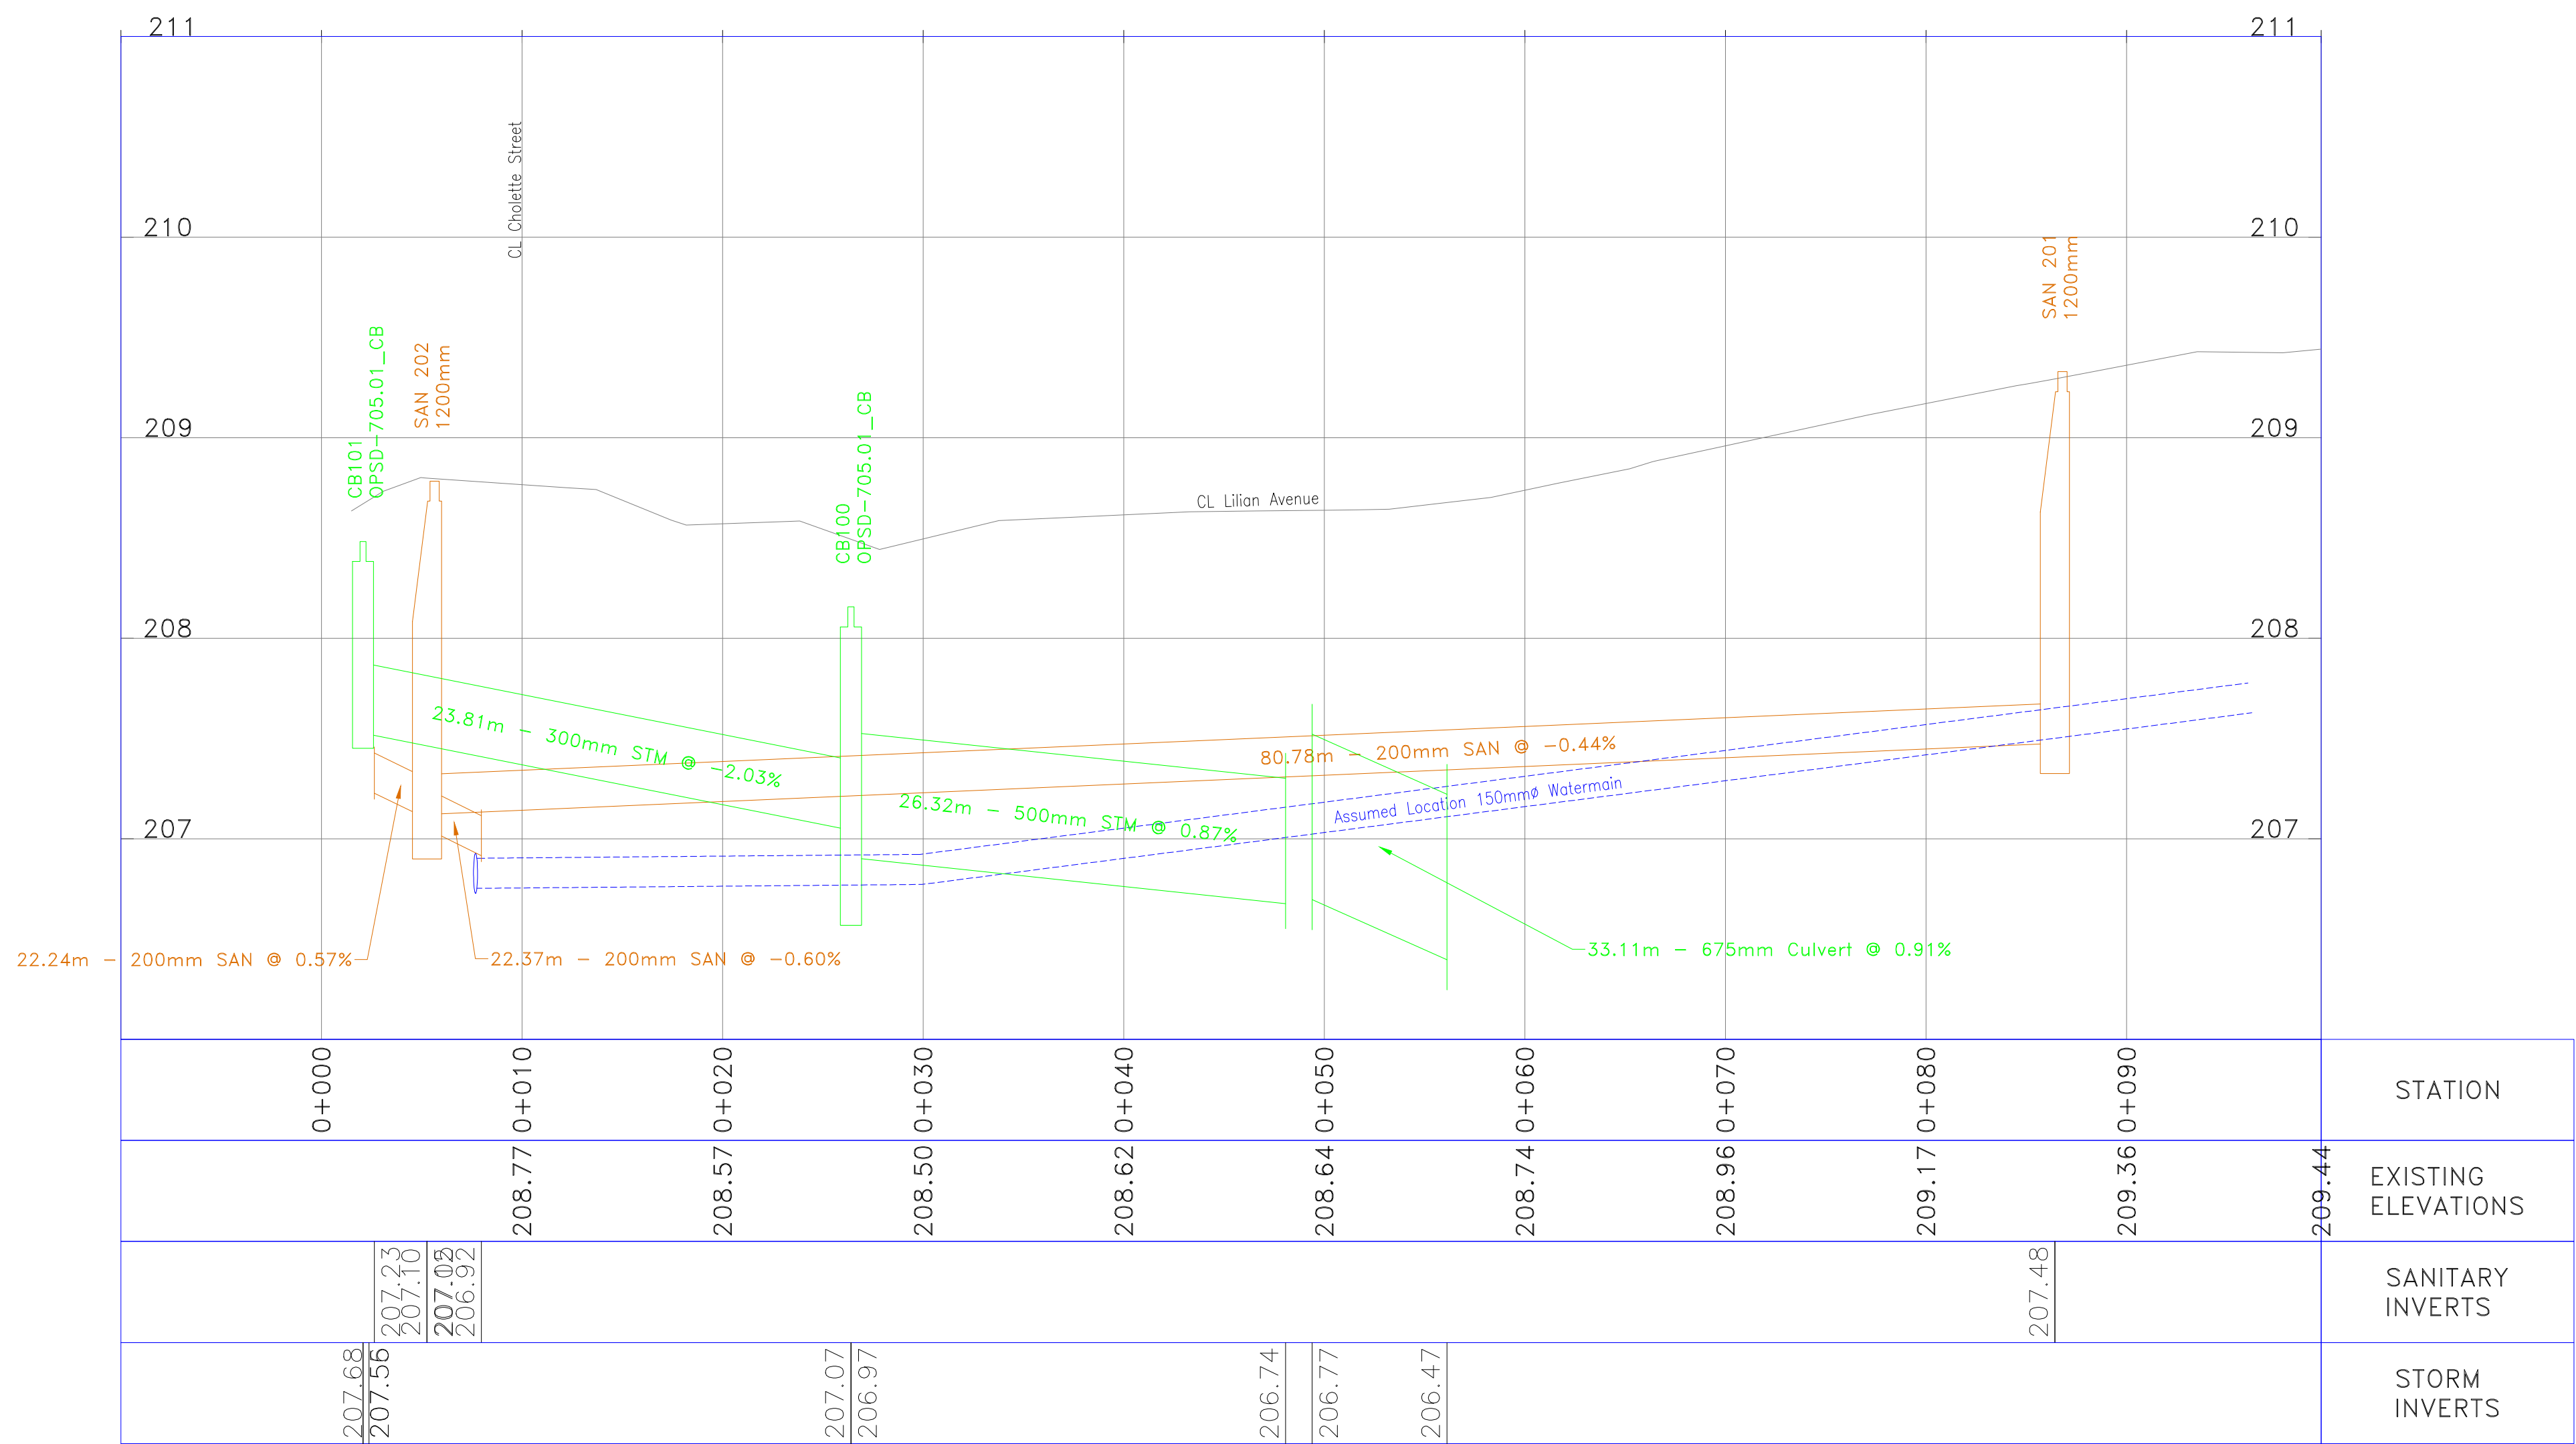

KEY PLAN
LEGEND

REVISIONS

no.	date	by	description
1.	6 August 2015		As-Built

Disclaimer

The information contained on this drawing may be based upon data provided by others and may not have been verified by either as-constructed drawings or an Ontario Land Surveyor. The City of North Bay cannot accept responsibility for any errors or omissions on any information shown herein. Field verification, land surveys or excavation (with City approvals) may be required to determine actual location of any and all utilities or property lines.

REQUIRED P.ENG
STAMP



From Cholette St.
To End

AS-BUILT

LILIAN AVENUE

STA. 0+000 to 0+095

designer drawn by:
G.W.C.

checked by: approved by:

scale
H.1:250
V.1:50

date drawing number
6/08/2015 L-126