
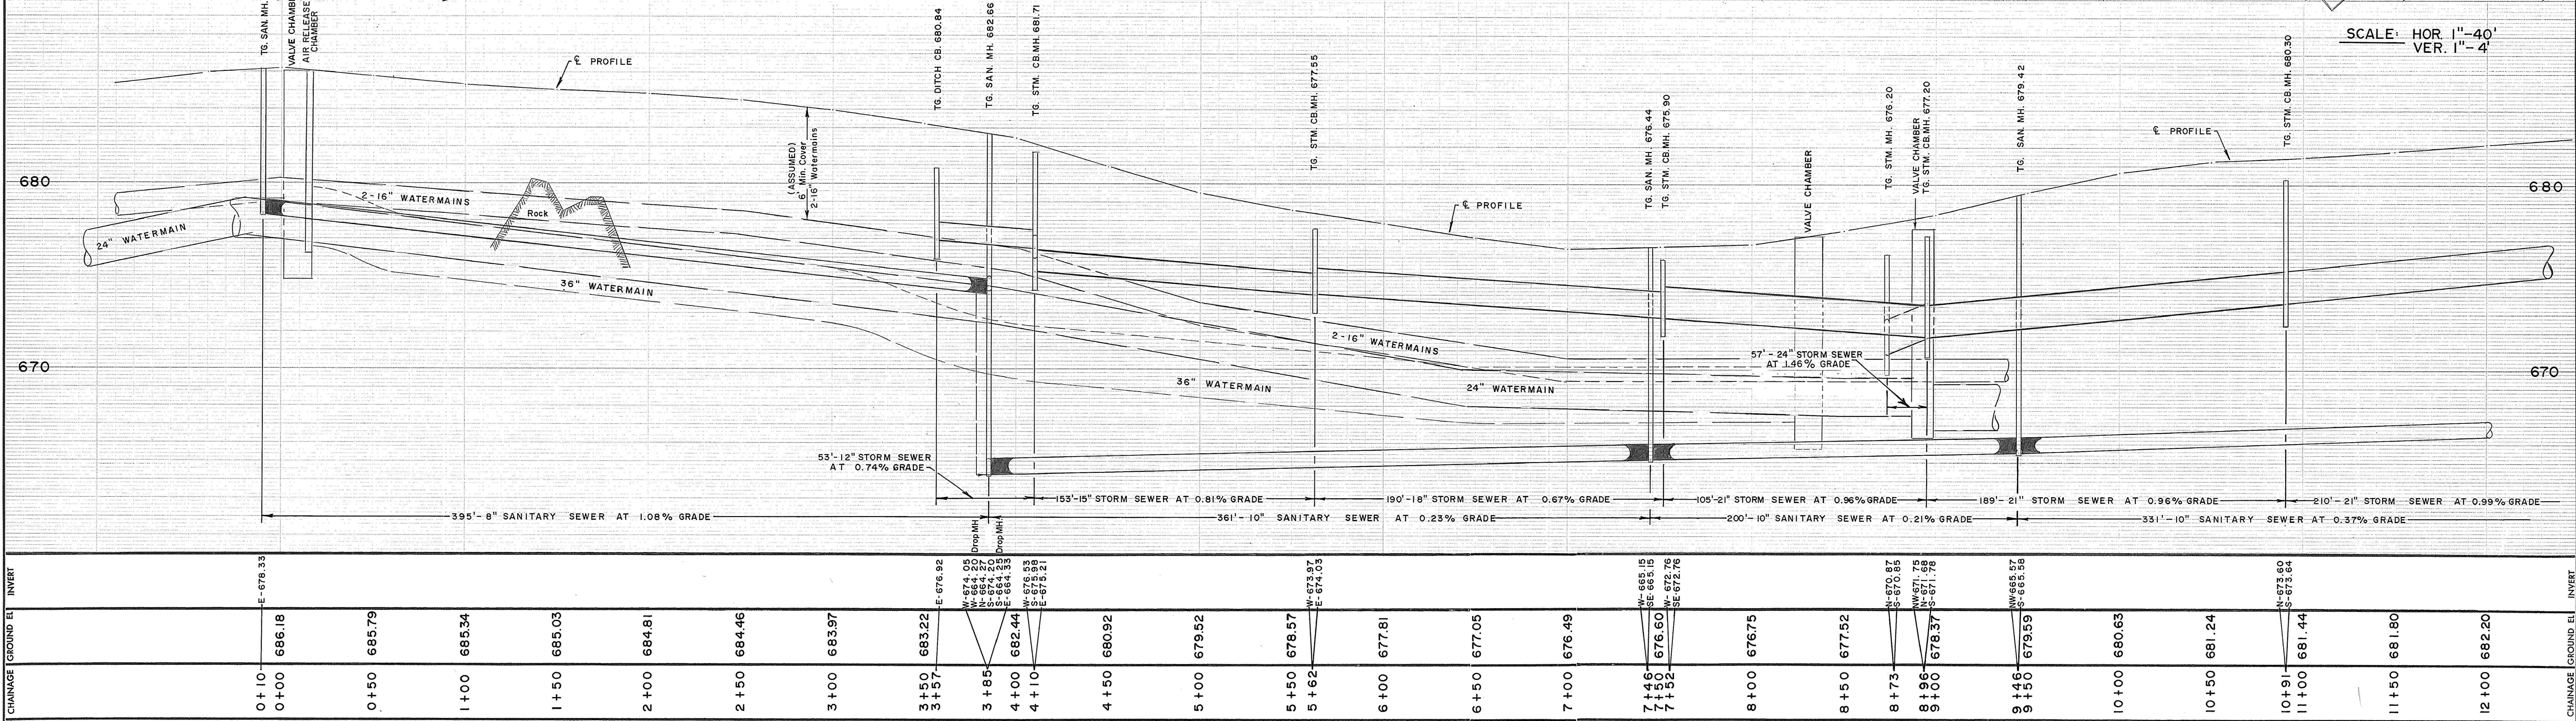


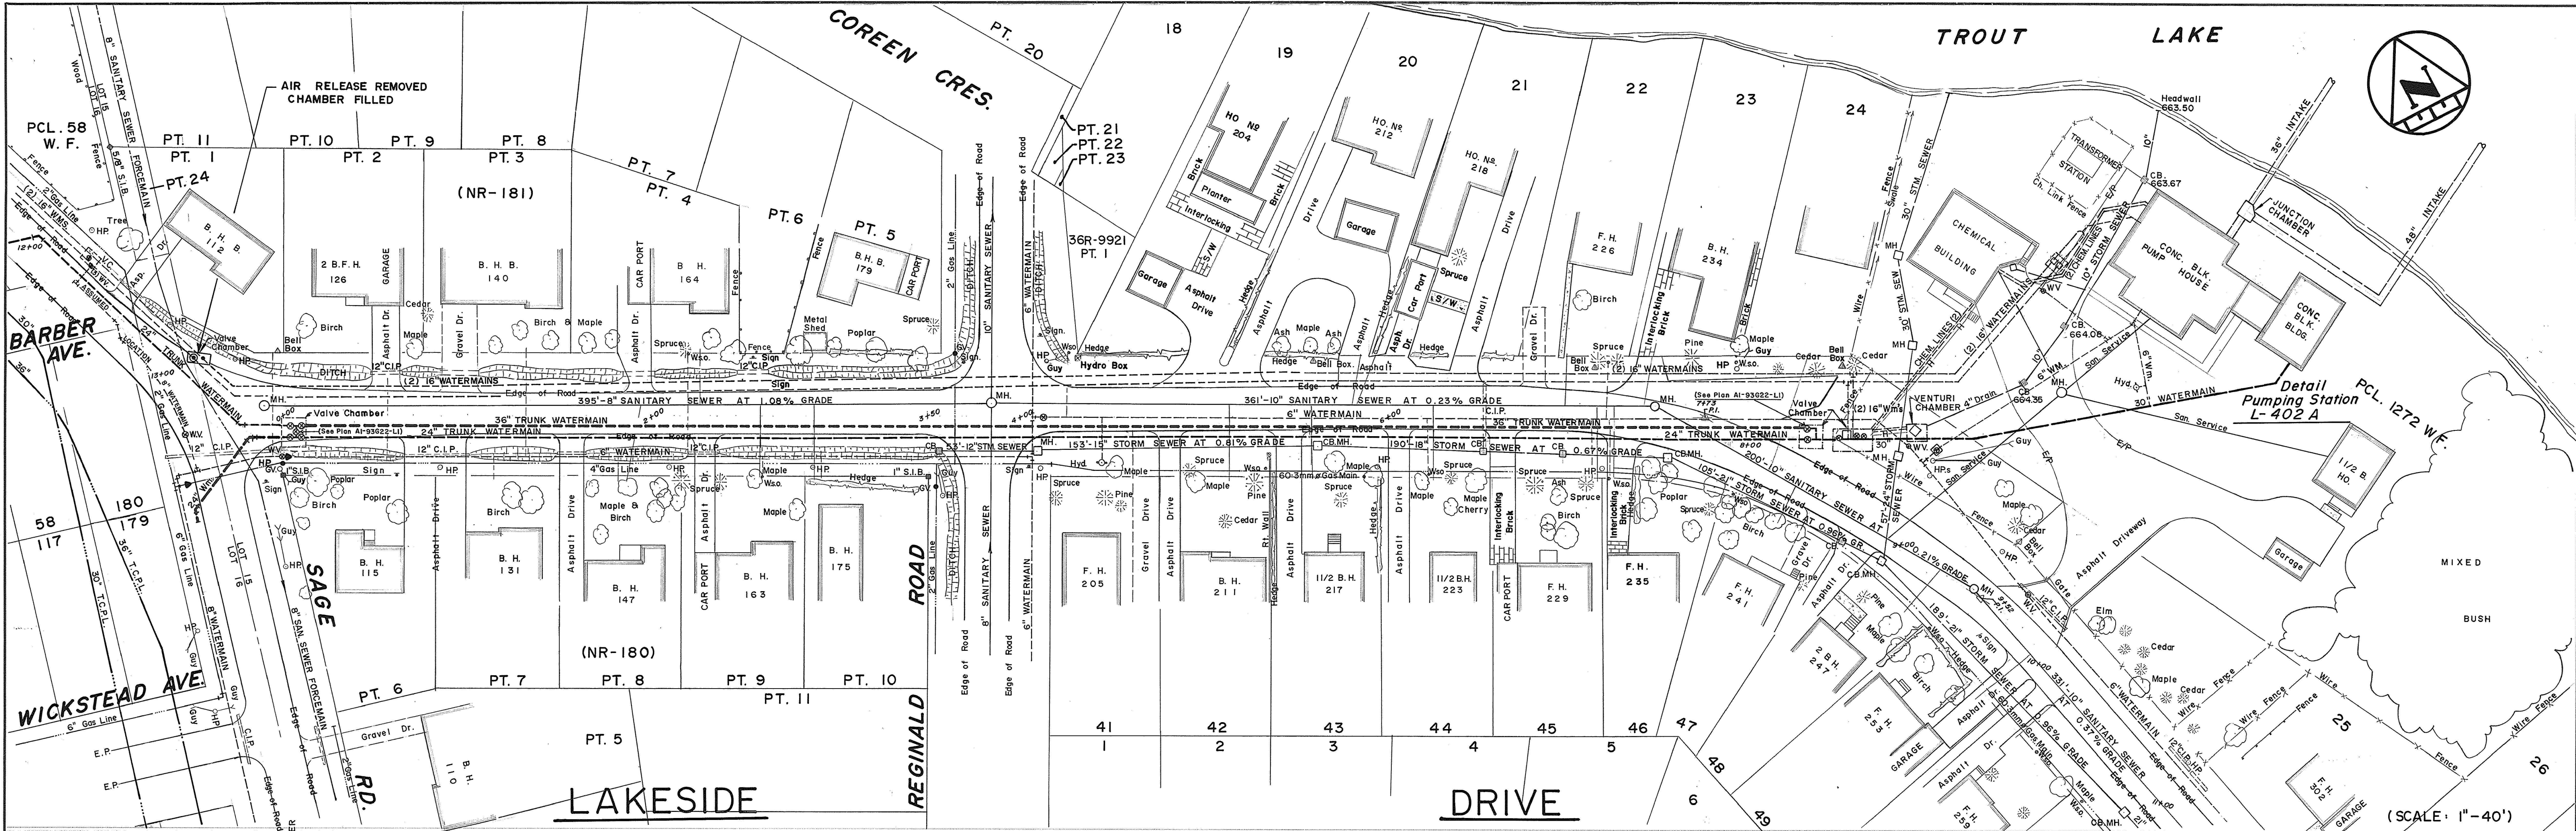

NOTES:

1. AS CONSTRUCTED STORM SEWER, BK. 252

2. 60.3 mm Gas Main

3. WATERMAIN PROFILES ADDED

4. VALVE CHAMBER AT 12+25 AND 8" WM, AS PER P&R DWG. A1-80913-02 (Rev. 2)

5. REVISED (2) 16" WATERMANS - LAKESIDE DR.

6. ADD 36" TRUNK WATERMAIN - (As Proposed)

APPROVED

MAR. 80. R.F.B.

JAN/82. B.D.

NOV. '93. P.L.C.

DEC. '93. P.L.C.

DEC. '93. R.T.

FEB. '98. P.L.C.

No.	REVISION	DATE	INITIAL

LAKESIDE DRIVE

SAGE ROAD TO DONALD DRIVE

CITY OF NORTH BAY

ENGINEERING DEPARTMENT

SCALE: AS SHOWN DATE: MAR. 80

DRAWN BY: Rick B. CK'D. BY: 252, 254 DRAWING No. **L-402** REV.