
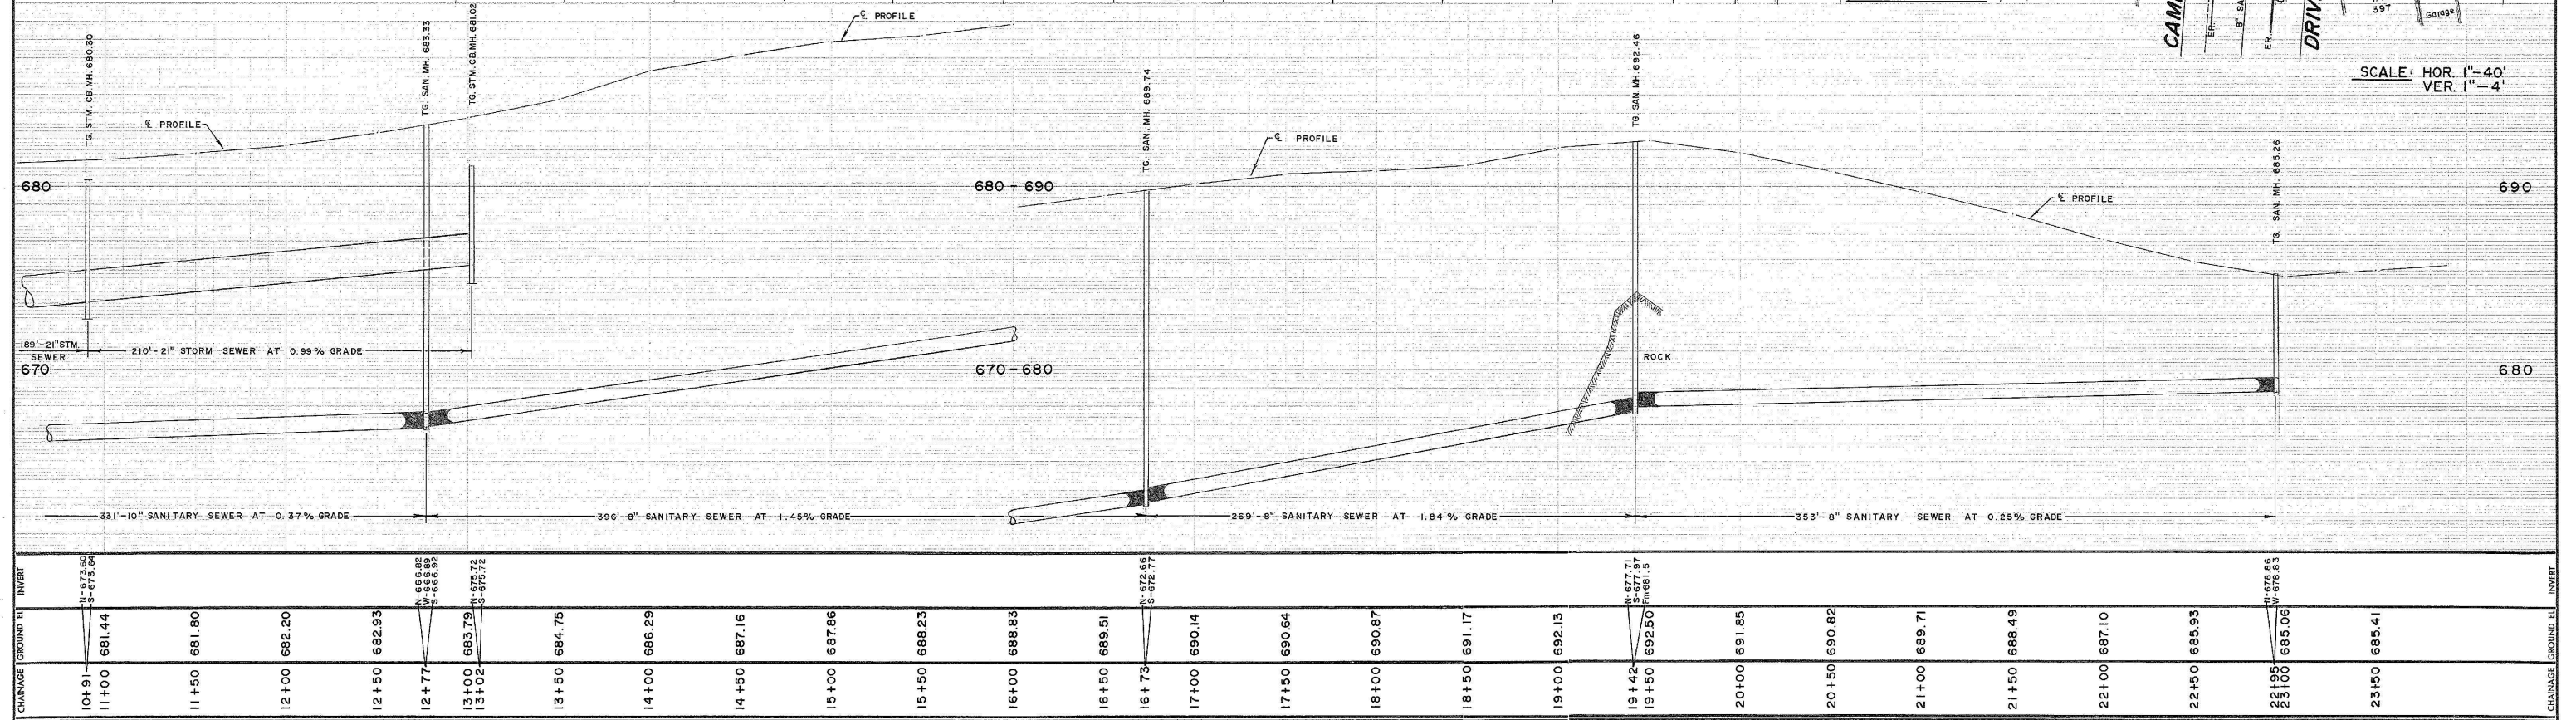


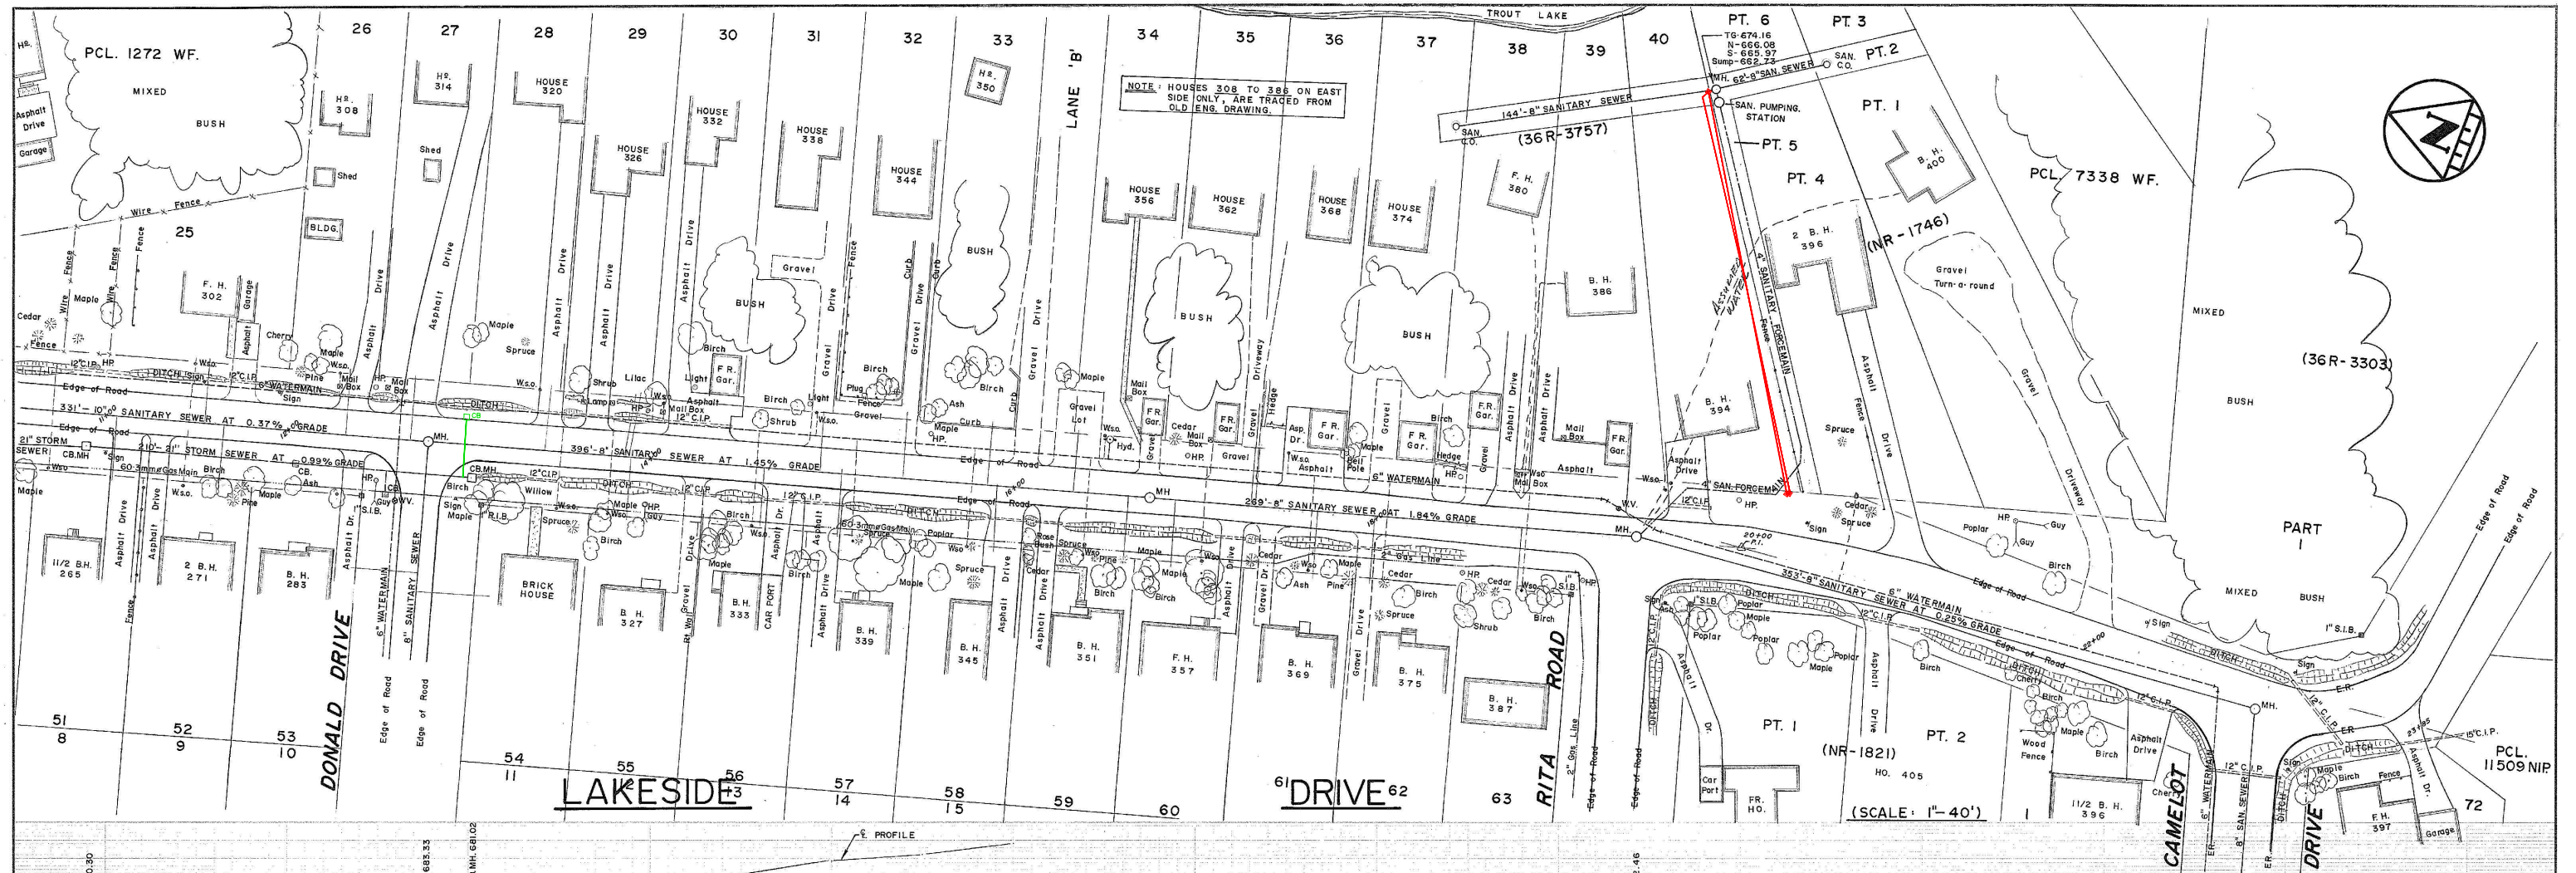

NOTES:  DISCLAIMER The information contained on this drawing may be based upon data provided by others and may not have been verified by either as-constructed drawings or an Ontario Land Surveyor. The City of North Bay cannot accept responsibility for any errors or omissions on any information shown herein. Field verification, land surveys or excavation (with City approvals) may be required to determine actual location of any and all utilities or property lines.	<i>NOTE: HOUSE #400 ASSUMED WATERLINE LOCATION BY EDGAR GRAVELLE.</i>		1. AS-CONST'D. FORCEMAIN AND P.S. BK. 206 (1970)	MAR. 80	R.F.B.	APPROVED	LAKE SIDE DRIVE		CITY OF NORTH BAY ENGINEERING DEPARTMENT			
	2. AS-CONST'D. STORM SEWER BK. 252 (1978)	MAR. 80	R.F.B.	DONALD DRIVE TO CAMELOT DRIVE								
	3. 60-3mm Gas Main	JAN/82	B.D.									
	4. Updated Storm	Mar'11	G.W.C.									
	5. E-Hydro Lift sta locate (approx)	Mar2021	rjo									
	No.	REVISION	DATE	INITIAL			SCALE: AS SHOWN		DATE: MAR. 80			
							DRAWN BY: RICK B.		FIELD BOOK No.	DRAWING No.	L-403	KEY
							C.C.D. BY:		254			
	10-0000-00-000000-000											