
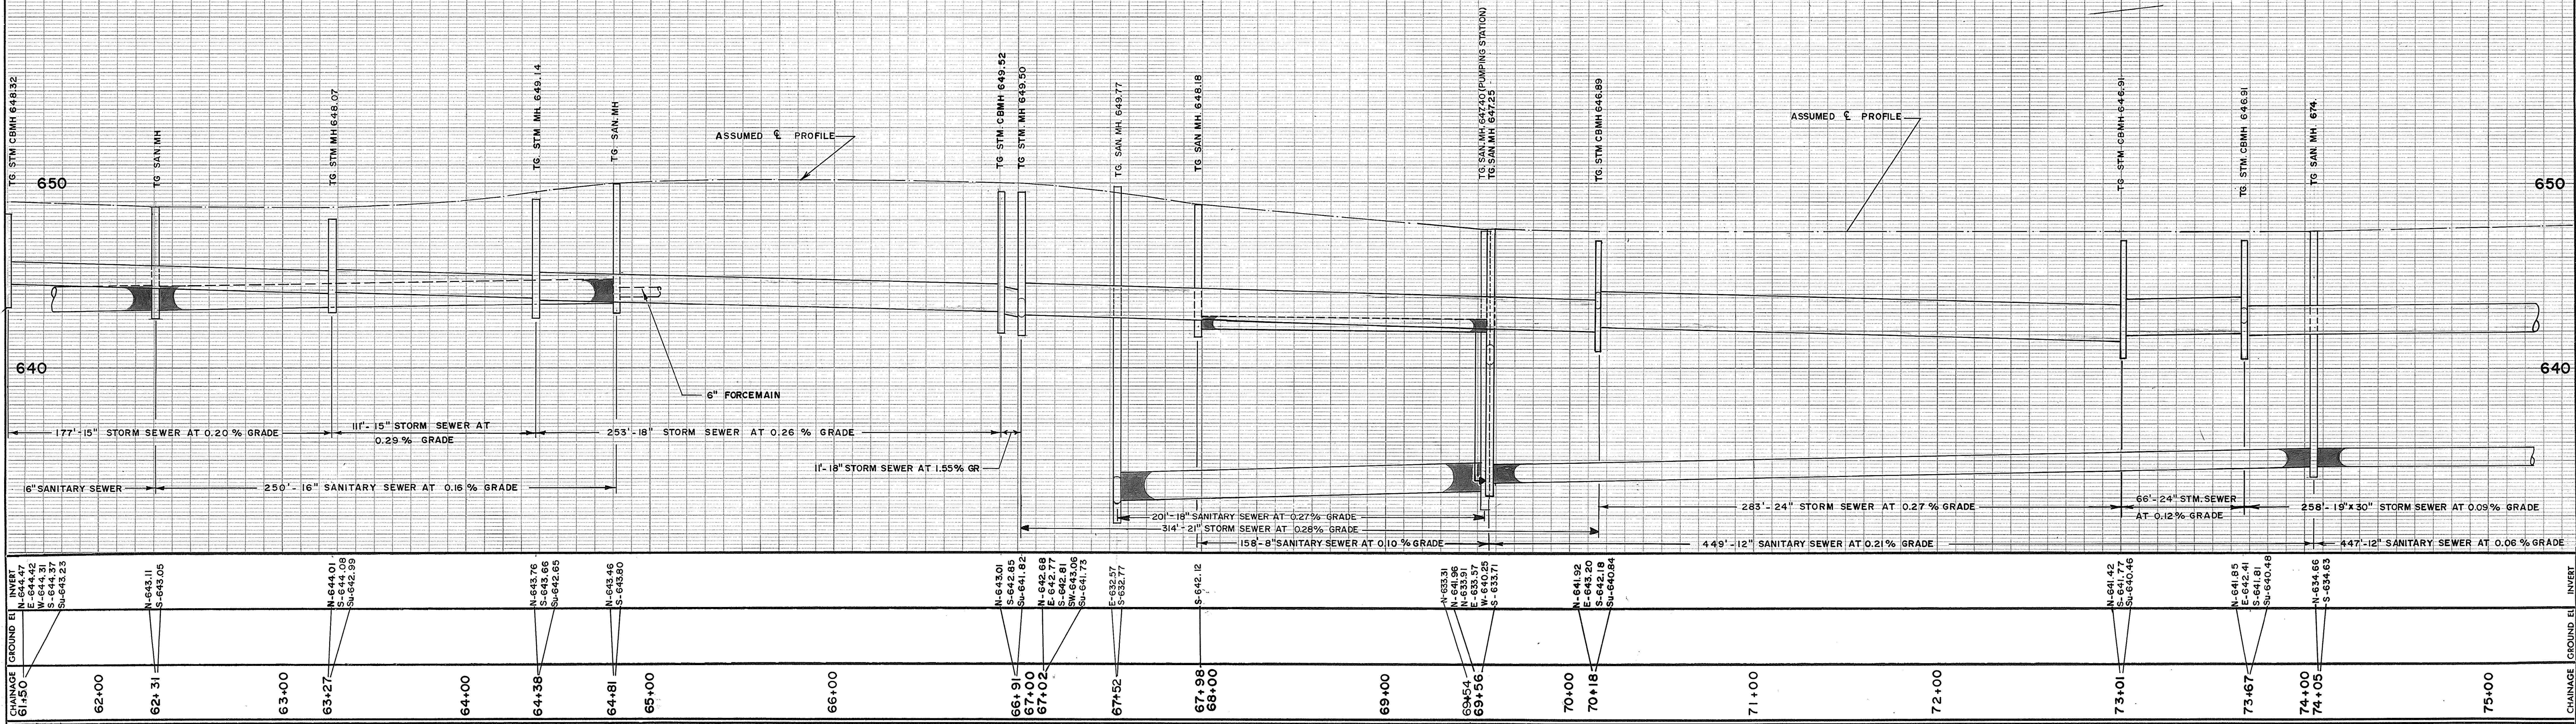


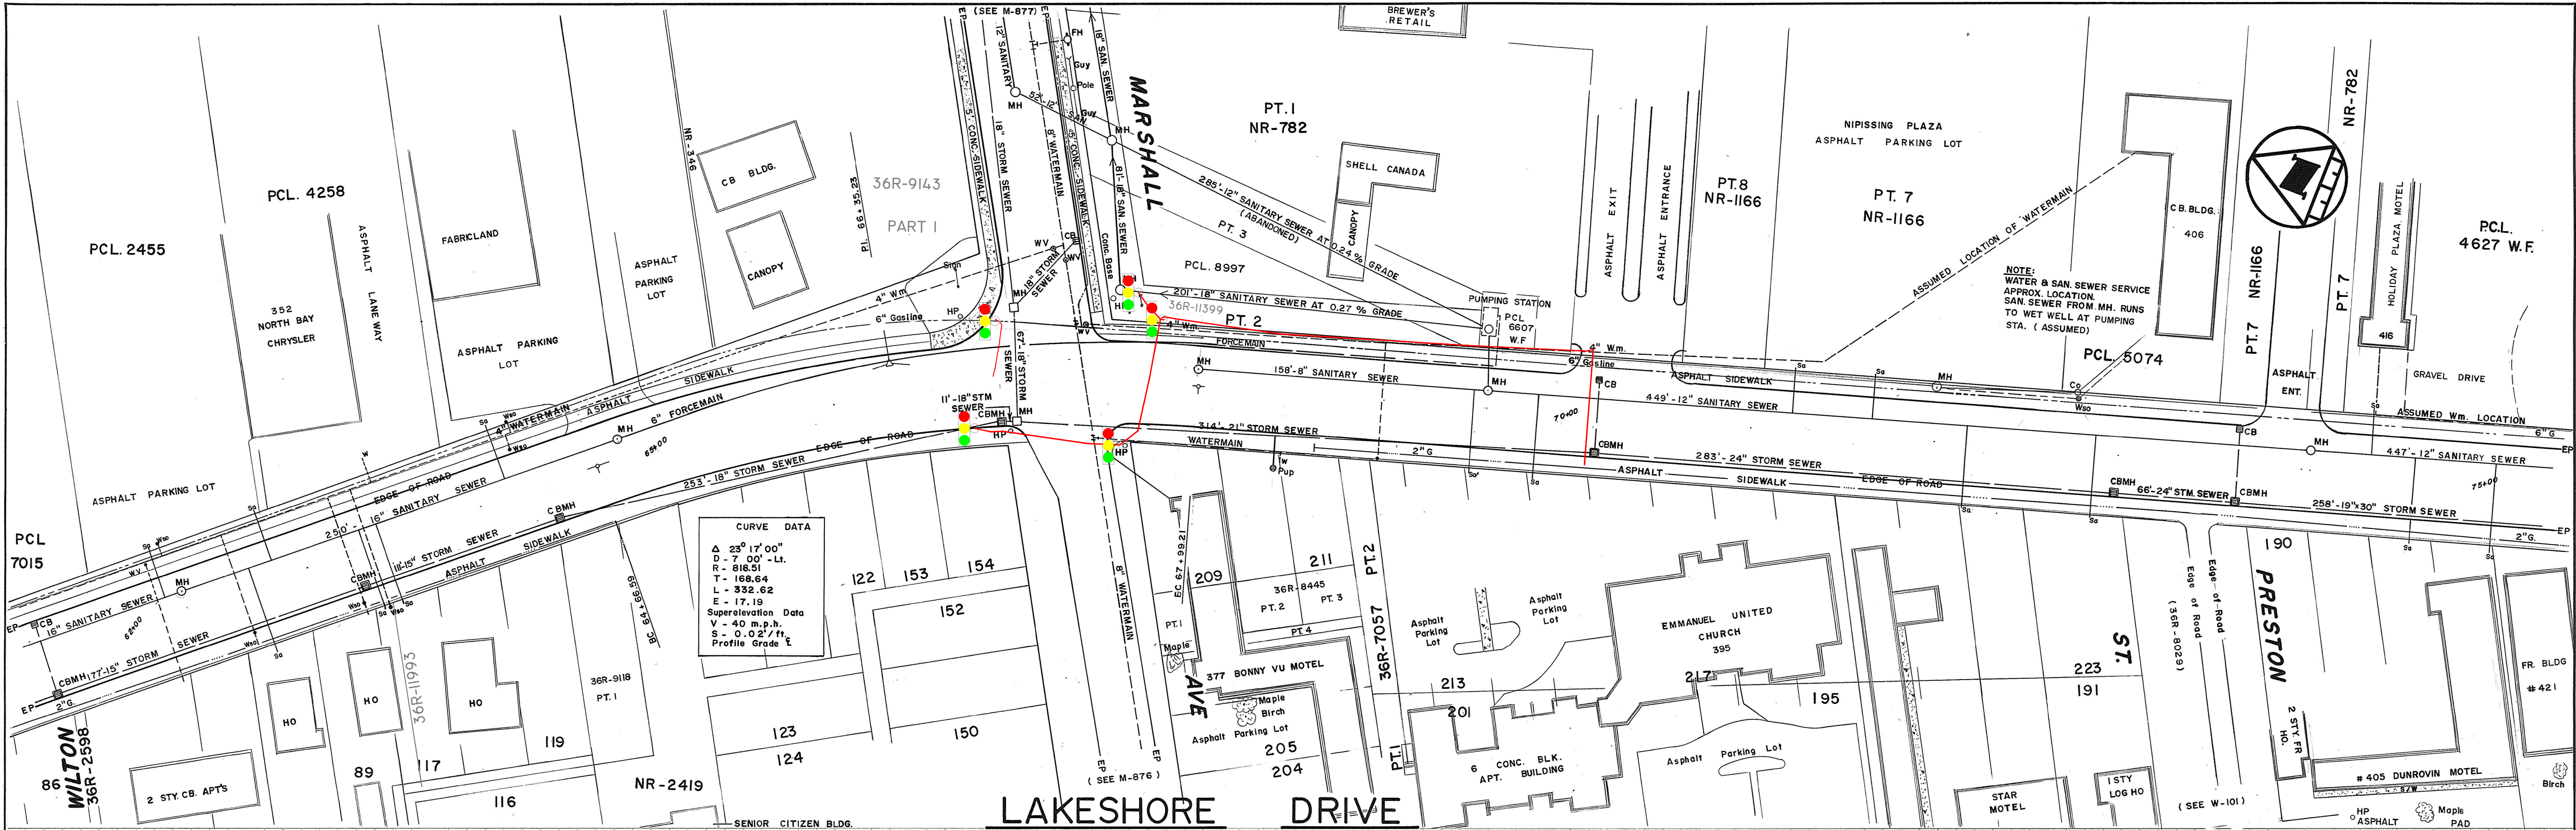

NOTES:

1. APPROX LOCATION SAN SEWER TO WET WELL.

2. ADD 18" SAN. SEWER PROFILE AT SHELL.

3. REGISTERED PLANS ADDED.

4. E-HYDRO LIGHTS (TRAFFIC)(APPROX.)

APPROVED

SEPT '20 R.J.O.

NOV 08 R.J.O.

DEC/ 97 J. STP

MARCH/97 R T

LAKESHORE DRIVE
WILTON AVE TO WILLIAM STREET

CITY OF NORTH BAY
ENGINEERING AND WORKS

SCALE: HOR - 1" = 40'
VERT - 1" = 4'

DATE: AUG / 92

DRAWN BY: PLC
CKD BY:

FIELD BOOK No.

DRAWING No.

REV.

L - 456