





Scale - 1 inch = 40 feet

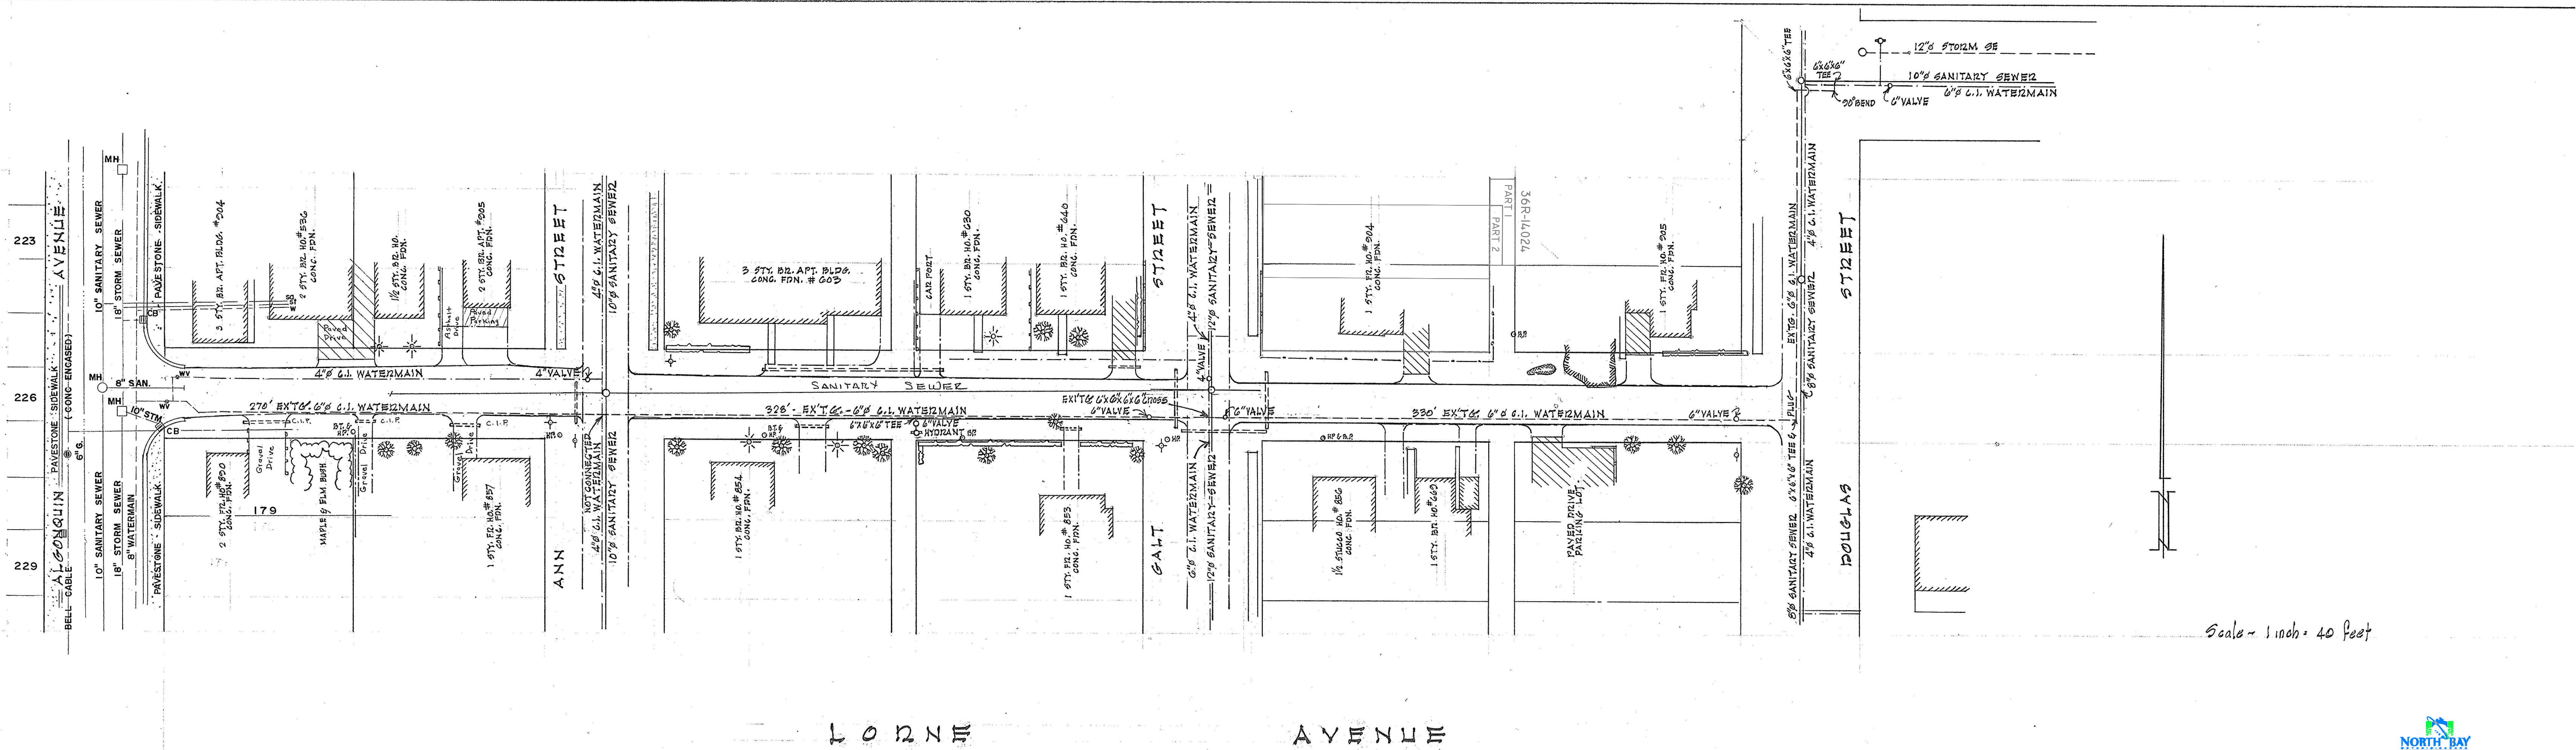

The information contained on this drawing may be based upon data provided by others and may not have been verified by either as-constructed drawings or an Ontario Land Surveyor. The City of North Bay cannot accept responsibility for any errors or omissions on any information shown herein. Field verification of land surveys or excavation (with City approvals) may be required to determine the actual location of any and all utilities or property lines.

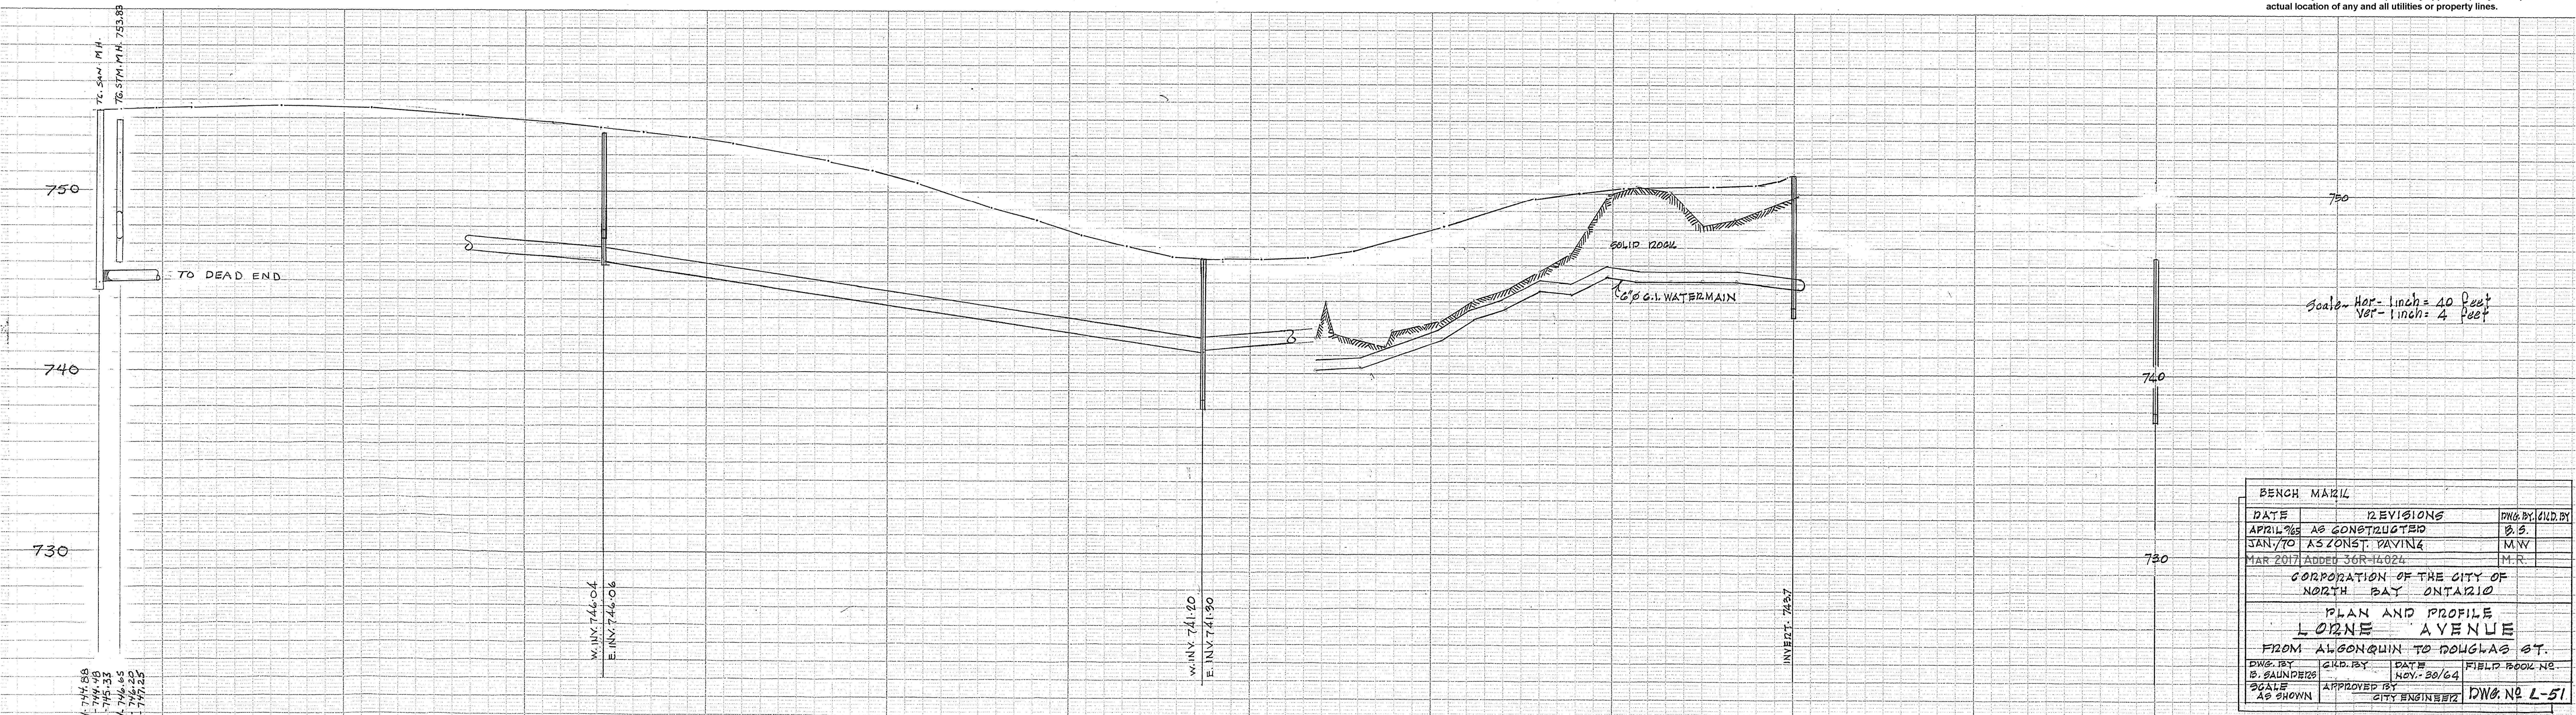

Scale - Hor - 1 inch = 40 feet
Ver - 1 inch = 4 feet

BENCH MARK		
DATE	REVISIONS	DWG BY / CHD BY
APRIL 1969	AS CONSTRUCTED	B.S.
JAN 1970	AS ZONED. PAVING	M.W.
MAR 2017	ADDED 36R-14024	M.R.
CORPORATION OF THE CITY OF NORTH BAY ONTARIO		
PLAN AND PROFILE		
LORNE AVENUE		
FROM ALGONQUIN TO DOUGLAS ST.		
DWG BY	CHD BY	DATE
B. SAUNDERS	B. SAUNDERS	NOV. 30/64
SCALE AS SHOWN	APPROVED BY	CITY ENGINEER
		DWG. NO. L-51