


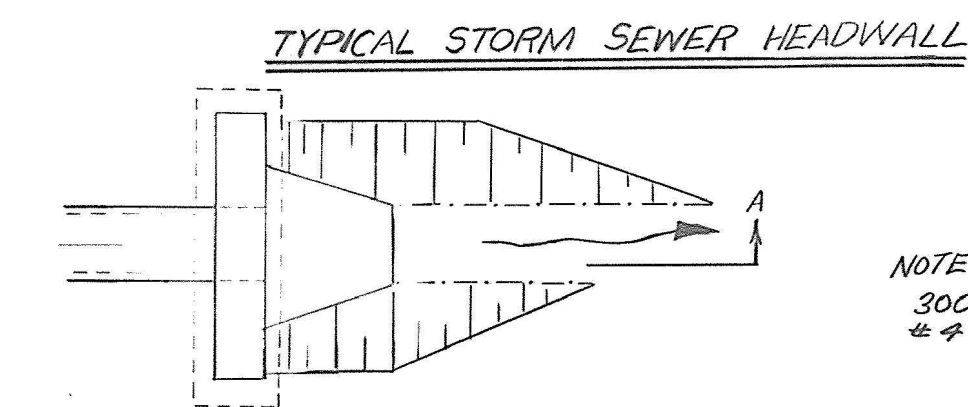
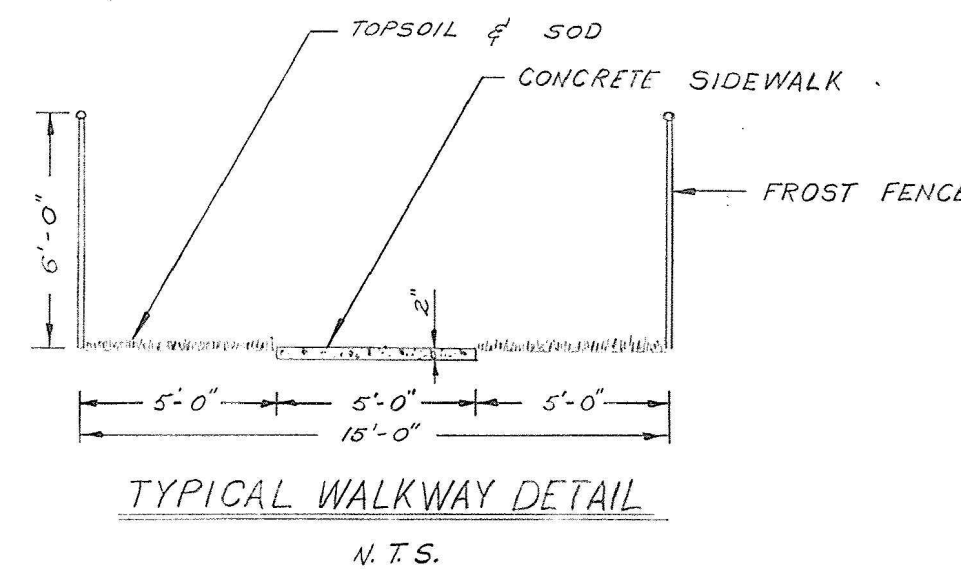


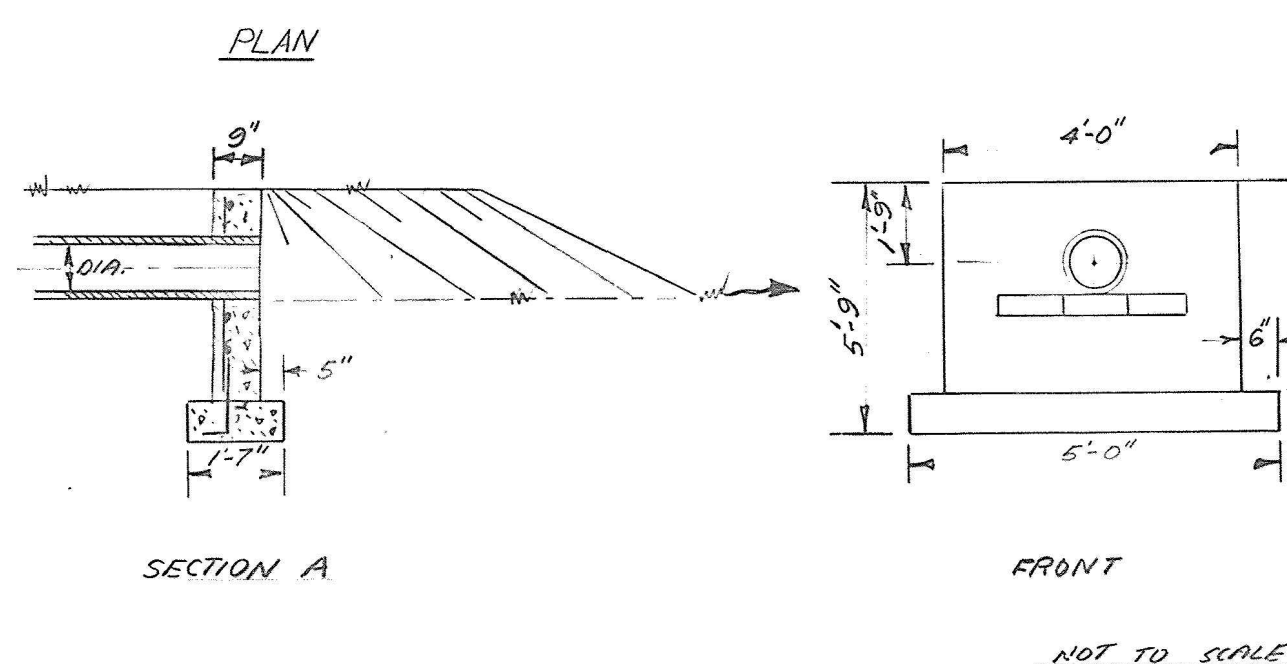

NOTE:
3000 PSI. CONCRETE
#4 REINFORCING BARS

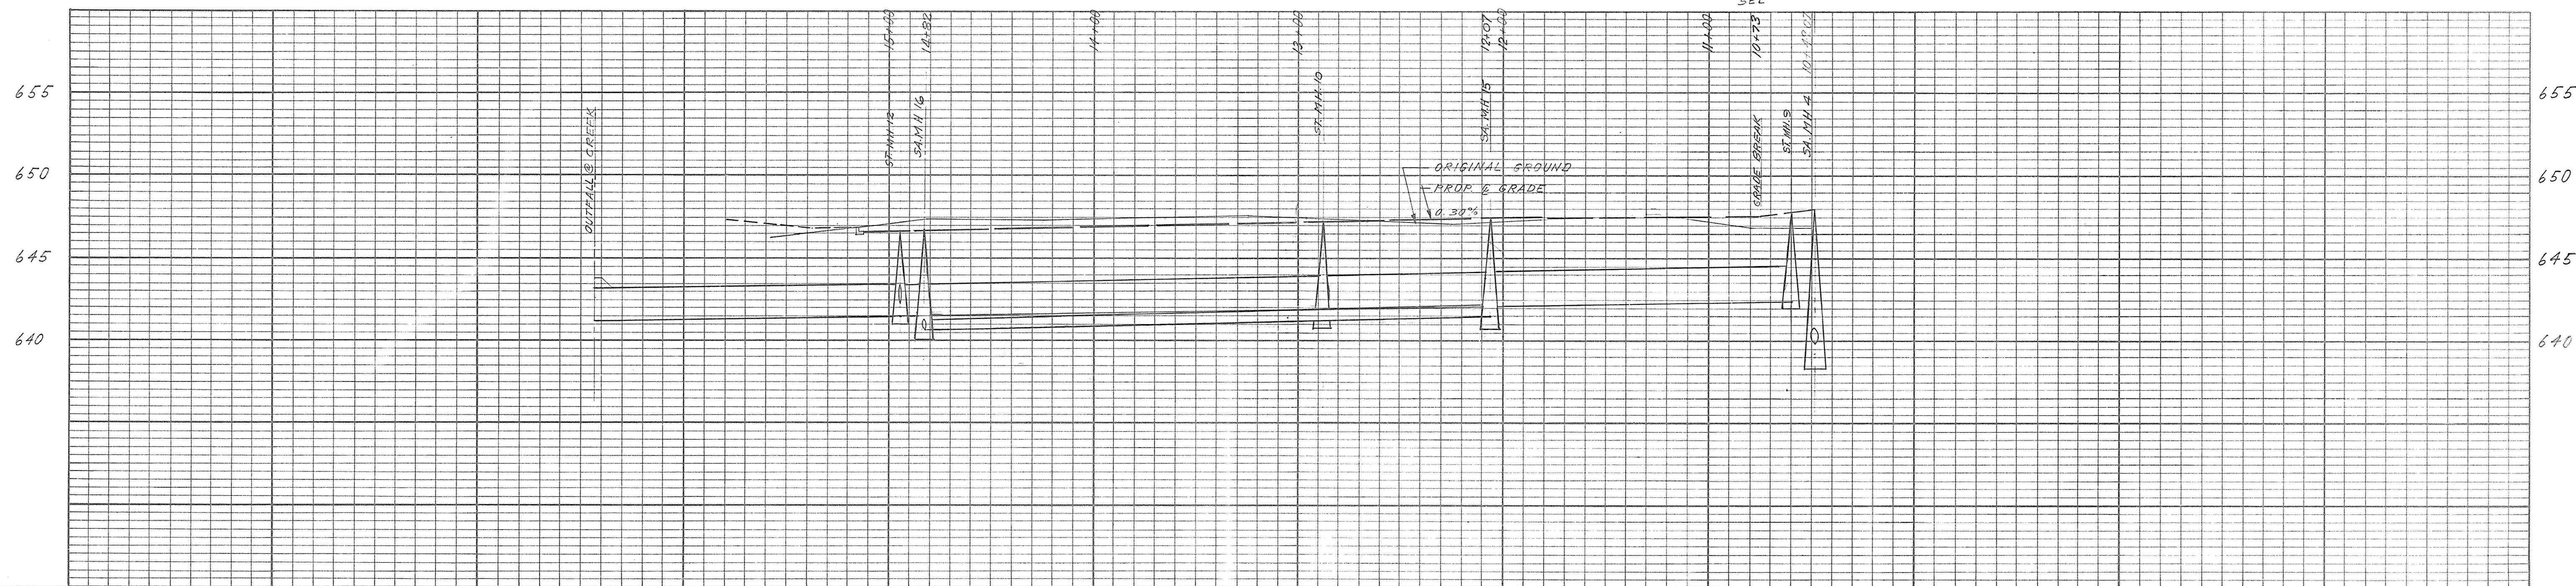

NOTE: IN ALL CASES SAN. & STORM SEWER EXTENSIONS MUST
BE TAKEN TO AT LEAST THE LOT LINE, AND CAPPED.

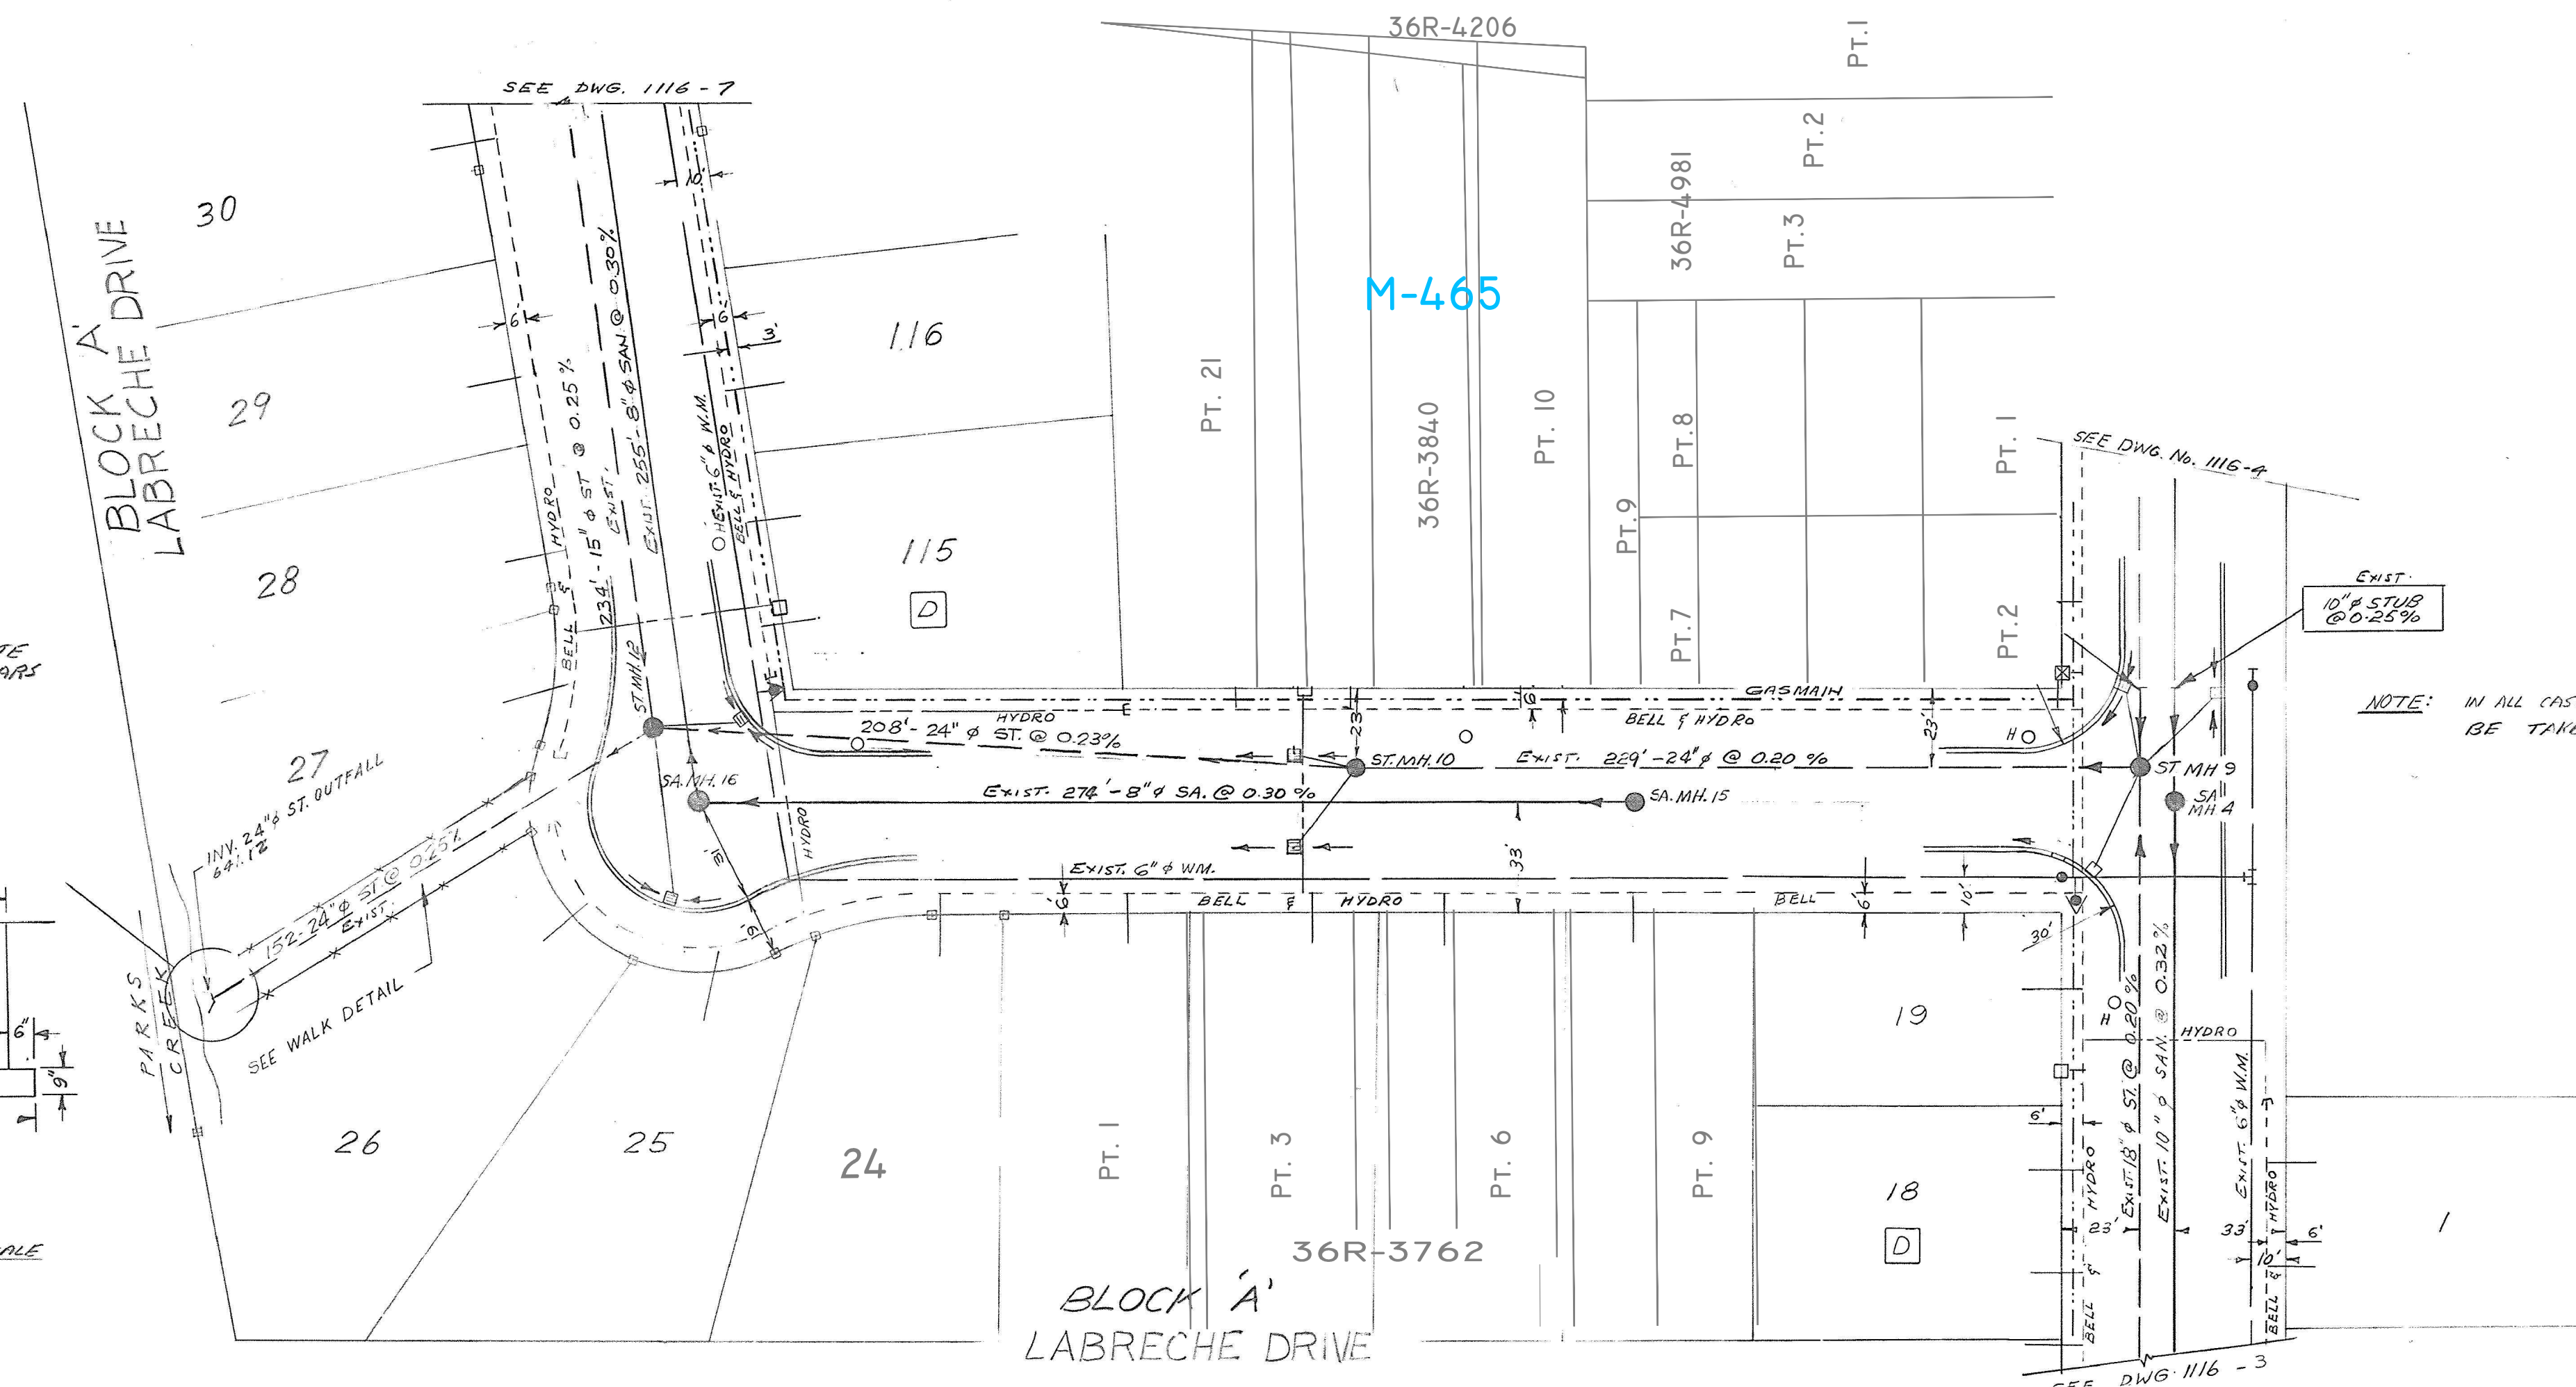

ROAD E	641.12	641.76	642.39	642.97	643.74	ROAD E
ST. INV.	641.12	641.76	642.39	642.97	643.74	ST. INV.
SAN. INV.	640.77	641.56	642.00	642.00	642.00	SAN. INV.

SCHEDULE C

MARSHALL PARK DEVELOPMENT
LTD.

BLOCK 'A' LABRECHE DRIVE
NORTH FROM BLOCK 'D' LOVELL DRIVE

Northland
Engineering Ltd.
CONSULTING CIVIL ENGINEERS
NORTH BAY - SUDBURY - TORONTO

No.

L-651

C	R.J.O.	REGISTERED PLANS ADDED.	Nov. 08	DWN. BY	G. J.
B	PLC.	PROPERTY LINES REVISED	M.B. JAN. 24/74	CHKD. BY	M. B.
A	PLC.	ADDITION OF WALKWAY DETAIL	M.B. JAN. 22/74	DATE	OCTOBER 1973.
MK.	BY	REVISIONS	APP.	DATE	SCALE
					HOR. 1" = 40'-0"
					VER. 1" = 5'-0"



DISCLAIMER

The information contained on this drawing may be based upon data provided by others and may not have been verified by either as-constructed drawings or an Ontario Land Surveyor. The City of North Bay cannot accept responsibility for any errors or omissions on any information shown herein. Field verification, land surveys or excavation (with City approvals) may be required to determine actual location of any and all utilities or property lines.