
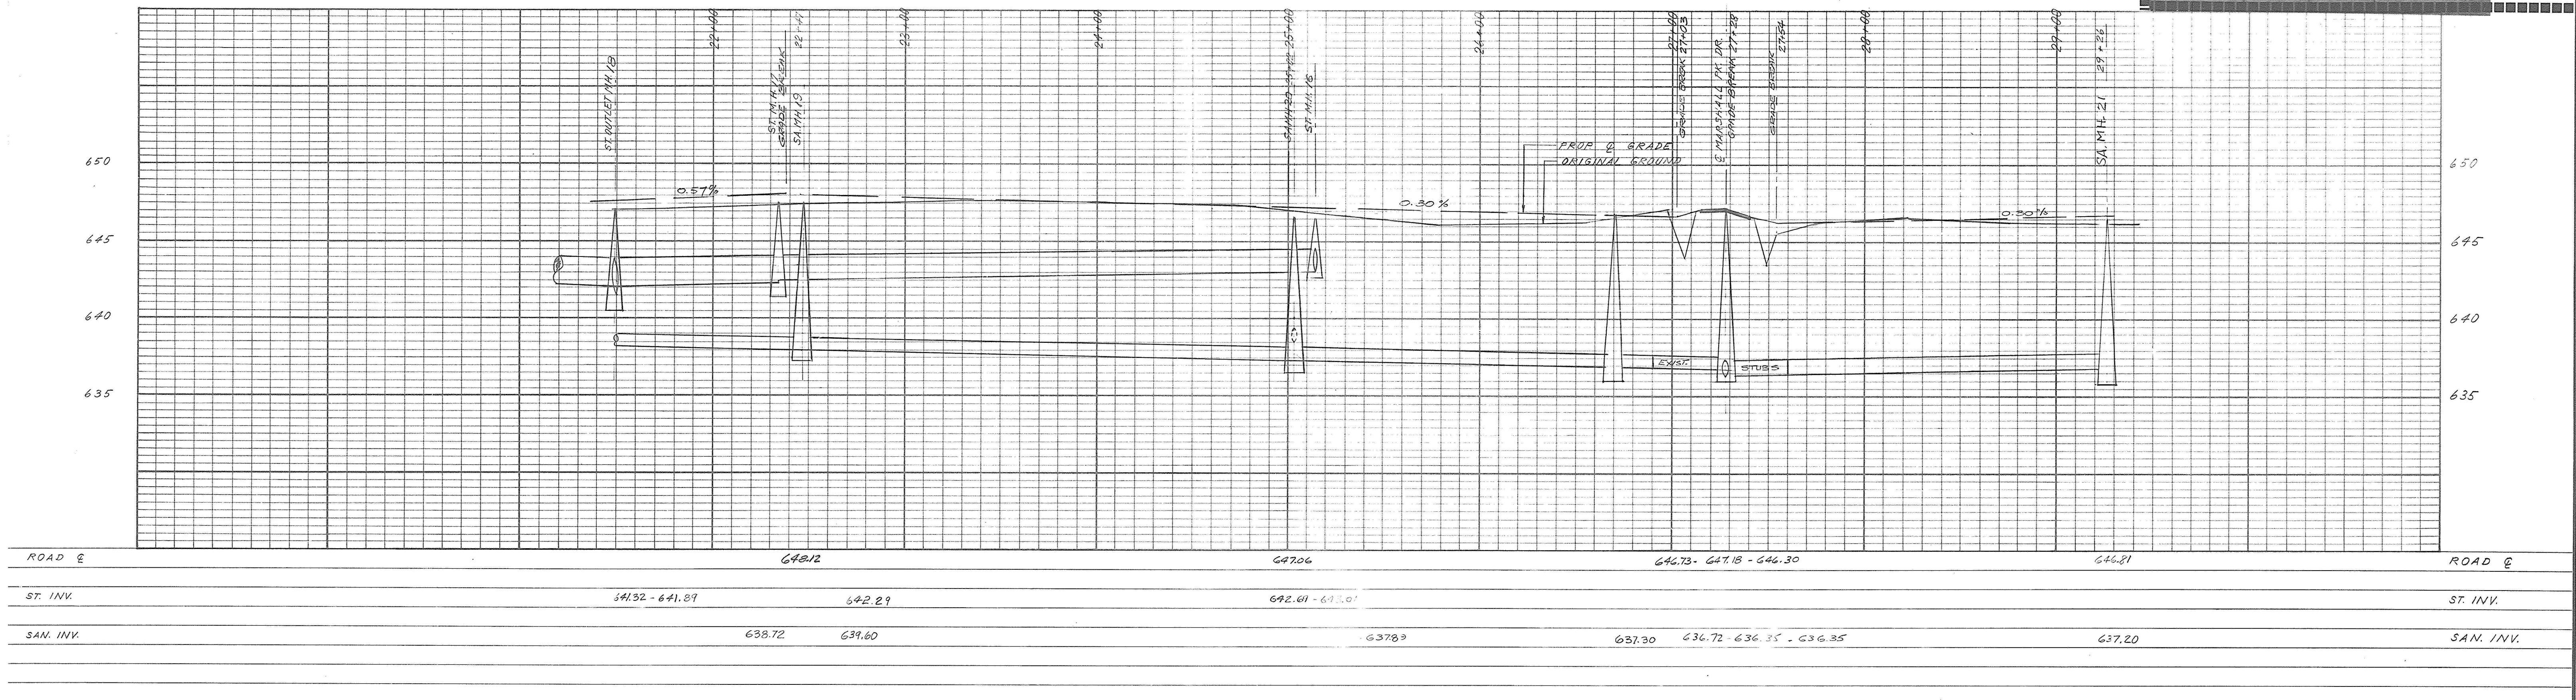
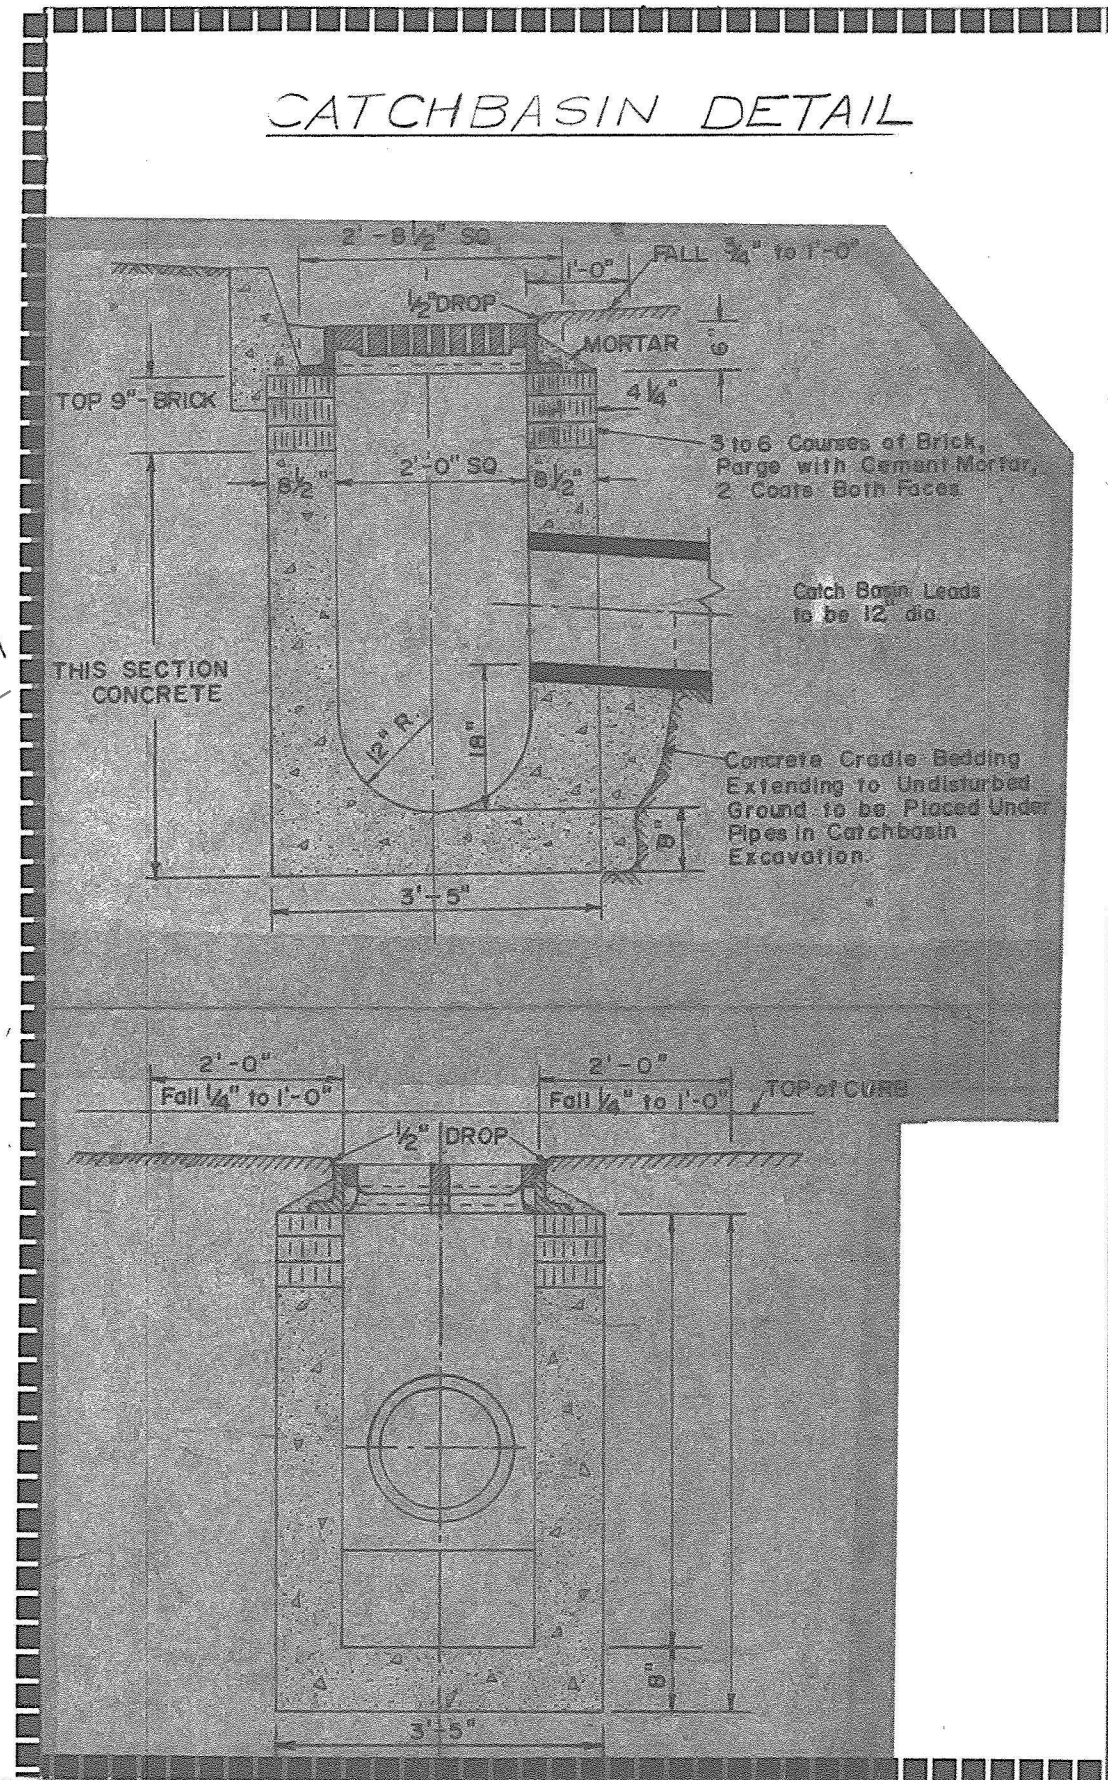


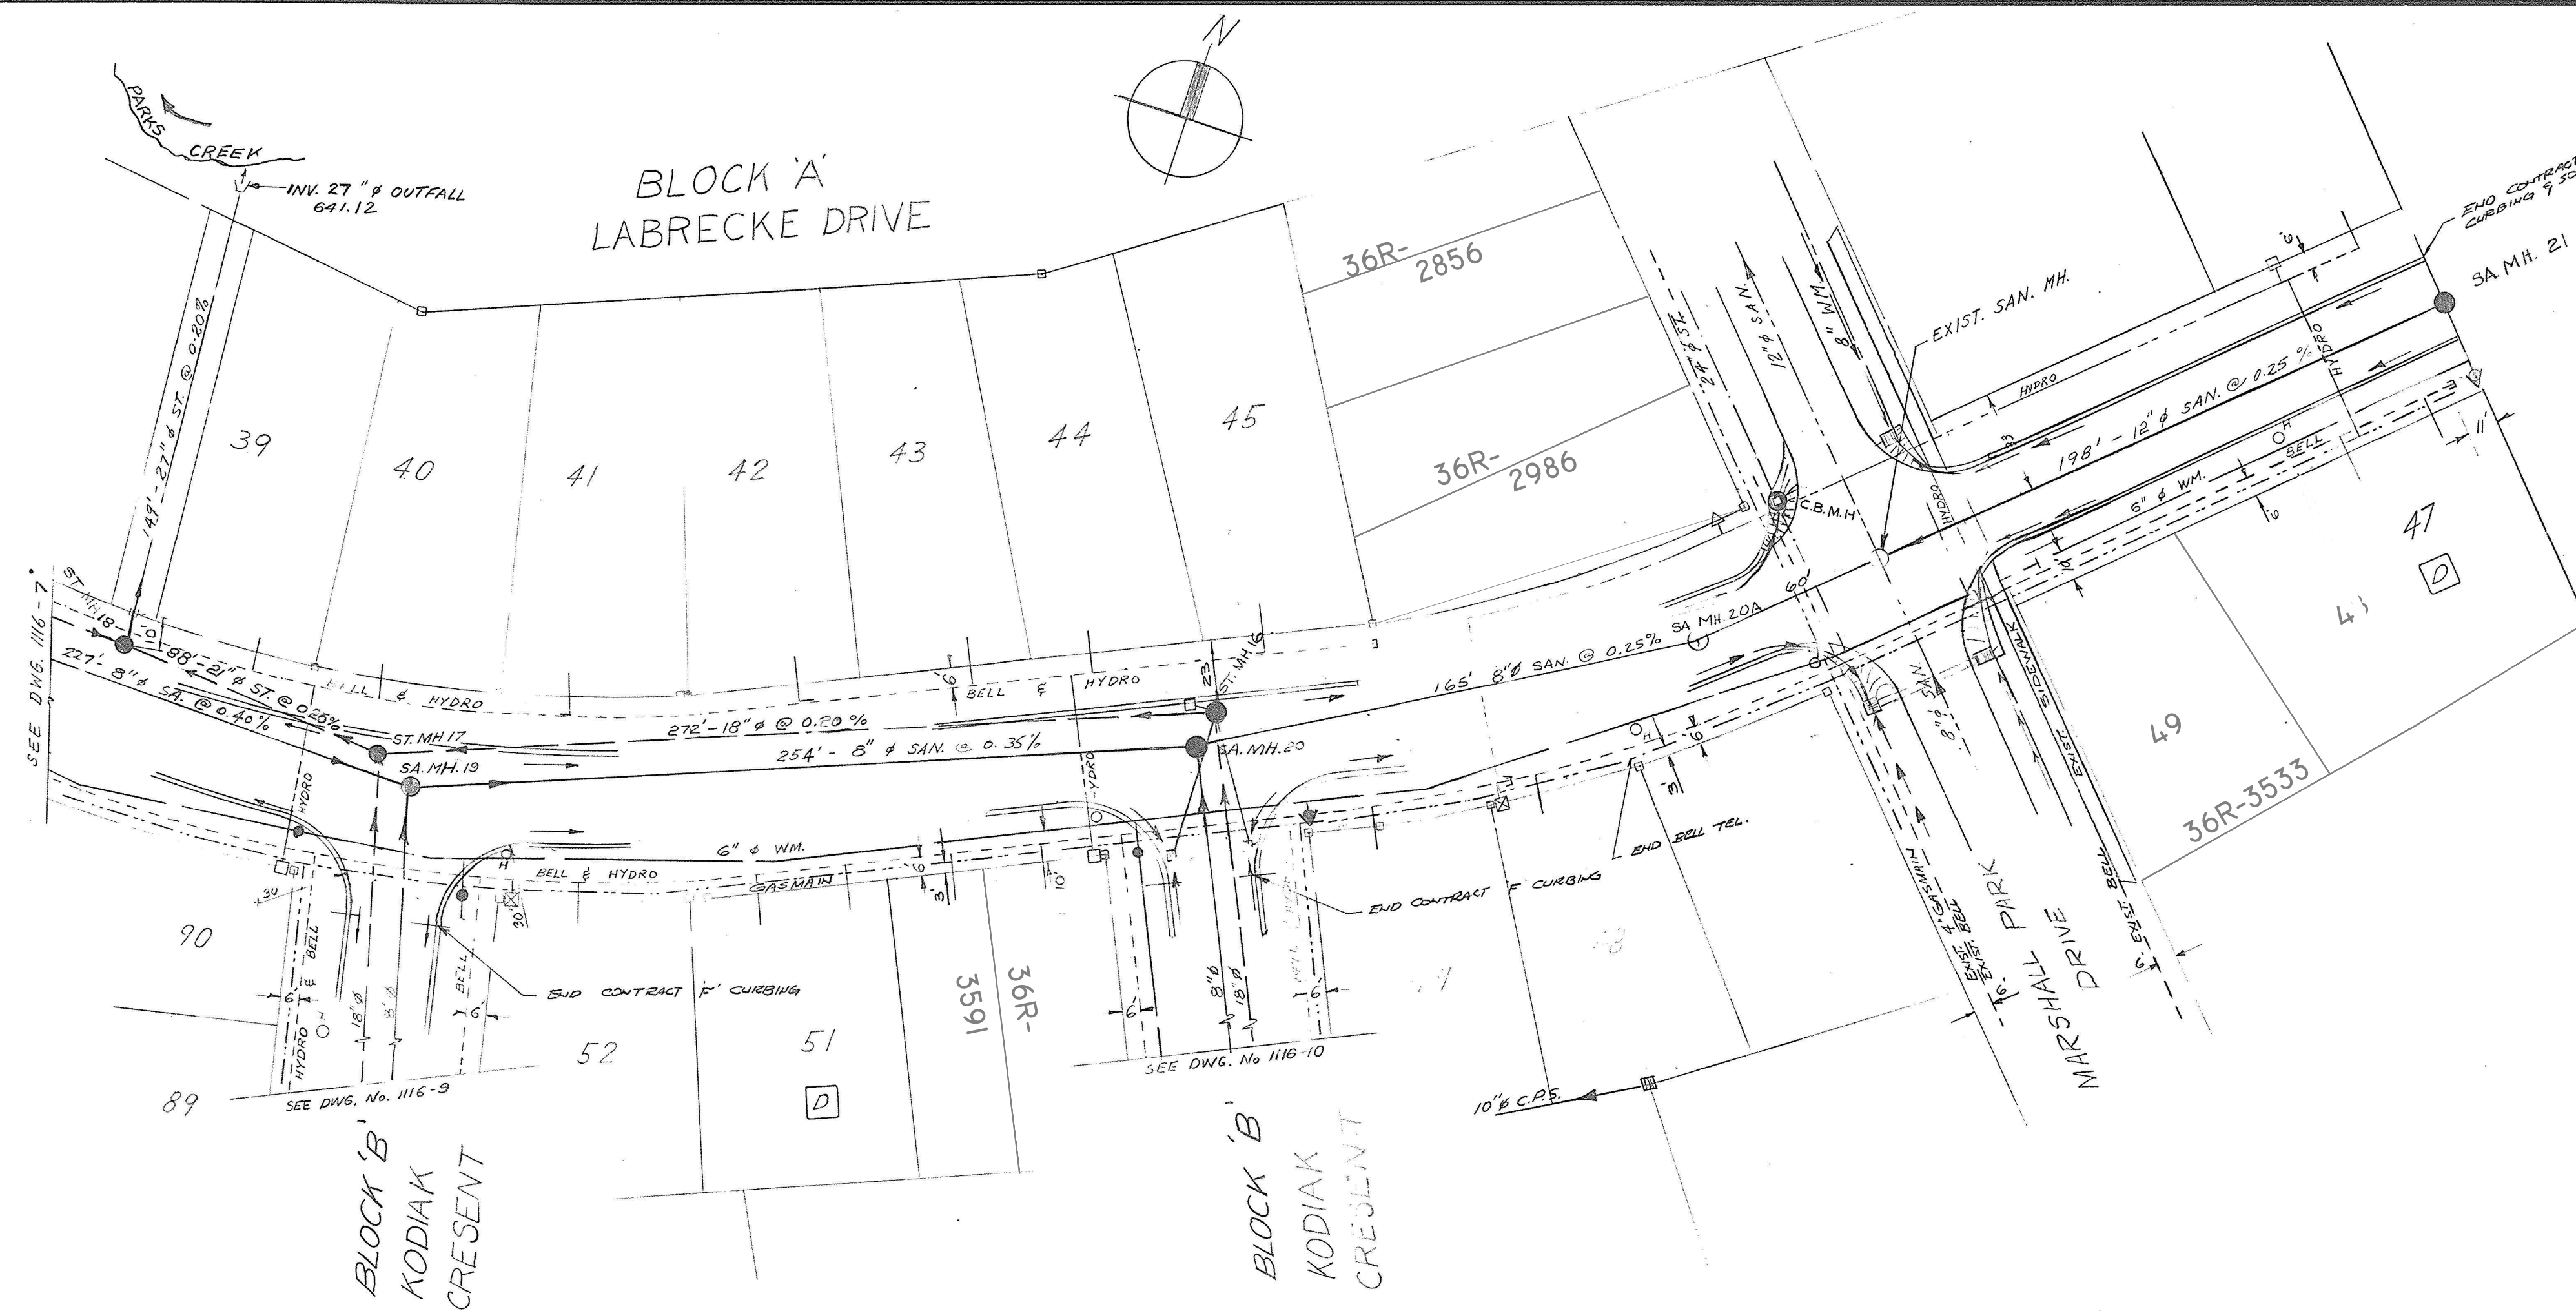

SCHEDULE C

MARSHALL PARK DEVELOPMENT LTD.
BLOCK 'A' LABRECHE DRIVE
KODIAK CRESENT WEST TO
MARSHALL PARK DRIVE

Northland Engineering Ltd.
CONSULTING CIVIL ENGINEERS
NORTH BAY - SUDBURY - TORONTO

C.	R.J.O.	REGISTERED PLANS ADDED.	Nov. 2008	DWN. BY	C. J.
B	MBB	ROAD GRADE - MARSHALL PARK DR. TO S. A. MH 19	FEB. 11/74	CHKD. BY	M. B.
A	PLC	LOT LINES REVISED	JAN 24/74	DATE	OCTOBER 1973
MK.	BY	REVISIONS	APP.	DATE	SCALE
					HOR. 1" = 40'-0"
					VER. 1" = 5'-0"



DISCLAIMER
The information contained on this drawing may be based upon data provided by others and may not have been verified by either as-constructed drawings or an Ontario Land Surveyor. The City of North Bay cannot accept responsibility for any errors or omissions on any information shown herein. Field verification, land surveys or excavation (with City approvals) may be required to determine actual location of any and all utilities or property lines.

No.
L-653