
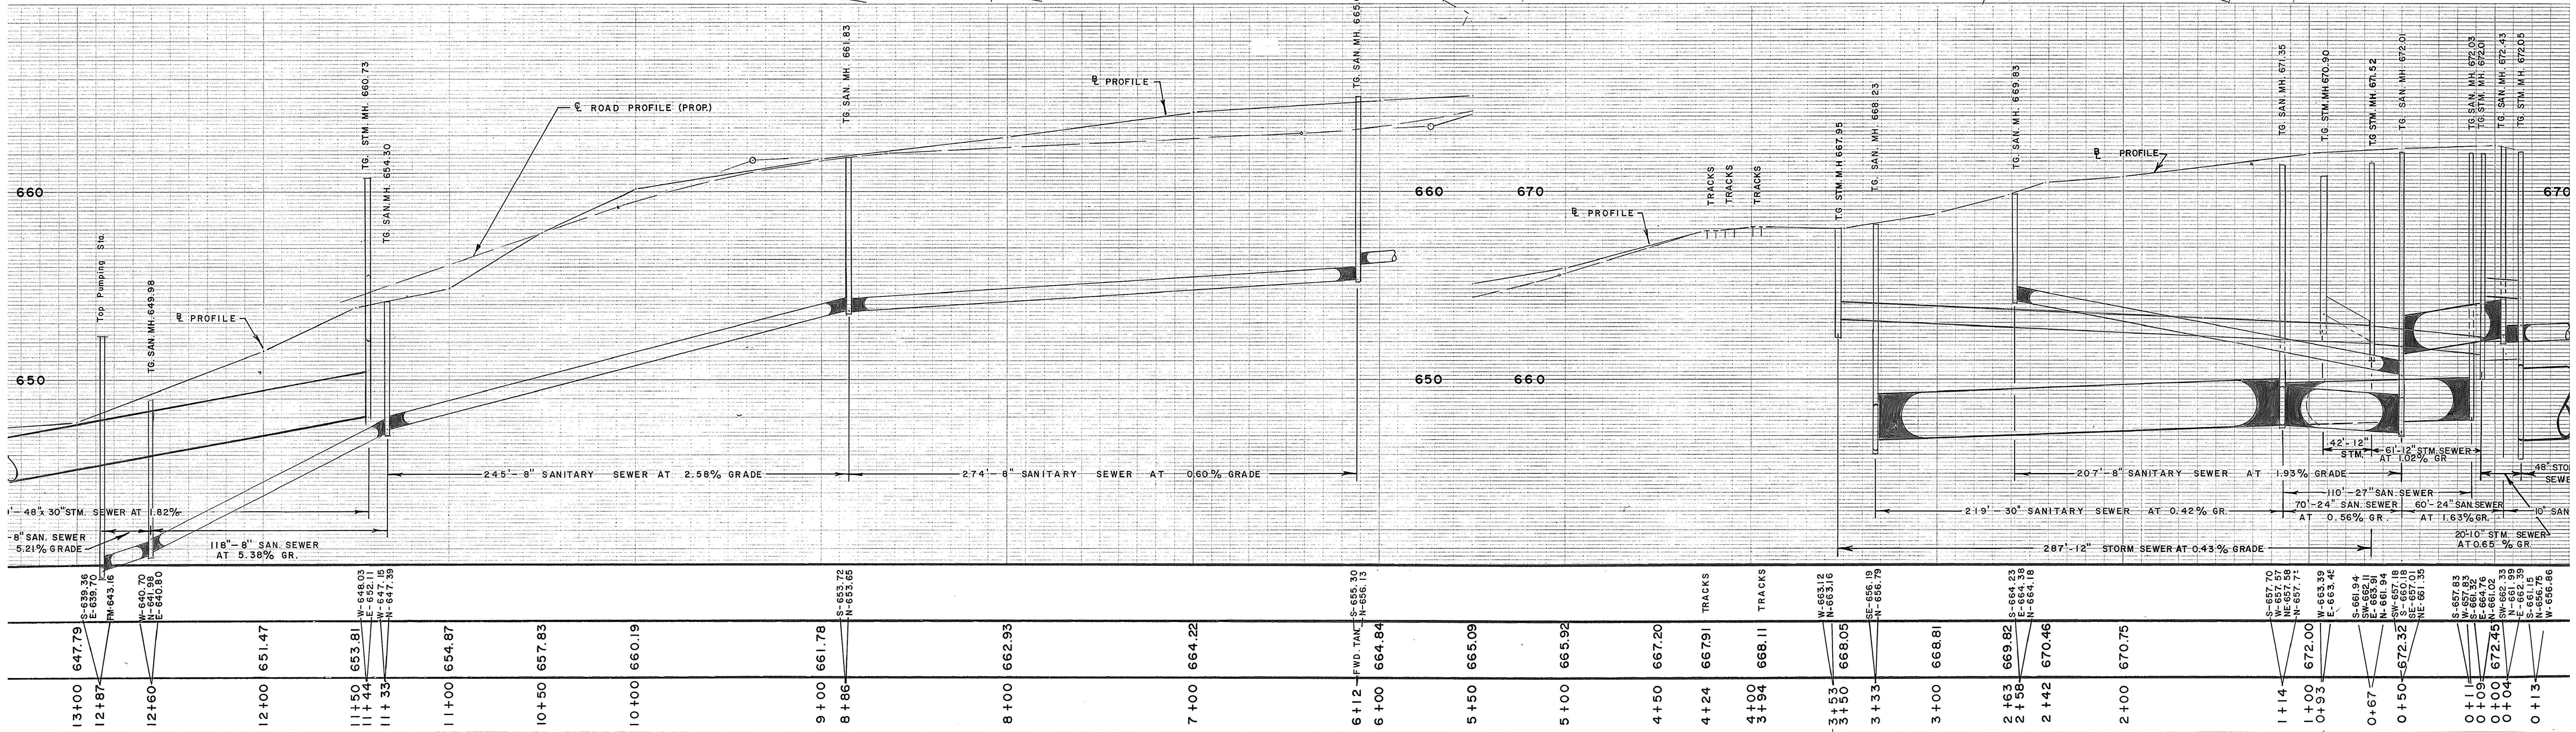
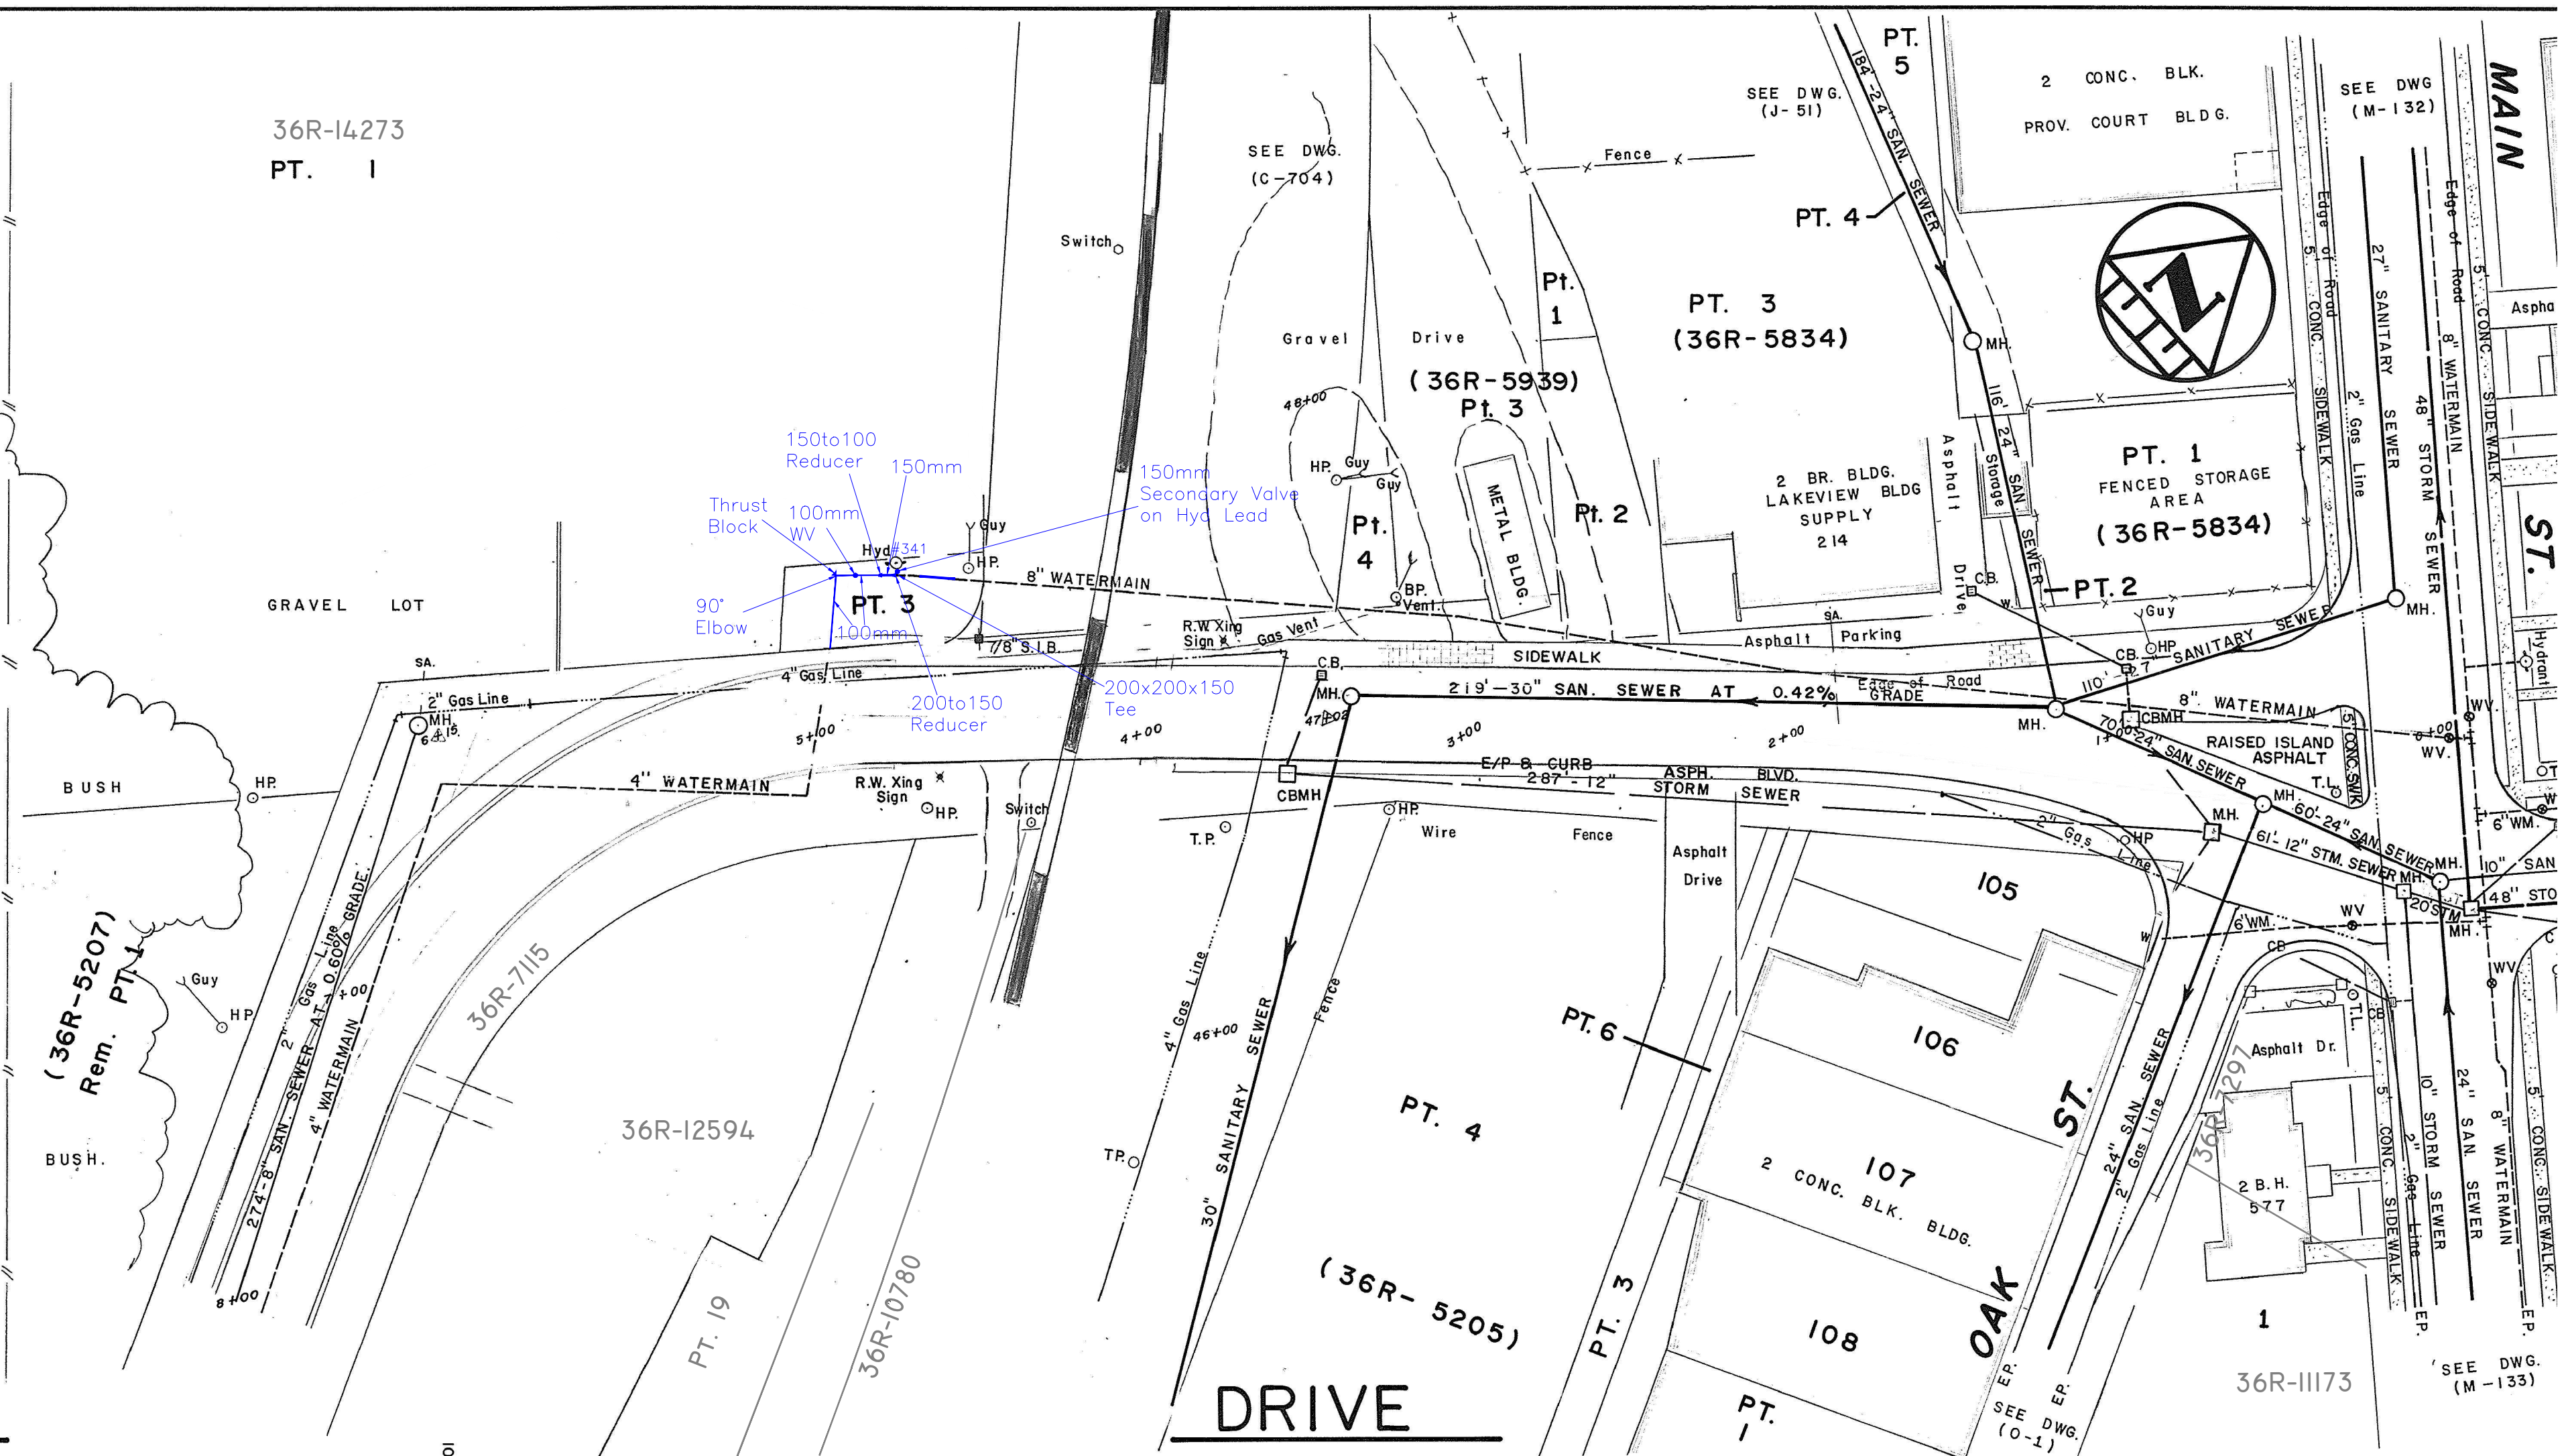


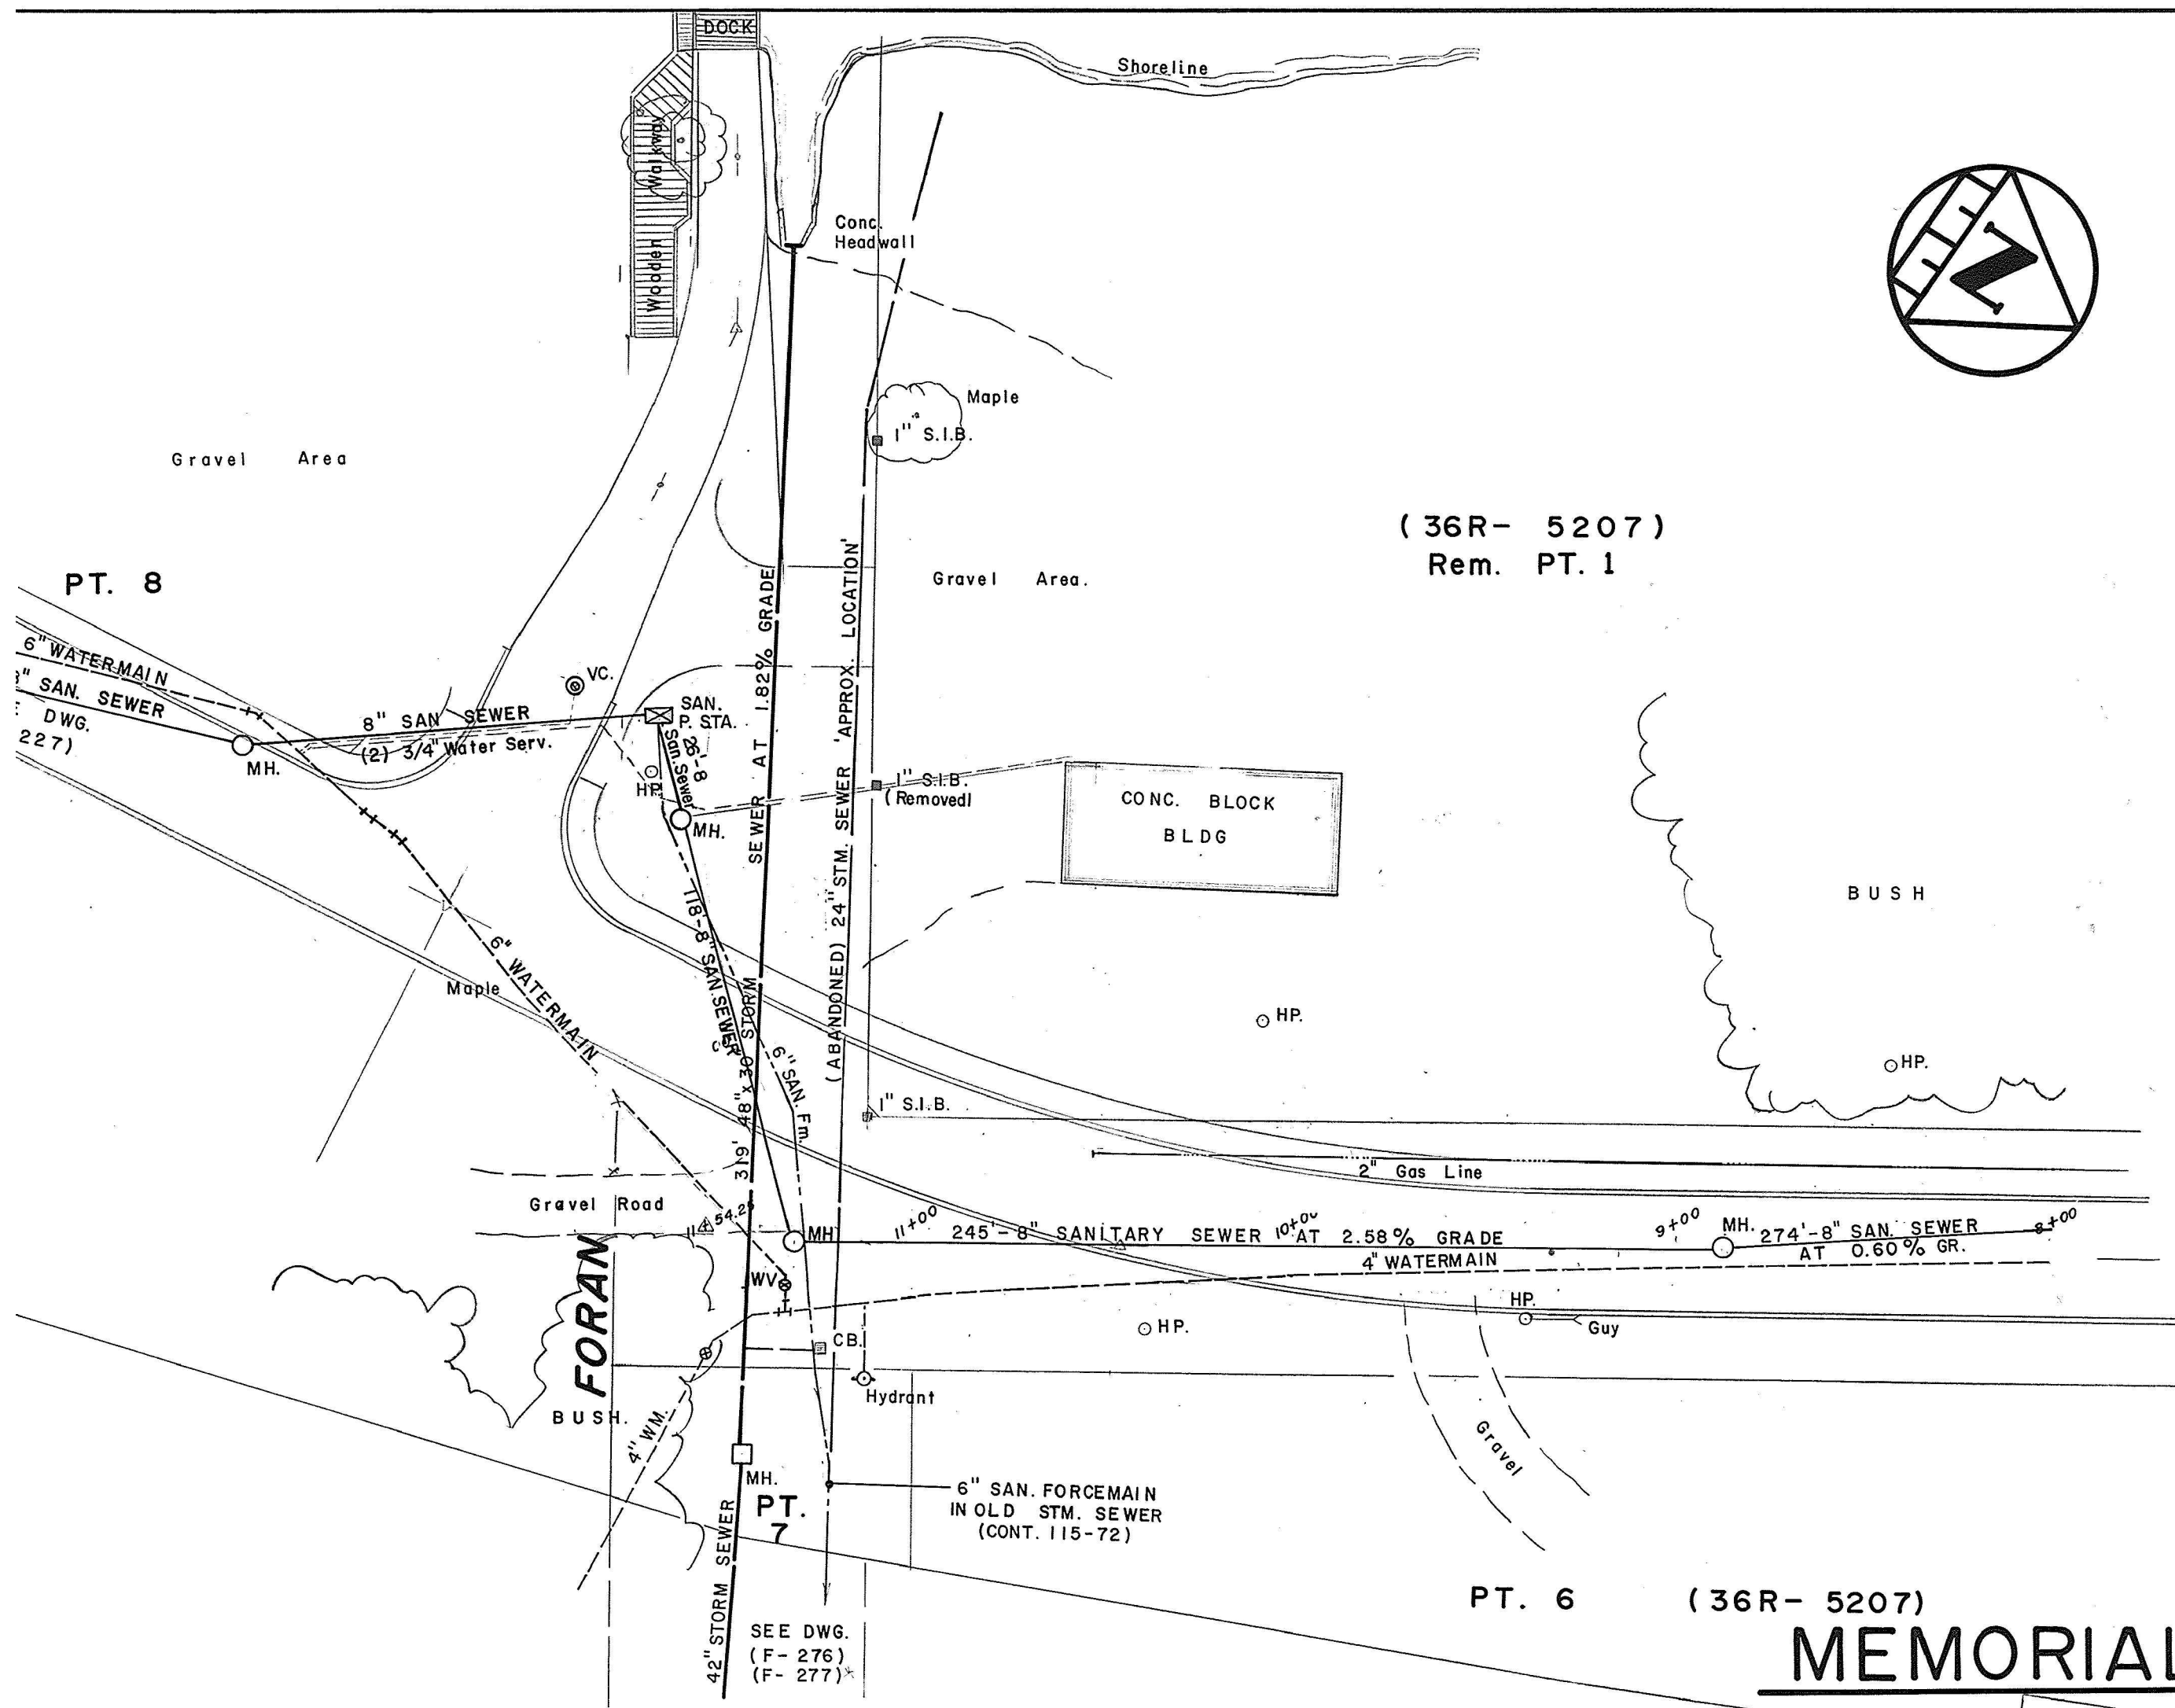

NOTES:				6. UPDATED WATER NEAR TRACKS				FEB 16				G.W.C.			
 DISCLAIMER The information contained on this drawing may be based upon data provided by others and may not have been verified by either as-constructed drawings or an Ontario Land Surveyor. The City of North Bay cannot accept responsibility for any errors or omissions on any information shown herein. Field verification, and surveys or excavation (with City approvals) may be required to determine actual location of any and all utilities or property lines.															
No.				REVISION				DATE				INITIAL			

1. NEW DWG. '1972' NOTES Revised BK.214.				OCT. 84.				R.B.							
2. AS CONST'D. WATERMAIN BK 222 1972				---				---							
AS CONST'D. SAN. 6+12 -- 12+87 BK 229 (115-72)				---				---							
AS CONST'D. CANADORE 30" SAN. (115- 76)				---				---							
3. WATERFRONT AS CONST'D. BK. 278 Cgn 101-85				JUNE 85				R. B.							
4 AS CONST'D STORM SEWER MEMORIAL DR. MAIN ST.				APRIL 91				R.T							
5. REGISTERED PLANS ADDED.				JAN 2019				R.J.O.							
No.				REVISION				DATE				INITIAL			

APPROVED			