



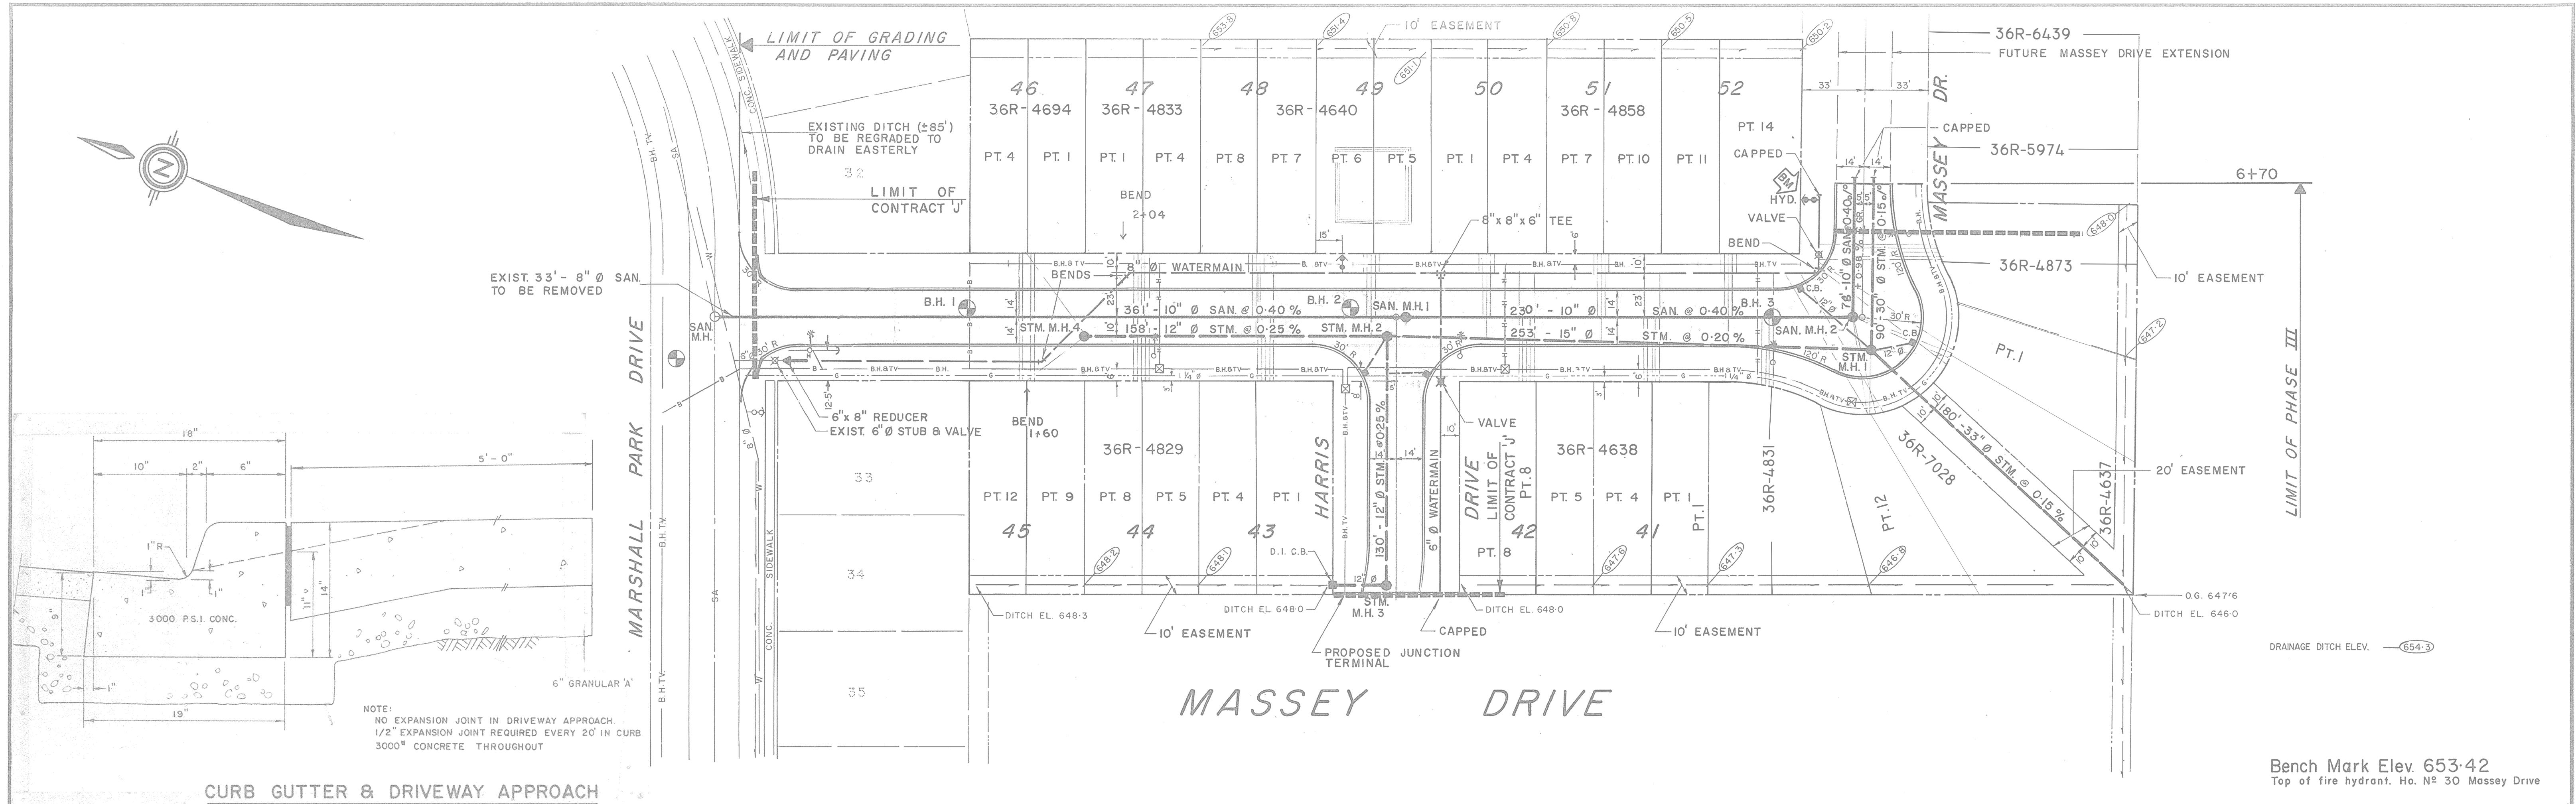

Bench Mark Elev. 653.42
Top of fire hydrant. Ho. N° 30 Massey Drive

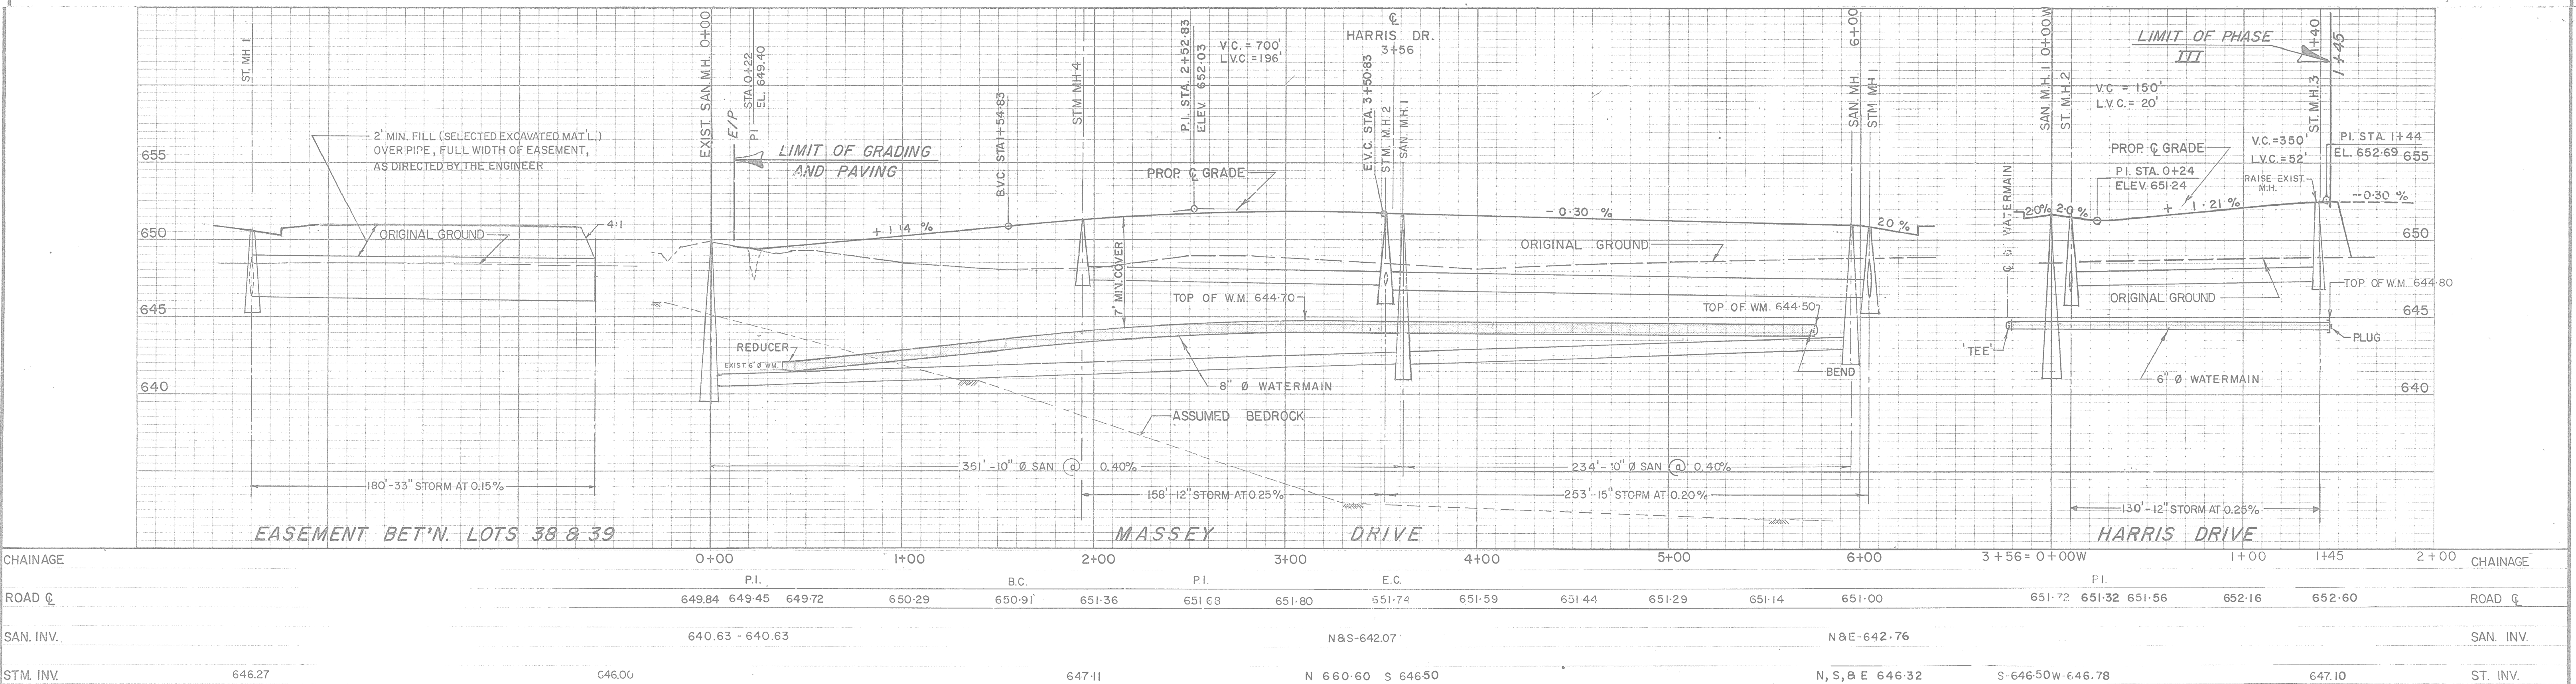

DISCLAIMER
The information contained on this drawing may be based upon data provided by others and may not have been verified by either as-constructed drawings or an Ontario Land Surveyor. The City of North Bay cannot accept responsibility for any errors or omissions on any information shown herein. Field verification, land surveys or excavation (with City approval) may be required to determine actual location of any and all utilities or property lines.

CATV PLANT APPROVED <i>[Signature]</i> 6/27/77 McLEAN - HUNTER Cable T.V. Ltd. Date	GAS PLANT APPROVED <i>[Signature]</i> 6/27/77 Northern & Central Gas Corp. Ltd. Date
HYDRO PLANT APPROVED <i>[Signature]</i> 6/27/77 North Bay Hydro Date	BELL PLANT APPROVED <i>[Signature]</i> 1977-10-11 Bell Canada Ltd. Date

8.	R.J.O.	REGISTERED PLANS ADDED.	DEC 2008
7.	P.L.C.	ADD BENCH MARK AND STORM INVERT M.H.1	JUNE '79
6.	D.P.C.	REVISE ROAD GRADE ON HARRIS DR.	APR '78
5.	P.L.C.	LIMITS OF CONTRACT 'J'	
4.	R.E.A.	BACK OF LOT DRAINAGE ADDED.	NOV '77
3.	R.D.	AS CONSTRUCTED	OCT 77
2.	D.P.C.	REVISE RD. GRADE STA. 1+54.85 TO 6+00 MASSEY DR. 0+00 TO 1+45 ON HARRIS DR. REV. STM. & WM. GRADES, DELET. SAN. ON HARRIS DR.	M.B. AUG. 1977
1.	B.A.	STORM SEWERS, ROAD GRADE, DITCHES	F.V.M. MARCH 1977
MK.	BY	REVISIONS	APP. DATE

MARSHALL PARK DEVELOPMENT LTD.

MASSEY DRIVE
MARSHALL PARK DR. TO STA. 6+00

Northland Engineering Ltd.
CONSULTING CIVIL ENGINEERS
NORTH BAY - SUDBURY - TORONTO

No.
M-1076