


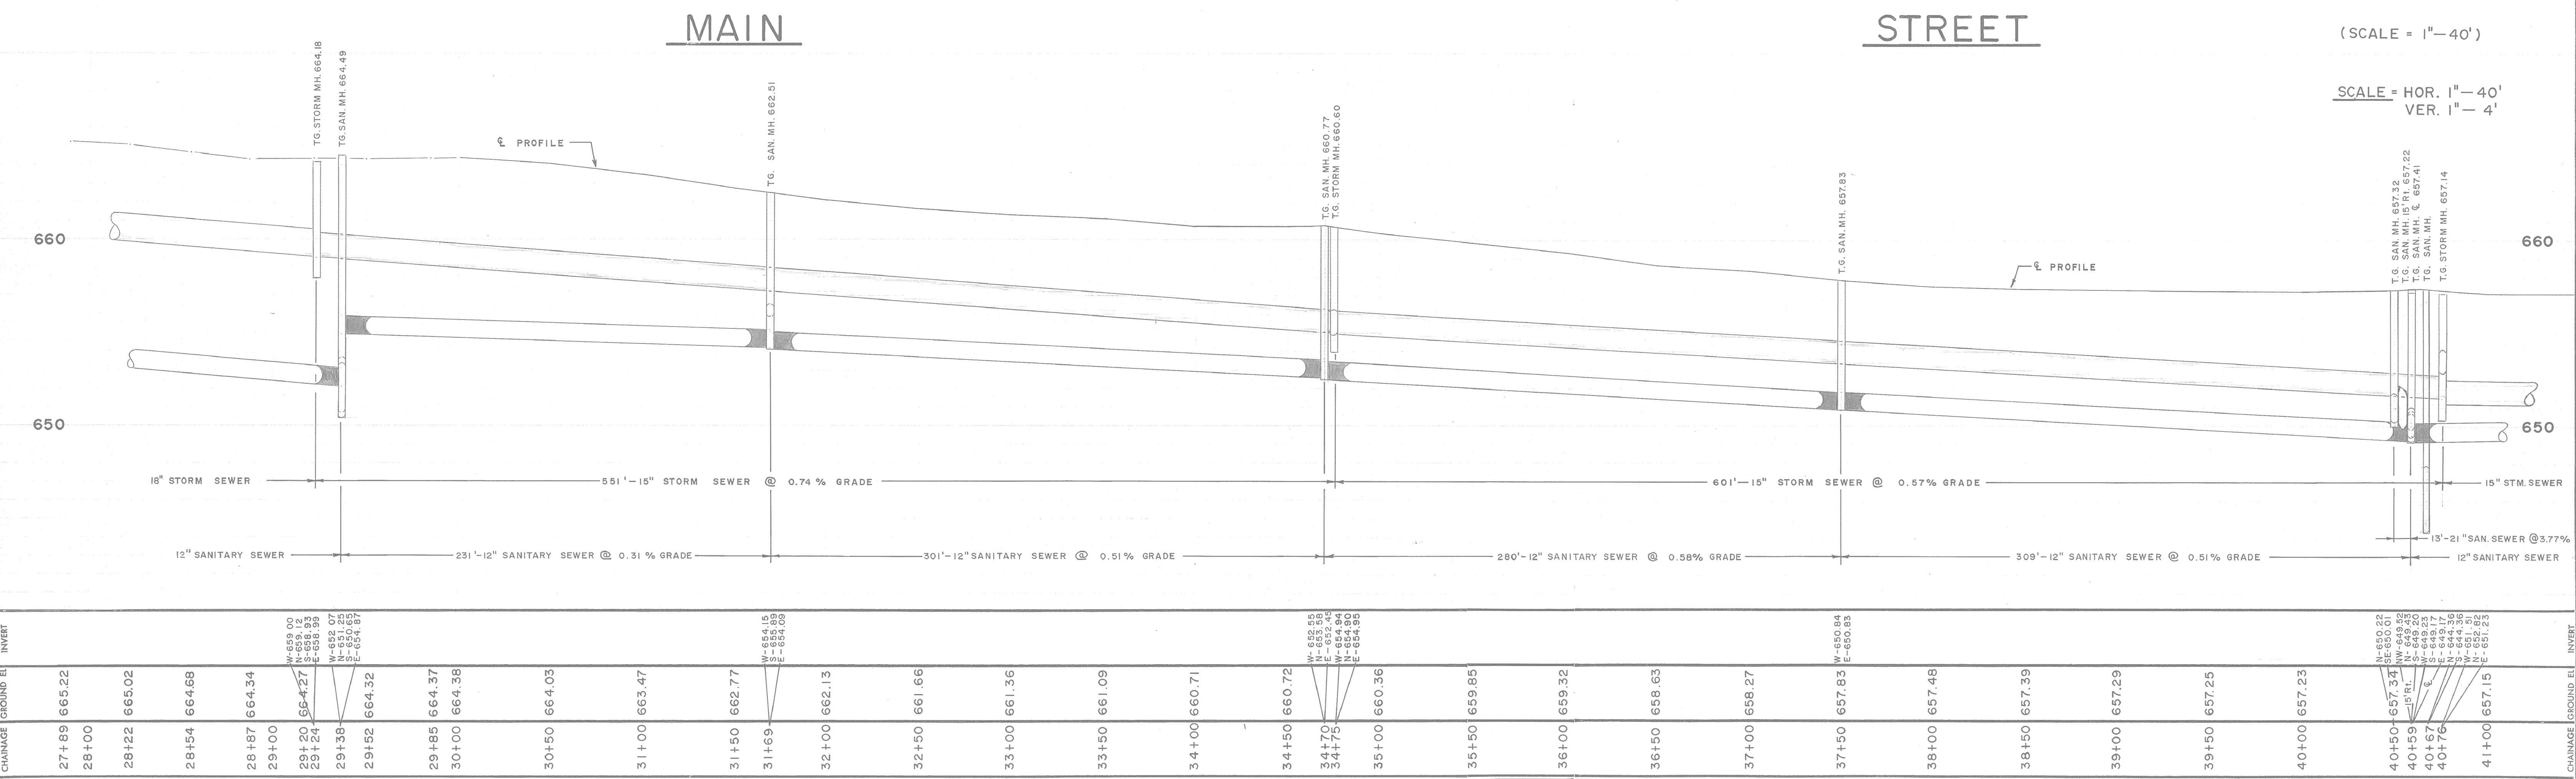

NOTES: DISCLAIMER The information contained on this drawing may be based upon data provided by others and may not have been verified by either as-constructed drawings or an Ontario Land Surveyor. The City of North Bay cannot accept responsibility for any errors or omissions on any information shown herein. Field verification, land surveys or excavation (with City approvals) may be required to determine actual location of any and all utilities or property lines.	1. 42" SANITARY SEWER AT REGINA ST. DEC. 75. R. F. B. APPROVED				MAIN STREET SHERBROOKE STREET TO REGINA STREET REG'D. PLAN N ^o . 10		CITY OF NORTH BAY ENGINEERING DEPARTMENT						
	2. REVISED INTERSECTION AT SHERBROOKE ST. NOV. 81. R. F. B.												
	3. DOWNTOWN IMPROVEMENT Cassells To Sherbrooke CONT. 101-83 BK. 272 As Const. JAN. 85 R. F. B.												
	4. REGISTERED PLANS ADDED. NOV 08 R. J. O.				SCALE: As Shown. DATE: NOV. 73.		DRAWN BY: <i>WJB</i> CK'D. BY:		FIELD BOOK N ^o . # 213		DRAWING N ^o . M-136		REV.
	No. REVISION				DATE		INITIAL						