
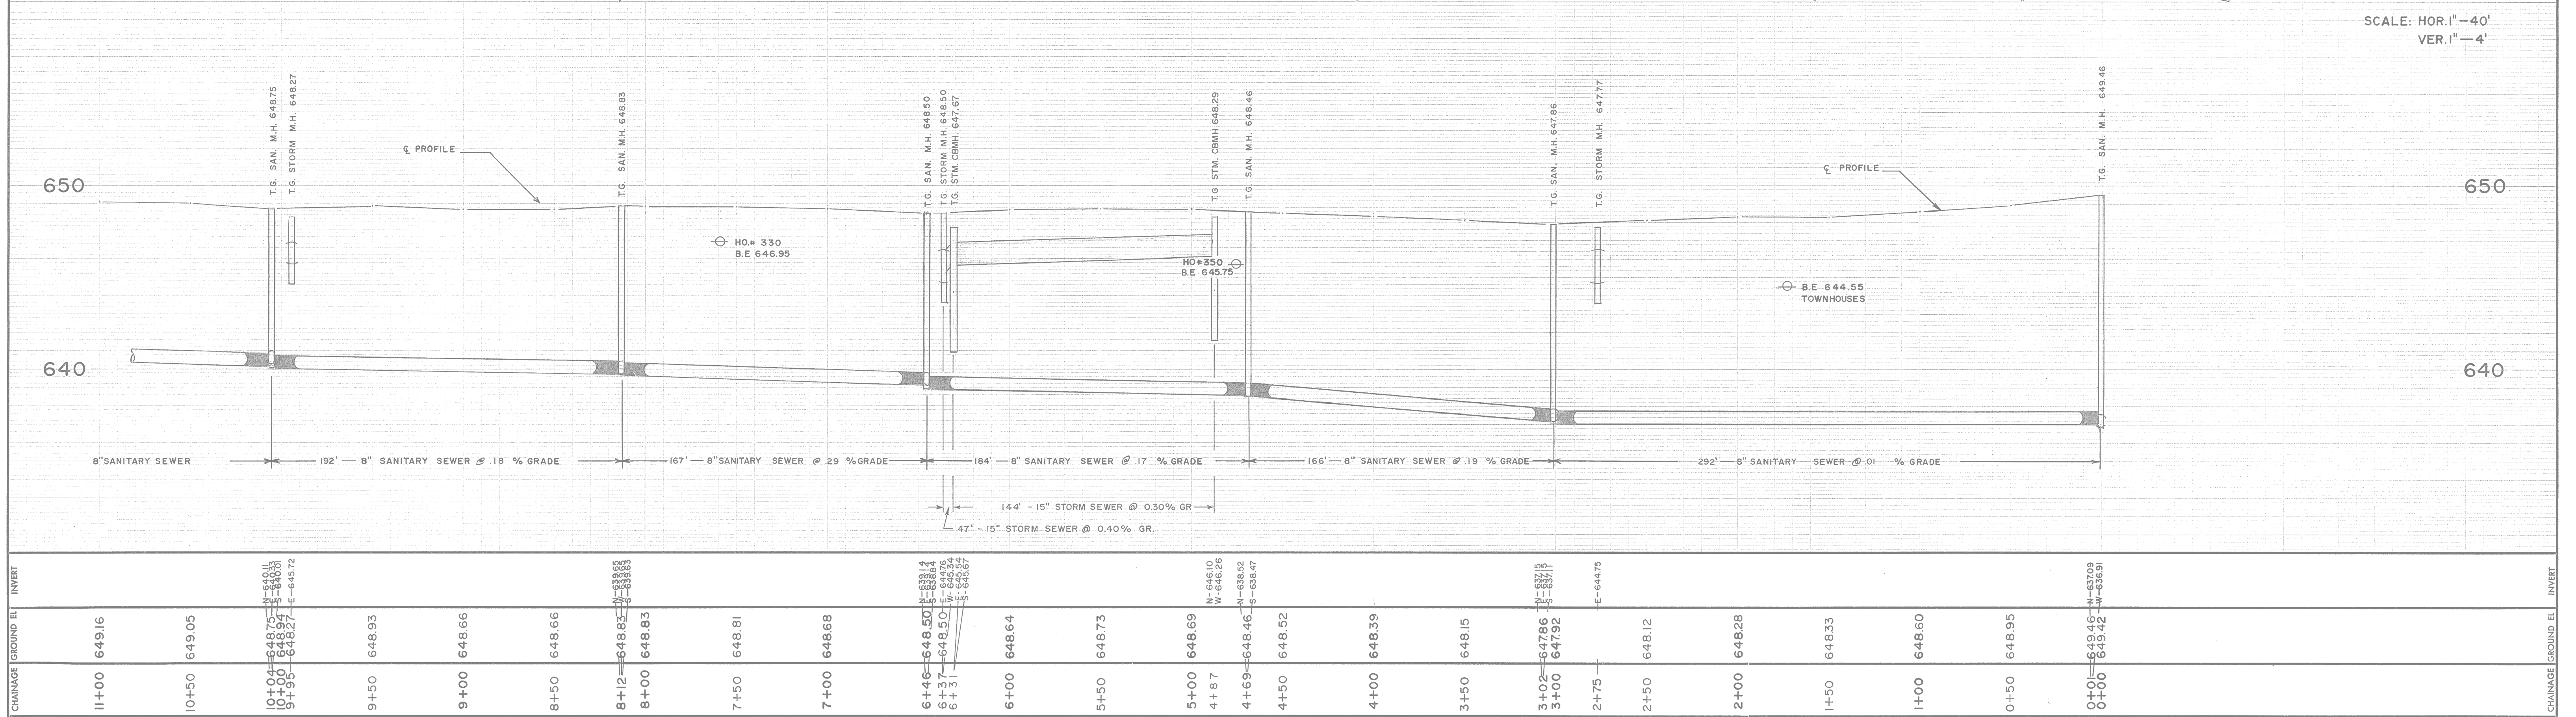


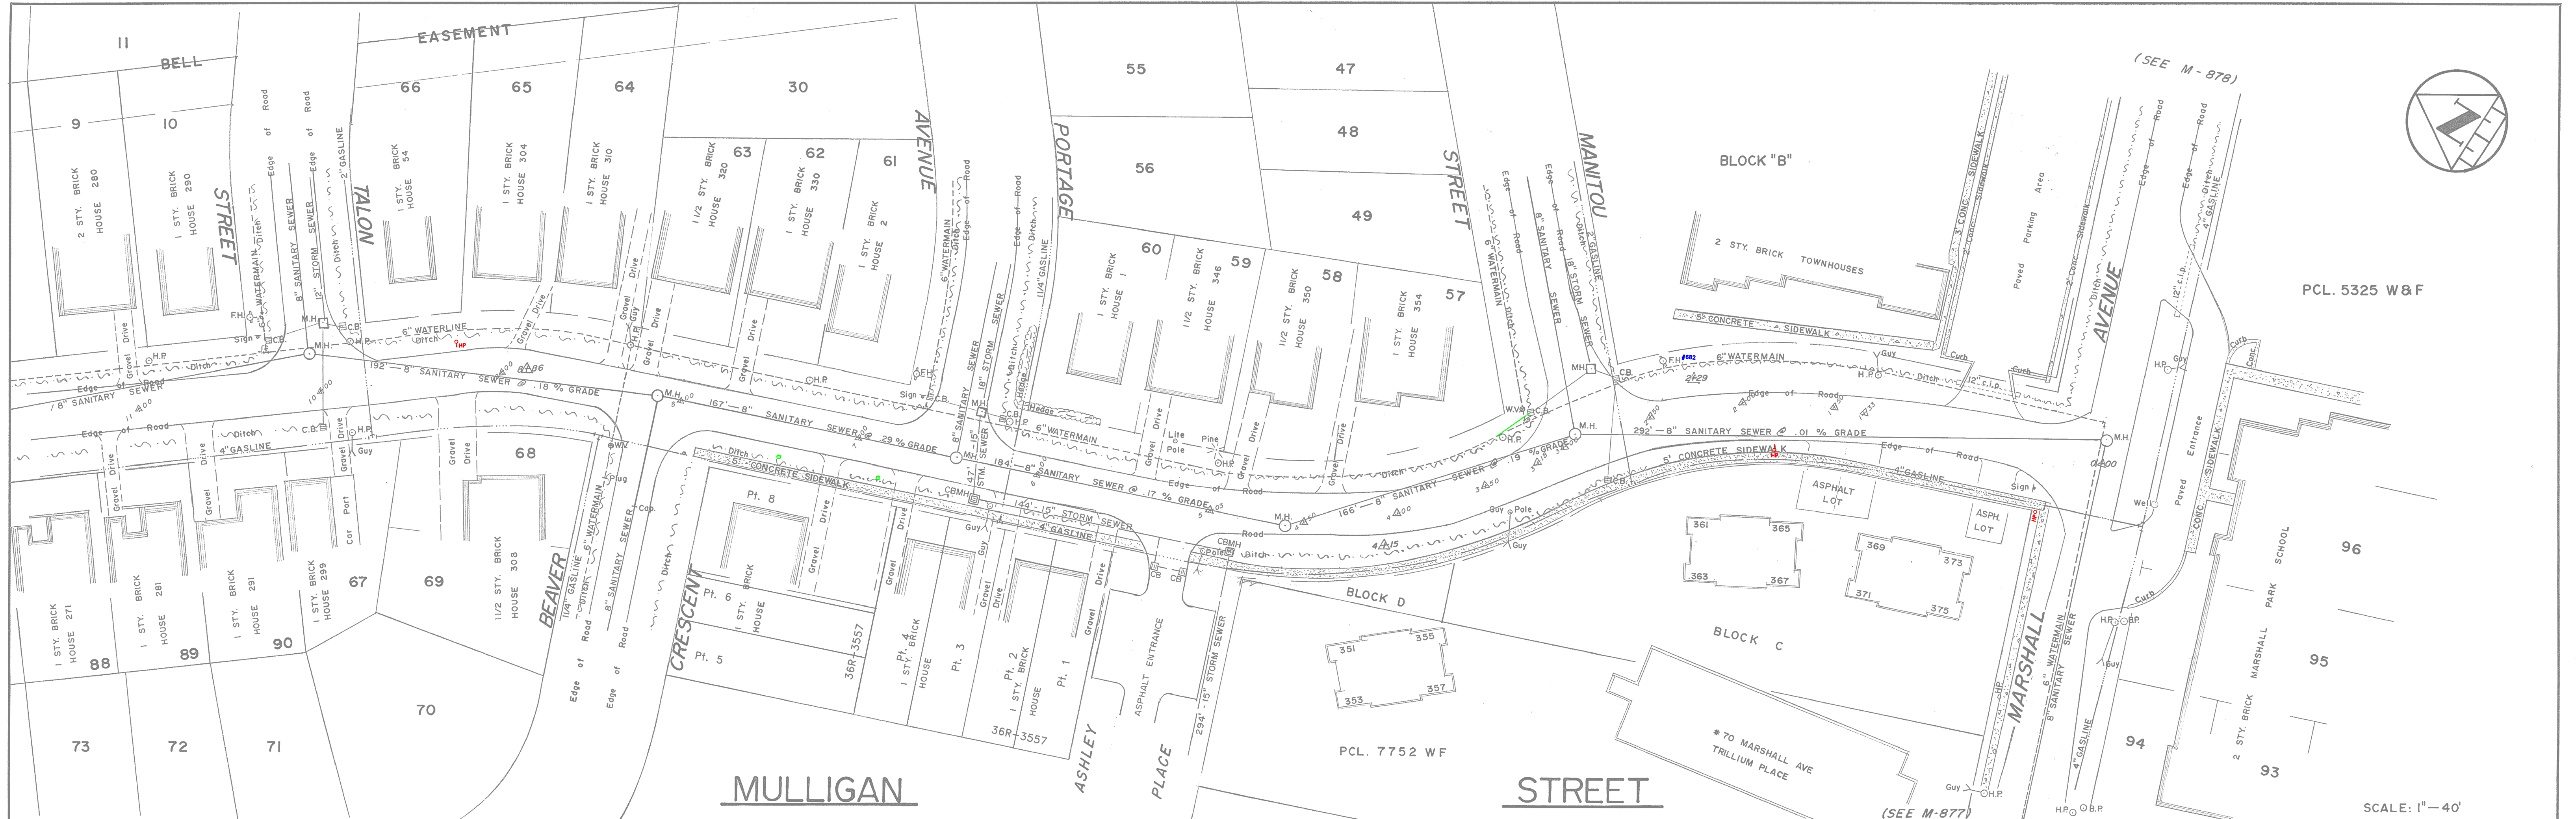

DWC: 10'	NOTES:	DISCLAIMER The information contained on this drawing may be based upon data provided by others and may not have been verified by either as-constructed drawings or an Ontario Land Surveyor. The City of North Bay cannot accept responsibility for any errors or omissions on any information shown herein. Field verification, land surveys or excavation (with City approvals) may be required to determine actual location of any and all utilities or property lines.	1. NEW DRAWING. MAR. 75 A.P.				APPROVED	MULLIGAN STREET				CITY OF NORTH BAY				
			2. NEW C PROFILE B.M.H. ELEV'S. APR. 75 A.P.					MARSHALL AVE. TO TALON STREET				ENGINEERING DEPARTMENT				
			3. AS CONST. SDWK. NOV. 84 J.S.					REG'D. PLAN N ^o . M-364, M-431.				SCALE: AS SHOWN DATE: MAR. 75.				
			4. 15" STORM SEWER - PORTAGE TO ASHLEY PL. (AS PER NORTHLAND ENG. DWGS.) MAR. 94 P.L.C.									DRAWN BY: A.P. FIELD BOOK No. 241 DRAWING No. M-328 REV.				
			5. Registered Plans Added. Nov. 08 r.j.o.													
					No.			REVISION		DATE		INITIAL				