


M-727

CIRCLE
LAKE

CON. C
CON. D

MADELENA
DRIVE

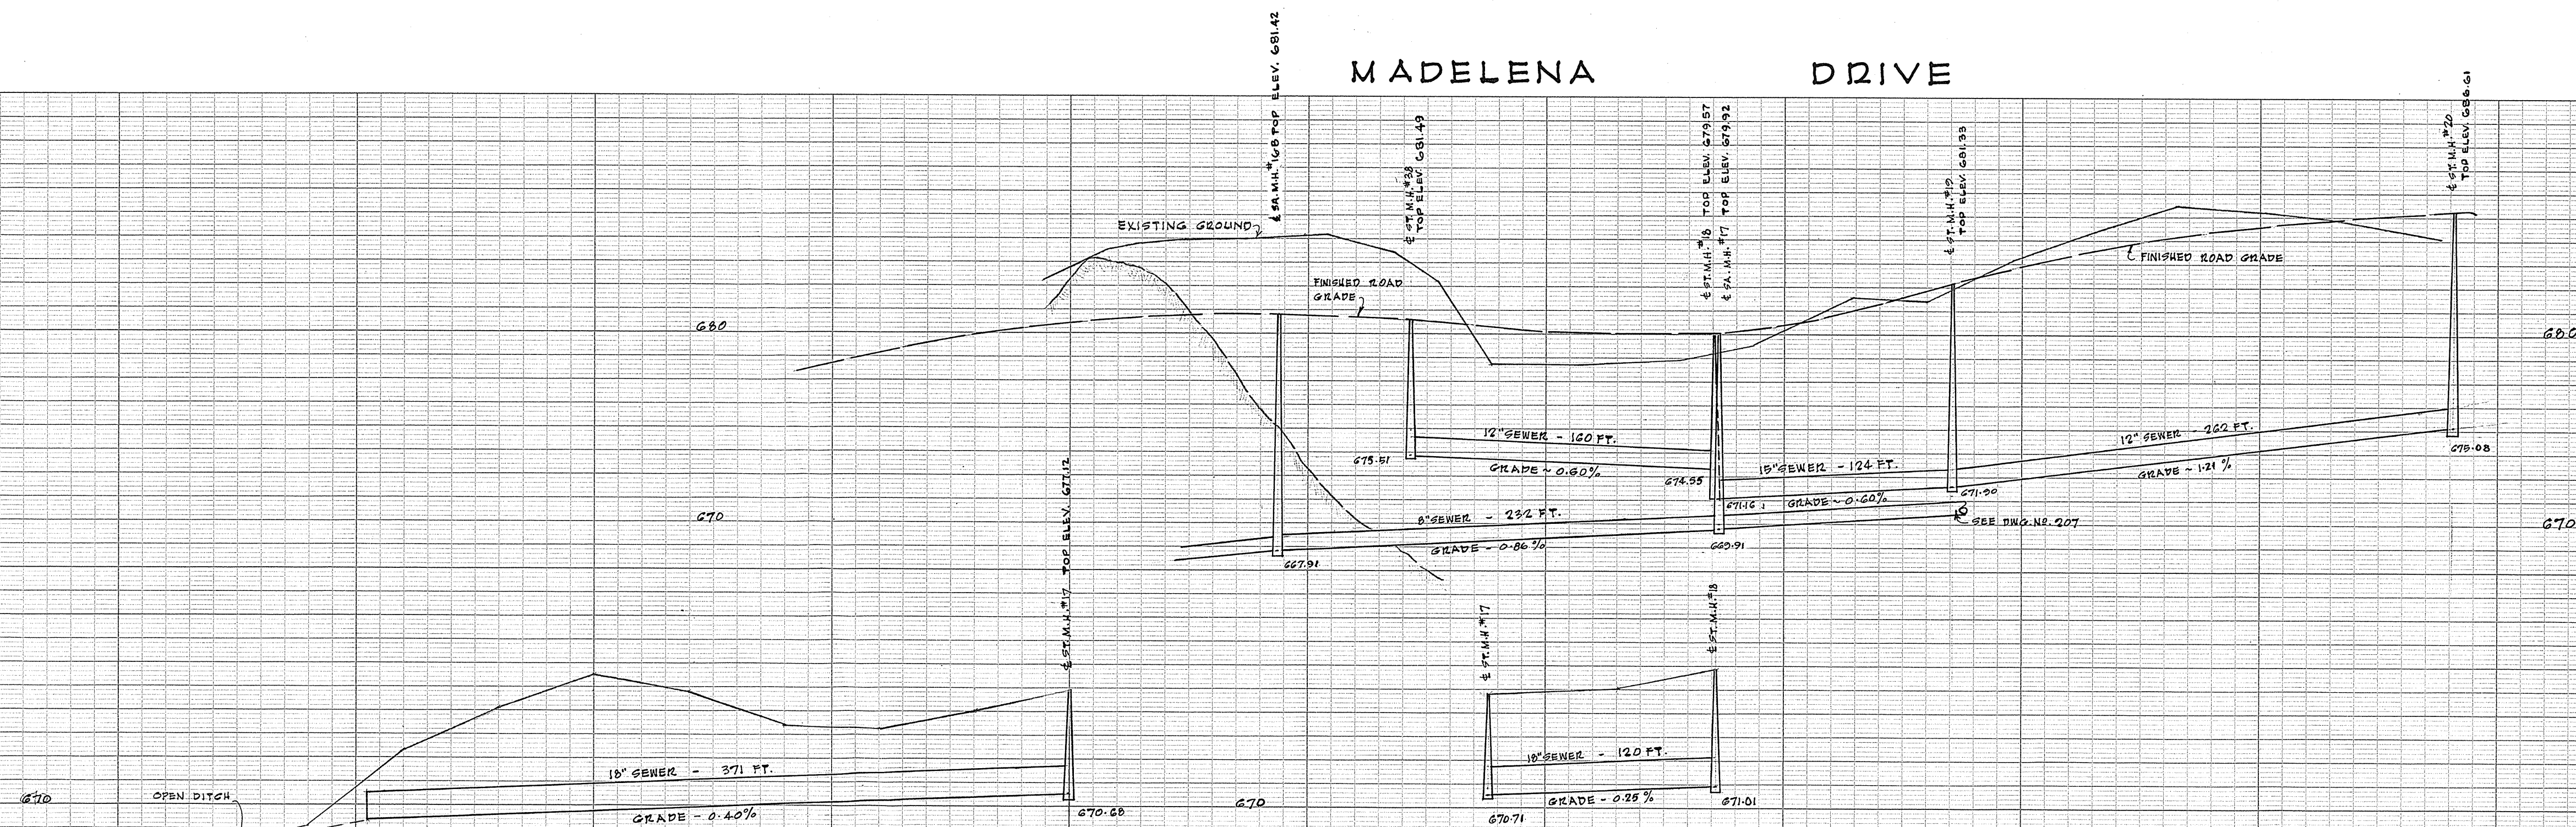

DISCLAIMER
The information contained on this drawing may be based upon data provided by others and may not have been verified by either as-constructed drawings or an Ontario Land Surveyor. The City of North Bay cannot accept responsibility for any errors or omissions on any information shown herein. Field verification, land surveys or excavation (with City approvals) may be required to determine actual location of any and all utilities or property lines.

CENTRAL MORTGAGE & HOUSING CORPORATION
URBAN MILITARY HOUSING PROJECT 1-60
NORTH BAY • ONTARIO

MADELENA DRIVE
FROM S.A.M.H.#16 TO S.T.M.H.#20
EASEMENT No 23

NORTHLAND ENGINEERING
CONSULTING CIVIL ENGINEERS
NORTH BAY • ONTARIO

APPROVALS		W.K.	DATE	REVISION	BY	CHECKED BY	DATE
A MAY 15/64 AS CONSTRUCTED		AFR					

SCALE - HORIZ. 1" = 50 FT.
VERT. 1" = 5 FT.

DWG. No. M-727

KEUFFEL & ESSER CO.
NEW YORK

TAKE STANDARD MARK
8 1/2 X 11 1/2 IN. SHEET
PROFILE PLATE A 4 X 20
100% MAG. PAPER
MADE IN U.S.A.

KEUFFEL & ESSER CO.
NEW YORK

TAKE STANDARD MARK
8 1/2 X 11 1/2 IN. SHEET
PROFILE PLATE A 4 X 20
100% MAG. PAPER
MADE IN U.S.A.

KEUFFEL & ESSER CO.
NEW YORK