



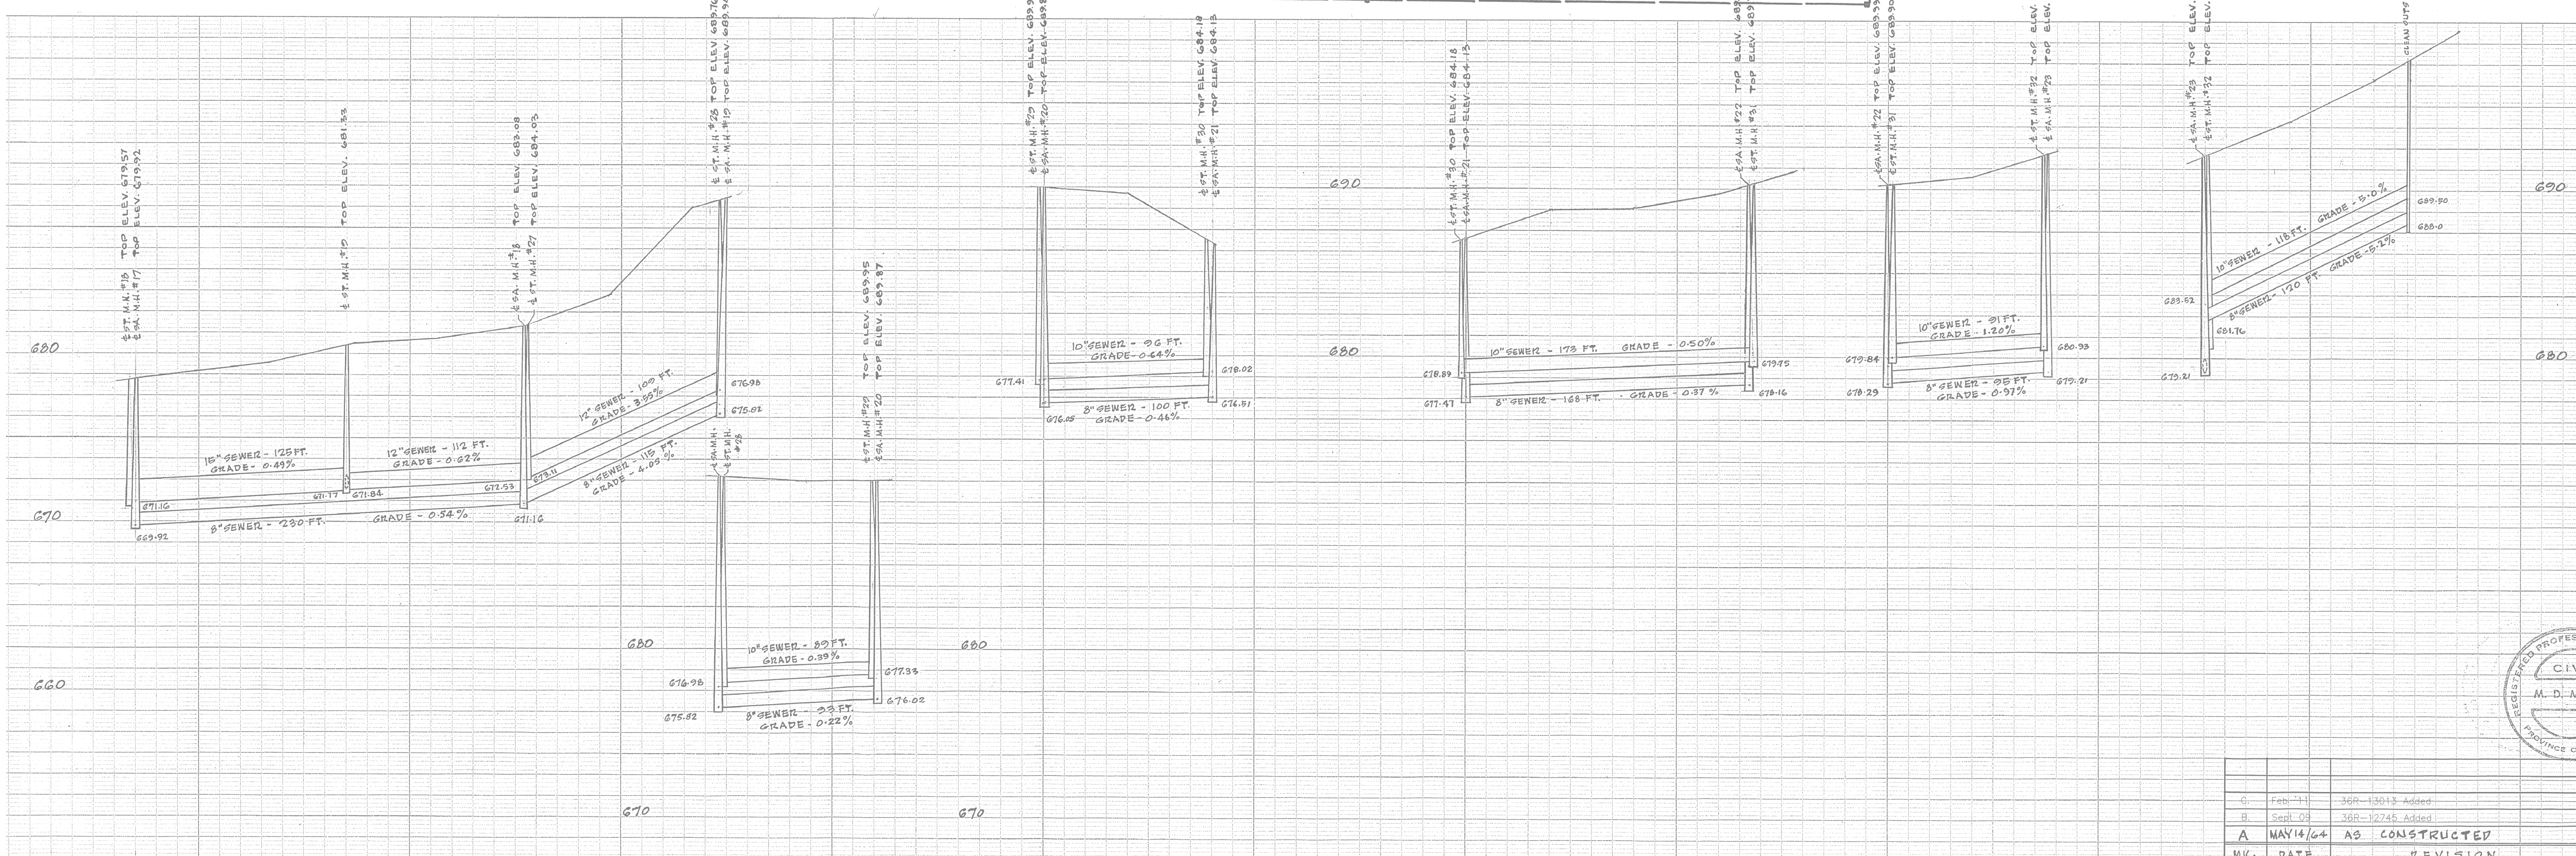

DISCLAIMER
The information contained on this drawing may be based upon data provided by others and may not have been verified by either as-constructed drawings or an Ontario Land Surveyor. The City of North Bay cannot accept responsibility for any errors or omissions on any information shown herein. Field verification, land surveys or excavation (with City approvals) may be required to determine actual location of any and all utilities or property lines.

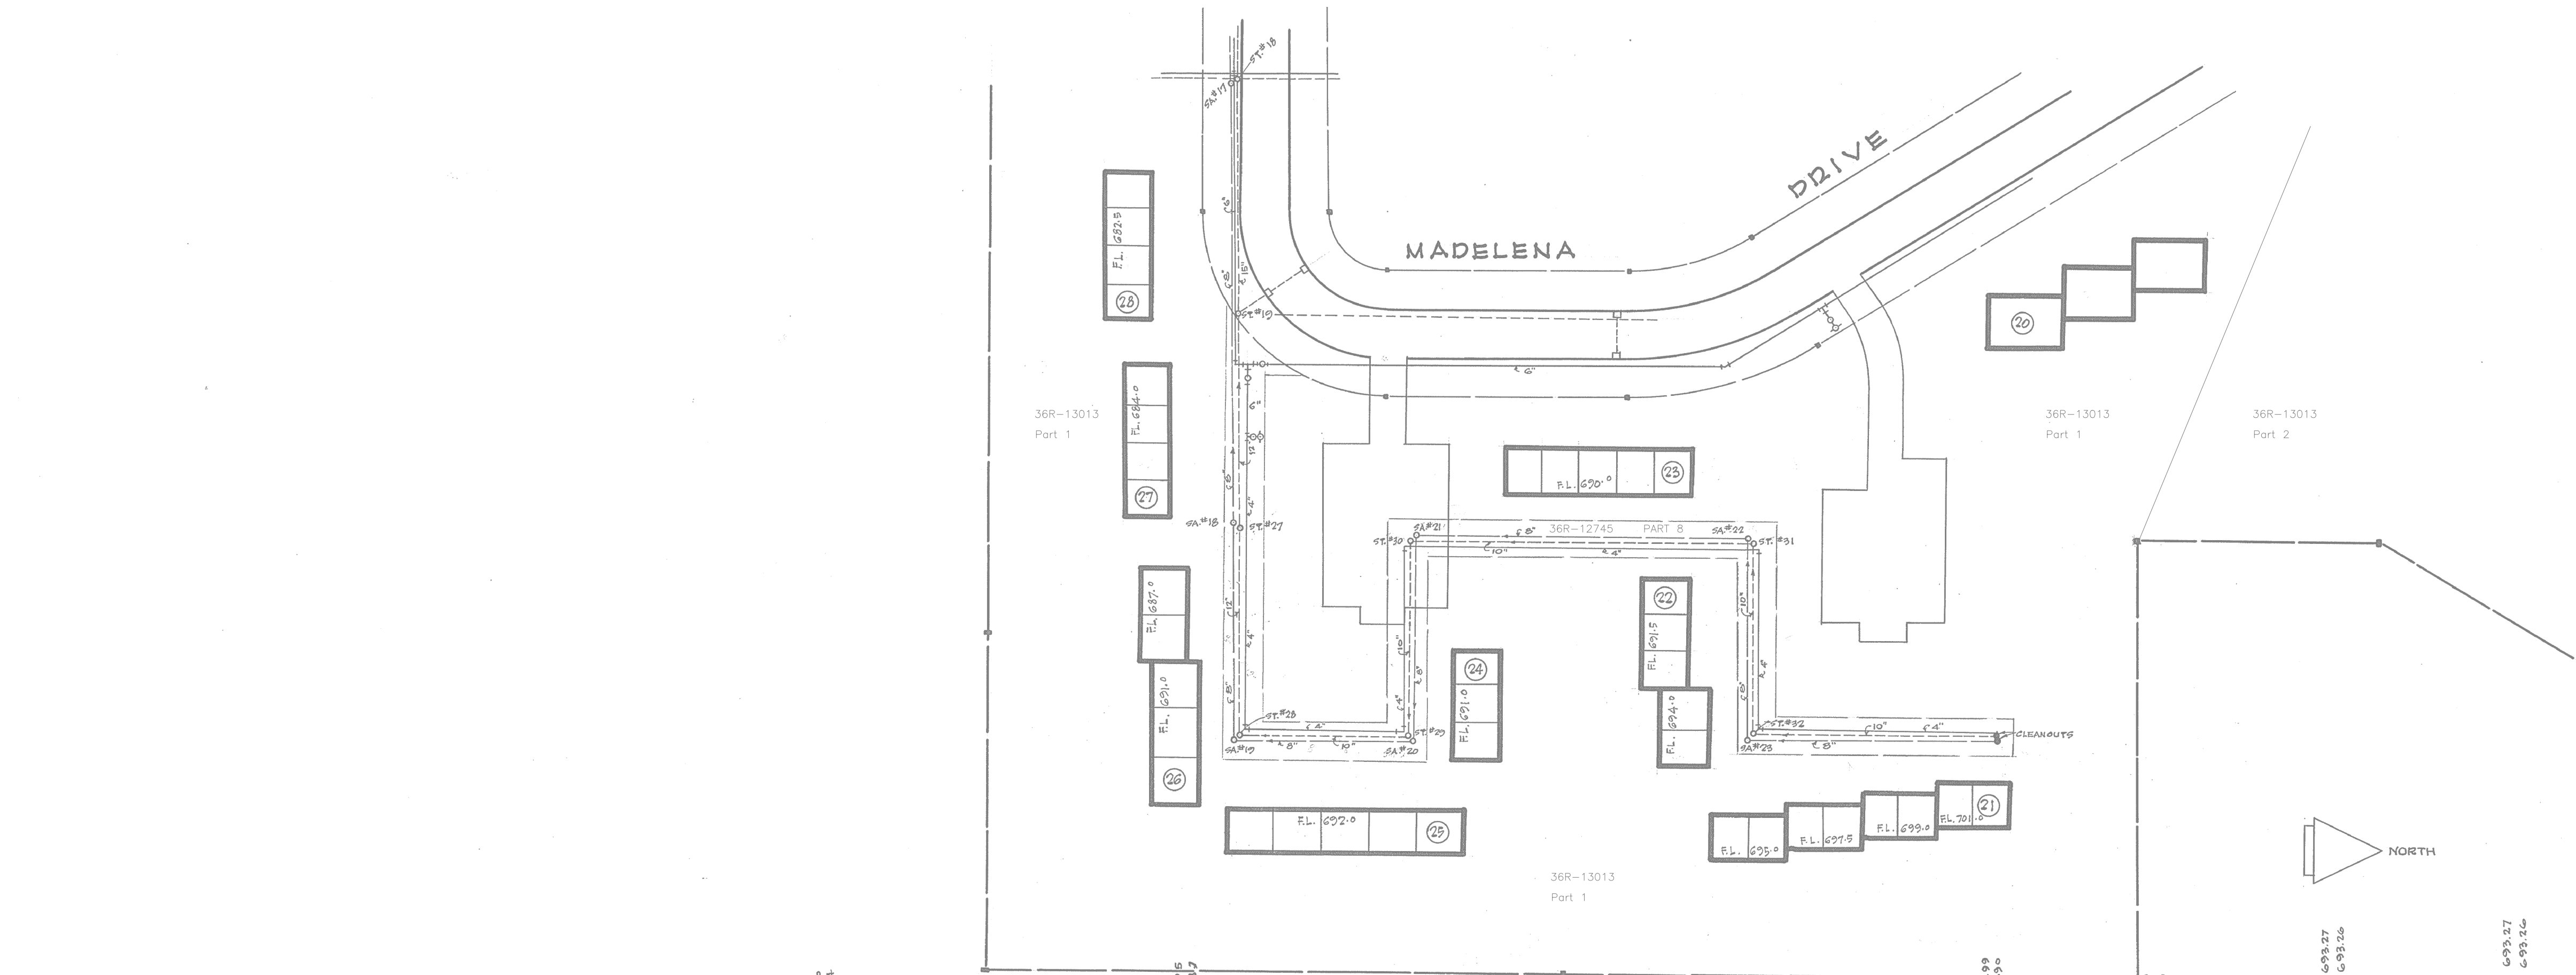

CENTRAL MORTGAGE & HOUSING CORPORATION	
URBAN MILITARY HOUSING PROJECT 1-60	
NORTH BAY • ONTARIO	
EASEMENT No. 20	
NORTHLAND ENGINEERING	
CONSULTING CIVIL ENGINEERS	
NORTH BAY • ONTARIO	
DATE	REVISION
Feb-11	36R-13013 Added
Sept-09	36R-12745 Added
MAY 14/04	AS CONSTRUCTED
W.K.	DRAWN BY: A. F. R.
BY	DESIGNED BY: H. D. M.
SCALE: 1/8" = 1' 0" H.T.	SCALE: 1/8" = 1' 0" V.T.
DWG. No. M-730	REV. A