
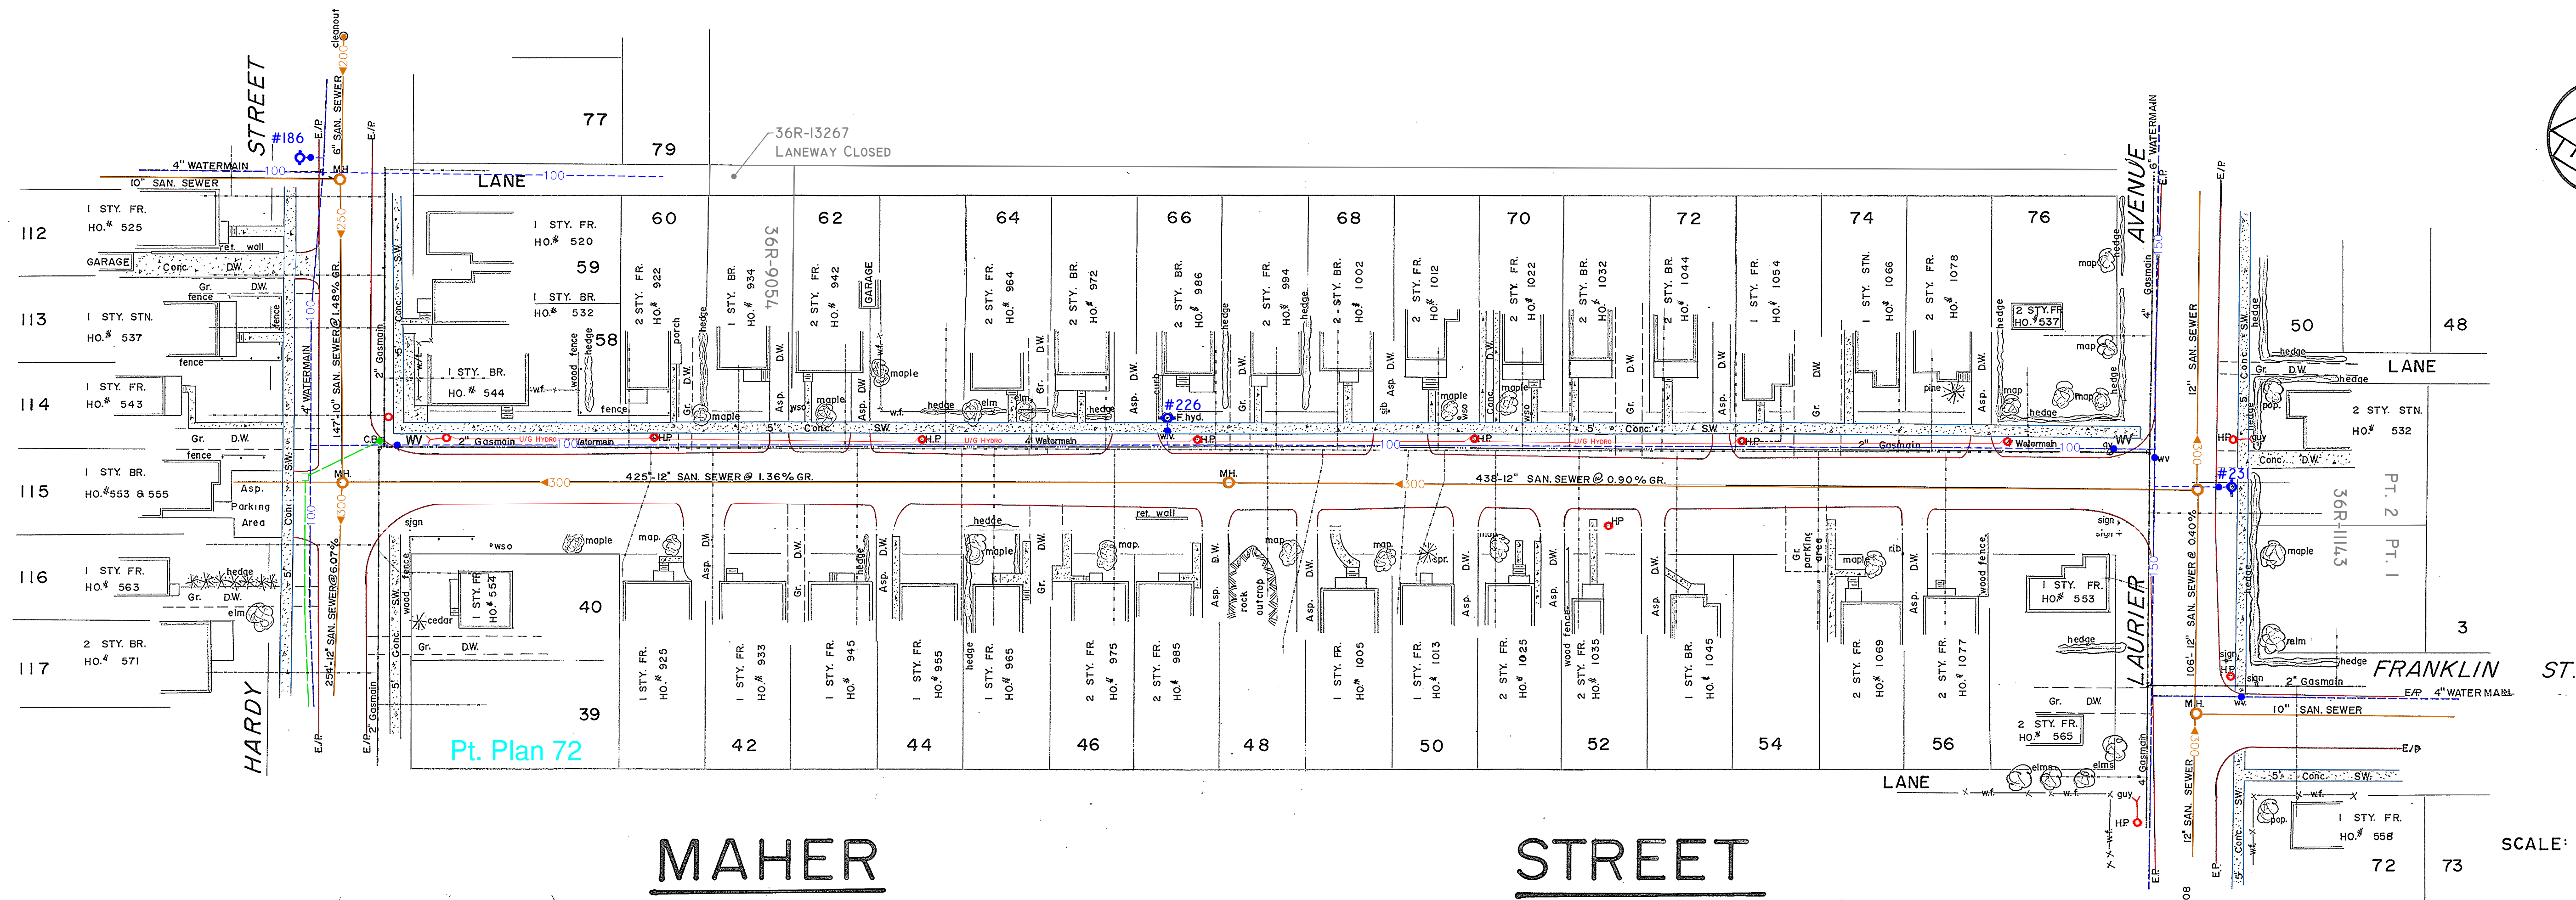


SCALE: 1 in. = 40 ft.

SCALE: hor. 1" = 40'
ver. 1" = 4'

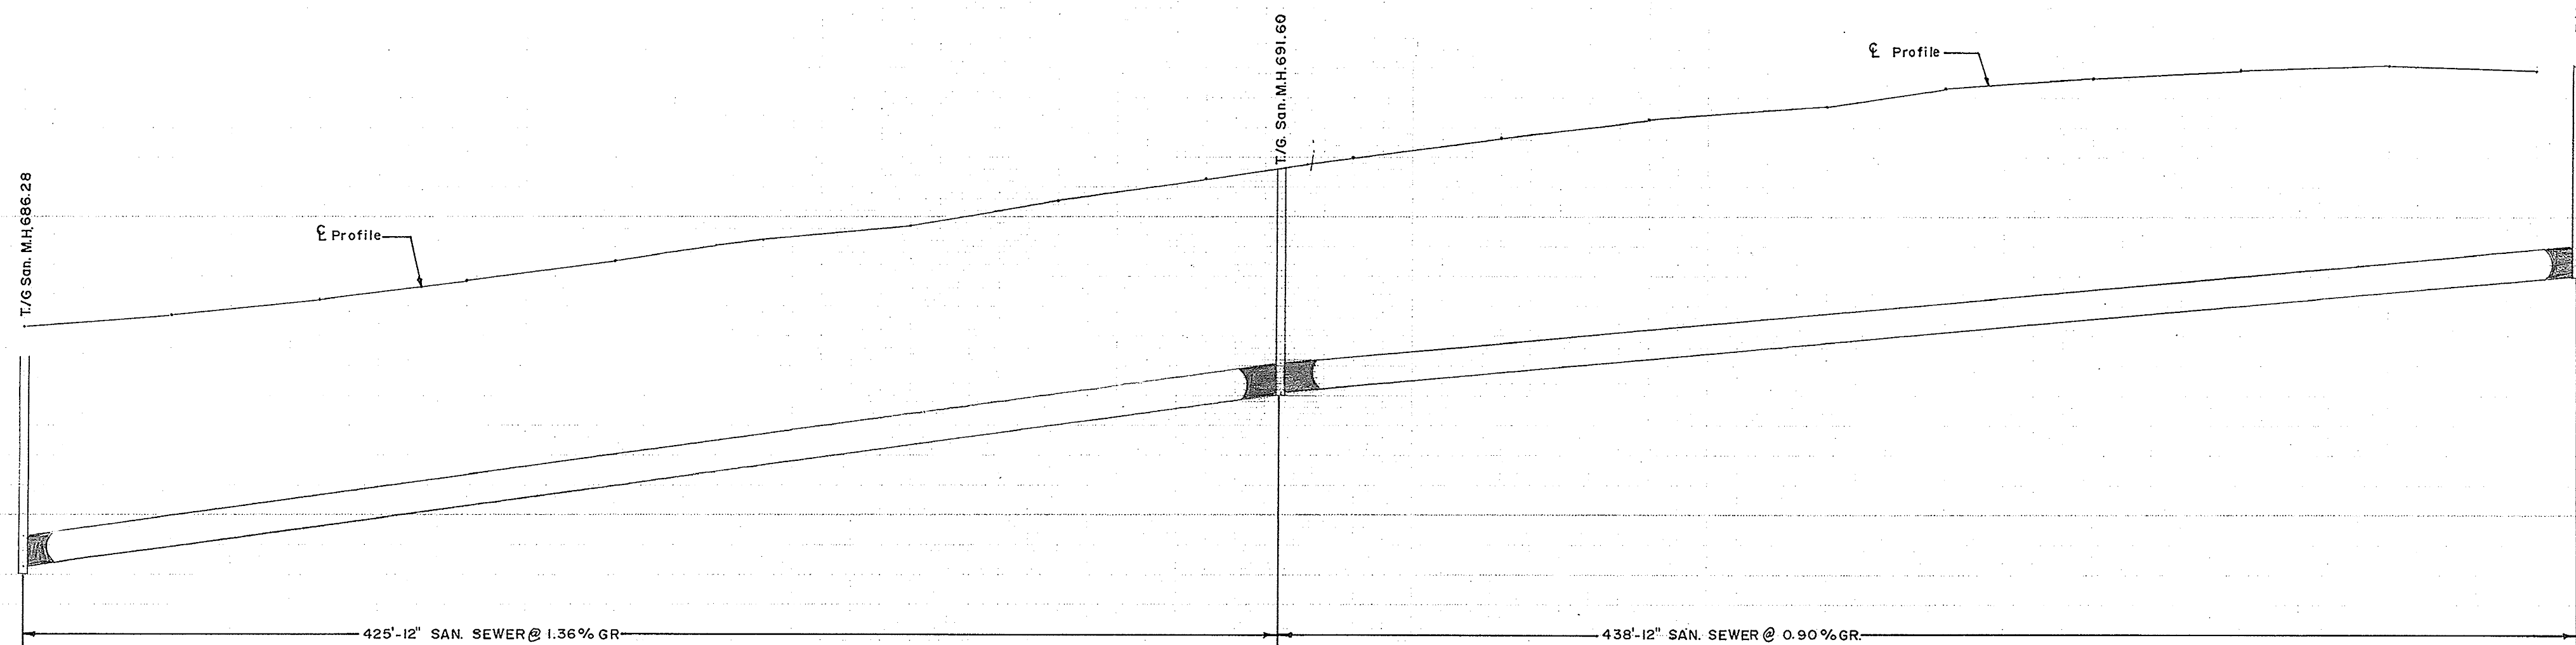

CHAINAGE	GROUND EL.	INVERT
0 + 00	686.28	N 678.27
0 + 50	686.69	
1 + 00	687.20	
1 + 50	687.80	
2 + 00	688.51	
2 + 50	689.10	
3 + 00	689.75	
3 + 50	690.58	
4 + 00	691.34	
4 + 25		S 684.95 N 684.95
4 + 50	692.08	
5 + 00	692.72	
5 + 50	693.21	
6 + 00	693.77	
6 + 50	693.21	
7 + 00	694.71	
7 + 50	694.94	
8 + 00	695.07	
8 + 50	694.81	
9 + 65		S 688.61 N 688.29 E 688.27

NOTES:

DISCLAIMER

The information contained on this drawing may be based upon data provided by others and may not have been verified by either as-constructed drawings or an Ontario Land Surveyor. The City of North Bay cannot accept responsibility for any errors or omissions on any information shown herein. Field verification, land surveys or excavation (with City approvals) may be required to determine actual location of any and all utilities or property lines.

1.	Add detail & services	9/6/74	G.W.R.
2.	REGISTERED PLANS ADDED.	NOV 08	R.J.O.
3.	INGROUND INFRASTRUCTURE (MC'S)	JAN 20	JJM
No.	REVISION	DATE	INITIAL

APPROVED

MAHER STREET
HARDY STREET TO LAURIER AVE.

REG.D. PLAN N° 72

CITY OF NORTH BAY
ENGINEERING DEPARTMENT

SCALE: AS SHOWN DATE: AUG. 17/70

DRAWN BY: J.D. FIELD BOOK No. **M-76**
CK'D. BY: 234

DWG: 140