
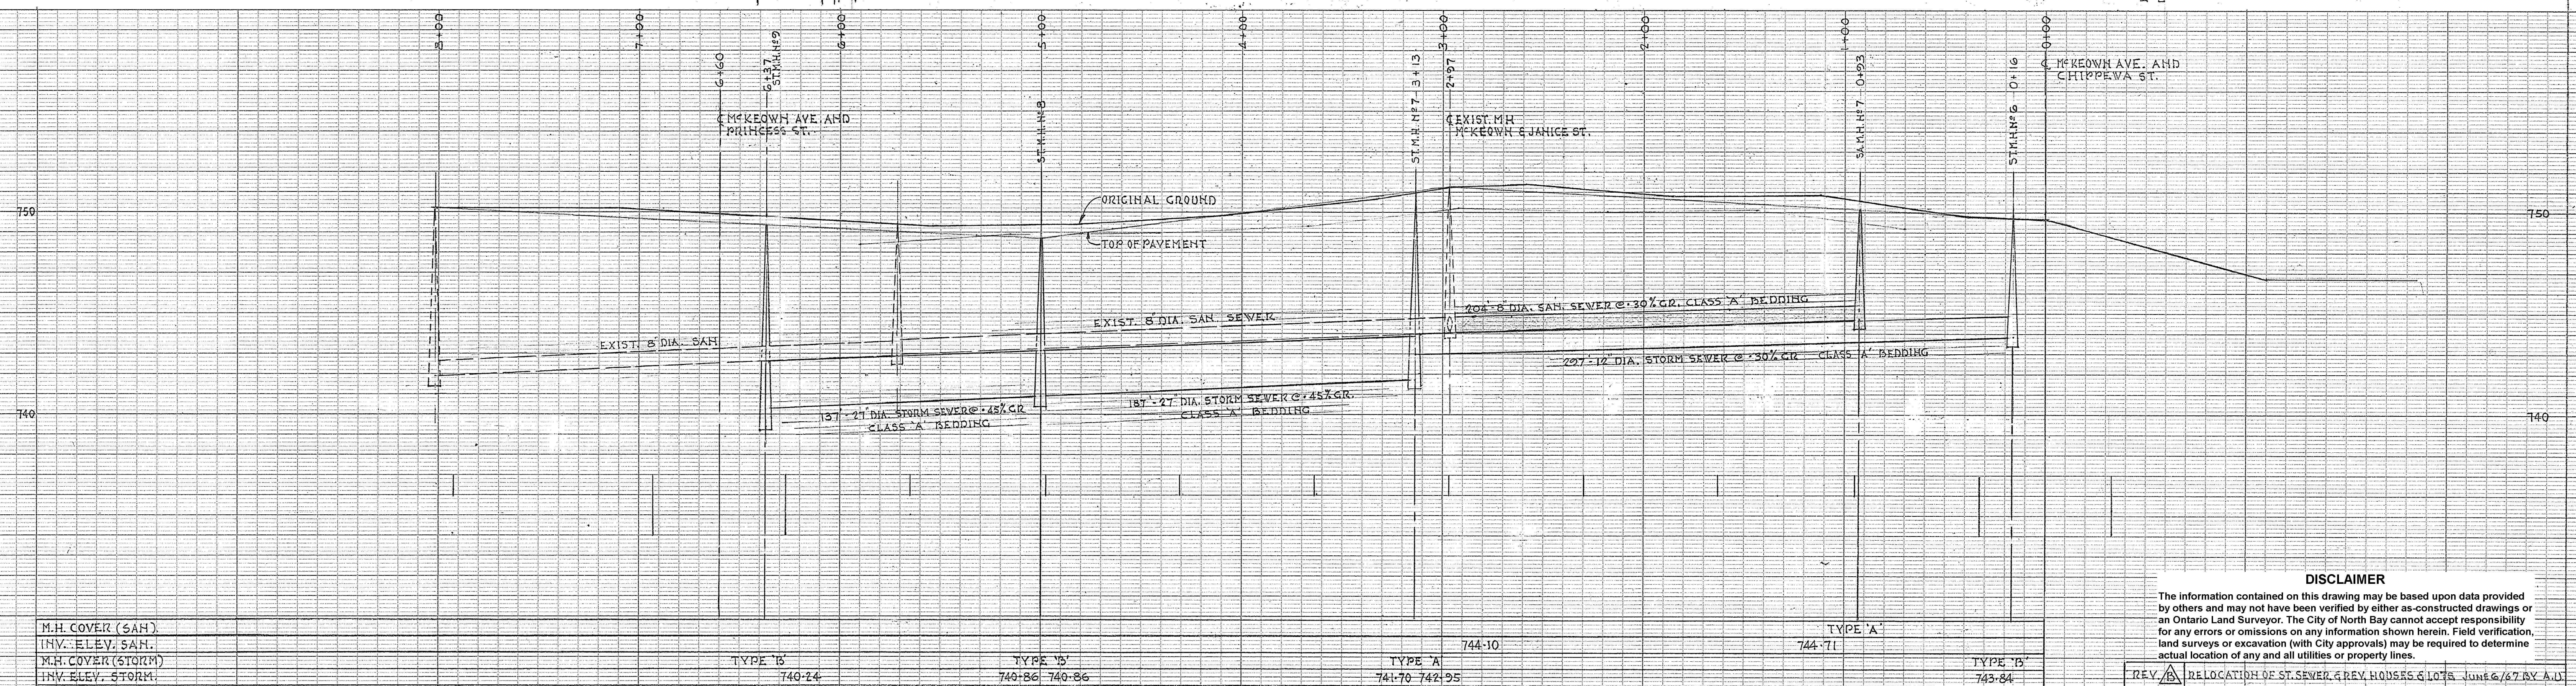


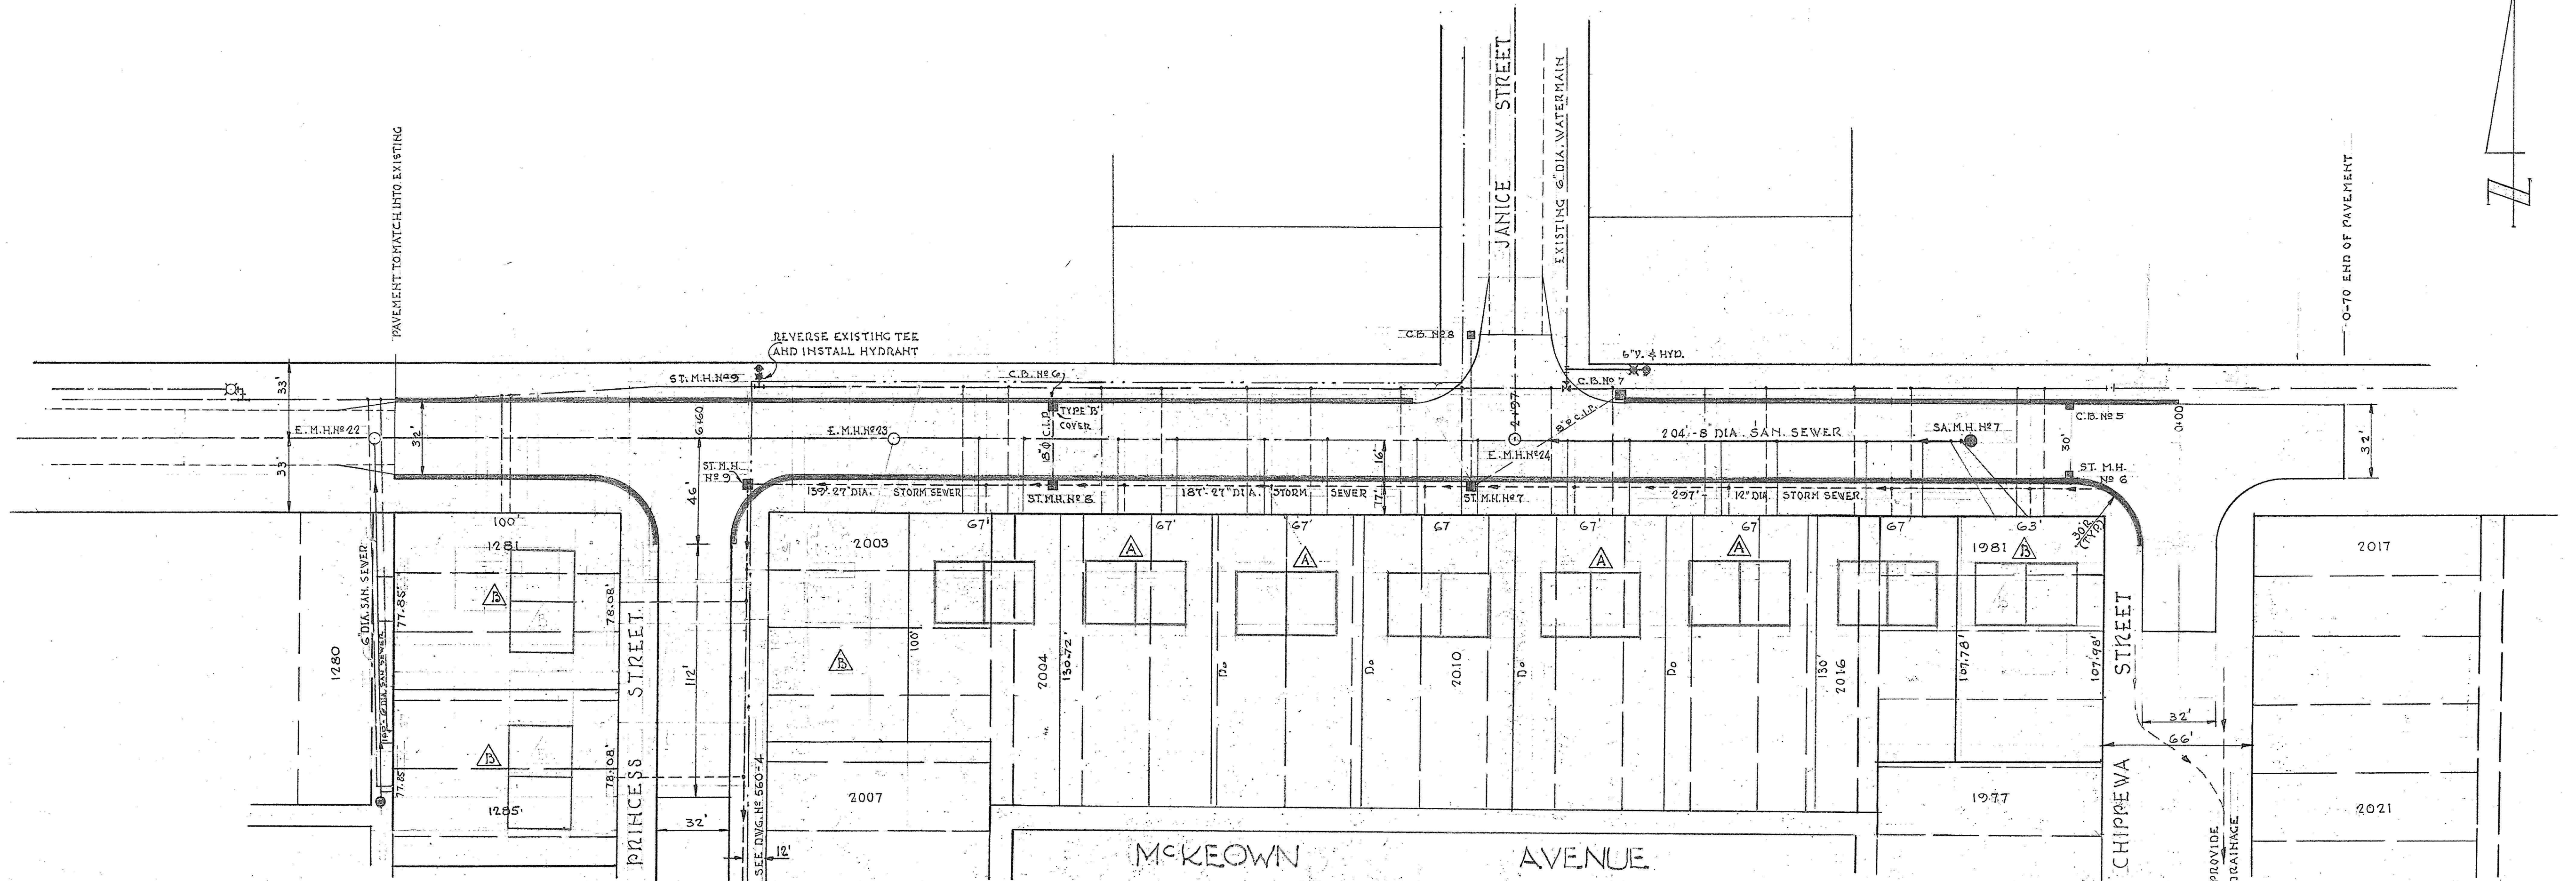

M.H. COVER (SAN.)
INV. ELEV. SAN.
M.H. COVER (STORM)
INV. ELEV. STORM

TYPE 'B'
740-24

TYPE 'B'
740-86 740-86

TYPE 'A'
744-10 742-95

TYPE 'A'
744-71

TYPE 'B'
743-84

DISCLAIMER

The information contained on this drawing may be based upon data provided by others and may not have been verified by either as-constructed drawings or an Ontario Land Surveyor. The City of North Bay cannot accept responsibility for any errors or omissions on any information shown herein. Field verification, land surveys or excavation (with City approvals) may be required to determine actual location of any and all utilities or property lines.

REV. A RELOCATION OF ST. SEWER & REV. HOUSES & LOTS JUNE 6/67 BY A.D.

REV. A REVISED SET-BACK OF HOUSES APRIL 14/1967 BY A.D.

SUB-DIVISION SERVICES
MCKEOWAN AVE. FROM PRINCESS ST. TO CHIPPEWA ST.

NORTHLAND ENGINEERING
CONSULTING CIVIL ENGINEERS
NORTH BAY • ONTARIO

APPROVALS -

DRAWN BY -

SCALE - HOR. - 1"=40'
VERT. - 1"=4'

CHECKED BY -

DATE - FEB. - 1967

Mc-2'A'