
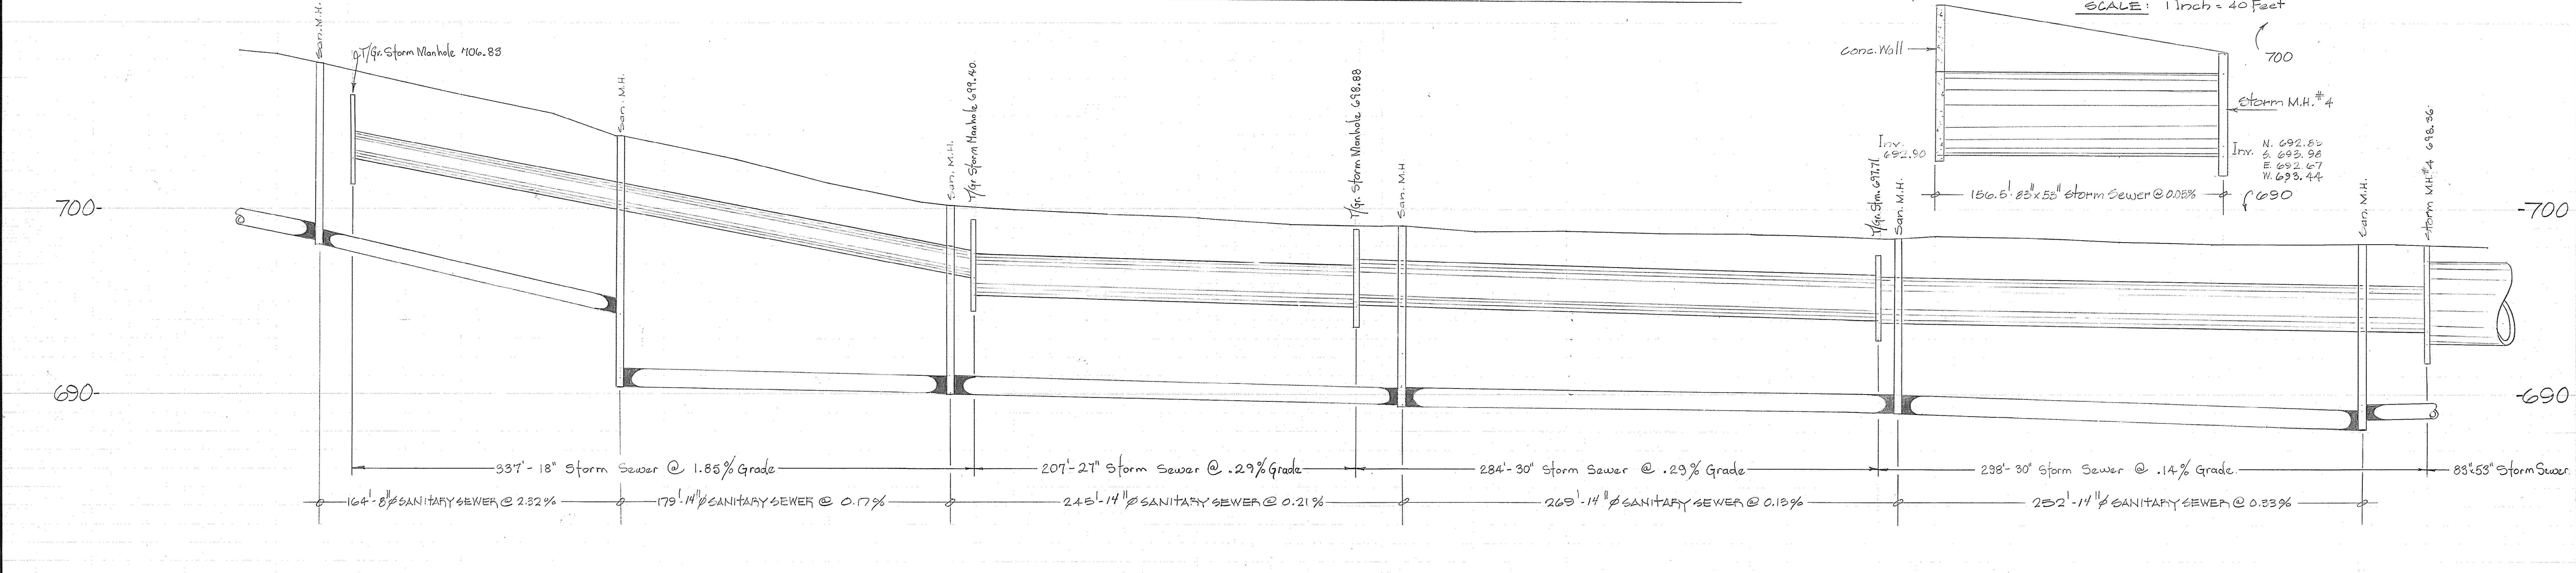


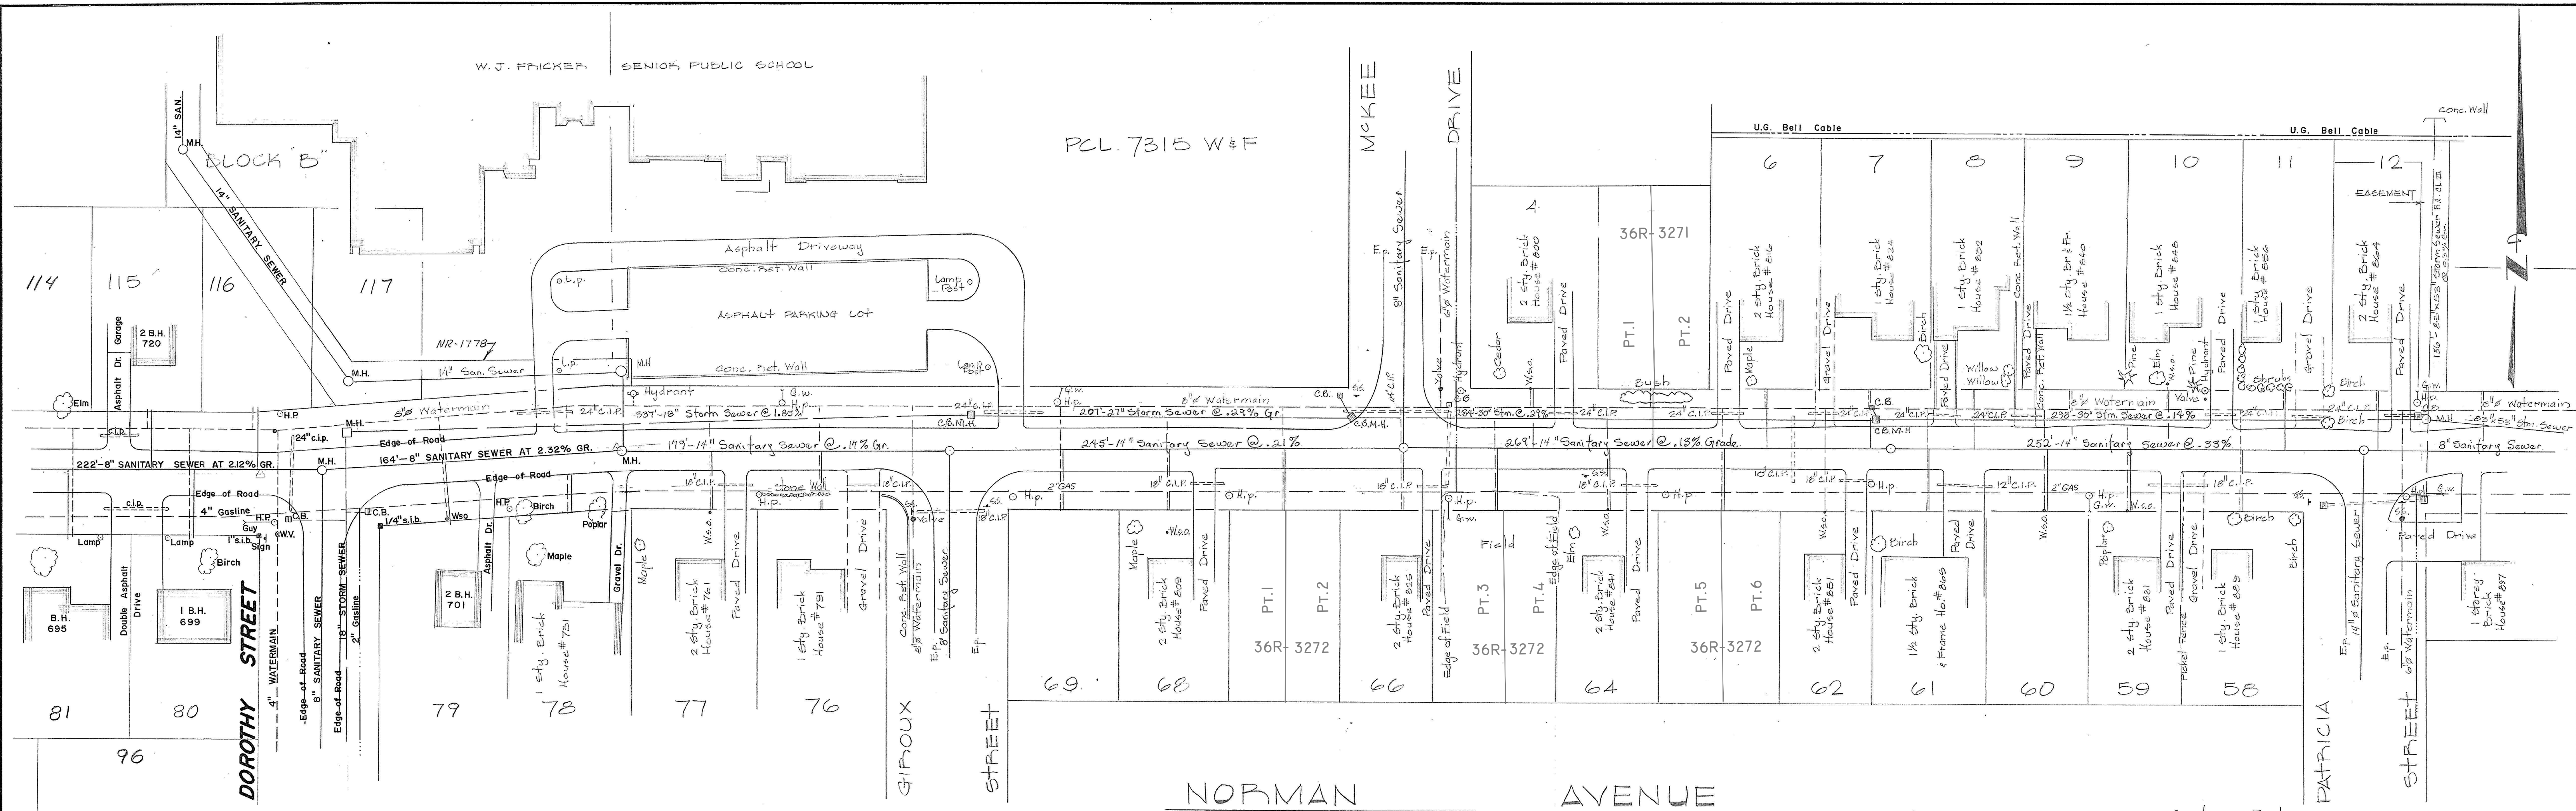

CHANCE	GROUND EL	INVERT
12+00	W. 698.50 E. 698.12	
11+77	S. 702.43 E. 702.13	
11+53		
11+00		
10+13	W. 694.32 E. 690.27 N. 690.64	
10+00		
9+00		
8+54	W. 690.04 E. 688.02 N. 688.38 S. 688.38 E. 688.38	
8+22		
8+00		
7+00		
6+15	E. 694.95 W. 694.95 S. 694.95 N. 694.95	
6+00	W. 695.44 E. 695.44 N. 695.23	
5+89		
5+00		
4+00	E. 695.88 W. 695.88 S. 695.88 N. 695.88	
3+31		
3+20		
3+00		
2+00		
1+00		
0+60	W. 698.14 E. 698.14 N. 698.15	
0+33	W. 695.44 E. 695.44 S. 695.44 N. 695.44	
0+00		

NOTES:

DISCLAIMER

The information contained on this drawing may be based upon data provided by others and may not have been verified by either as-constructed drawings or an Ontario Land Surveyor. The City of North Bay cannot accept responsibility for any errors or omissions on any information shown herein. Field verification, land surveys or excavation (with City approvals) may be required to determine actual location of any and all utilities or property lines.

1	As Const. STORM SEWER.	Aug/12	RFB	APPROVED
2	U.G. Bell Cable.	JULY/82	A.P.	
3	Revise Dorothy St. Intersection	Apr. 84	J.S.	
4	REGISTERED PLANS ADDED	DEC 08	R.J.O.	
No.	REVISION	DATE	INITIAL	

NORMAN AVE.
DOROTHY STREET TO PATRICIA AVE.
REQ'D. PLAN N^o. M-360
LOT 17, CON. "C"

CITY OF NORTH BAY
ENGINEERING DEPARTMENT

SCALE: AS SHOWN DATE: JUNE/11

DRAWN BY: DR FIELD BOOK No. #211 DRAWING No. N-152 REV.