


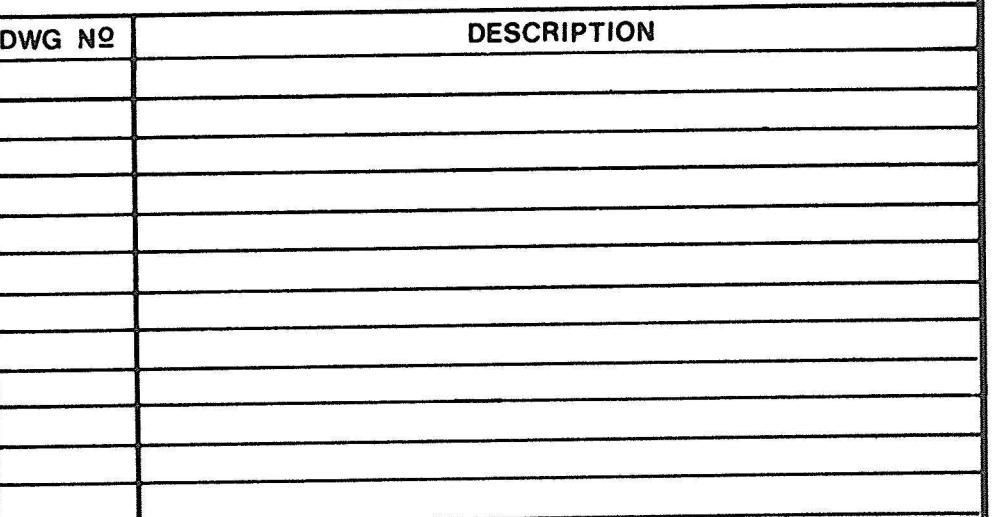

DISCLAIMER

The information contained on this drawing may be based upon data provided by others and may not have been verified by either as-constructed drawings or an Ontario Land Surveyor. The City of North Bay cannot accept responsibility for any errors or omissions on any information shown herein. Field verification, land surveys or excavation (with City approvals) may be required to determine actual location of any and all utilities or property lines.

HYDRO PLANT APPROVED	BELL PLANT APPROVED
<u>A. Hunt</u> 88-05-01	<u>J. P. Brown</u> 88-05-01
North Bay Hydro. : Date	Bell Canada Ltd. Date

RAB	AS CONSTRUCTED	APR. 91	2
SKP	REVISED & ROAD PROFILE GRADE,		
	CULVERT, DITCH PROFILE GRADE	AUG. 90	1
APP'D BY	DETAILS	DATE	Nº

REVISIONS	
-----------	--

RECOMMENDED BY	APPROVED BY

NORTHSHORE ROAD
Sta. 11+900 to Sta. 12+200

**northland
engineering
limited**

Consulting Engineers and Planners
NORTH BAY SUDBURY TIMMINS

DRAWN BY: R.E.A.	DATE: APRIL, 1987
------------------	-------------------

CHECKED BY: S. K. P.	SCALE: HORIZ. 1:500
FIELD BOOK:	VERT. 1:100

OFFICE NORTH BAY	PROJECT NO 2917	DRAWING NO N-258	REV. 2
---------------------	--------------------	---------------------	-----------

