



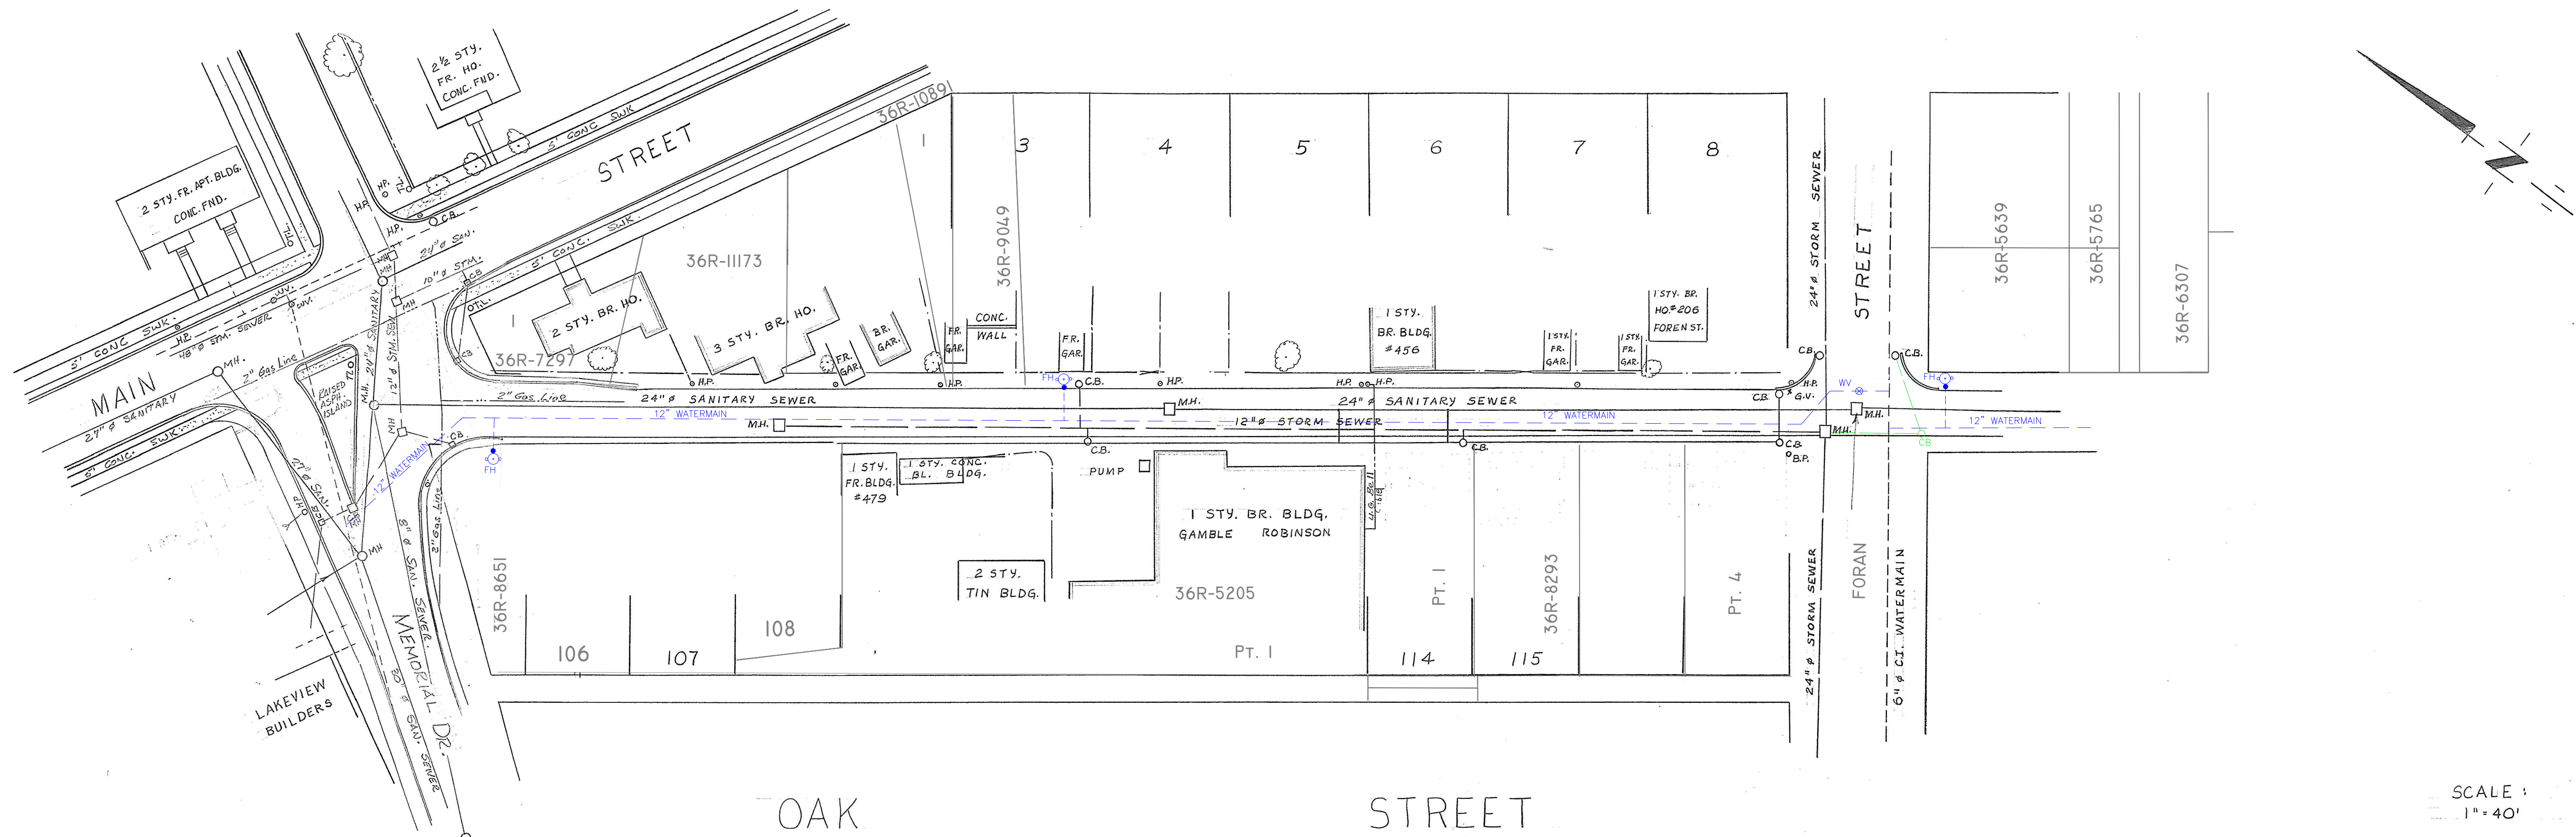

SCALE :
1" = 40'

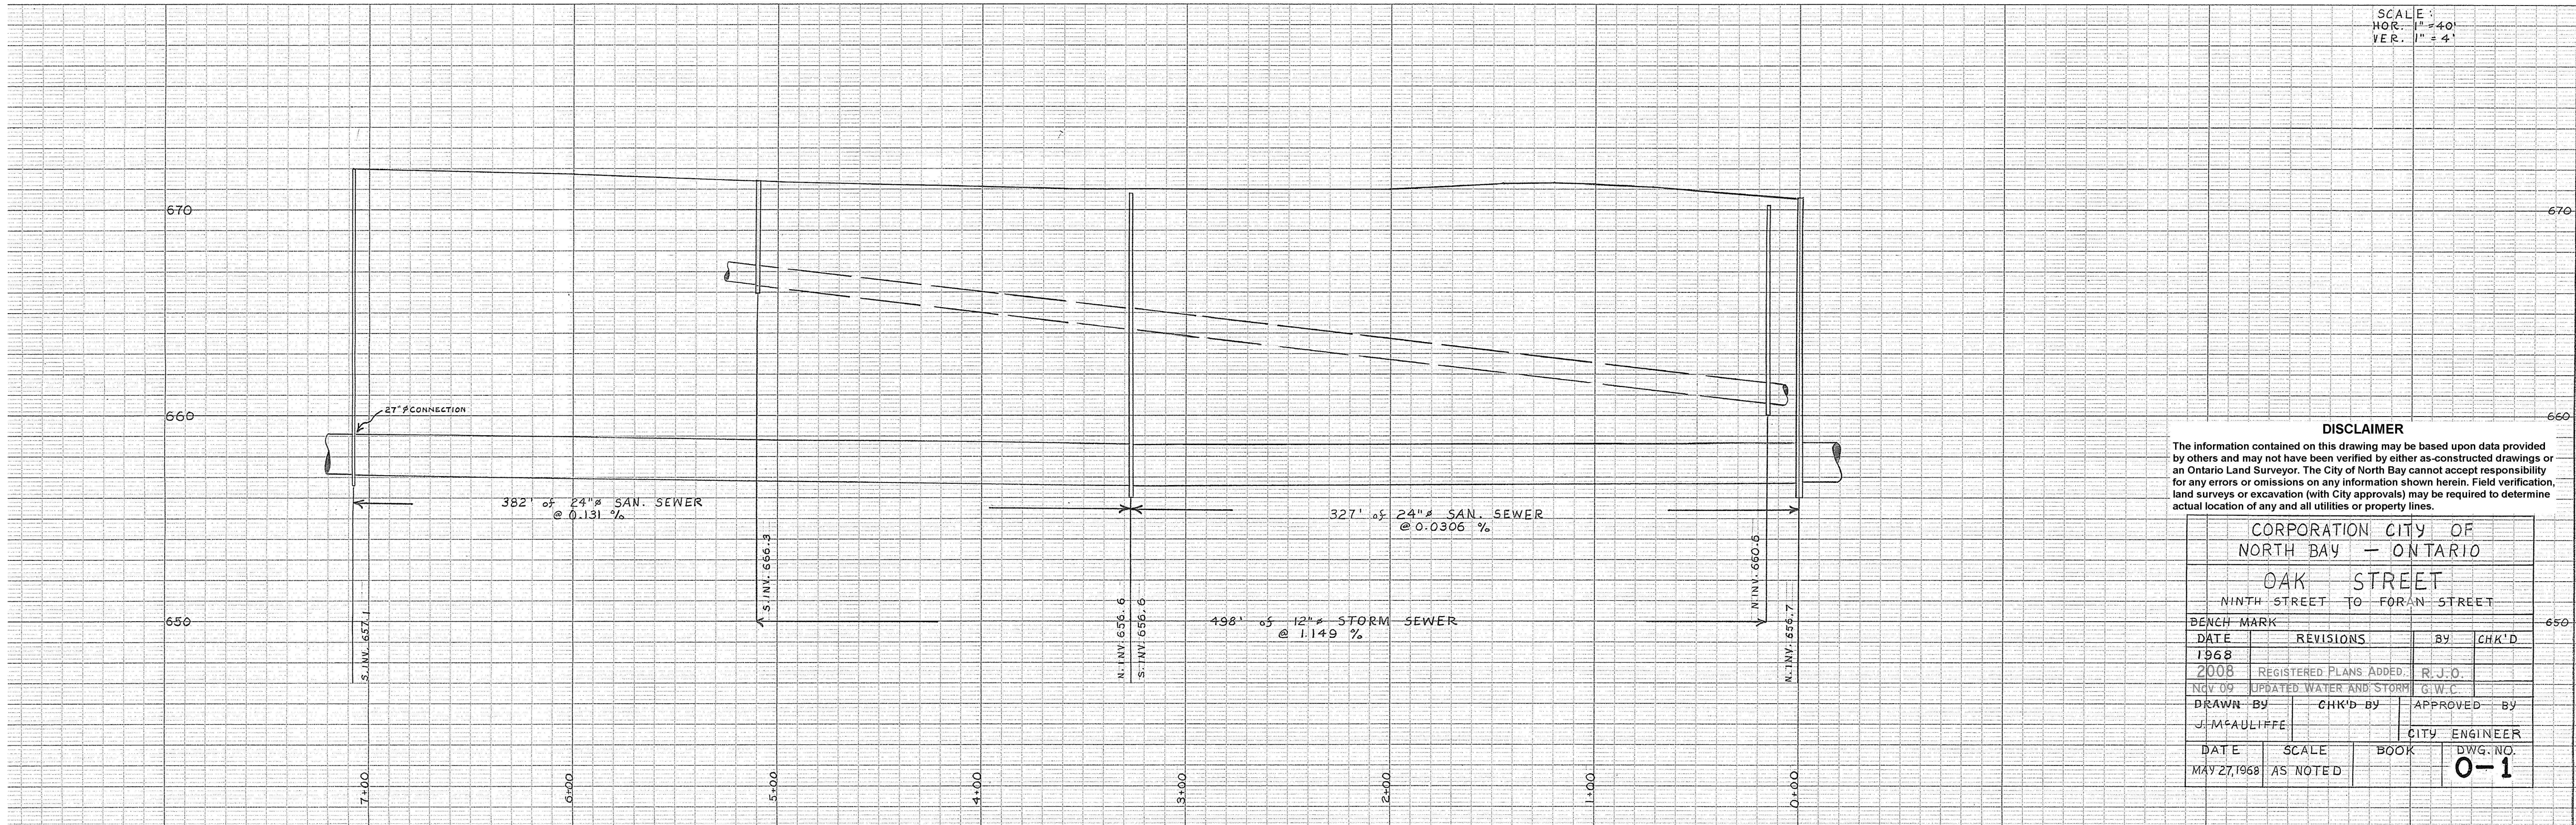

SCALE :
HOR. 1" = 40'
VER. 1" = 4'

DISCLAIMER			
The information contained on this drawing may be based upon data provided by others and may not have been verified by either as-constructed drawings or an Ontario Land Surveyor. The City of North Bay cannot accept responsibility for any errors or omissions on any information shown herein. Field verification, land surveys or excavation (with City approvals) may be required to determine actual location of any and all utilities or property lines.			
CORPORATION CITY OF NORTH BAY - ONTARIO			
OAK STREET			
NINTH STREET TO FORAN STREET			
BENCH MARK			
DATE	REVISIONS	BY	CHK'D
1968			
2008	REGISTERED PLANS ADDED	R.J.O.	
NOV 09	UPDATED WATER AND STORM	G.W.C.	
DRAWN BY	CHK'D BY	APPROVED BY	
J. MAULIFFE		CITY ENGINEER	
DATE	SCALE	BOOK	DWG. NO.
MAY 27, 1968	AS NOTED		0-1