
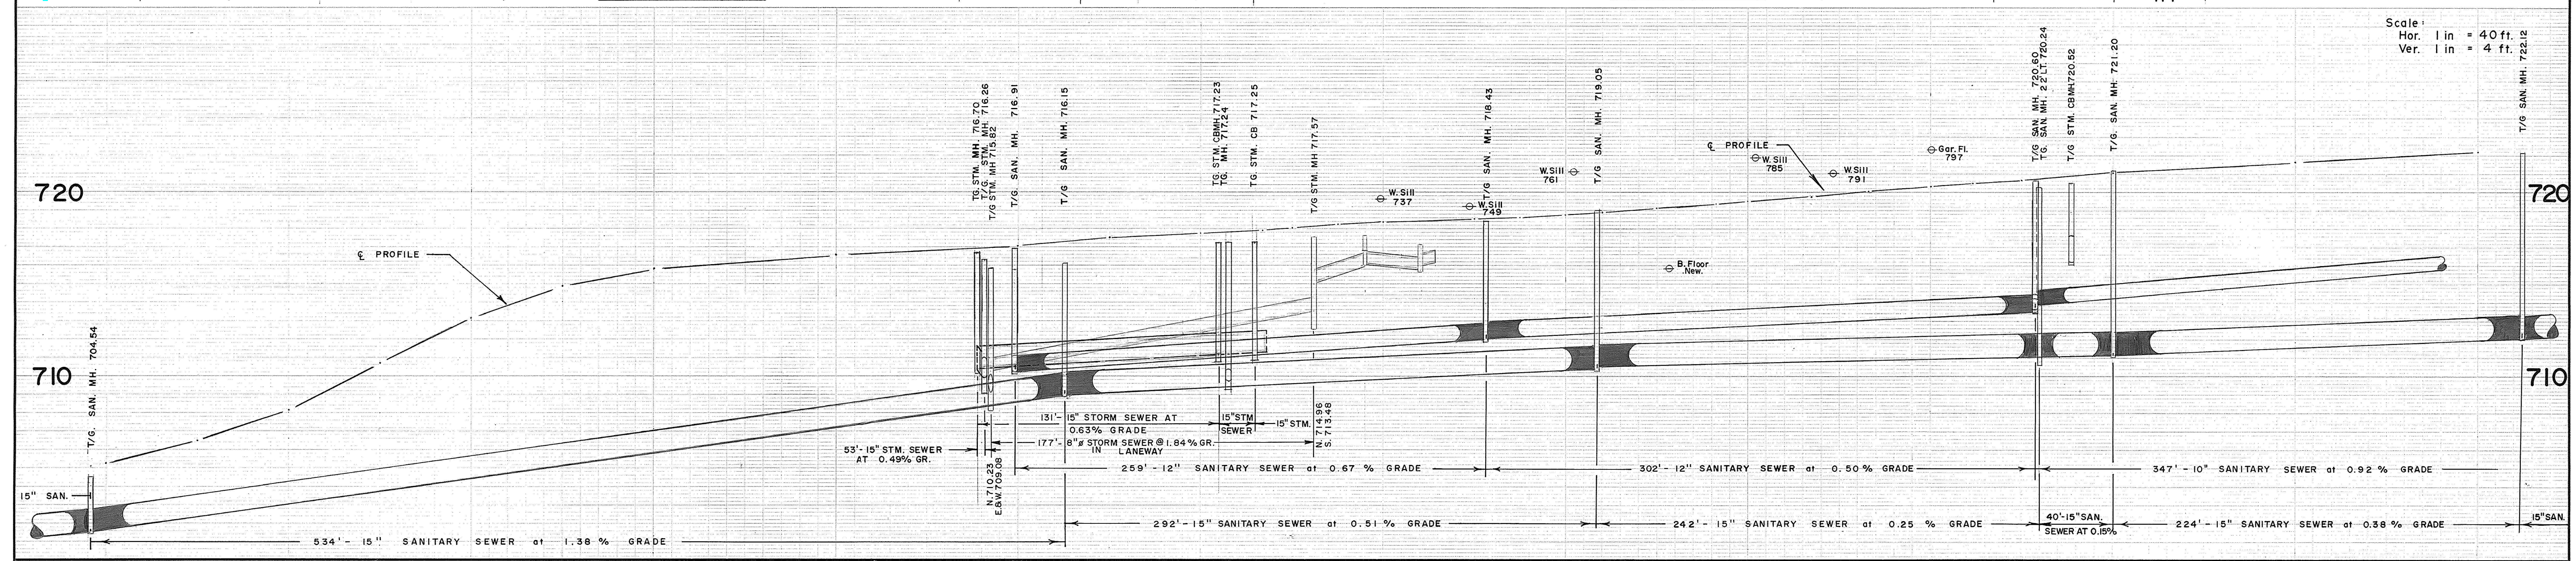


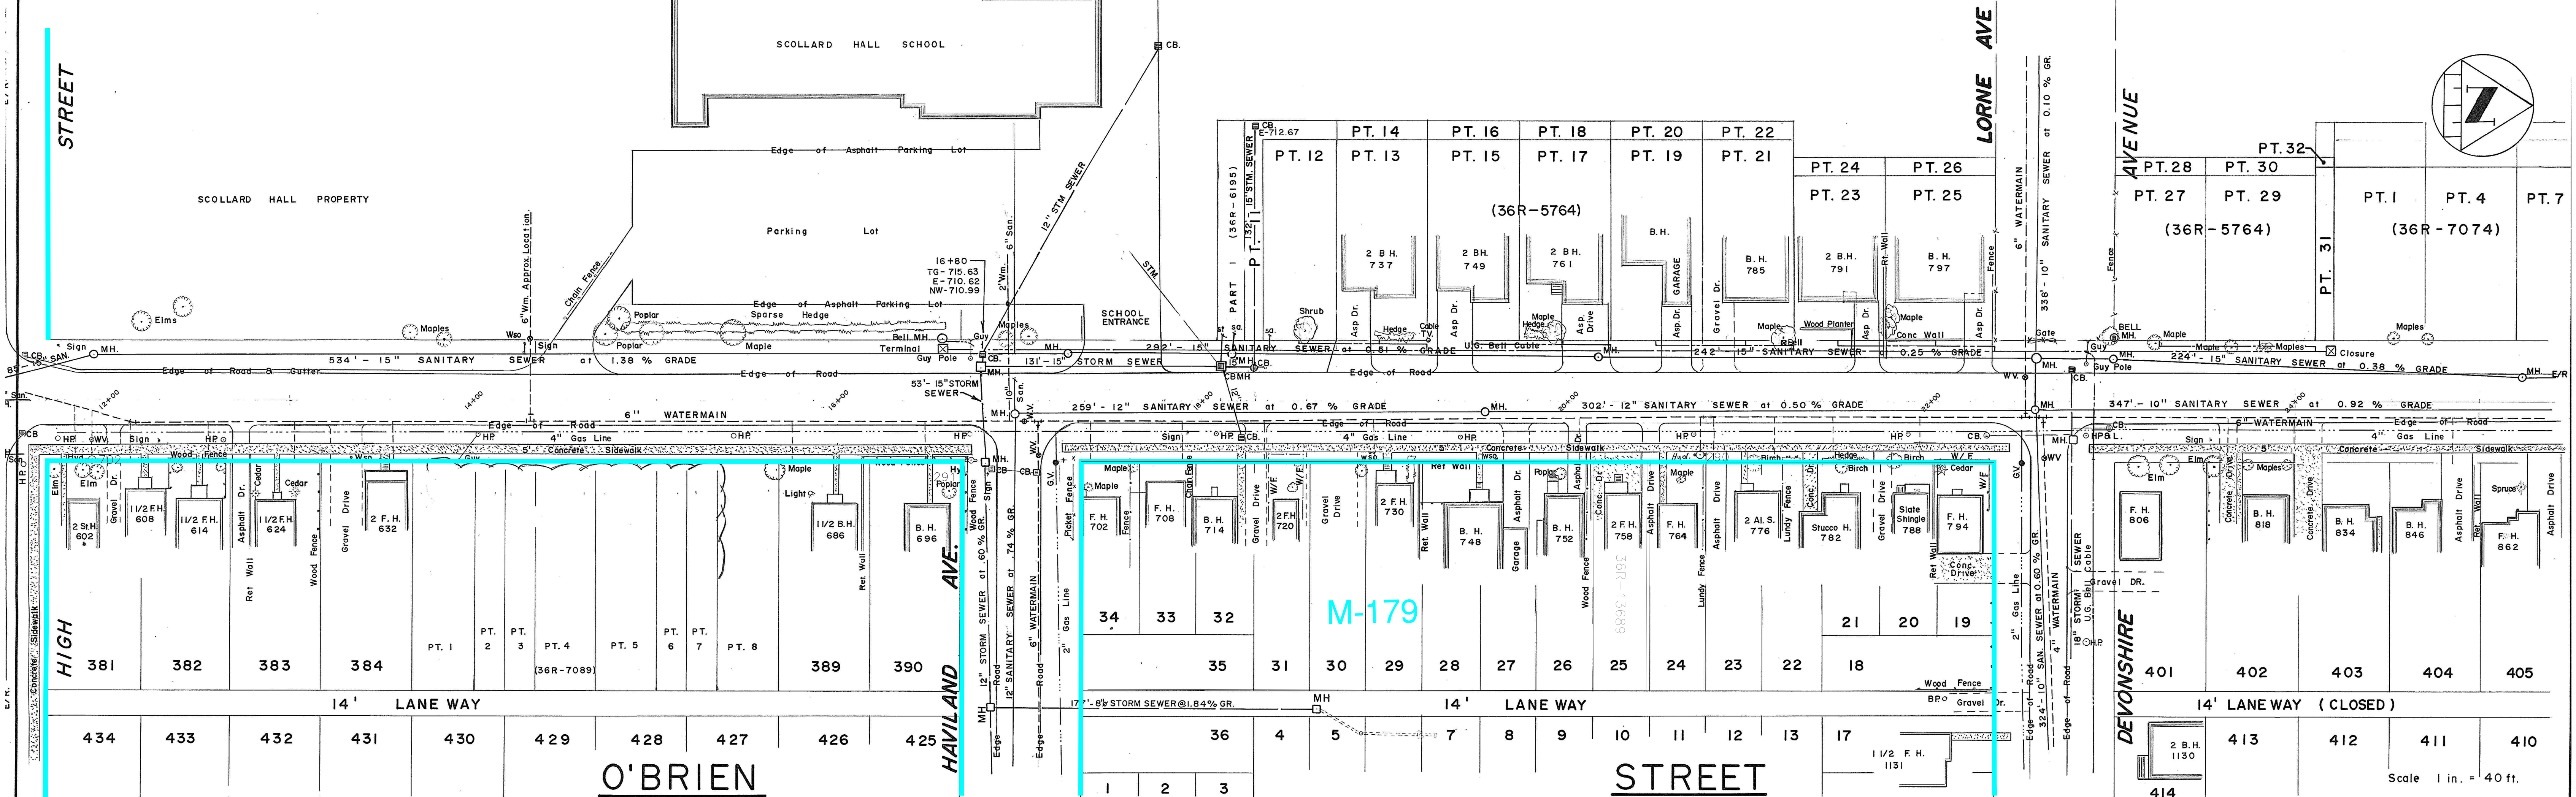

CHANCE	GROUND EL	INVERT
11 + 92	705.24	S-704.44 N-704.45
12 + 50	706.50	
13 + 00	708.13	
13 + 50	710.70	
14 + 00	713.18	
14 + 50	714.93	
15 + 00	715.80	
15 + 50		
16 + 00	716.59	
16 + 50		
16 + 79		S-710.37 W-710.70 E-710.02 N-710.02
16 + 82		S-710.52 W-710.85 E-710.02 N-710.02
16 + 97		S-710.52 W-710.85 E-710.02 N-710.02
17 + 00	717.04	S-710.52 W-710.85 E-710.02 N-710.02
17 + 26		S-708.83 N-708.89
17 + 50	717.54	
18 + 00	717.72	S-711.19 W-711.54 E-711.19 N-711.19
18 + 10	717.72	S-711.19 W-711.54 E-711.19 N-711.19
18 + 16	717.72	S-711.19 W-711.54 E-711.19 N-711.19
18 + 29	717.93	S-711.19 W-711.54 E-711.19 N-711.19
18 + 35	717.93	S-711.19 W-711.54 E-711.19 N-711.19
18 + 50	718.02	
18 + 75	718.23	
19 + 00	718.37	
19 + 50	718.57	S-711.89 N-712.02
19 + 56	718.57	S-711.89 N-712.02
19 + 75	718.62	
20 + 00	718.75	
20 + 18	718.88	S-710.38 N-710.44
20 + 20	718.88	S-710.38 N-710.44
20 + 50	719.14	
20 + 83	719.39	
21 + 00	719.51	
21 + 35	719.77	
21 + 50	720.05	
21 + 67	720.05	
22 + 00	720.29	
22 + 23	720.51	
22 + 50	720.68	S-713.57 W-713.63 E-713.57 N-713.57
22 + 58	720.68	S-713.57 W-713.63 E-713.57 N-713.57
22 + 60	720.68	S-713.57 W-713.63 E-713.57 N-713.57
22 + 77	720.77	S-713.57 W-713.63 E-713.57 N-713.57
23 + 00	721.19	S-711.19 N-711.19
23 + 50		
24 + 00	721.62	
24 + 50		
25 + 00	722.16	
25 + 24		S-712.00 N-712.00

NOTES:

DISCLAIMER

The information contained on this drawing may be based upon data provided by others and may not have been verified by either as-constructed drawings or an Ontario Land Surveyor. The City of North Bay cannot accept responsibility for any errors or omissions on any information shown herein. Field verification, land surveys or excavation (with City approvals) may be required to determine actual location of any and all utilities or property lines.

1.	NEW DRAWING	JAN. 78	j.d.m.
2.	ADDED STORM MANHOLE AT LORNE	MAY 80	j.d.m.
3.	UP DATE DETAIL HAVILAND-DEVONSHIRE	JUL. 89	Rick B.
4.	AS CONST'D. STM. HAVILAND North	FEB. 90	Rick B.
No.	REVISION	DATE	INITIAL

O'BRIEN STREET

HIGH STREET to LORNE AVENUE

REG'D. PLAN N^o

M - 28, M-175, M-179.

CITY OF NORTH BAY

ENGINEERING DEPARTMENT

SCALE: AS SHOWN

DATE: JAN. 1978

DRAWN BY: j.d.m.

CKD. BY:

FIELD BOOK No. 250

DRAWING No. **0-102**

REV.