
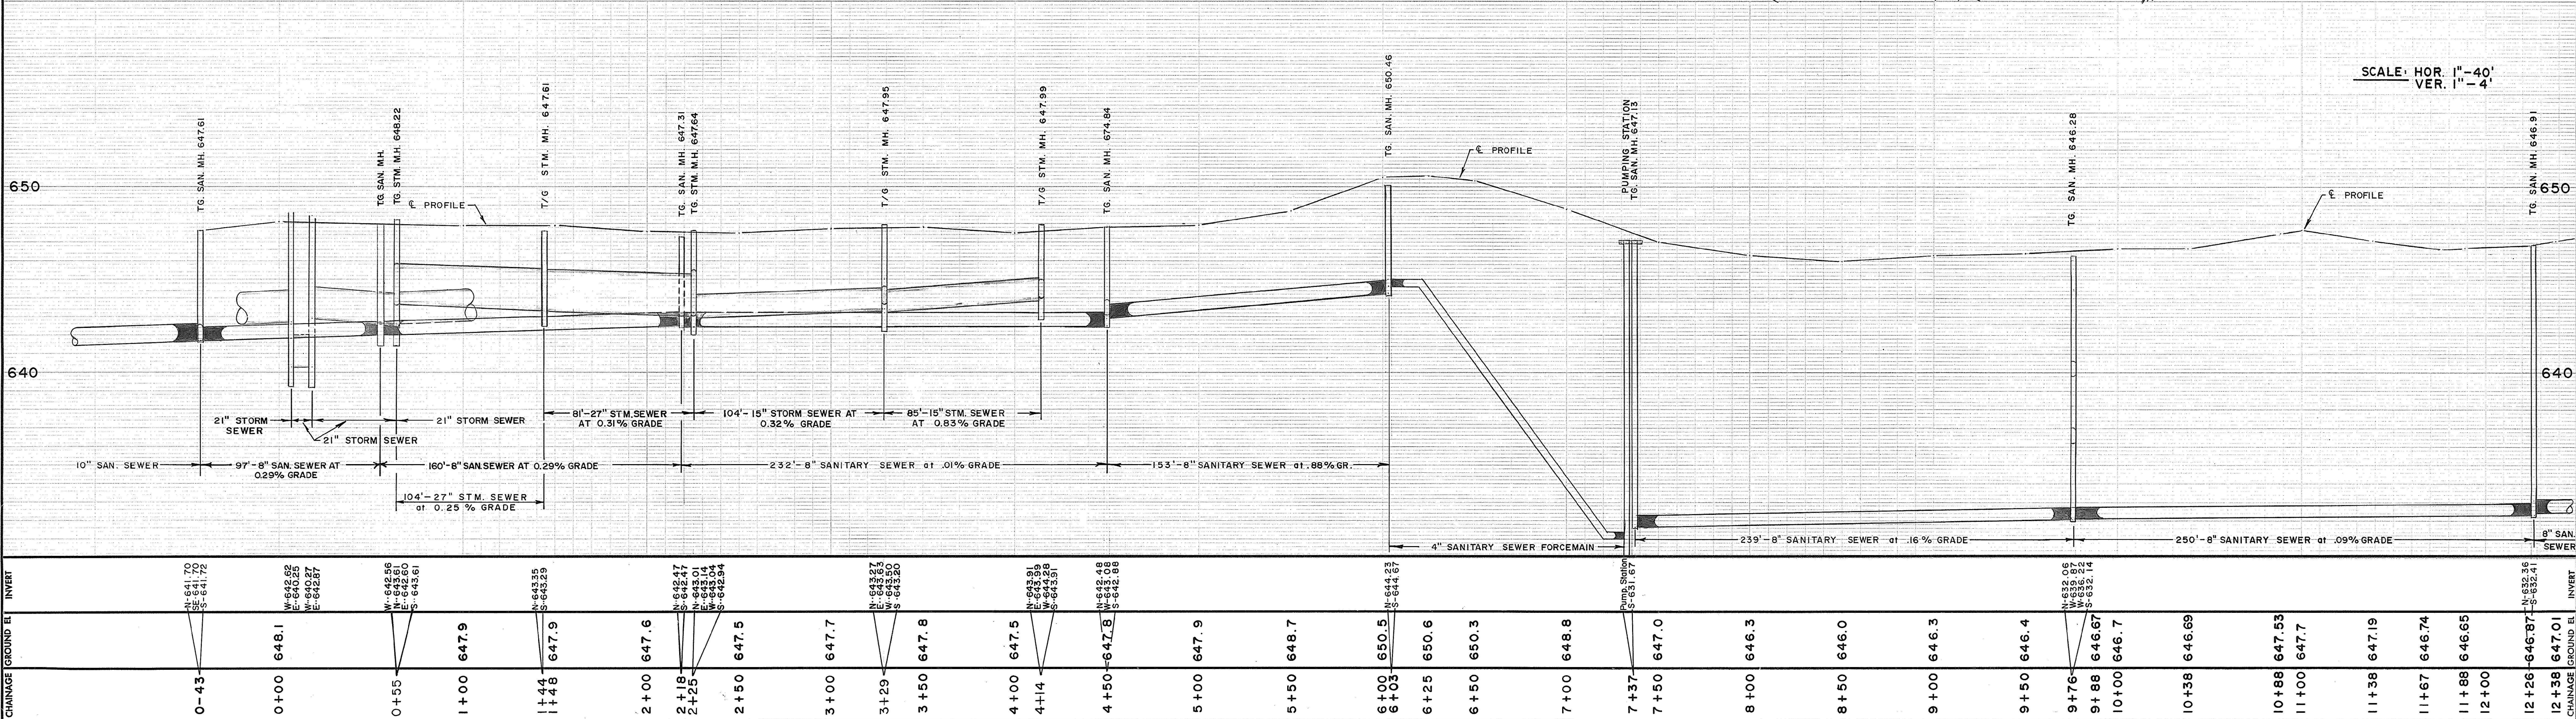


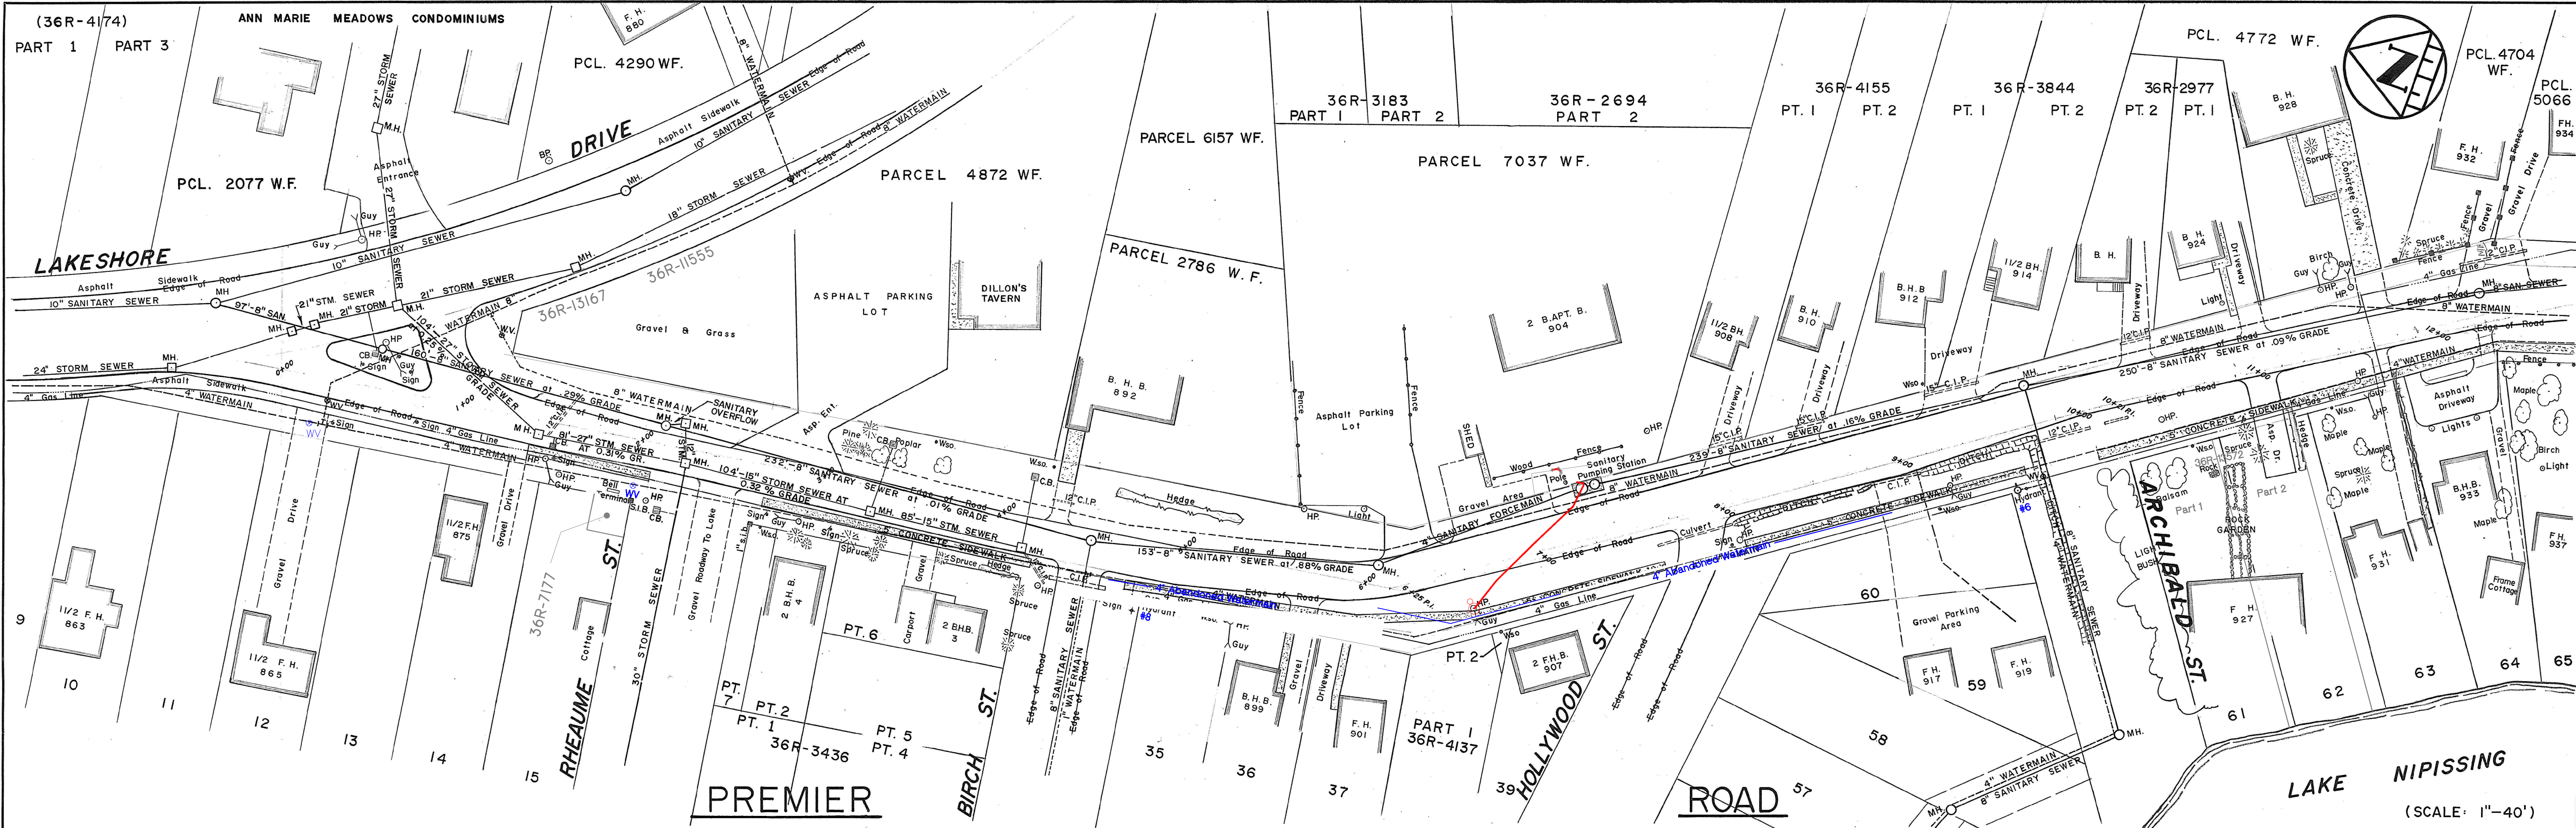

NOTES:	 DISCLAIMER The information contained on this drawing may be based upon data provided by others and may not have been verified by either as-constructed drawings or an Ontario Land Surveyor. The City of North Bay cannot accept responsibility for any errors or omissions on any information shown herein. Field verification, land surveys or excavation (with City approvals) may be required to determine actual location of any and all utilities or property lines.	6.	EXISTING U/G HYDRO LOCATION APPROX.	SEPT 20	R.J.O.	1.	NEW DRAWING	(Book 289)	JUNE 77	R.F.B.	APPROVED	PREMIER ROAD				CITY OF NORTH BAY ENGINEERING DEPARTMENT				
		2.	As Const. Stm. Sewer, update detail – Birch St. to L.S.D.			2.	As Const. Stm. Sewer, update detail – Birch St. to L.S.D.	(Book 289)	MAY 84	A.P.		LAKESHORE DRIVE TO STATION 12+00								
		3.	As Const. Stm. Sewer, 1984 Bk. 273 L.S.D.			3.	As Const. Stm. Sewer, 1984 Bk. 273 L.S.D.		AUG. 84	A.P.		Reg'd. Plan N ^o . M-206								
		4.	WATERMAIN SECTION ABANDONED, NEW VALVES INSTALLED			4.	WATERMAIN SECTION ABANDONED, NEW VALVES INSTALLED		OCT 2006				SCALE: AS SHOWN DATE: JUNE 1977				DRAWN BY: Rick B CKD. BY:	FIELD BOOK No. 175, 191, 212, 247	DRAWING No. P- 251	REV.
		5.	WATERMAIN SECTION ABANDONED, NEW VALVES INSTALLED			5.	WATERMAIN SECTION ABANDONED, NEW VALVES INSTALLED		JAN 09	R.J.O.										
		6.	ADDED 36R-13019			6.	ADDED 36R-13019		FEB '11	G.W.C.										
		7.	ADDED 36R-13572			7.	ADDED 36R-13572		FEB '14	G.W.C.										
		No.	REVISION	DATE	INITIAL	No.	REVISION	DATE	INITIAL											