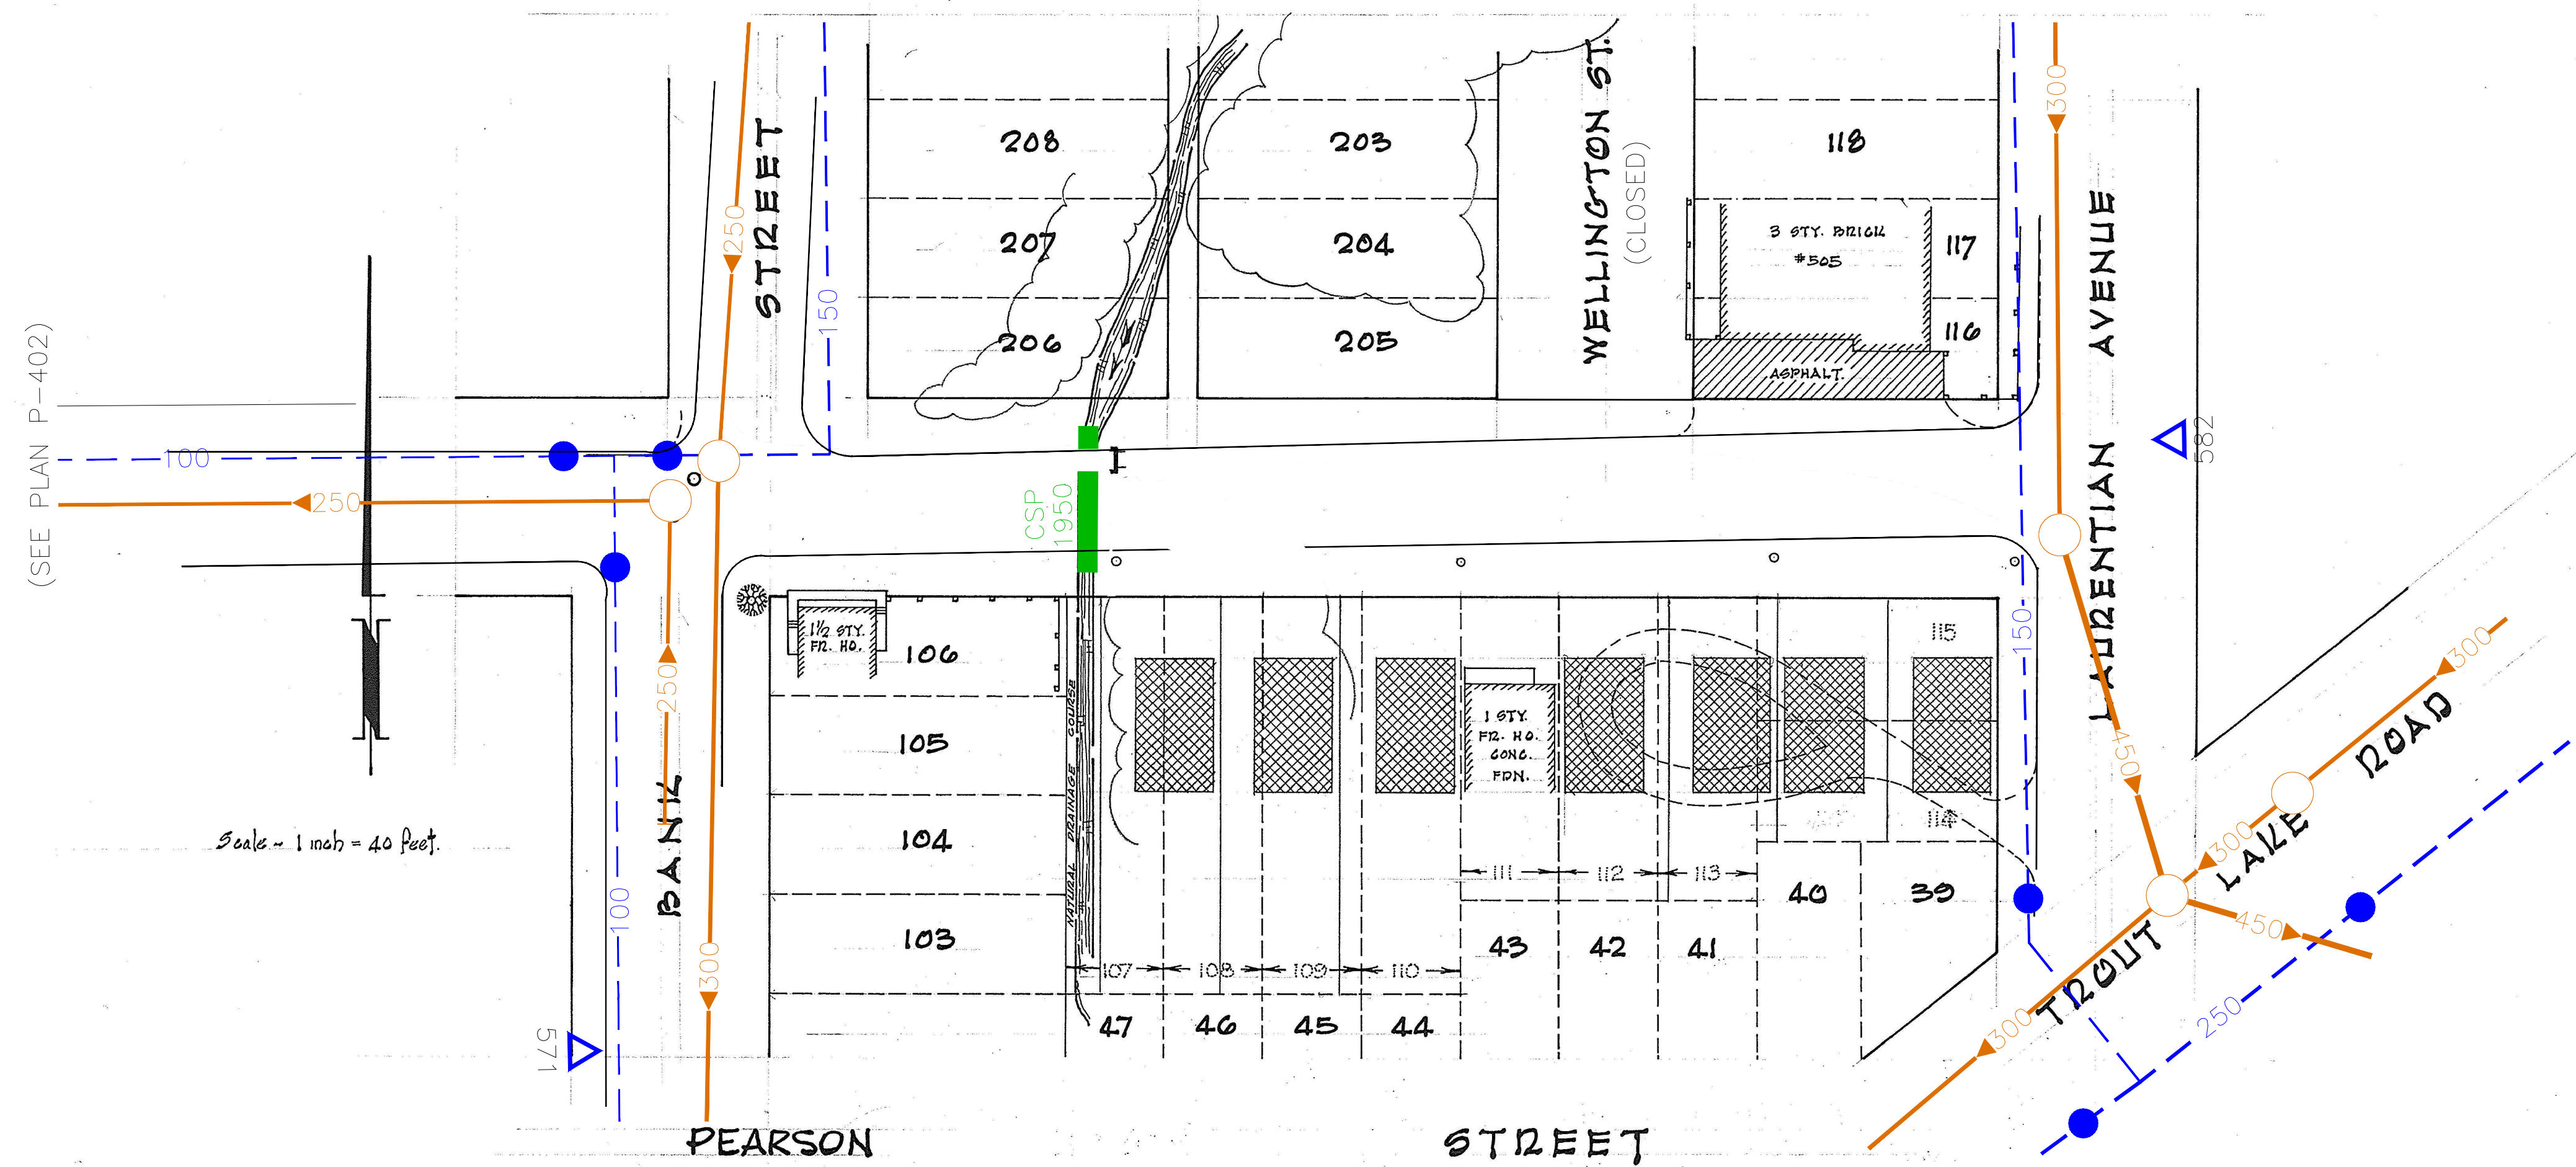


PEARSON ST.
FORMERLY
HIGH STREET

DISCLAIMER

The information contained on this drawing may be based upon data provided by others and may not have been verified by either as-constructed drawings or an Ontario Land Surveyor. The City of North Bay cannot accept responsibility for any errors or omissions on any information shown herein. Field verification, land surveys or excavation (with City approvals) may be required to determine actual location of any and all utilities or property lines.

BENCH MAZIL			
DATE	REVISIONS	DWG. BY	CHK. BY
Mar 2011	Added services from sheets	J.W.C.	
CORPORATION OF THE CITY OF NORTH BAY ONTARIO			
PLAN AND PROFILE			
PEARSON STREET			
FROM BANK ST. TO LAURENTIAN AVE.			
DWG. BY: B. SAUNDERS	CHK. BY:	DATE: JUNE 01/05	FIELD BOOK NO.:
SCALE: AS SHOWN	APPROVED BY: CITY ENGINEER	DWG. NO. P-401	