
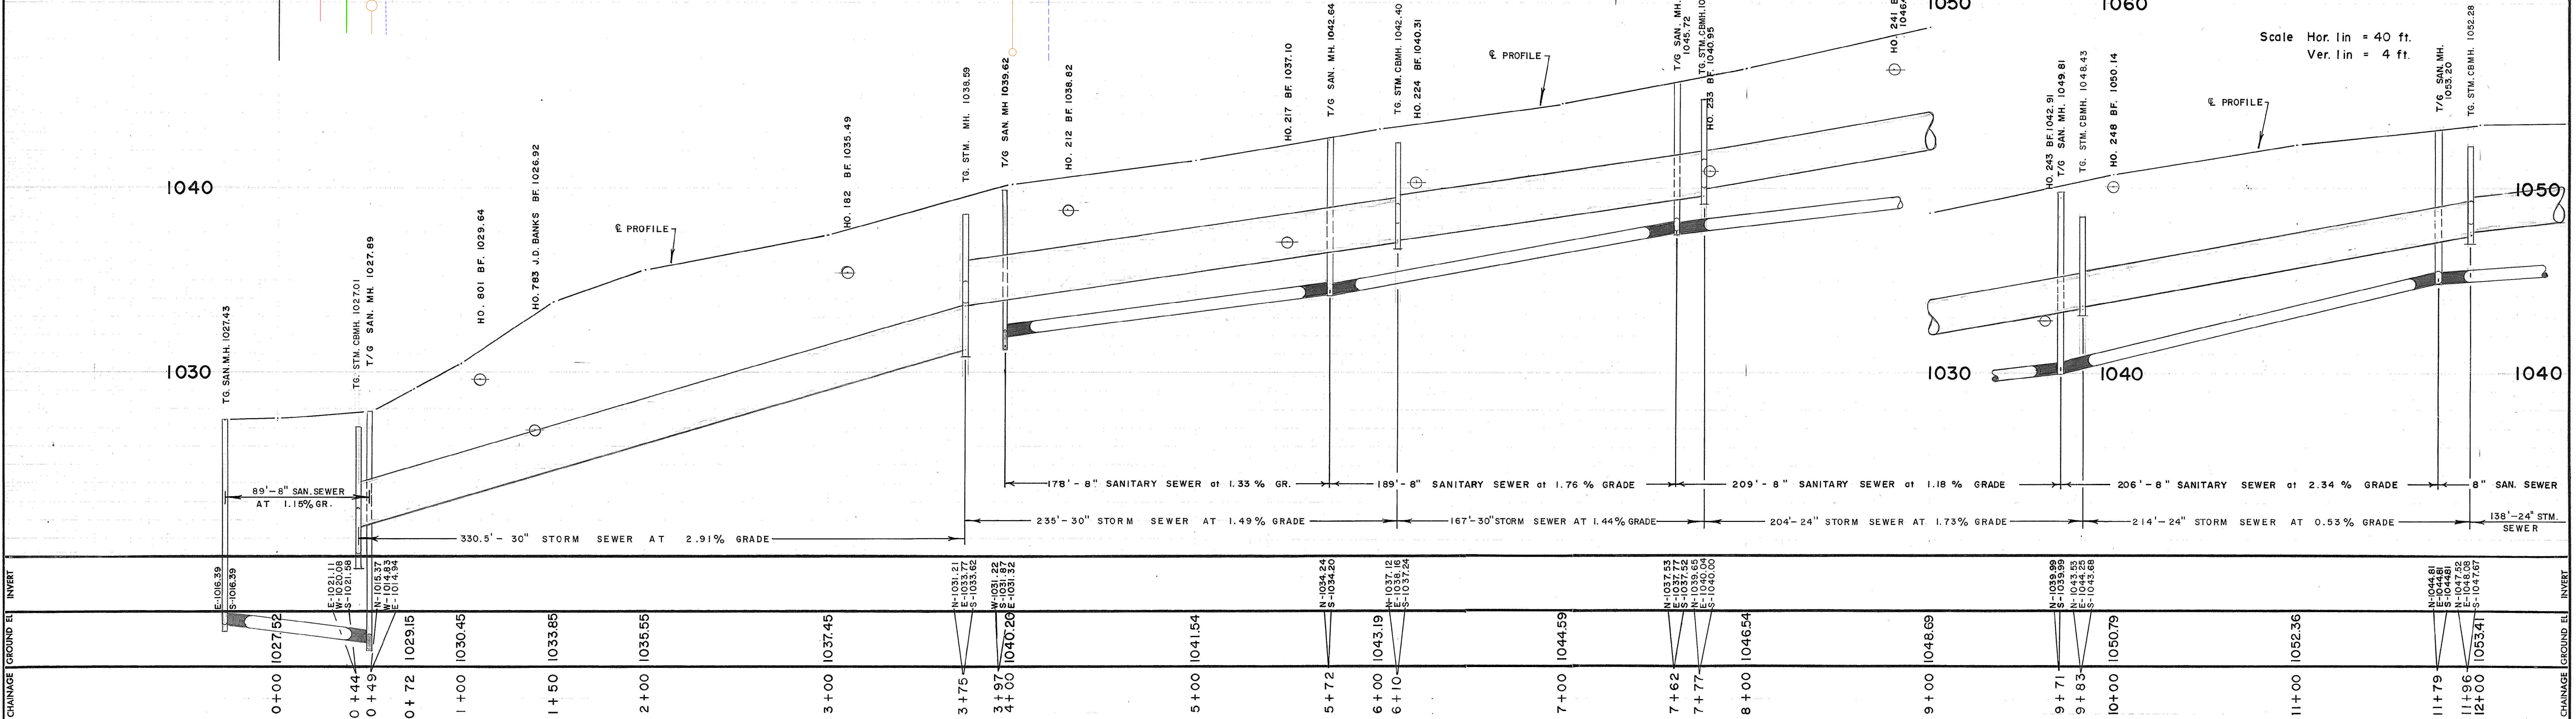


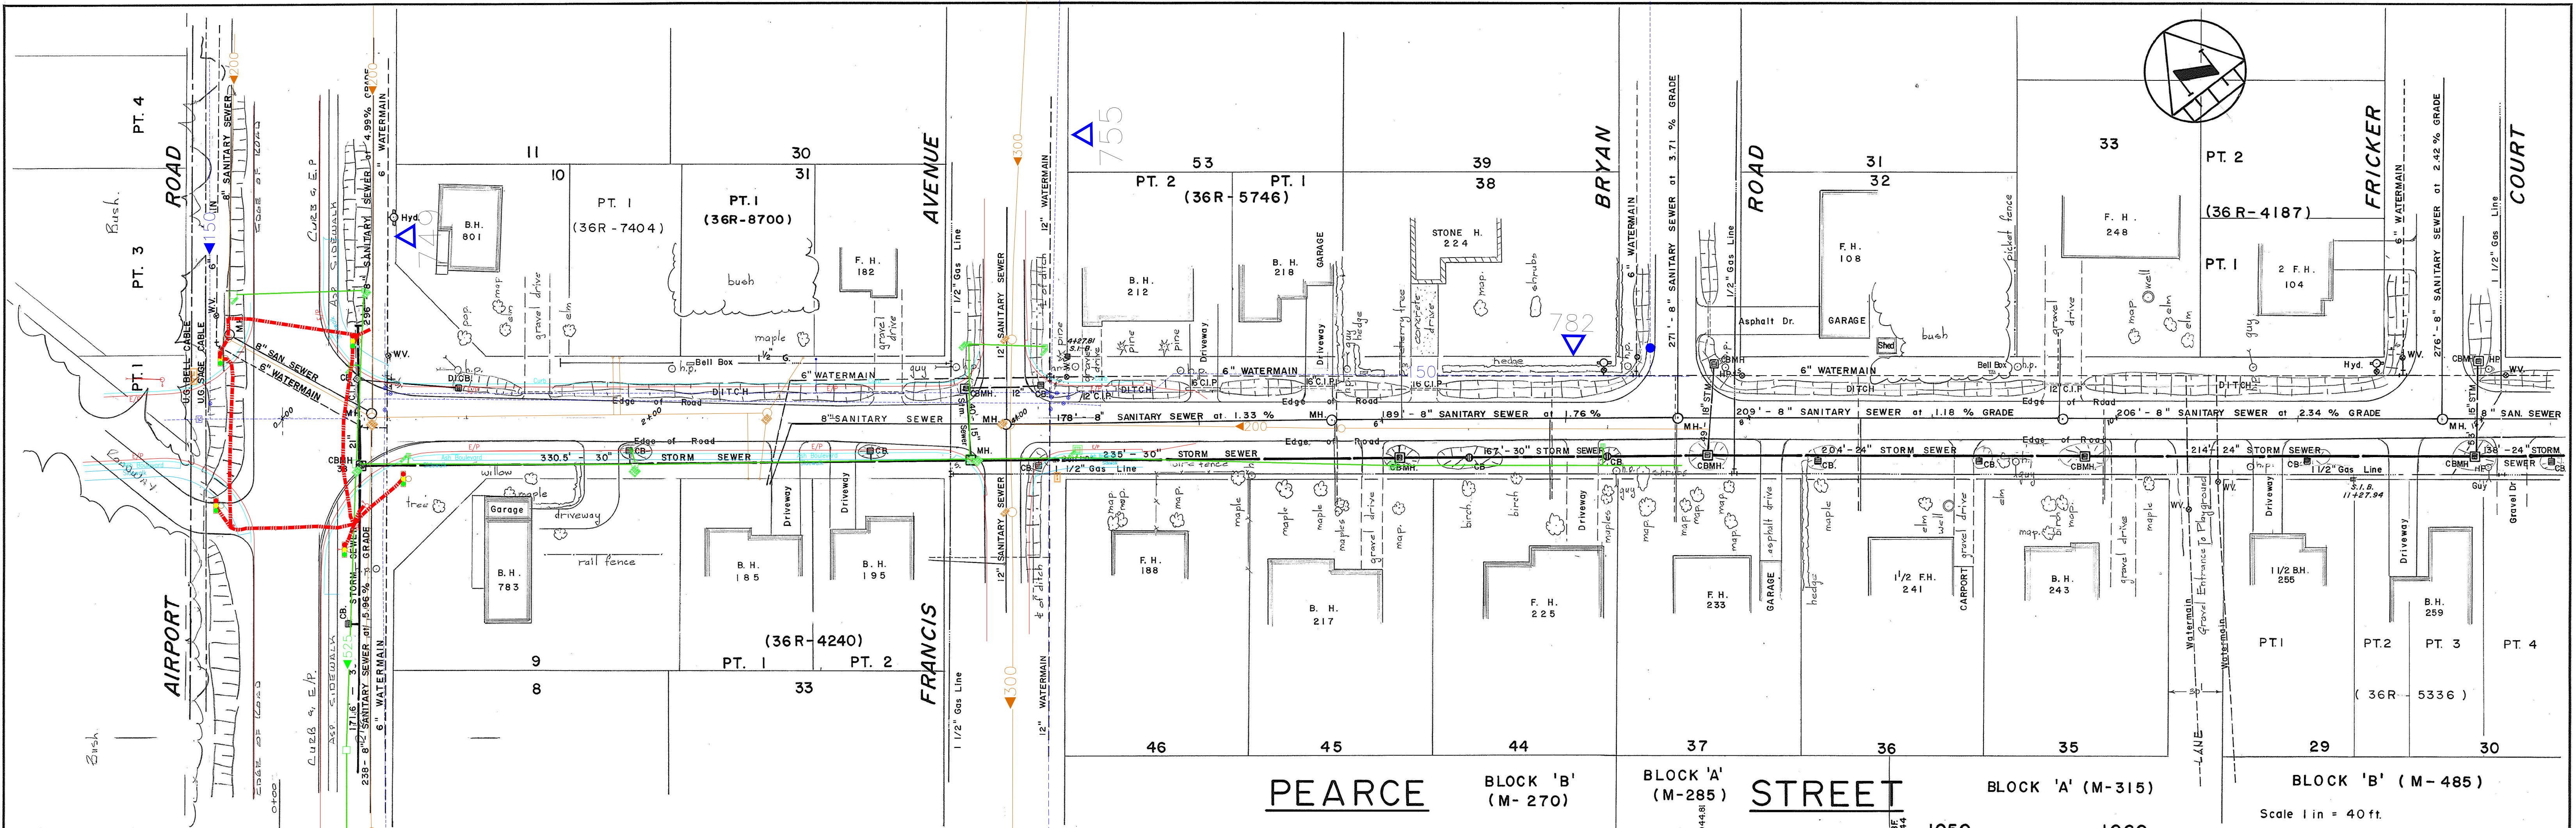

**NOTES:**

**DISCLAIMER**

The information contained on this drawing may be based on data provided by others and may not have been verified by either as-constructed drawings or an Ontario Land Surveyor. The City of North Bay cannot accept responsibility for any errors or omissions on any information shown herein. Field verification, land surveys or excavation (with City approval) may be required to determine actual location of any and all utilities or property lines.

| No. | REVISION                                            | DATE      | INITIAL |
|-----|-----------------------------------------------------|-----------|---------|
| 1   | SANITARY & WATERMAIN on FRANCIS                     | June / 75 | j.d.m.  |
| 2   | AS CONT'D SANITARY & WATERMAIN                      | Mar / 77  | j.d.m.  |
| 3   | REVISE AIRPORT ROAD INTERSECTION                    | AUG. 83   | J.S.    |
| 4   | UPDATE DETAIL, PROFILE Airport-Greenhill            | DEC. 86   | Rick B. |
| 5   | AS CONST'D. STM.(Cont. 115-87) Airport to Greenhill | SEPT. 87  | Rick B. |
| 6   | As-Built Pearce St.                                 | Oct. 28   | J.M.    |

**APPROVED**

**PEARCE STREET**

**AIRPORT ROAD to FRICKER COURT**

Reg'd. Plan - M-315  
- LOT 18 CON. B

**CITY OF NORTH BAY**

**ENGINEERING DEPARTMENT**

SCALE: AS SHOWN DATE: JAN. 1970

DRAWN BY: P.D. FIELD BOOK No. 190, 246

CKD BY: P.D. P-451

REV.