
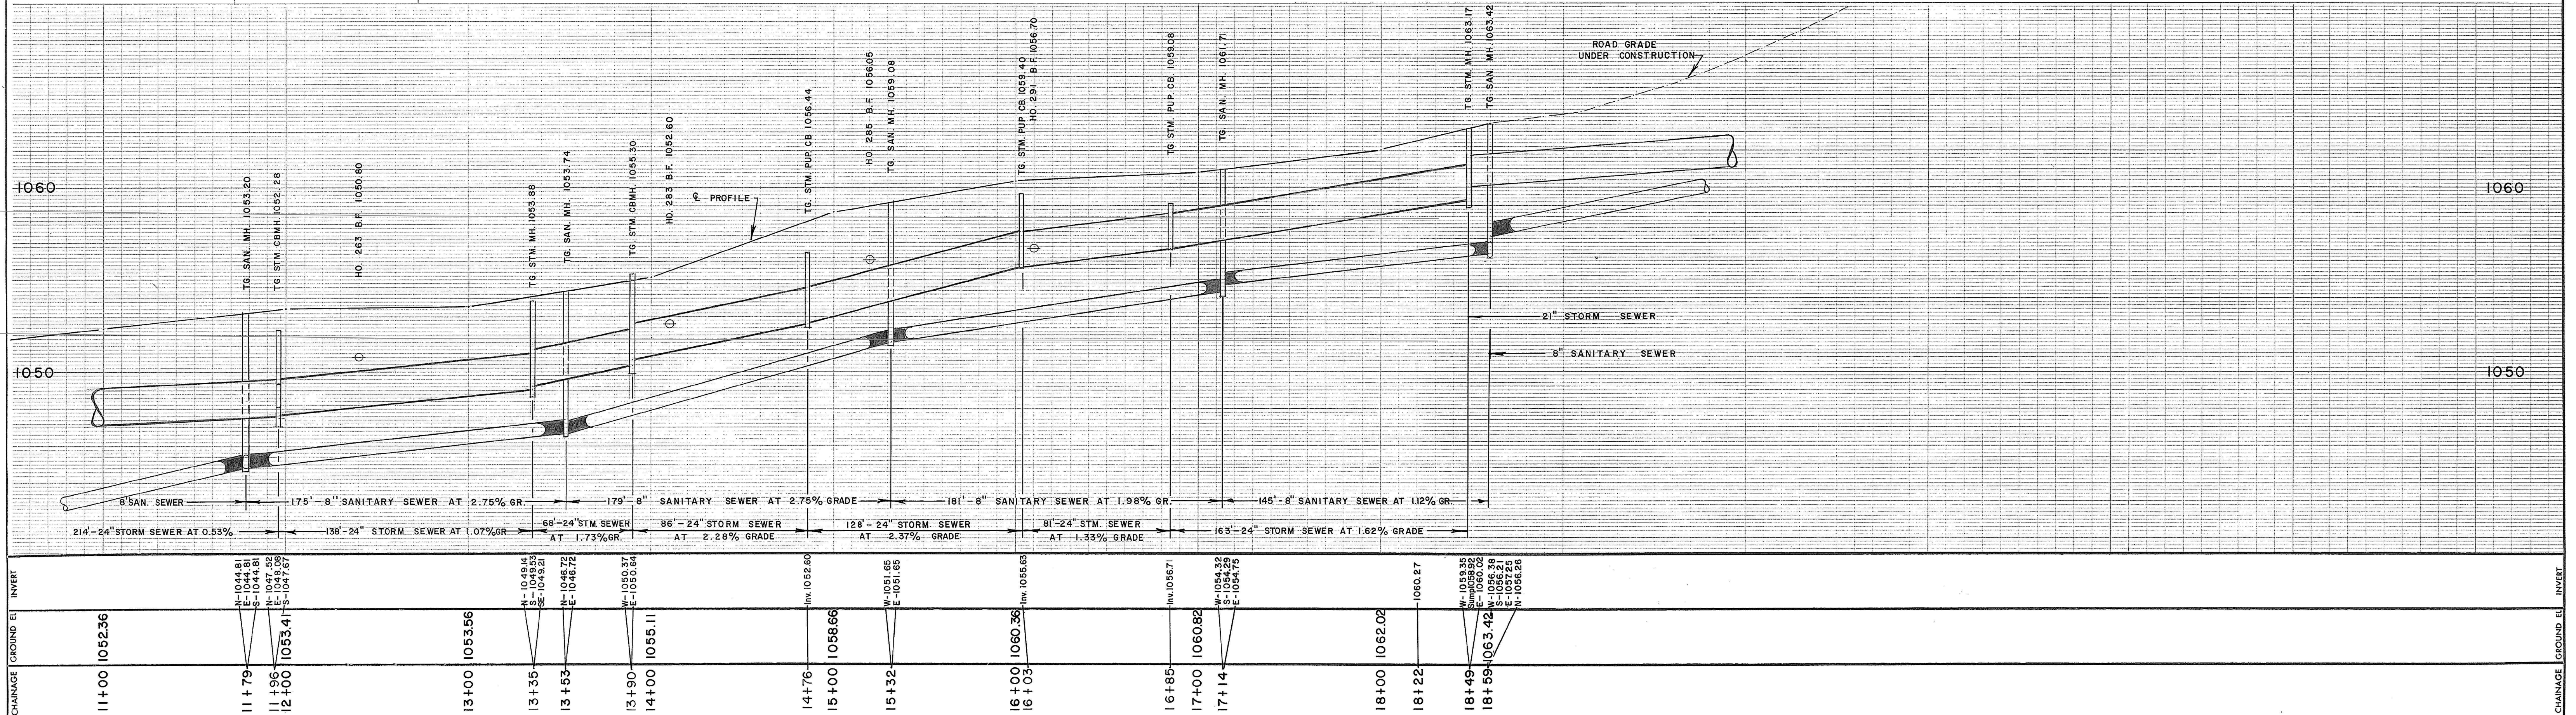


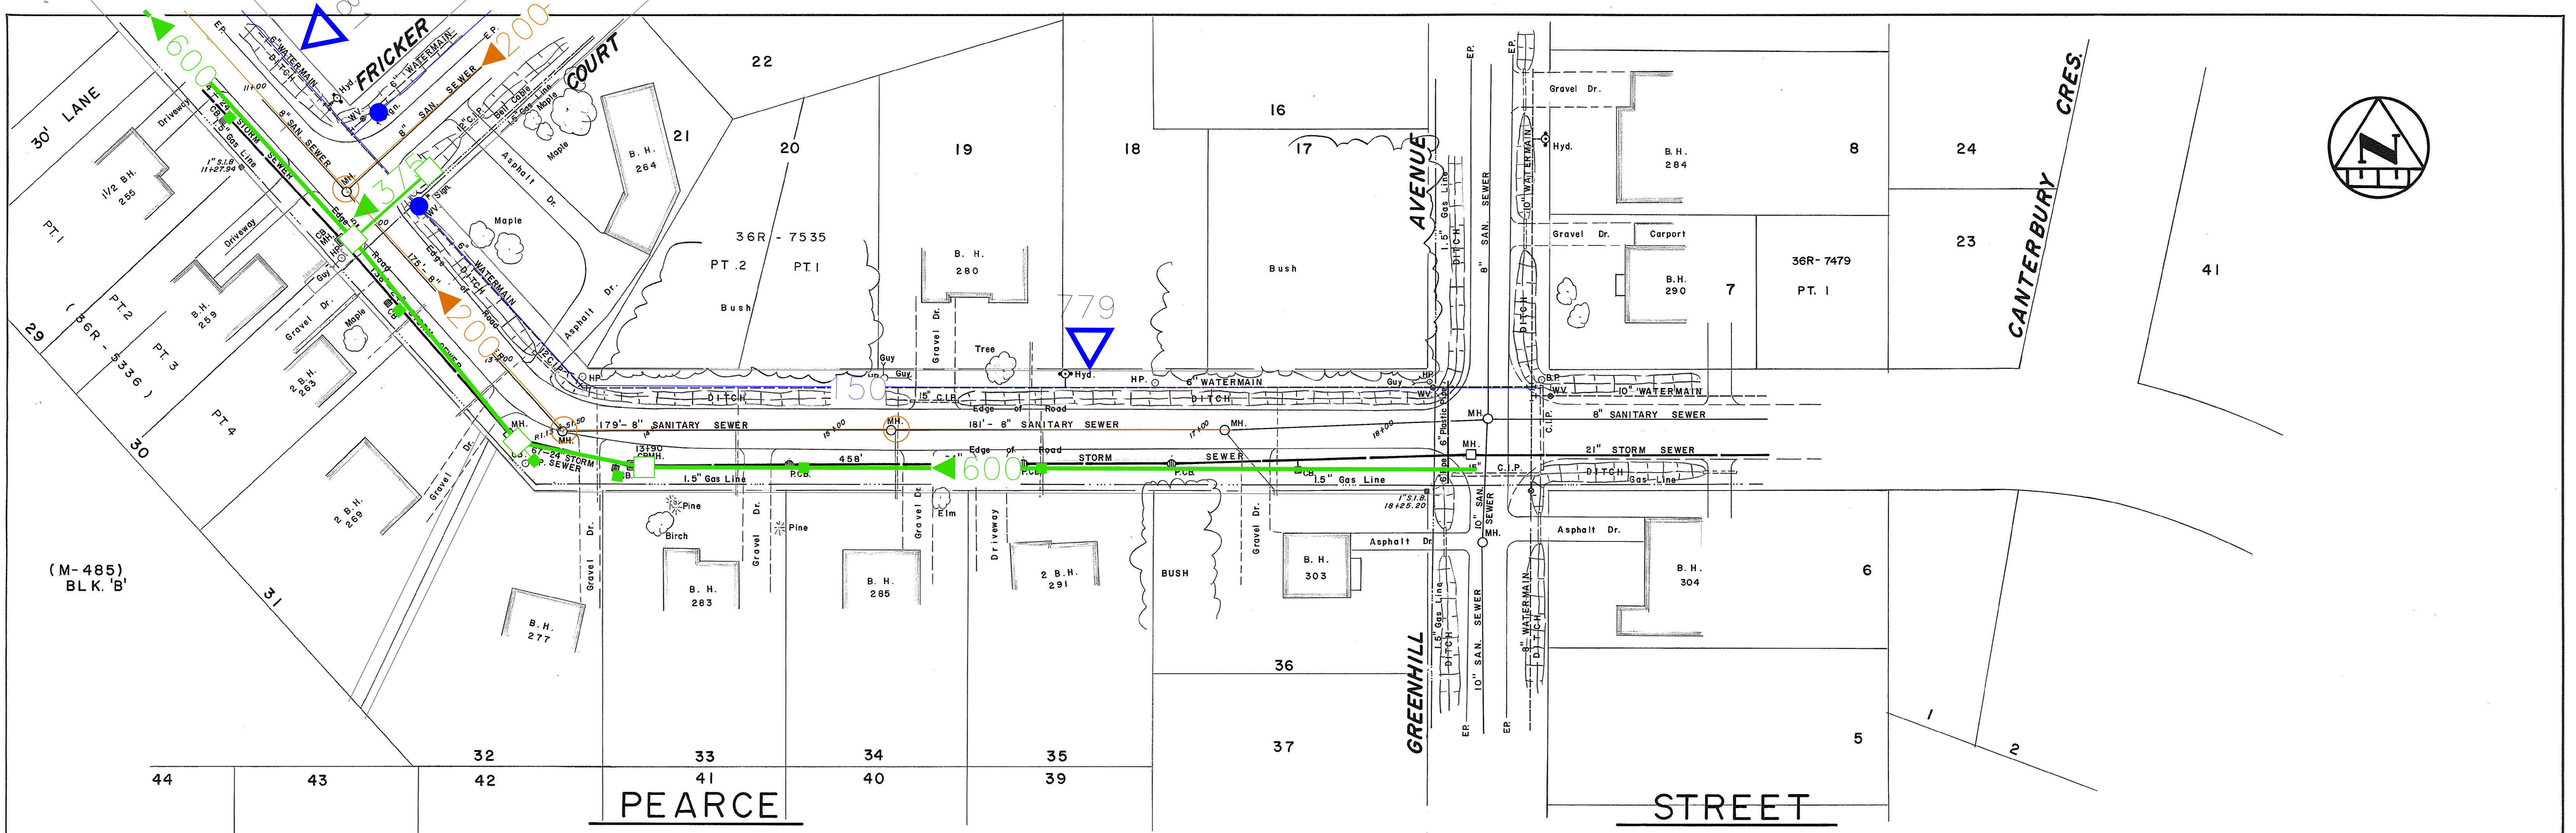

NOTES:

DISCLAIMER

The information contained on this drawing may be based upon data provided by others and may not have been verified by either as-constructed drawings or an Ontario Land Surveyor. The City of North Bay cannot accept responsibility for any errors or omissions on any information shown herein. Field verification, land surveys or excavation (with City approvals) may be required to determine actual location of any and all utilities or property lines.

1.	DRAWING REDRAWN AND REVISED	DEC. 86.	RICK B.
2.	AS CONST'D. SAN. SEWER AND WATER	DEC. 86.	RICK B.
3.	AS CONST'D. STM. (Cont. 115-87) Airport to Greenhill	SEPT. 87.	Rick B.
4.	AS CONST'D. SAN. 17+14 to 18+59	AUG. '88	P.L.C.
No.	REVISION	DATE	INITIAL

PEARCE STREET		CITY OF NORTH BAY	
FRICKER COURT TO GREENHILL AVENUE		ENGINEERING DEPARTMENT	
SCALE: HOR. 1"=40'	DATE: DEC. 86.	DRAWING No.	REV.
VER. 1"=4'		190, 280	P-452