
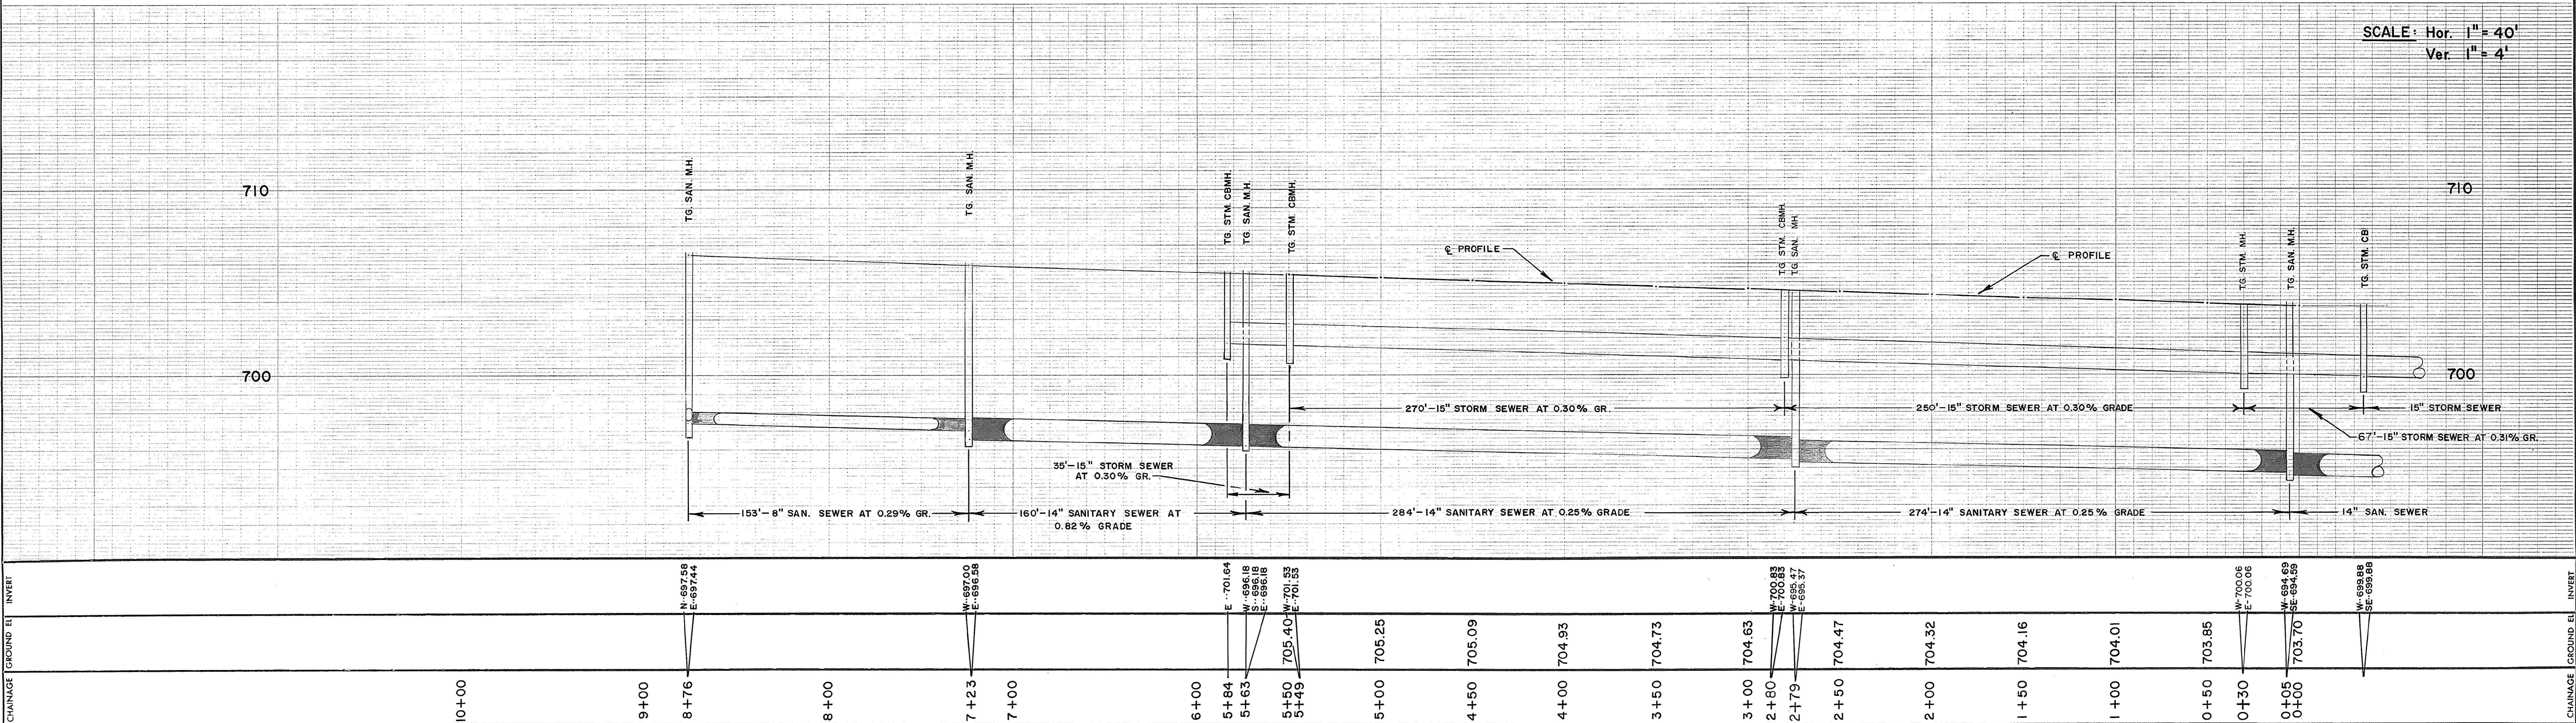


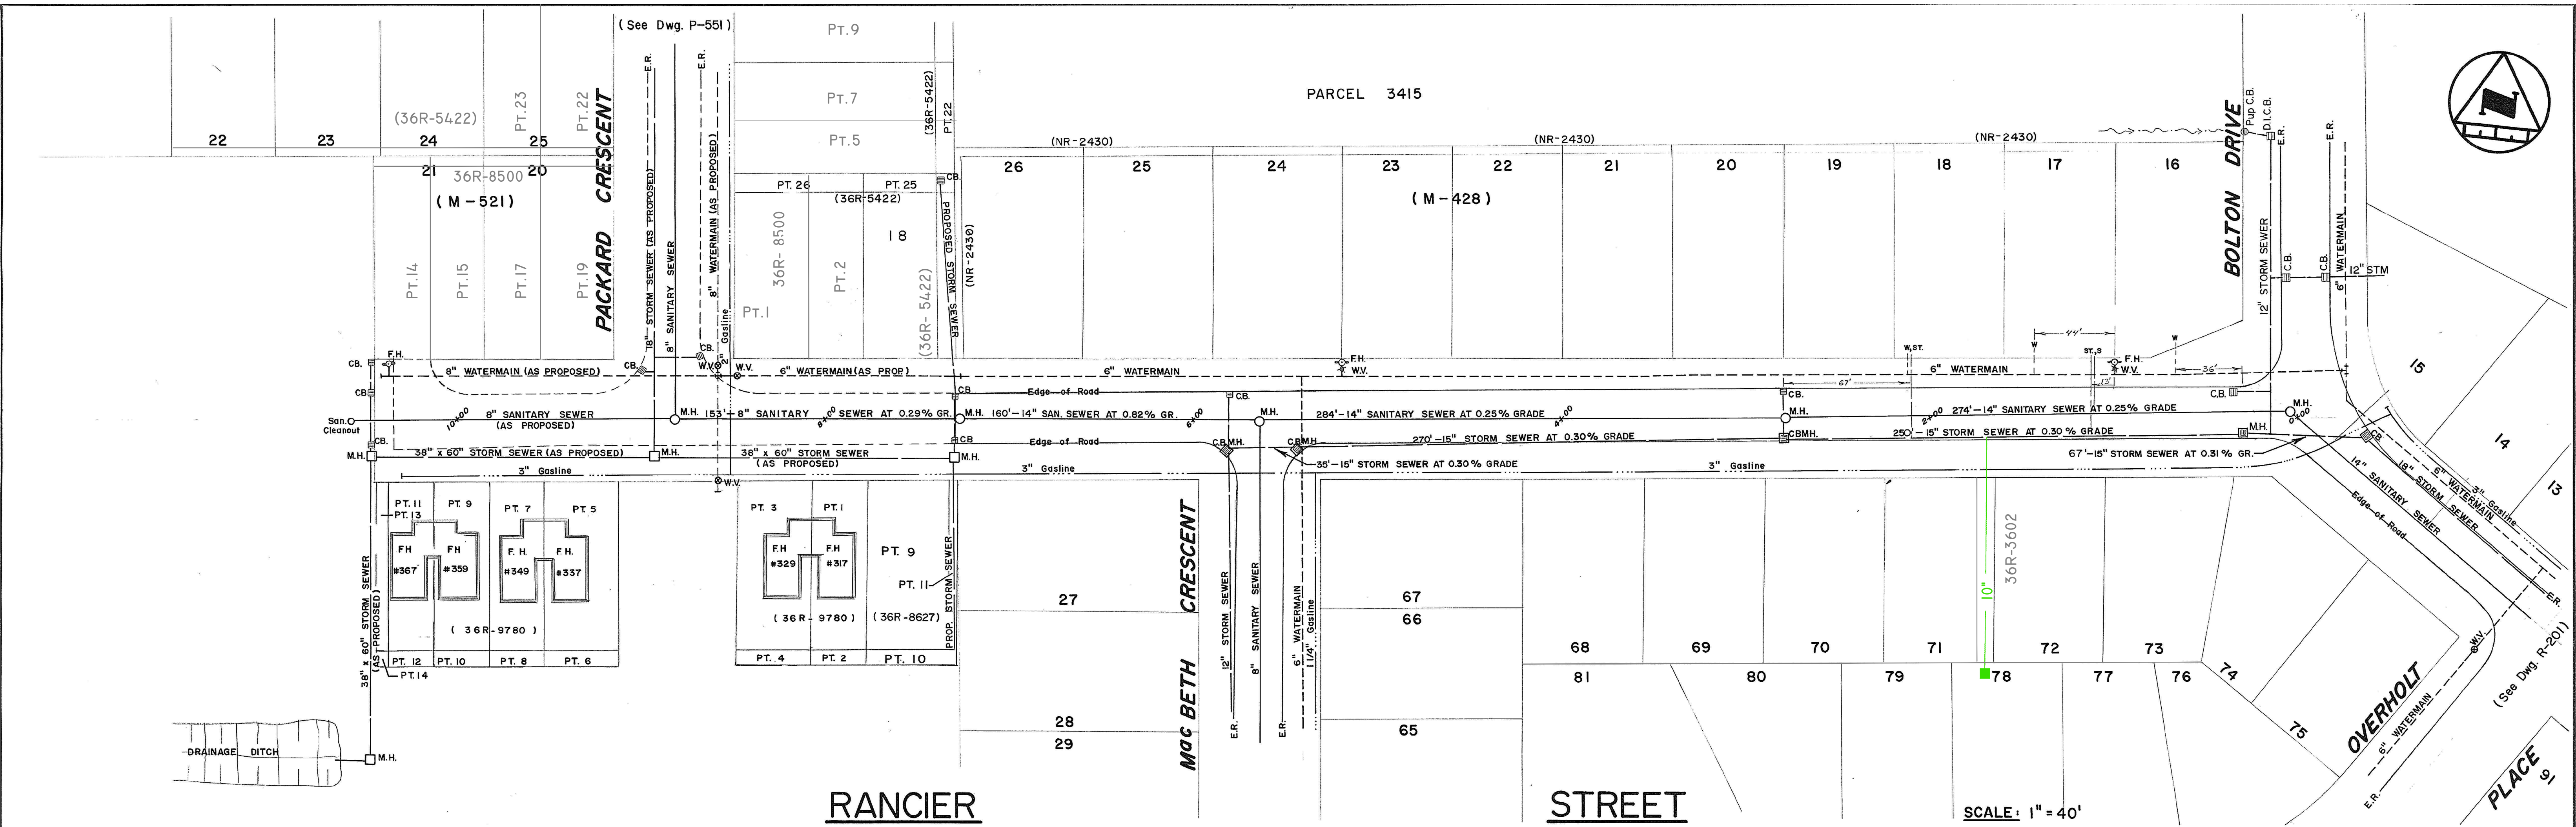

NOTES:

DISCLAIMER

The information contained on this drawing may be based upon data provided by others and may not have been verified by either as-constructed drawings or an Ontario Land Surveyor. The City of North Bay cannot accept responsibility for any errors or omissions on any information shown herein. Field verification, land surveys or excavation (with City approvals) may be required to determine actual location of any and all utilities or property lines.

1.	NEW DWG. FROM SUBD'N. DWGS. (1969)	J.S.	SEPT 84
2.	CHANGES TO STM SEWER AT BOLTON	J.STP.	OCT./98
3.	REGISTERED PLANS ADDED.	R.J.O.	JAN 09
No.	REVISION	DATE	INITIAL

APPROVED

RANCIER STREET	
BOLTON DRIVE to PACKARD CRESCENT	
REG'D. PLAN NO. M - 428 M - 521	
DRAWN BY: J.S. CHK'D. BY: R.F.B.	FIELD BOOK No. DRAWING No. R-202

CITY OF NORTH BAY	
ENGINEERING DEPARTMENT	
SCALE: AS SHOWN	DATE: SEPT. 84
REV.	

DWG. No.