
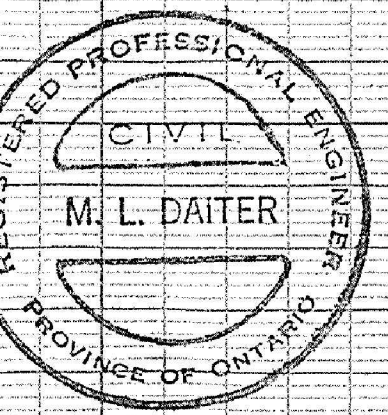


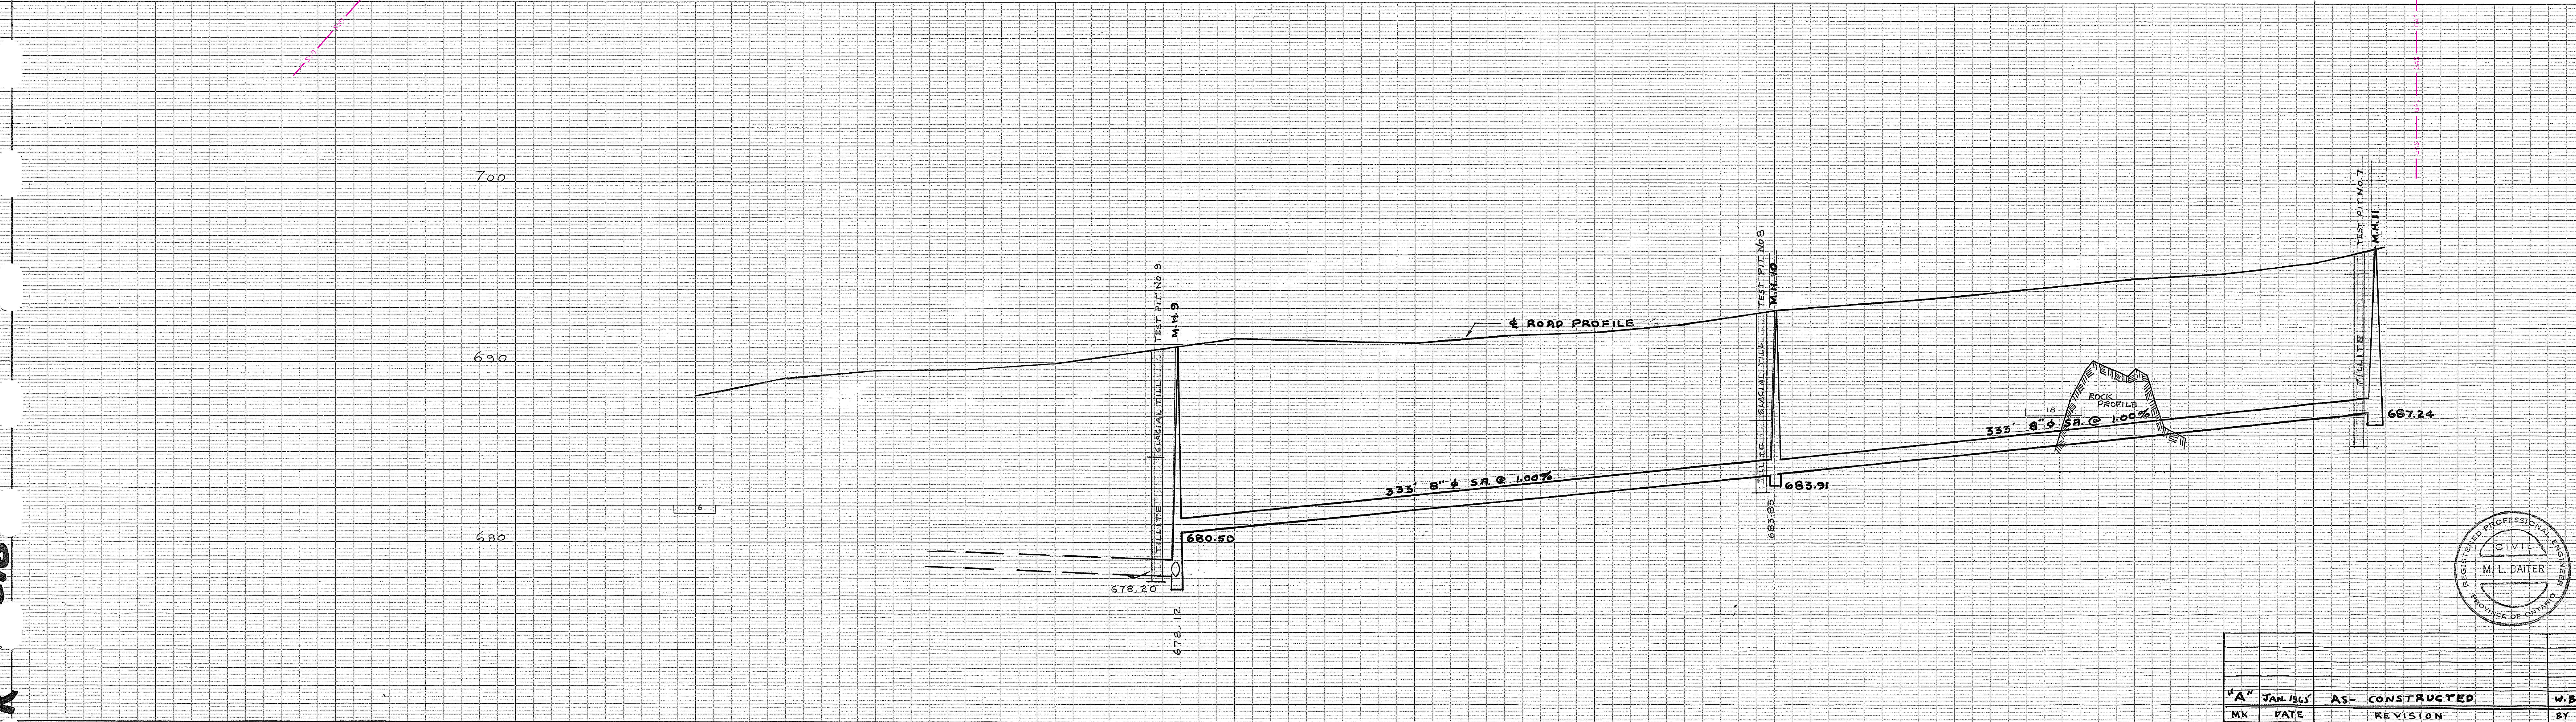

NO.	DATE	REVISION	BY
1	JAN 1964	AS-CONSTRUCTED	W.B.