



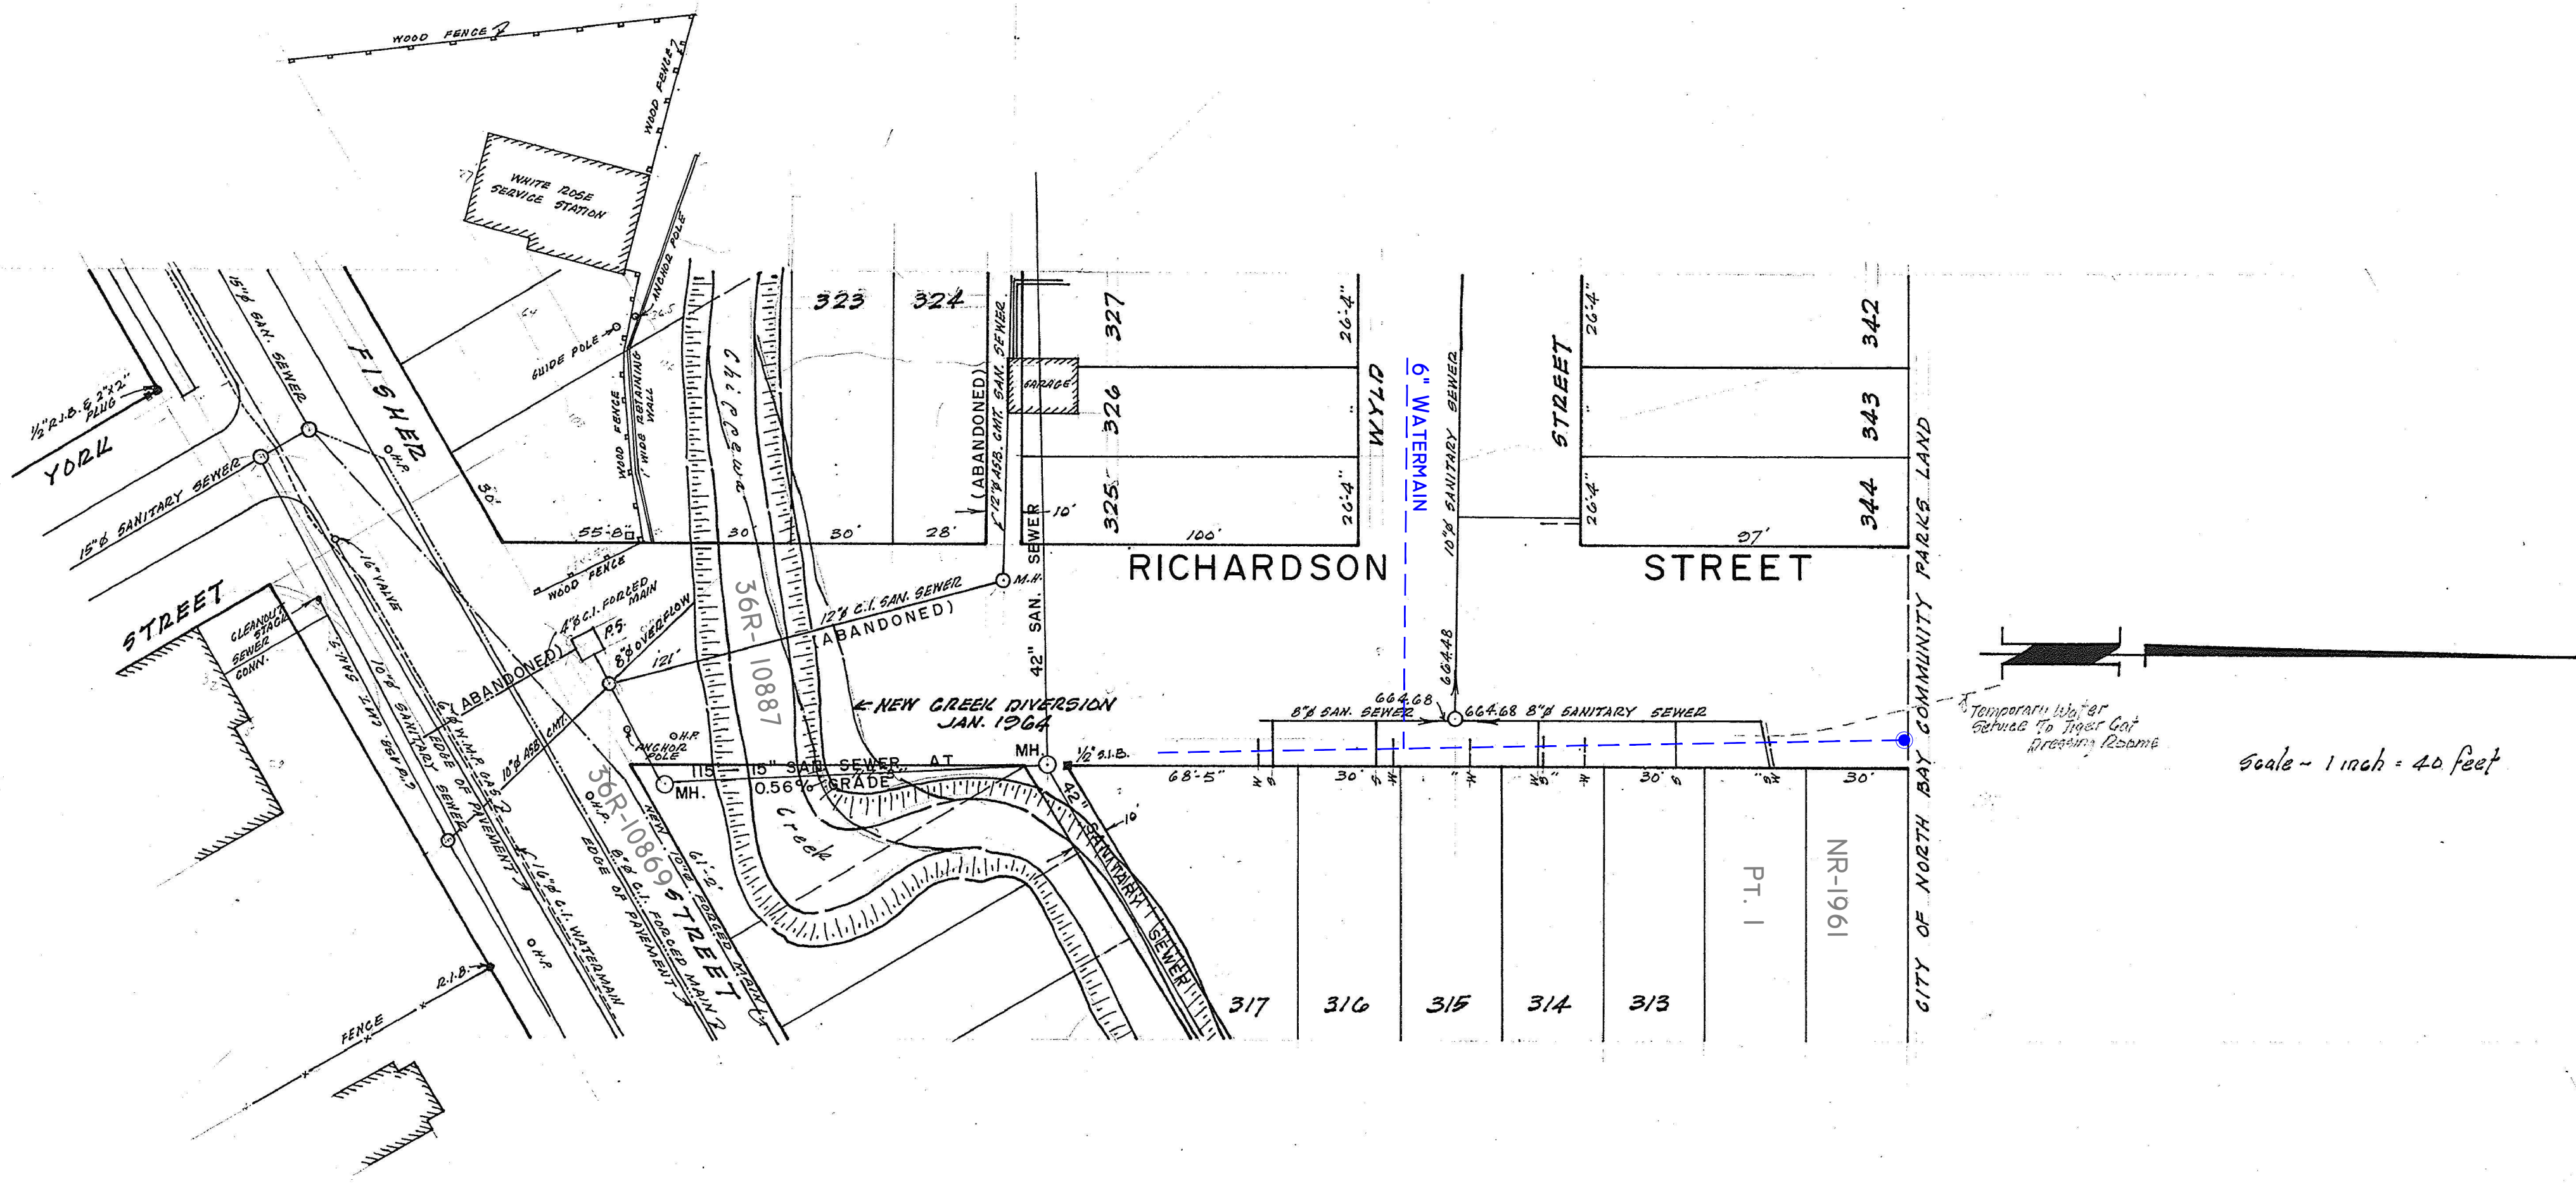

RICHARDSON STREET

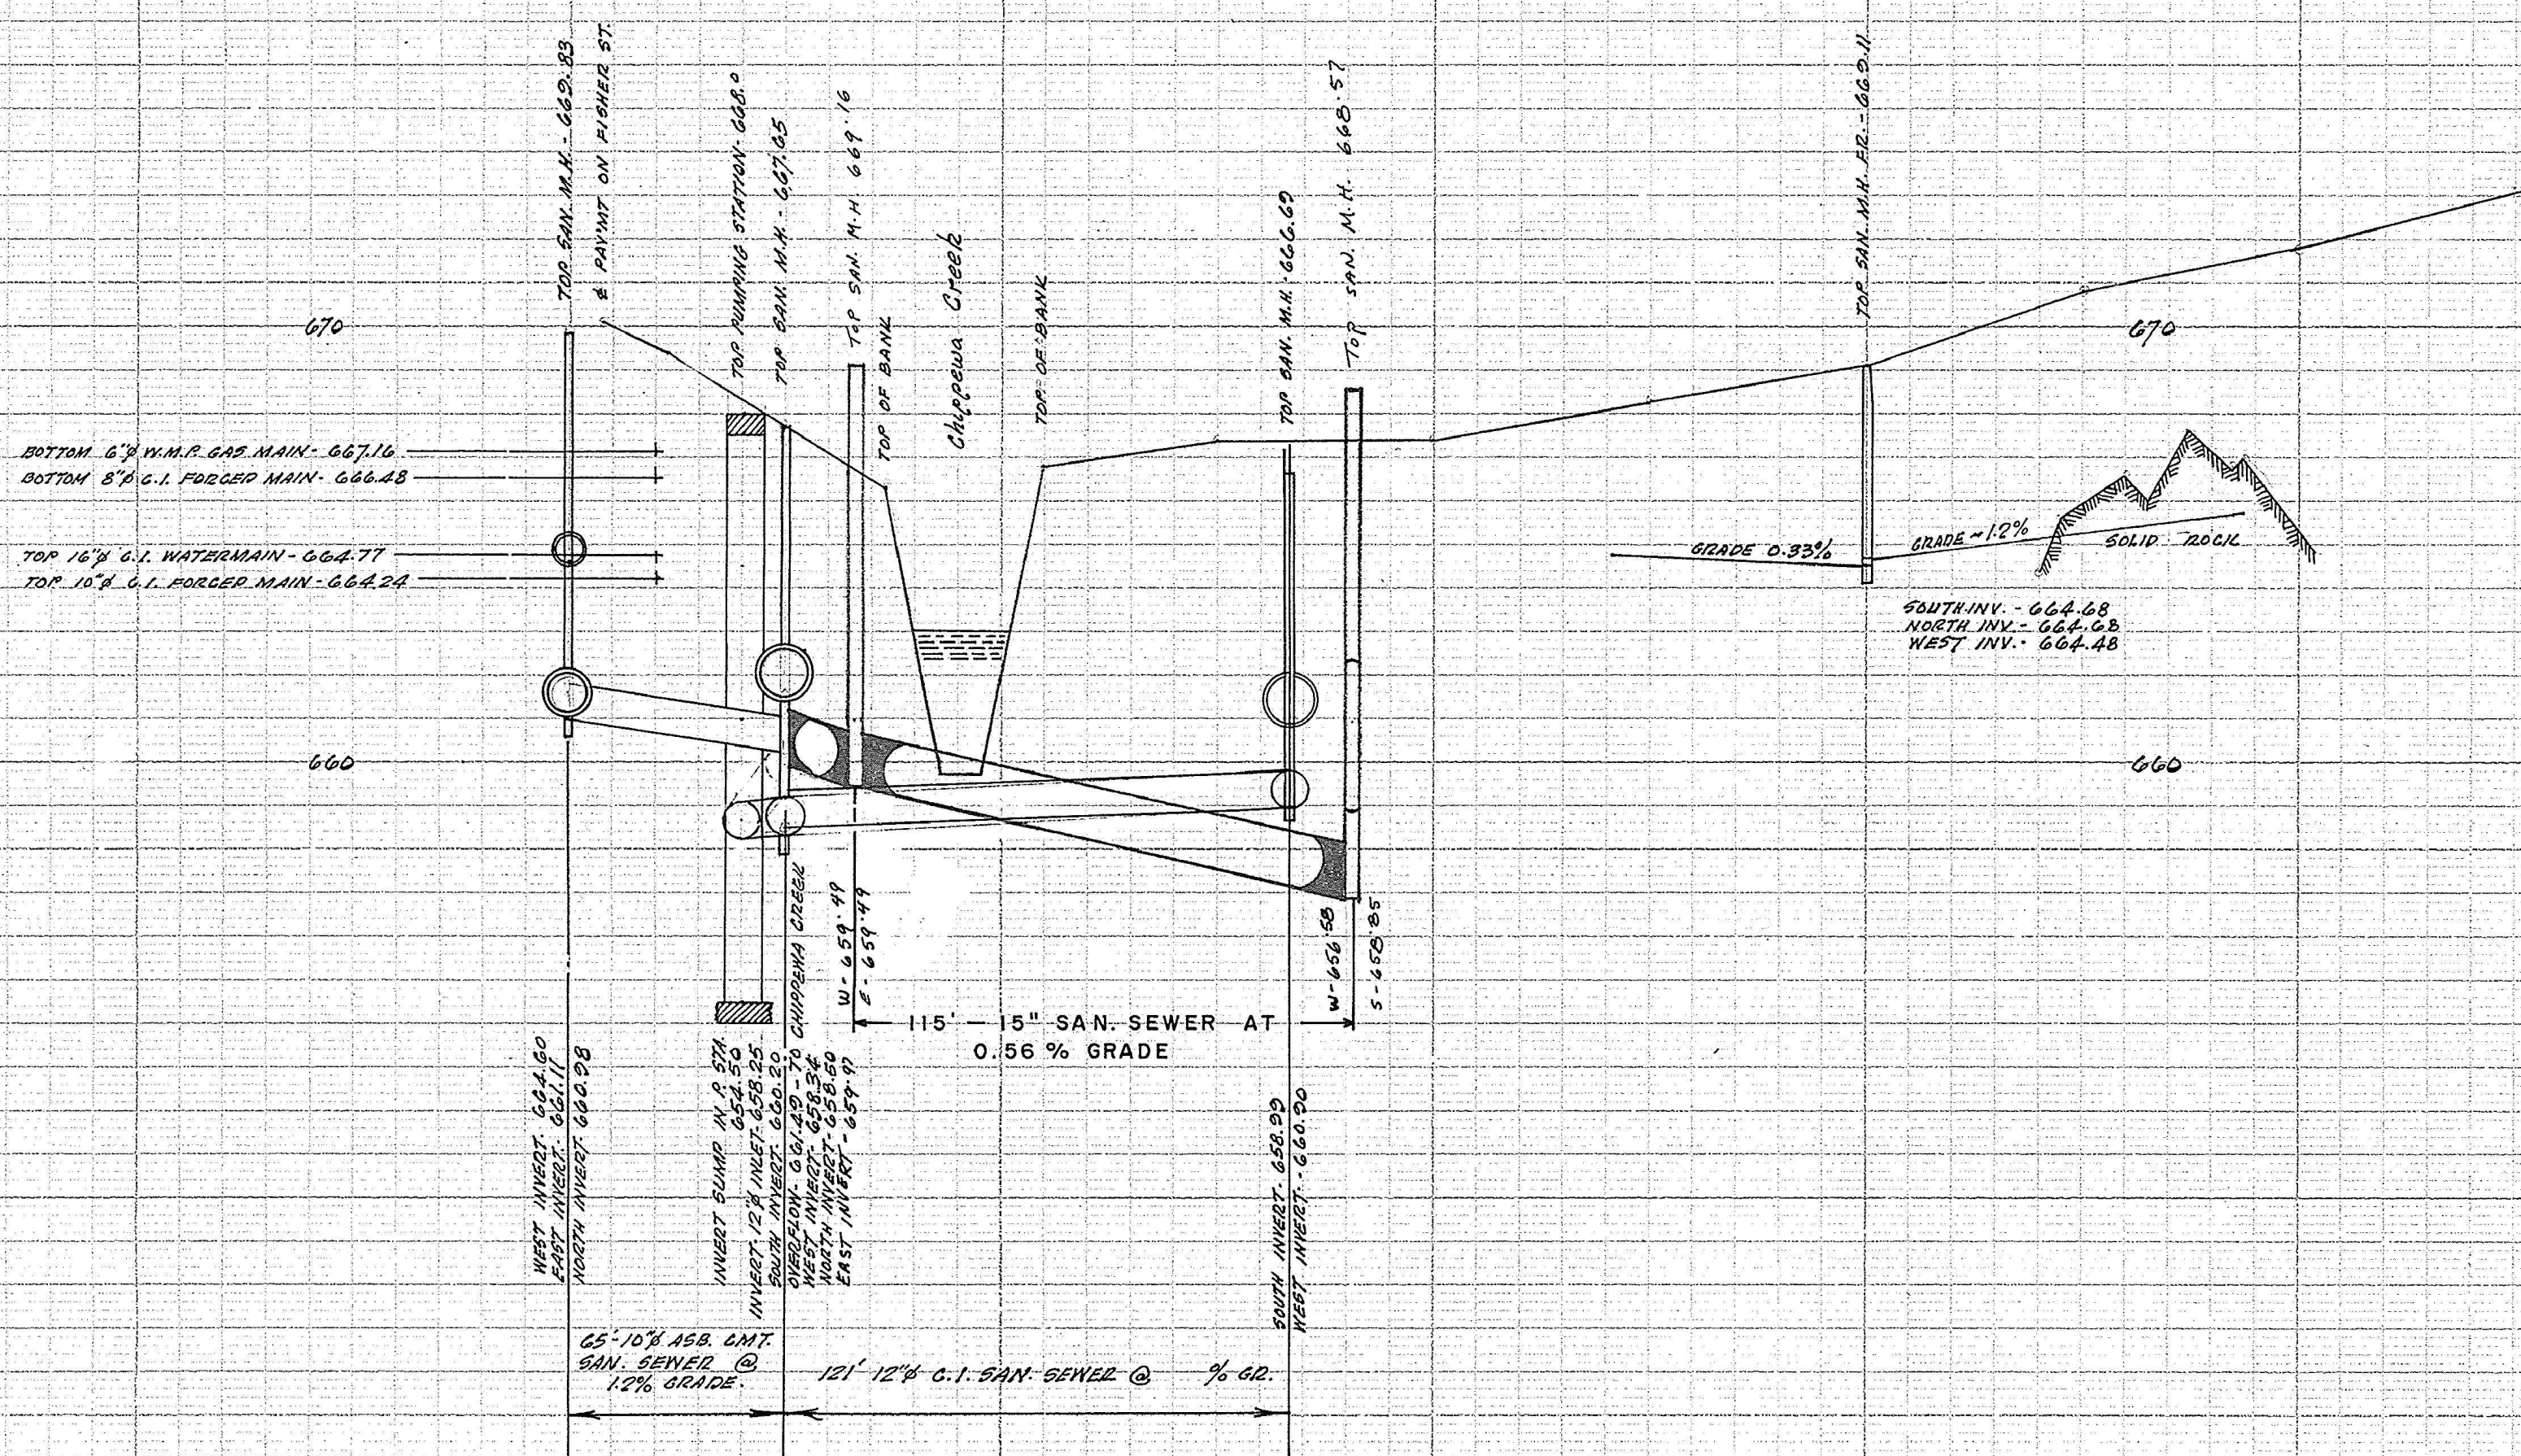

DISCLAIMER

The information contained on this drawing may be based upon data provided by others and may not have been verified by either as-constructed drawings or an Ontario Land Surveyor. The City of North Bay cannot accept responsibility for any errors or omissions on any information shown herein. Field verification, land surveys or excavation (with City approvals) may be required to determine actual location of any and all utilities or property lines.

BENCH MARK			
DATE	REVISIONS	DWG. BY	CHK. BY
NOV. 30/03	AS CONSTRUCTED SAN. SEWER	B.A.S.	F.P.
JAN. 08	REGISTERED PLANS ADDED	R.J.O.	

CORPORATION OF THE CITY OF NORTH BAY, ONTARIO

PLAN & PROFILE
RICHARDSON STREET
FISHER ST. NORTH TO PARK LINE

DWG. BY	DATE	CHK. BY	FIELD BOOK NO.
B. Saunders	April 20/03		
SCALE AS SHOWN.	APPROVED BY	DWG. NO.	R-552