

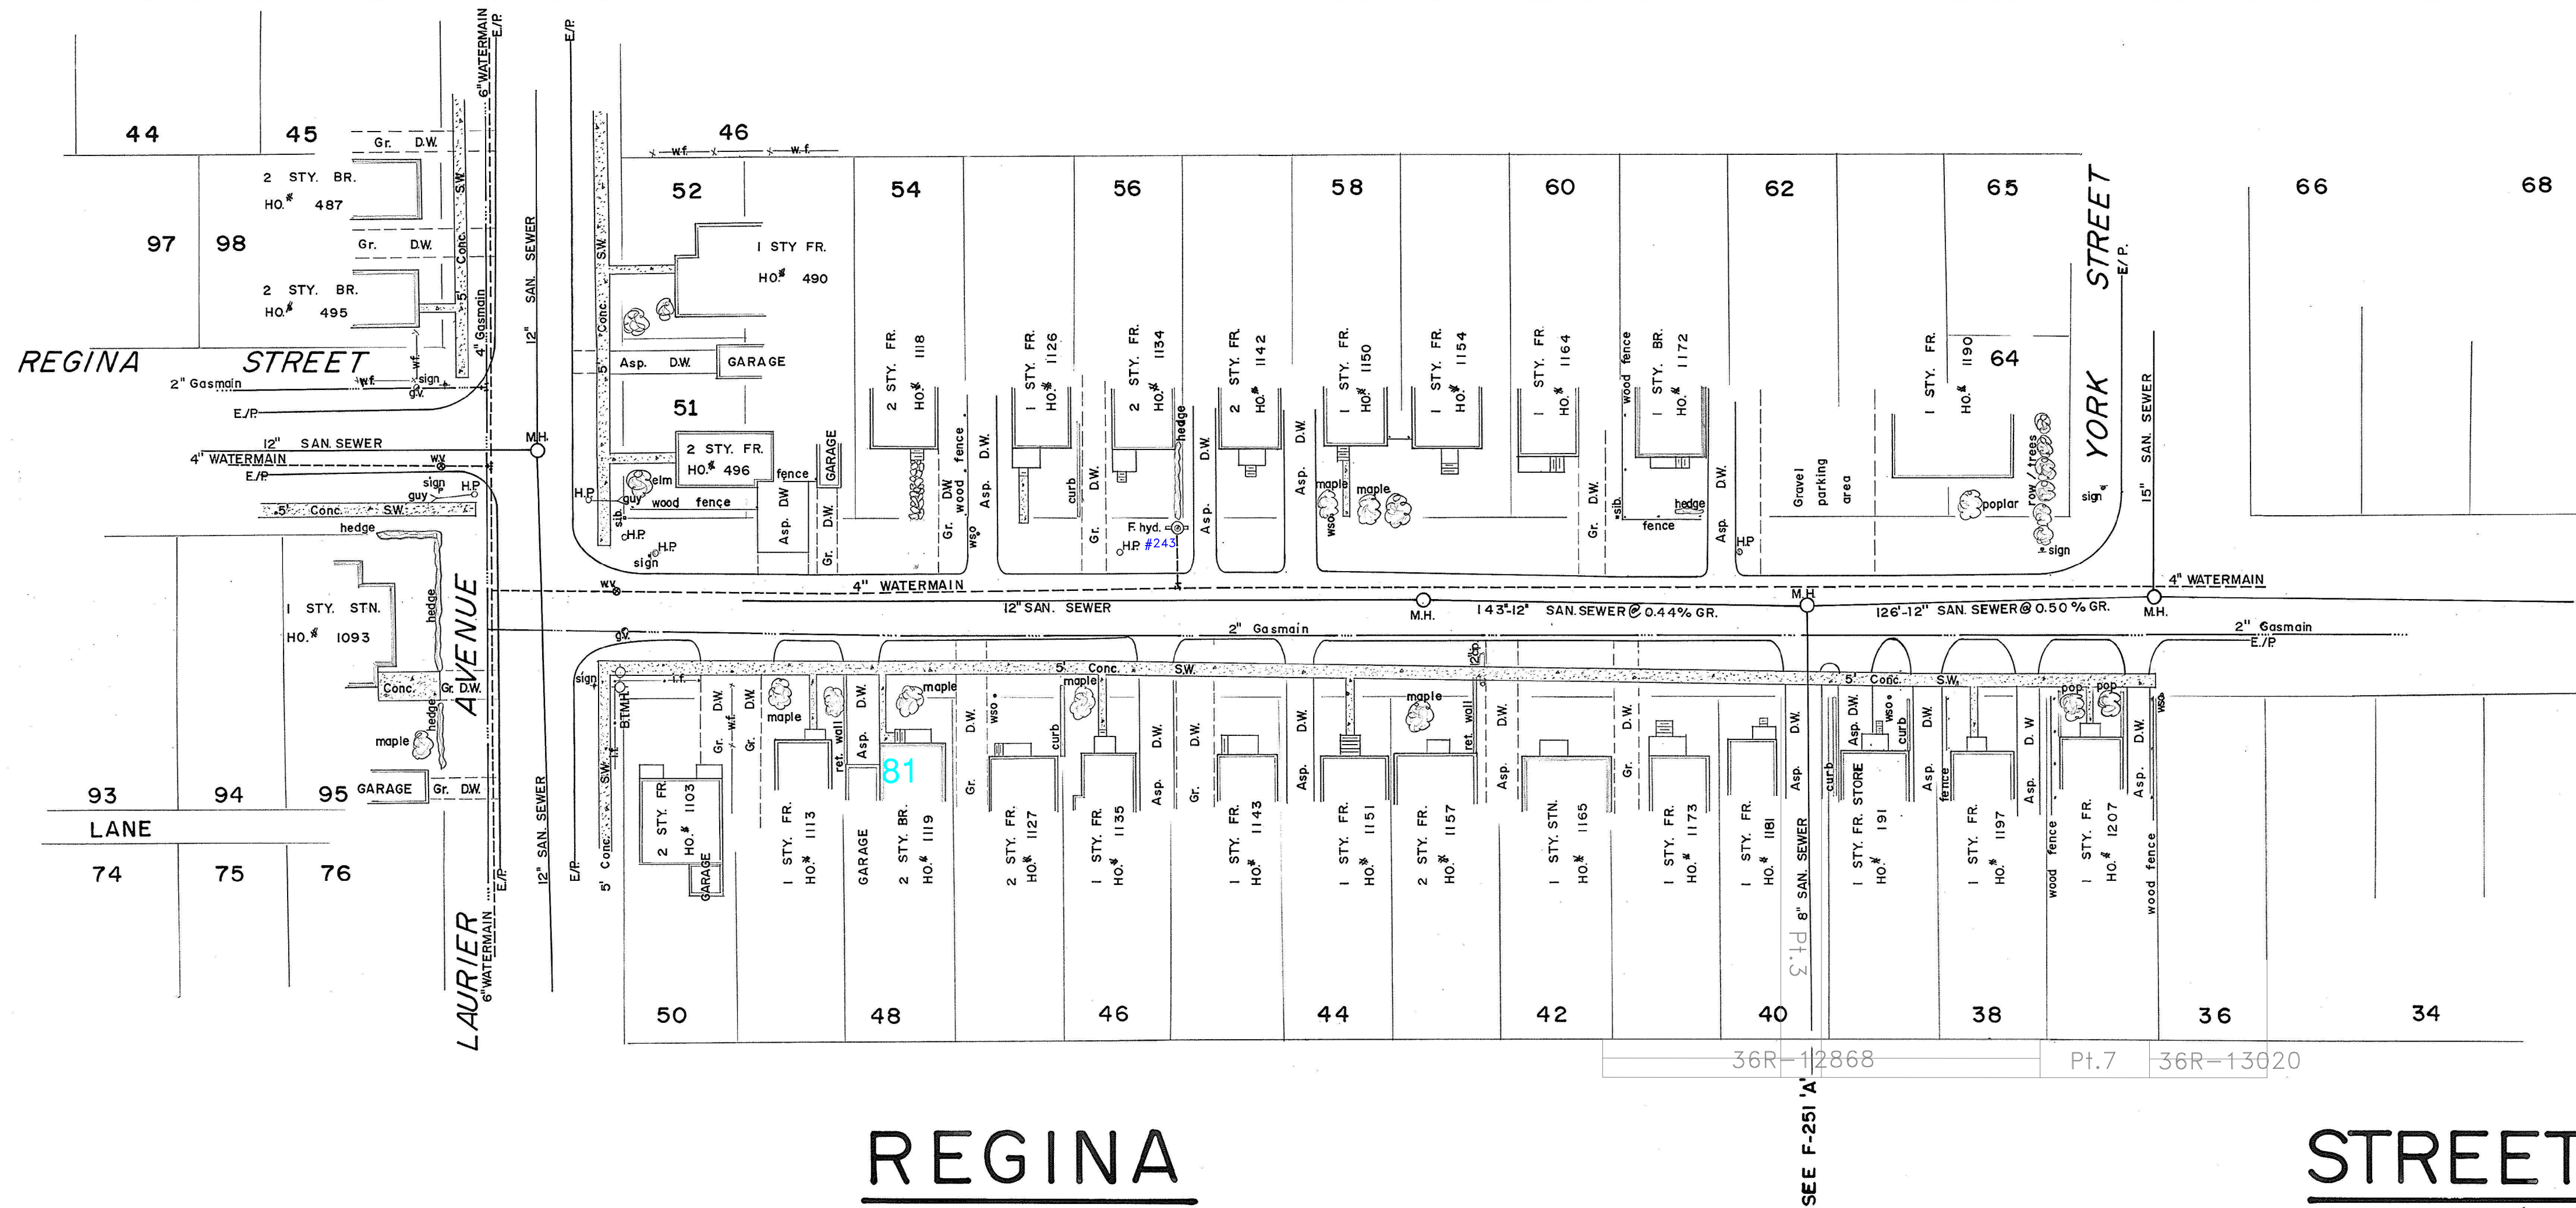


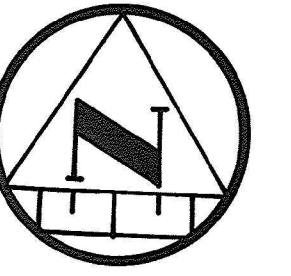

SCALE: 1 in. = 40 ft.

SCALE: hor. 1" = 40'  
ver. 1" = 4'

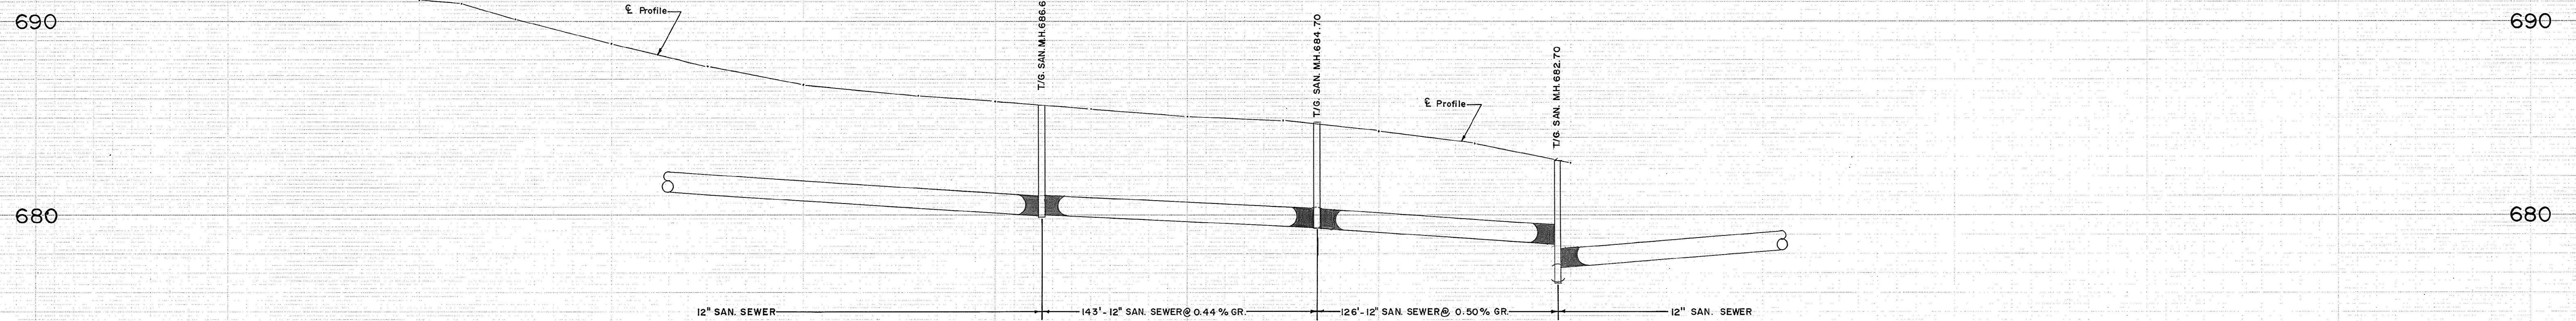

| CHAINAGE | GROUND EL | INVERT |
|----------|-----------|--------|
| 0 + 00   | 691.02    |        |
| 0 + 23   | 690.90    |        |
| 0 + 50   | 690.10    |        |
| 1 + 00   | 688.80    |        |
| 1 + 50   | 687.63    |        |
| 2 + 00   | 686.78    |        |
| 2 + 50   | 686.18    |        |
| 3 + 00   | 685.87    |        |
| 3 + 25   |           | 685.98 |
| 3 + 50   | 685.41    |        |
| 4 + 00   | 685.03    |        |
| 4 + 50   | 684.82    |        |
| 4 + 68   |           | 684.80 |
| 5 + 00   | 684.30    |        |
| 5 + 50   | 683.68    |        |
| 5 + 64   | 682.84    |        |
| 6 + 00   | 682.68    |        |
| CHAINAGE | GROUND EL | INVERT |

NOTES:

**DISCLAIMER**

The information contained on this drawing may be based upon data provided by others and may not have been verified by either as-constructed drawings or an Ontario Land Surveyor. The City of North Bay cannot accept responsibility for any errors or omissions on any information shown herein. Field verification, land surveys or excavation (with City approvals) may be required to determine actual location of any and all utilities or property lines.



|     |                 |         |         |          |
|-----|-----------------|---------|---------|----------|
| 1.  | NEW DRAWING     | 21/6/74 | G.W.R.  | APPROVED |
| 2.  | Added 36R-12868 | Jun/10  | G.W.C.  |          |
| 3.  | Added 36R-13020 | Feb/11  | G.W.C.  |          |
|     |                 |         |         |          |
|     |                 |         |         |          |
| No. | REVISION        | DATE    | INITIAL |          |

REGINA STREET  
LAURIER AVENUE TO YORK STREET

REG,D. PLAN N° 81

CITY OF NORTH BAY  
ENGINEERING DEPARTMENT

SCALE: AS SHOWN  
DATE: JUNE 1974

DRAWN BY: G.W.R.  
CK'D. BY:

FIELD BOOK No.  
234

R-6