




HARRISON ST.

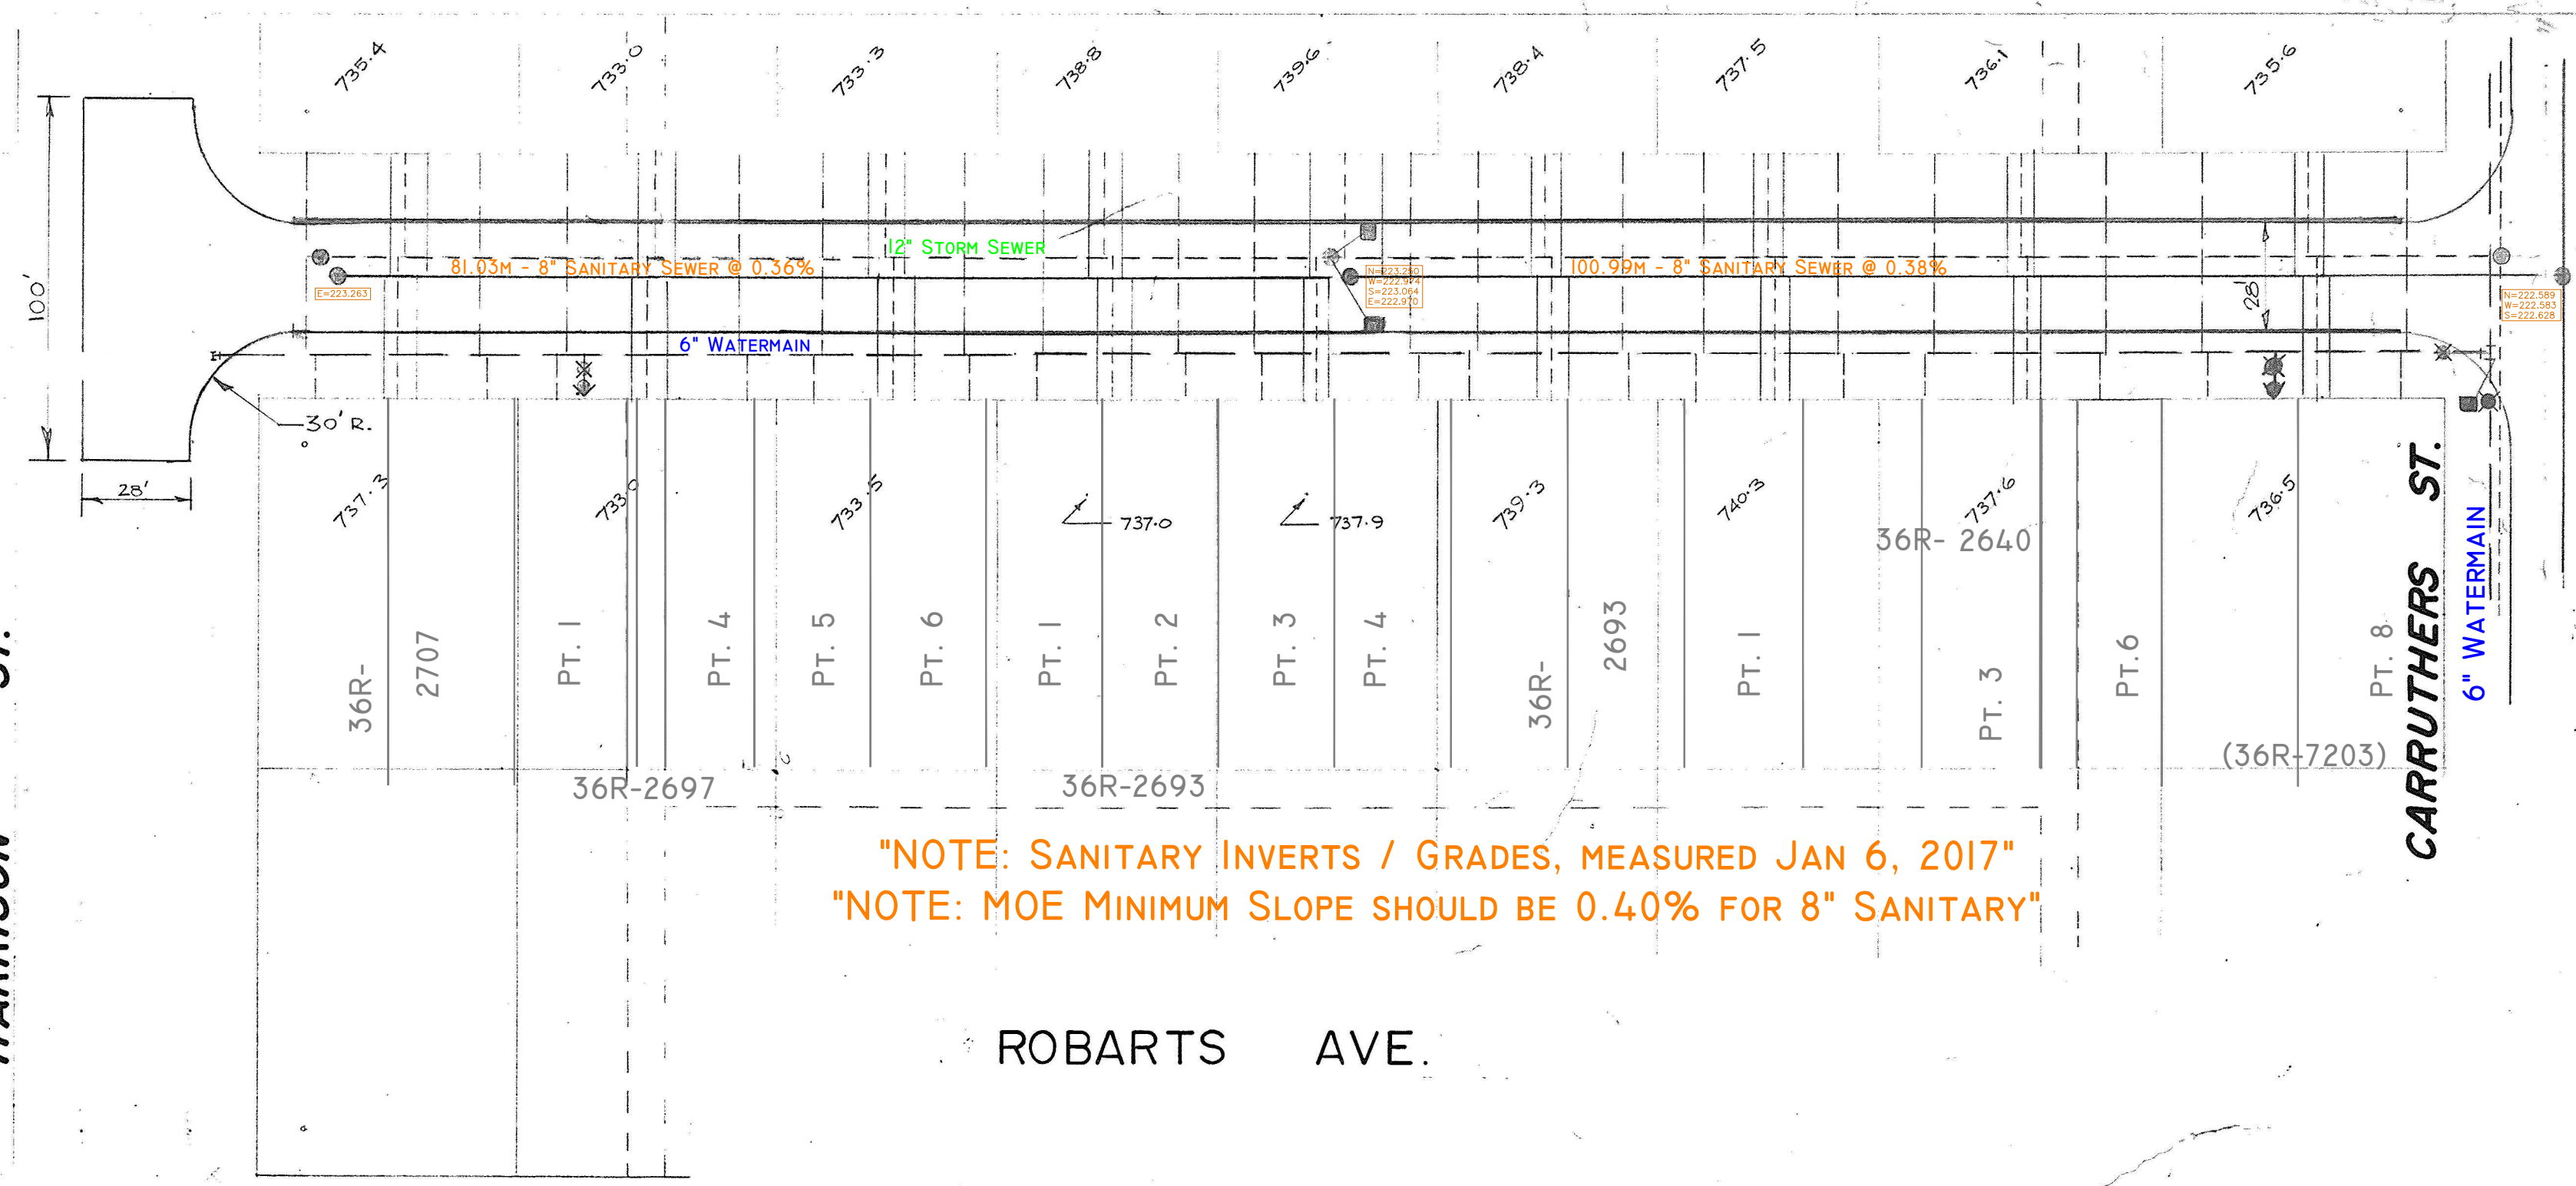


"NOTE: SANITARY INVERTS / GRADES, MEASURED JAN 6, 2017"
"NOTE: MOE MINIMUM SLOPE SHOULD BE 0.40% FOR 8" SANITARY"

DISCLAIMER

The information contained on this drawing may be based upon data provided by others and may not have been verified by either as-constructed drawings or an Ontario Land Surveyor. The City of North Bay cannot accept responsibility for any errors or omissions on any information shown herein. Field verification, land surveys or excavation (with City approvals) may be required to determine actual location of any and all utilities or property lines.

FORMERLY MCKENZIE AVE.

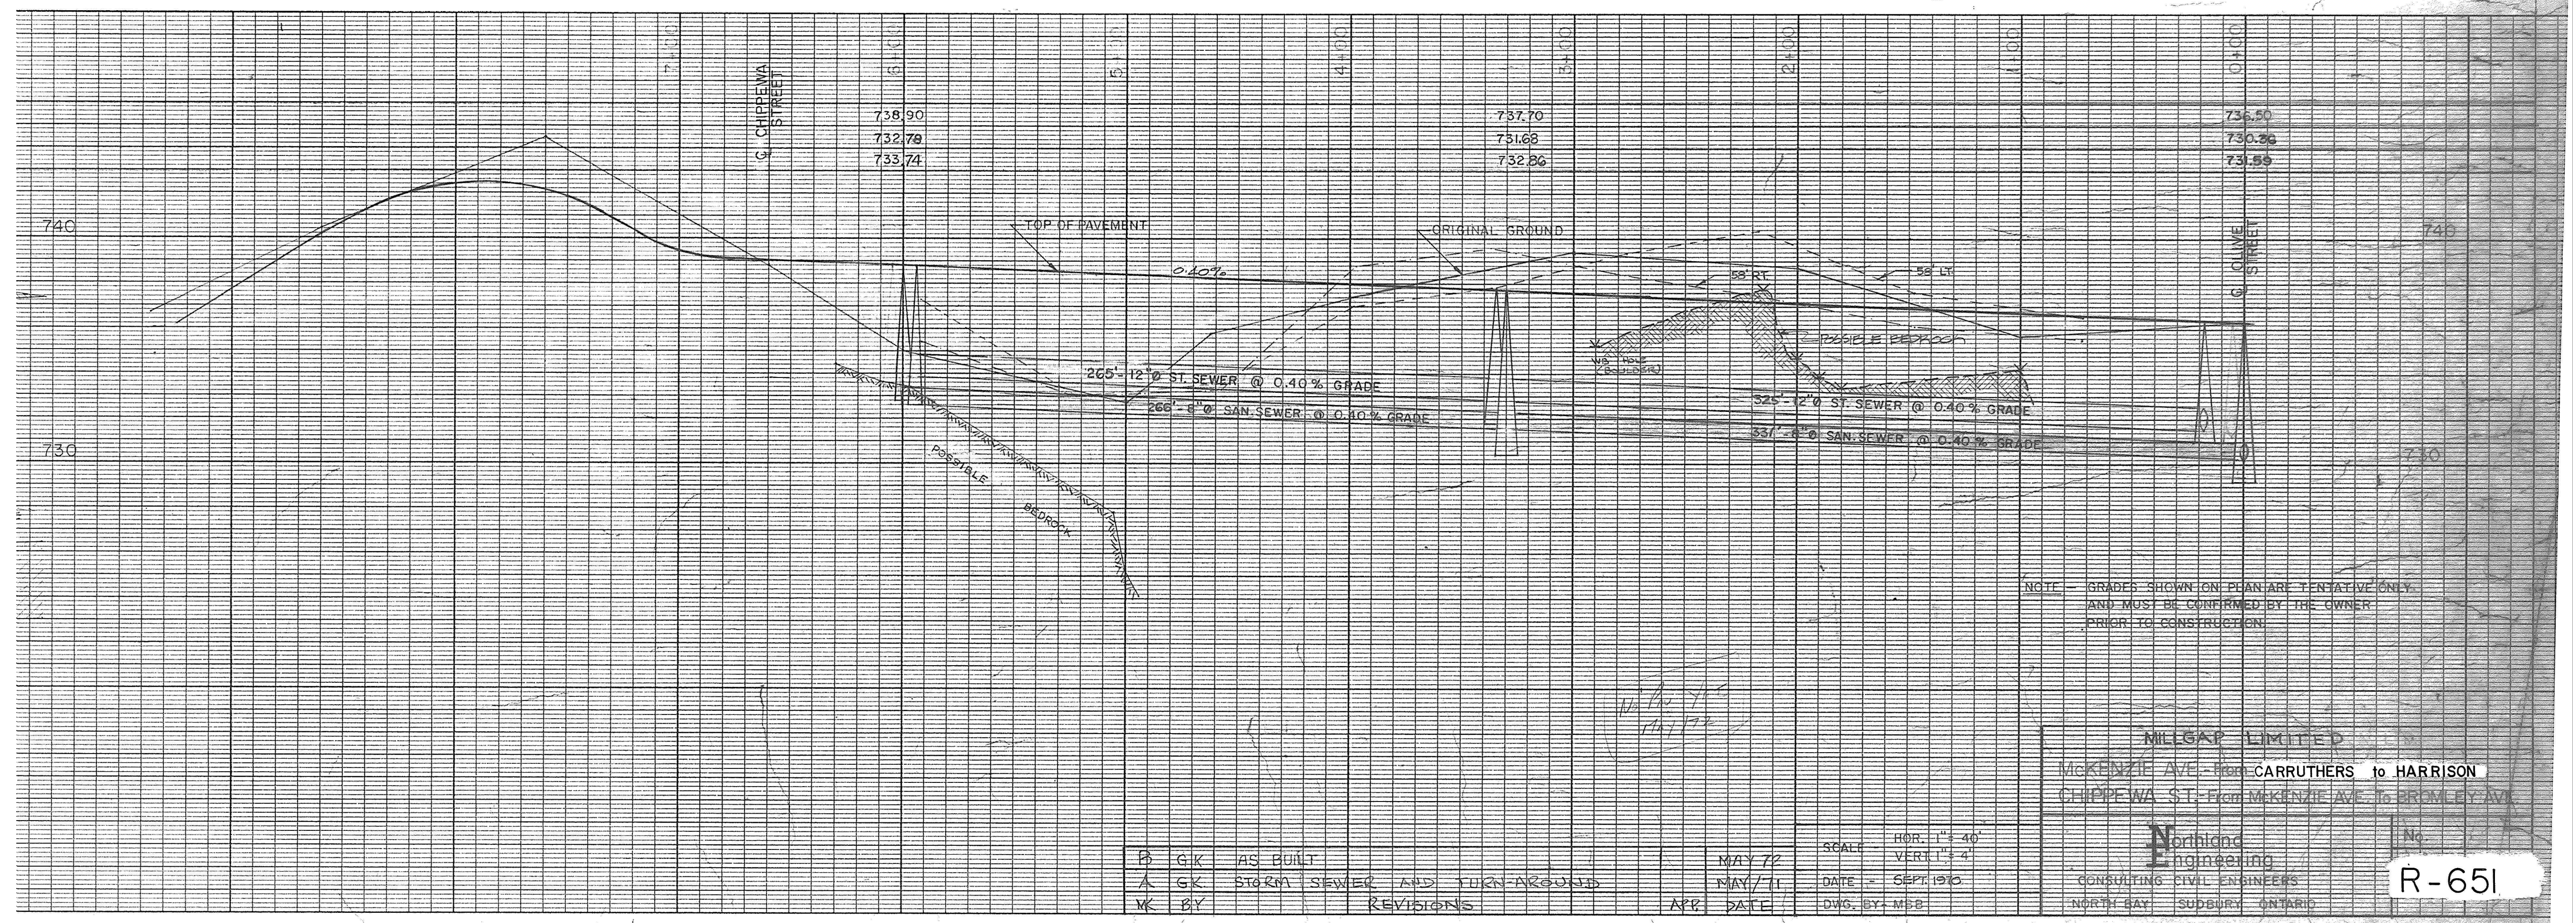

NOTE - GRADES SHOWN ON PLAN ARE TENTATIVE ONLY, AND MUST BE CONFIRMED BY THE OWNER PRIOR TO CONSTRUCTION.

B	GK	AS BUILT	MAY 72
A	GK	STORM SEWER AND TURN-AROUND	MAY 71
M	BY	REVISIONS	APR DATE

SCALE: HOR. 1" = 40'
VERT. 1" = 4'
DATE: SEP. 1970
DWG. BY: MBB

MILGAP LIMITED
MCKENZIE AVE. - from CARRUTHERS to HARRISON
CHIPPewa ST. - from MCKENZIE AVE. to BROMLEY AVE.
Northland Engineering
CONSULTING CIVIL ENGINEERS
NORTH BAY, SUDBURY, ONTARIO

R-651