
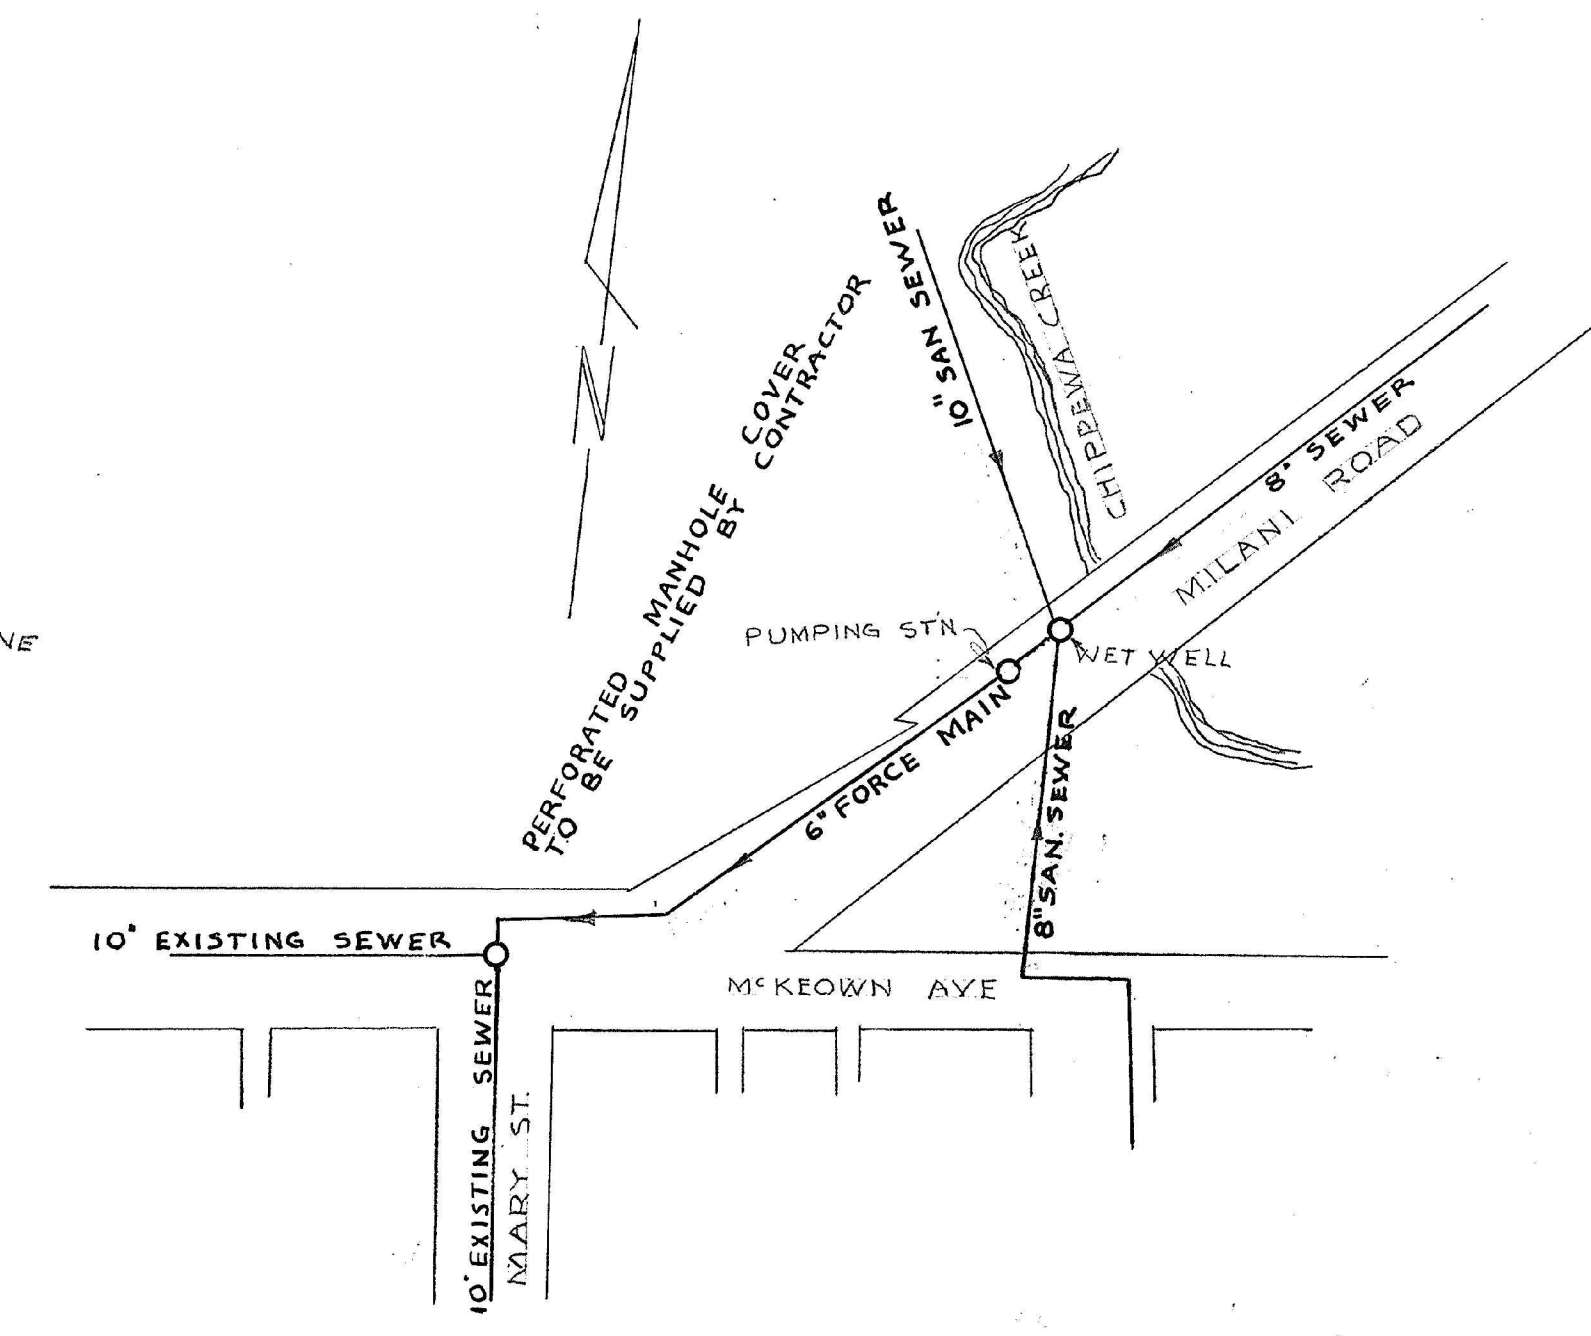
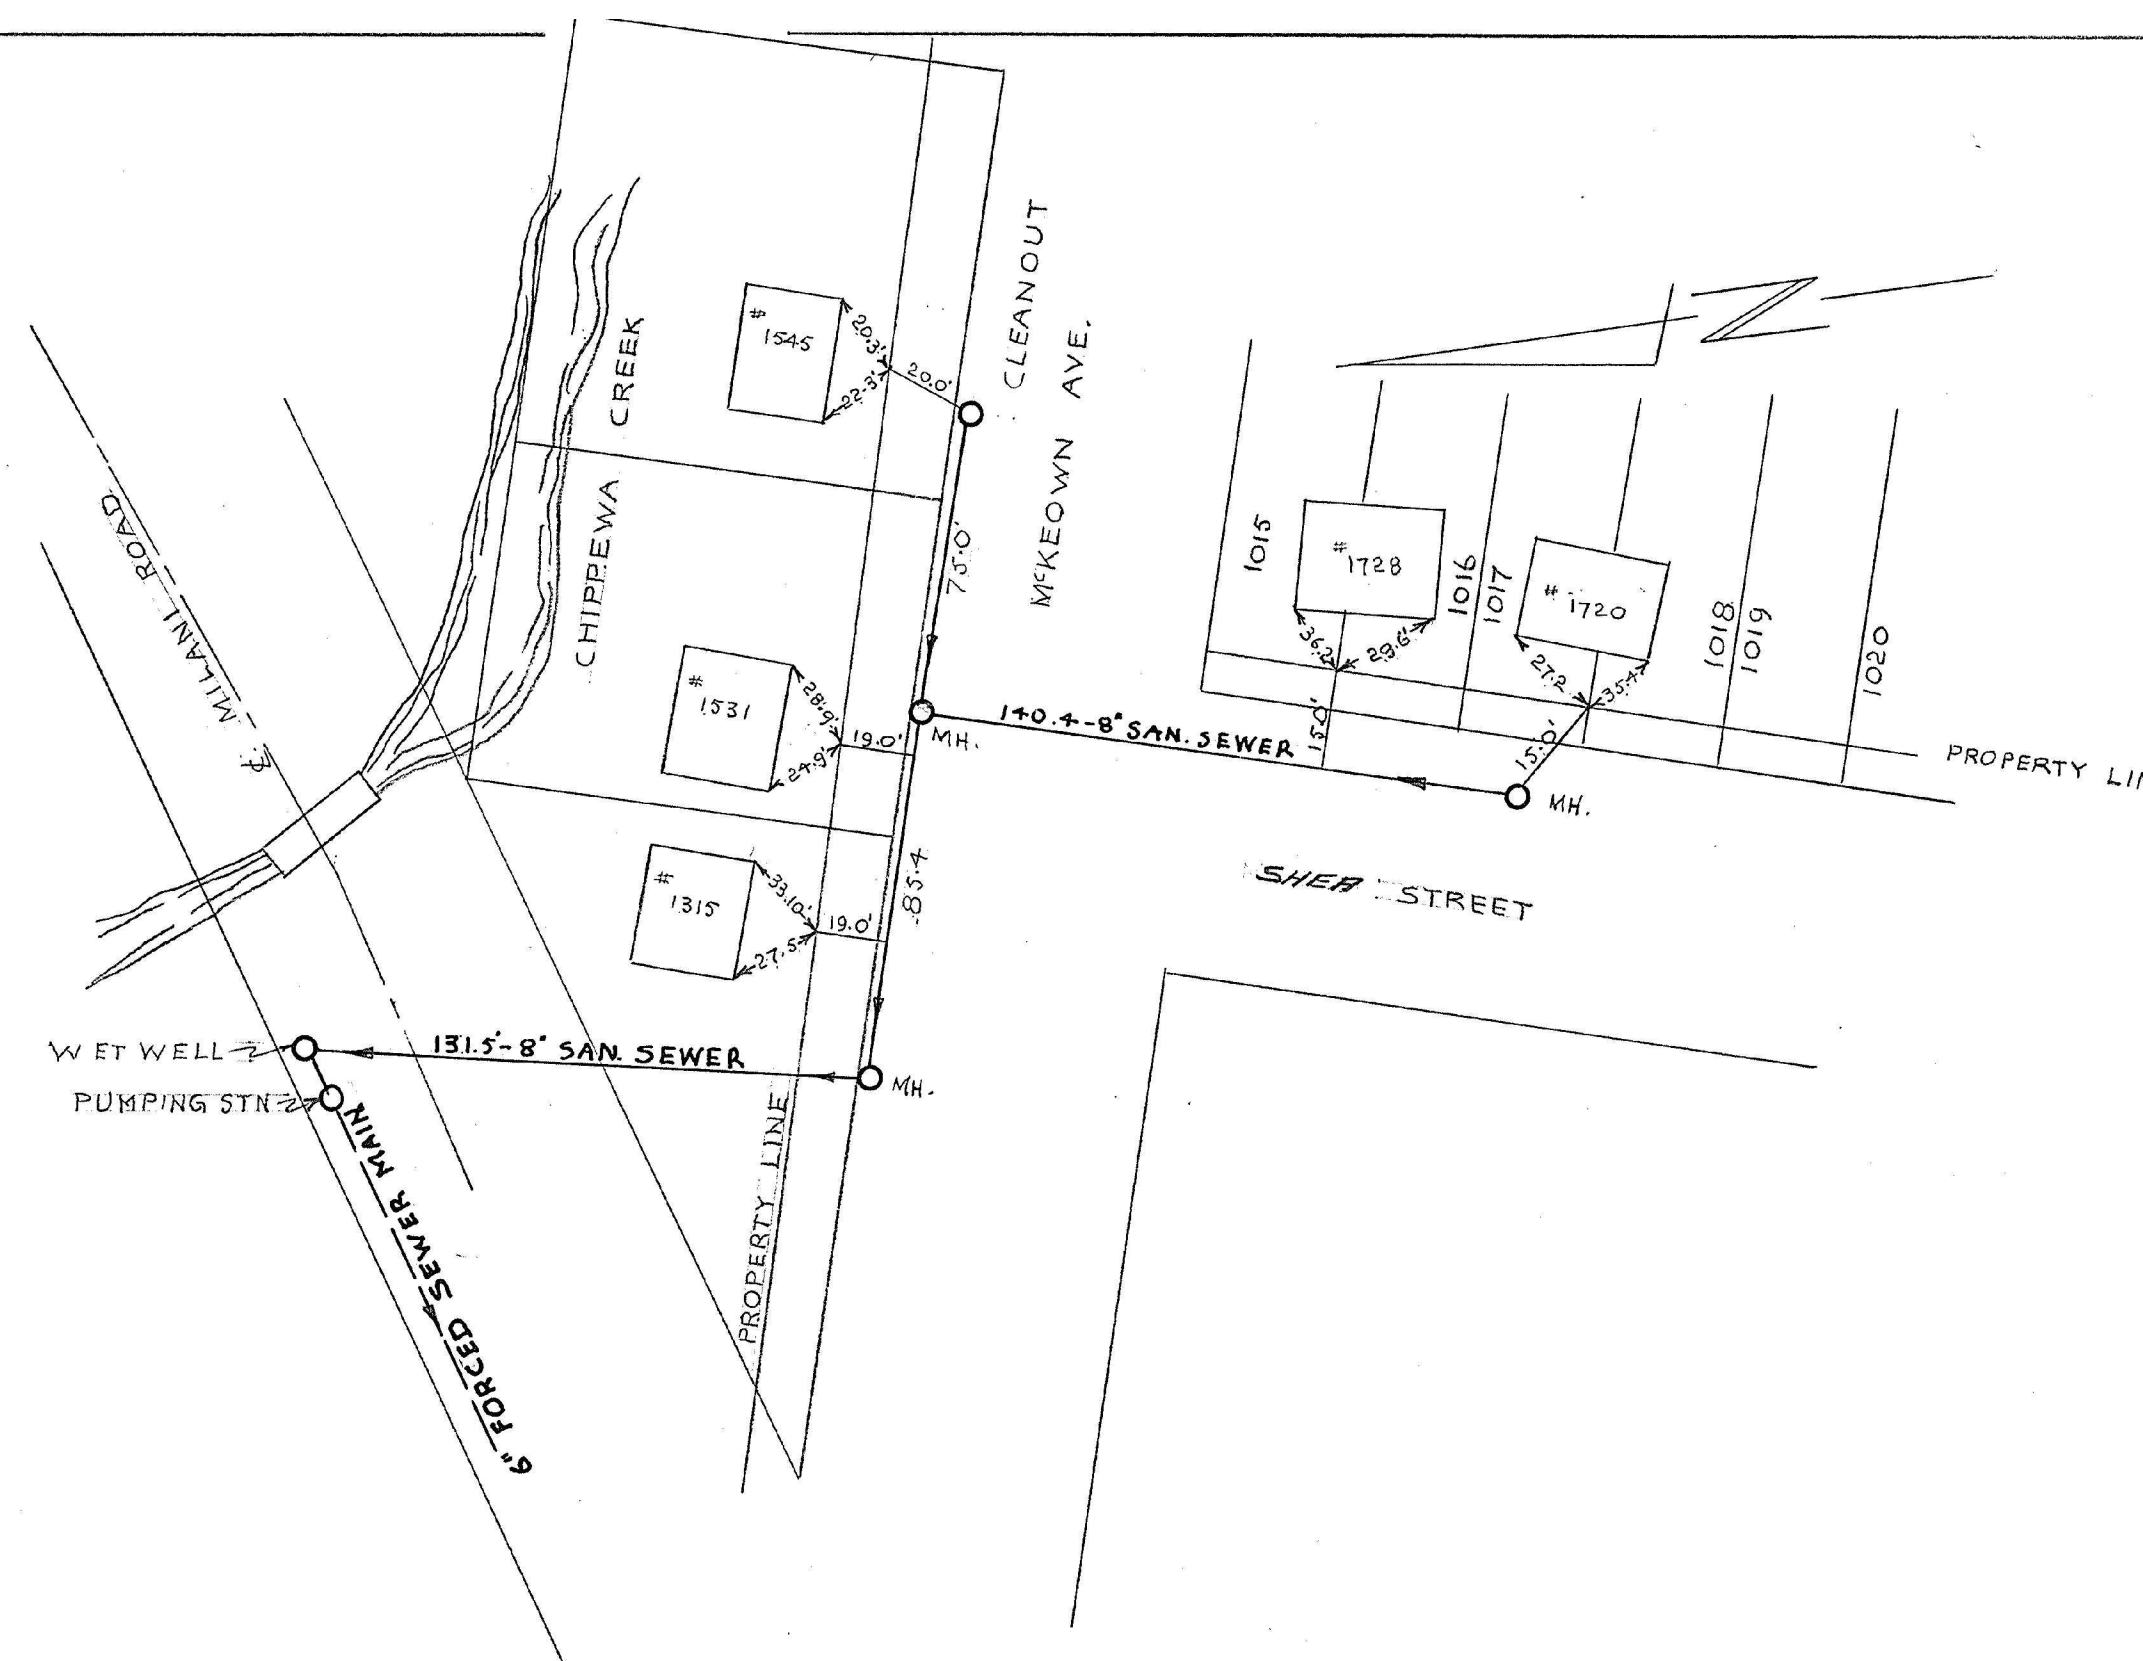



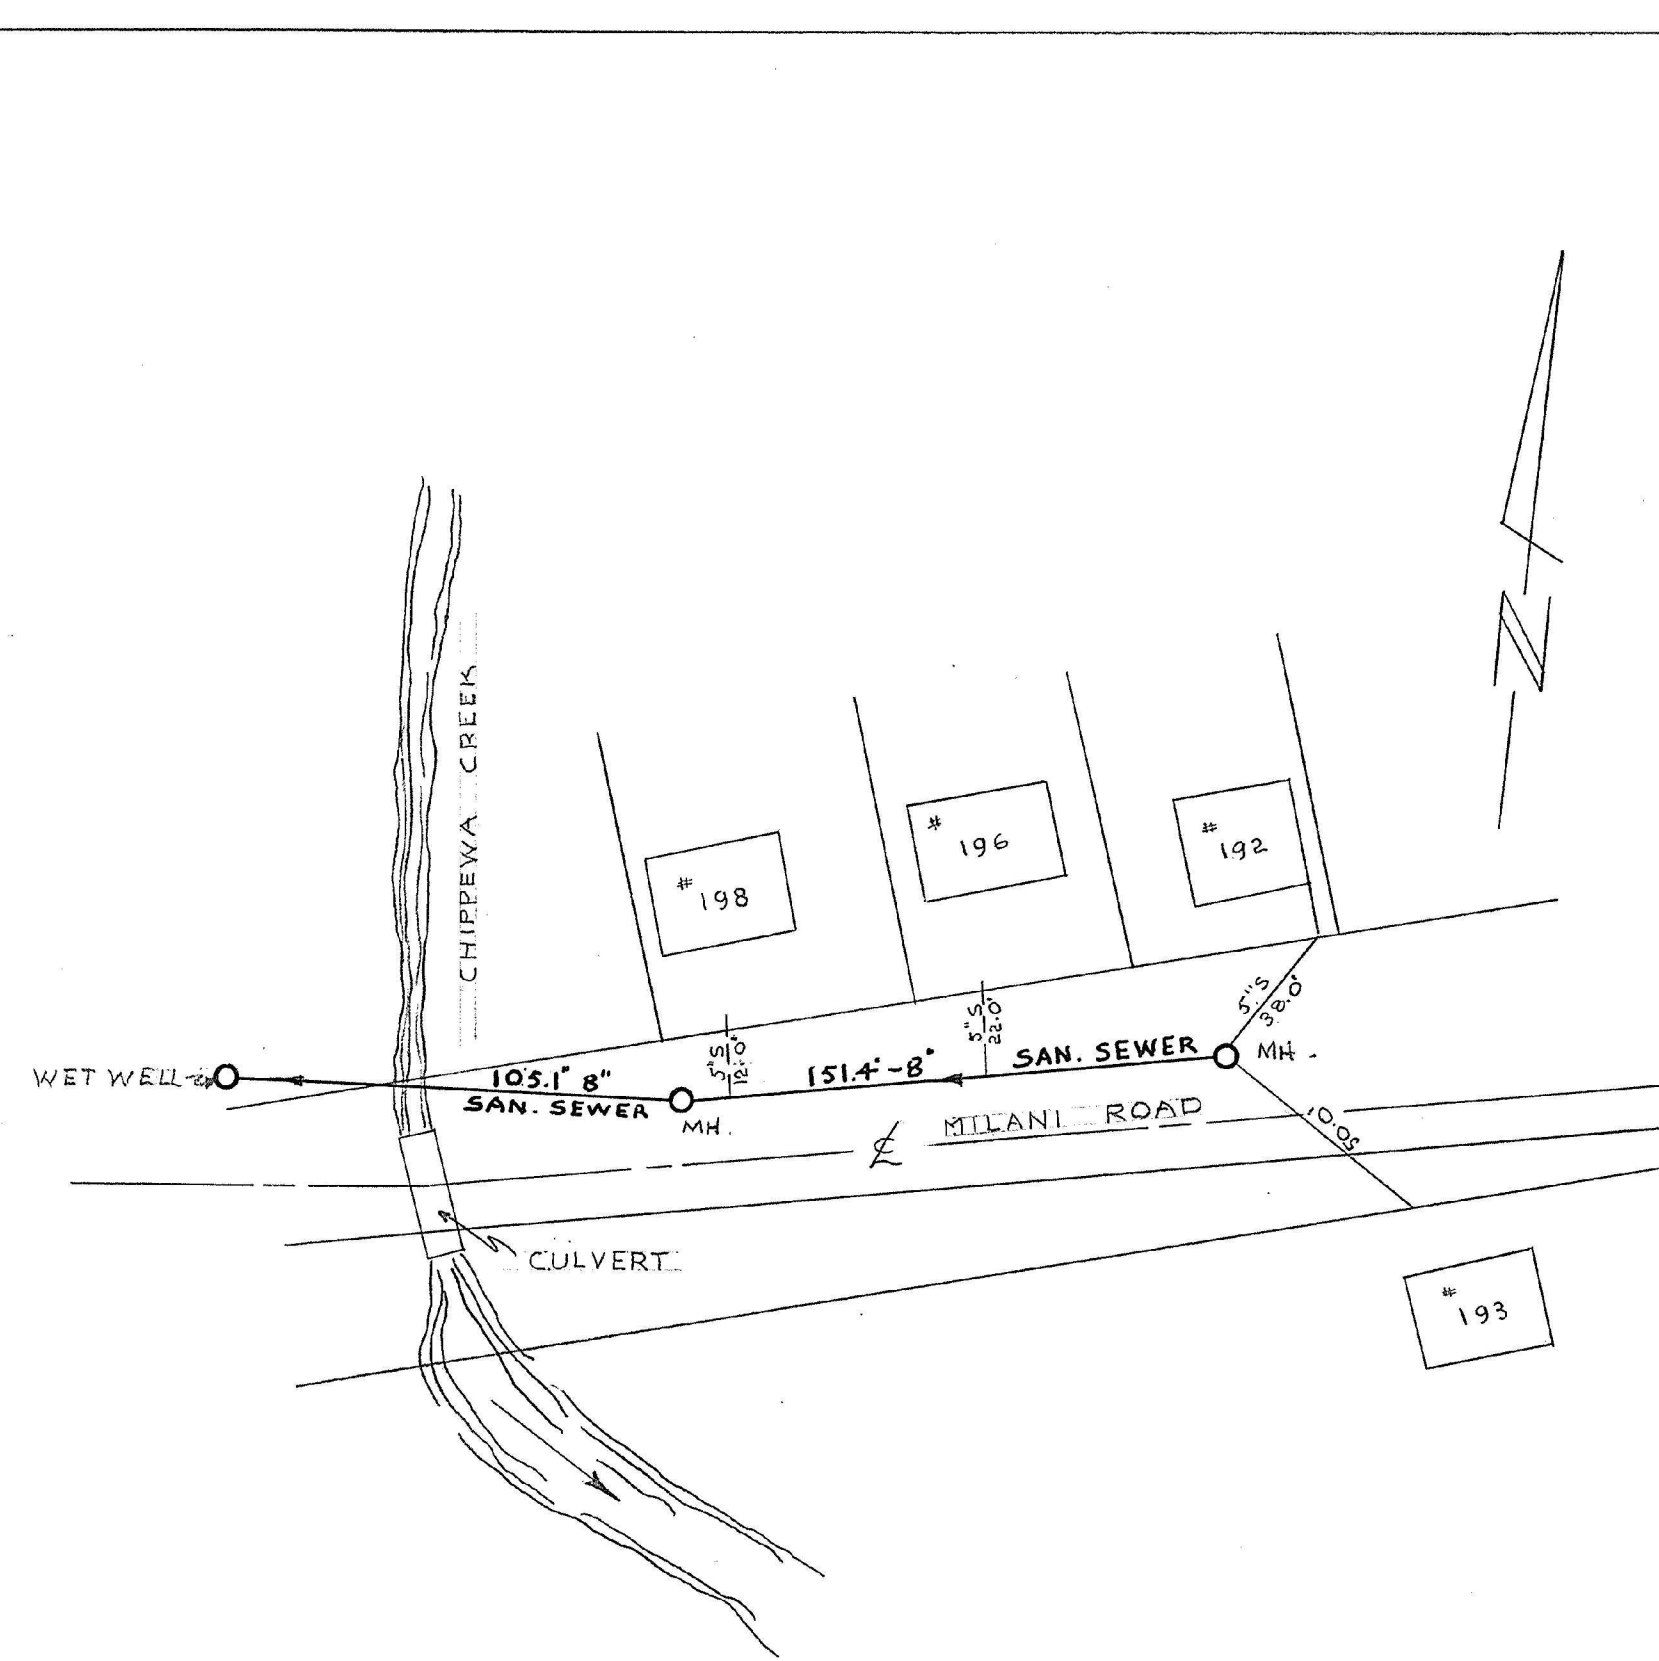


FLOOR ELEV.
@ 196 MILANI RD.
FLOOR ELEV.
@ 192 MILANI RD.

PROPOSED 6" FORCE MAIN

MILANI ROAD

MCKEOWN AVE / SHEAR STREET

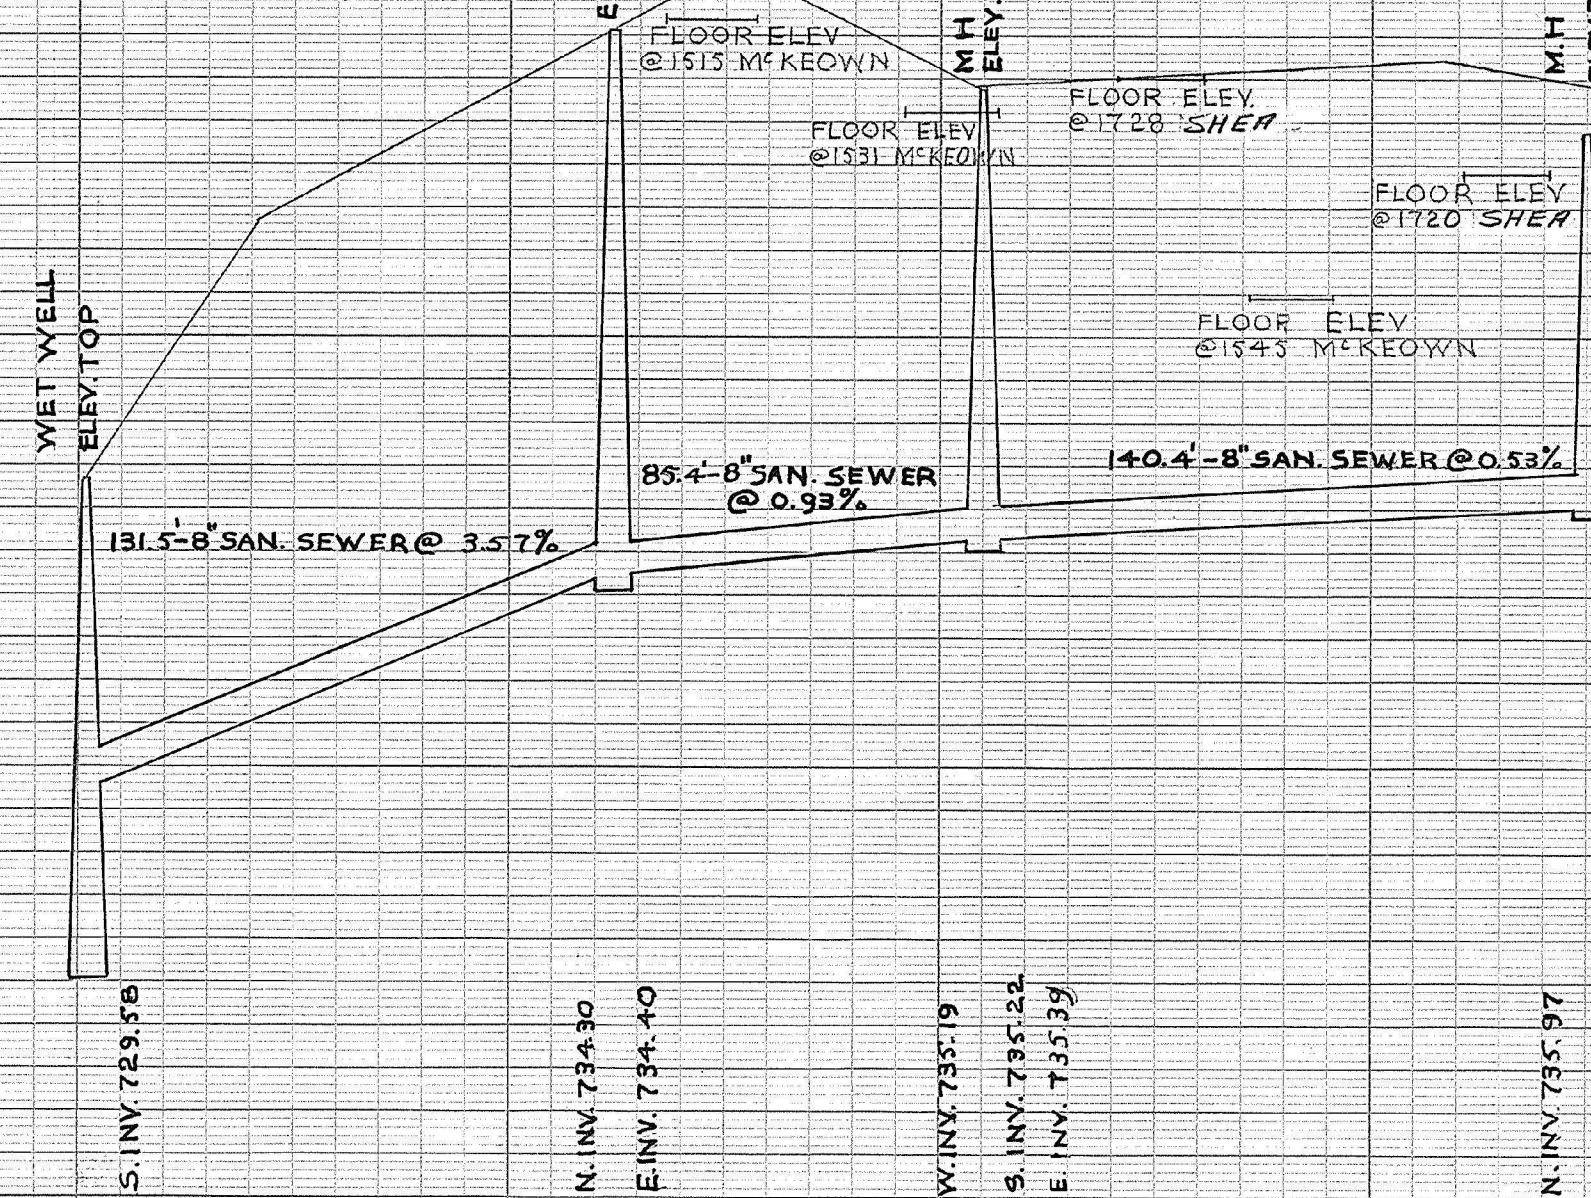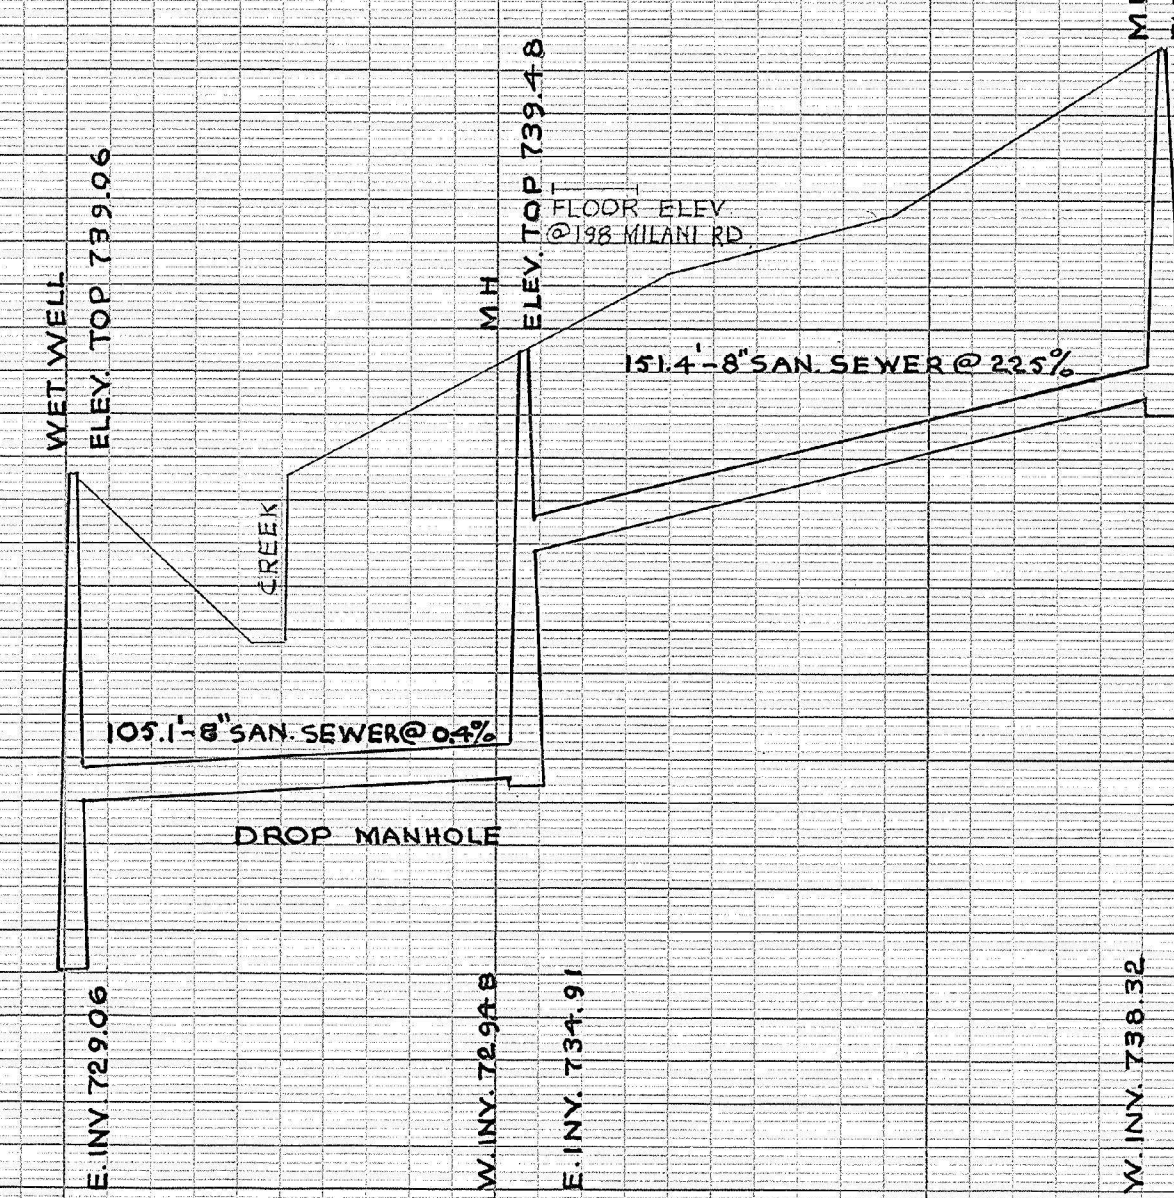

DISCLAIMER
The information contained on this drawing may be based upon data provided by others and may not have been verified by either as-constructed drawings or an Ontario Land Surveyor. The City of North Bay cannot accept responsibility for any errors or omissions on any information shown herein. Field verification, land surveys or excavation (with City approvals) may be required to determine actual location of any and all utilities or property lines.

SHEA STREET
MCKEOWN AVE / MILANI ROAD INTERSECTION
TOWNSHIP OF WIDDIFIELD
SANITARY SEWER EXTENSIONS
MCKEOWN AVE
MILANI ROAD AND WHEED STREET
NORTHLAND ENGINEERING
CONSULTING CIVIL ENGINEERS
NORTH BAY - ONTARIO

APPROVALS		SCALE - 1"=40'		DWG. No S-52
DRAWN BY JKT	DATE FEB 19/20	CHECKED BY	DATE	
REVISION		BY		REV
JAN 6/21		AS CONSTRUCTED		

S-52