
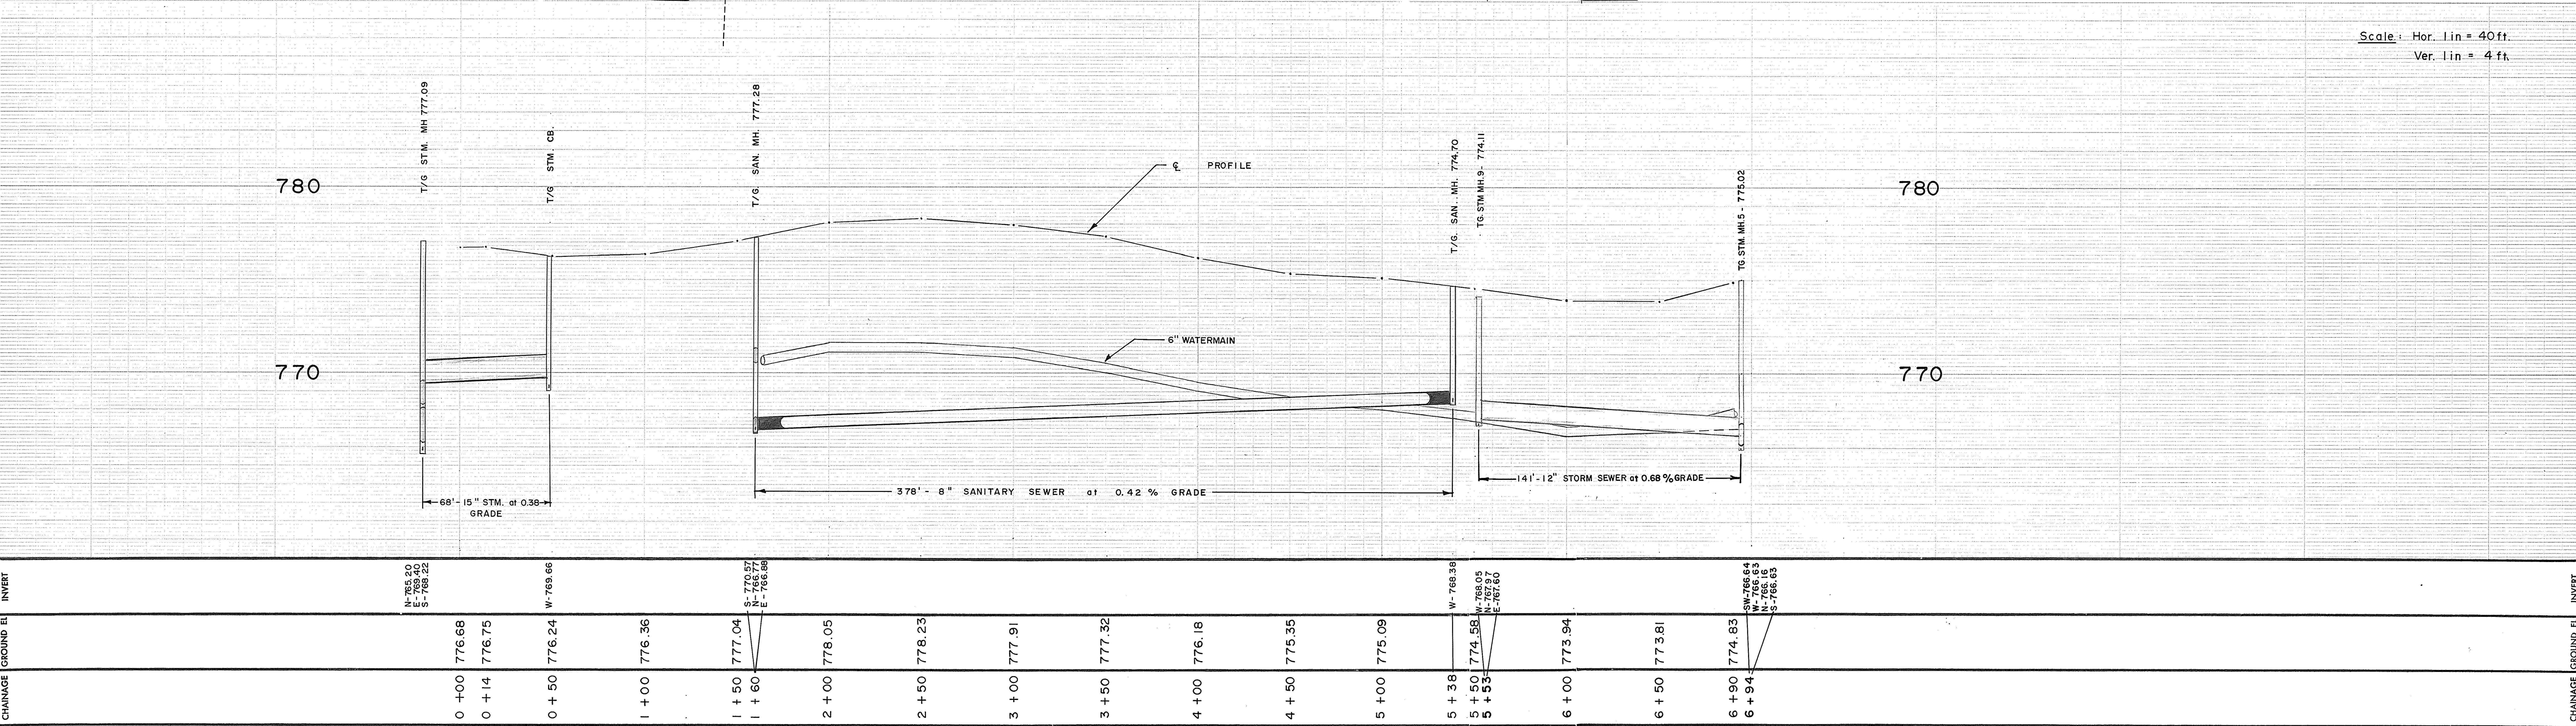


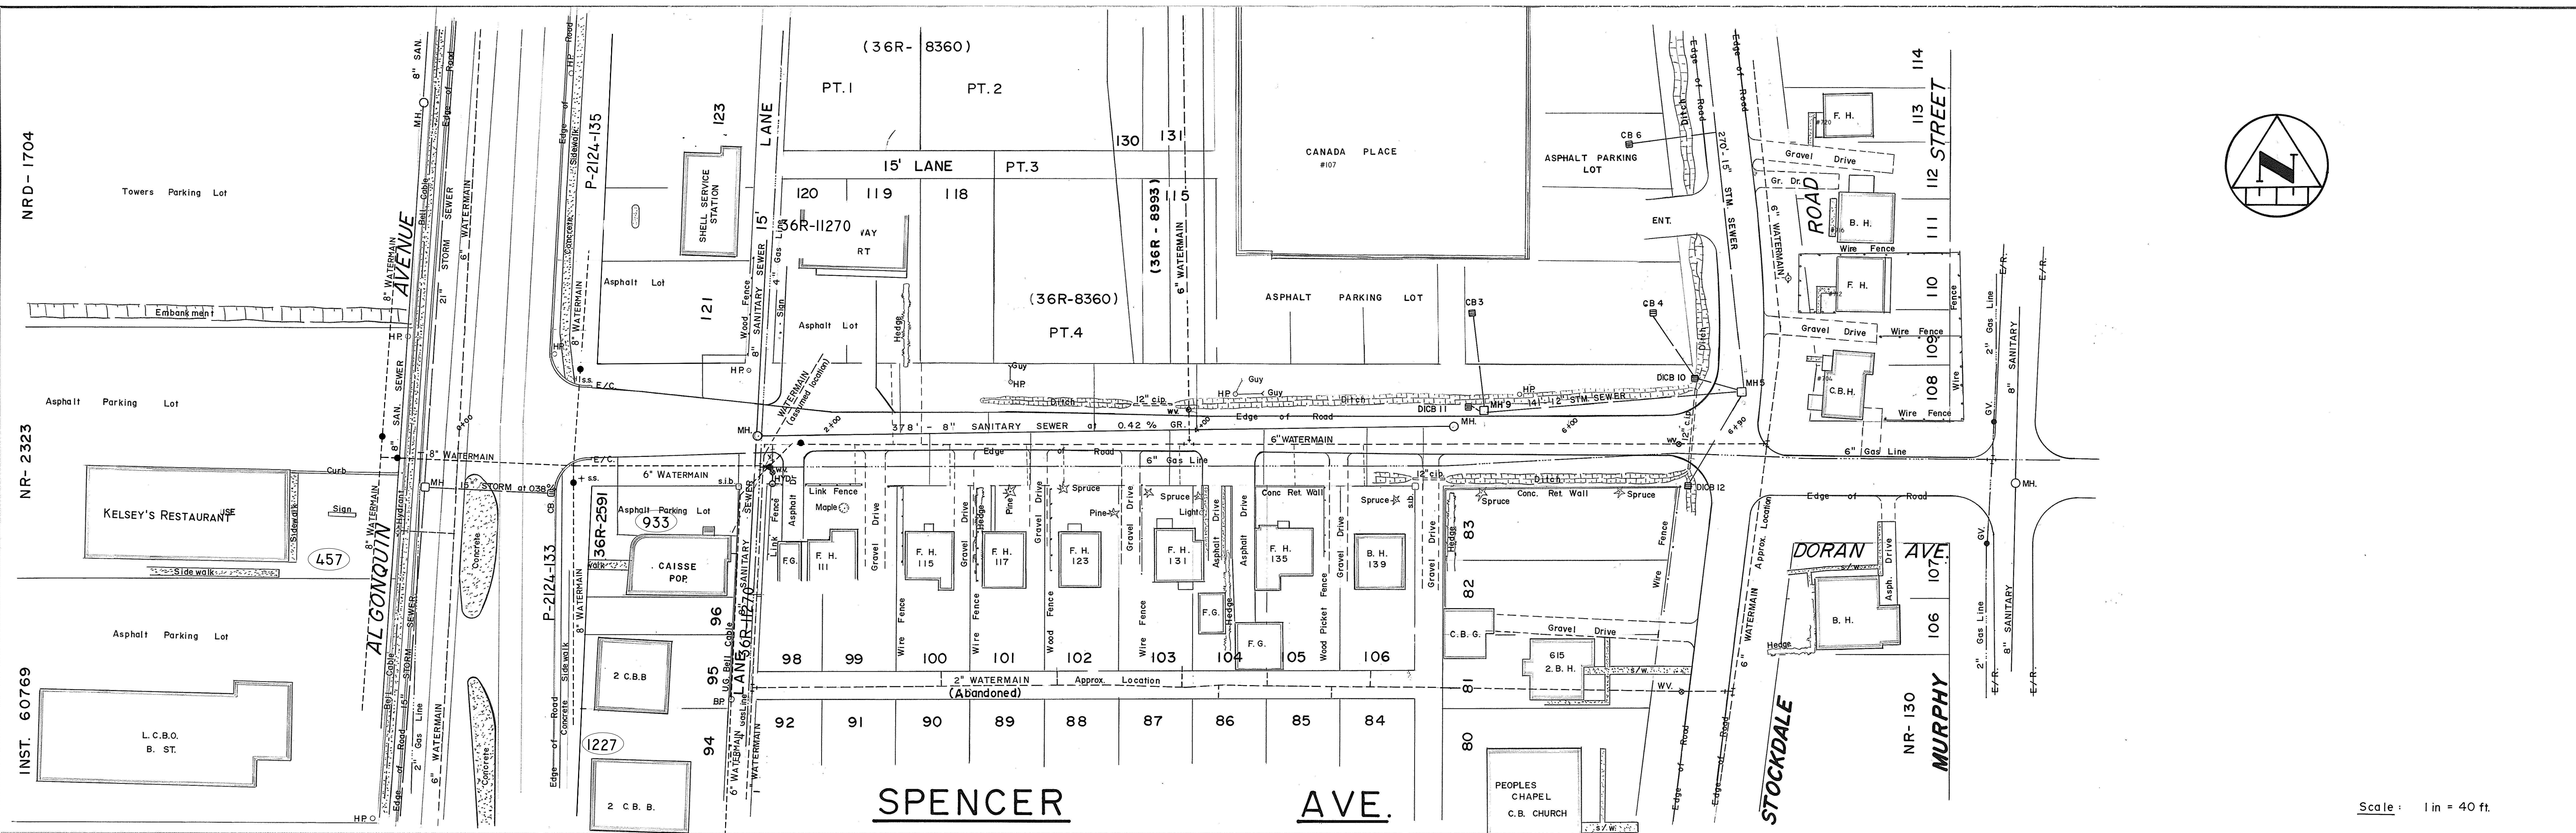

NOTES:

DISCLAIMER

The information contained on this drawing may be based upon data provided by others and may not have been verified by either as-constructed drawings or an Ontario Land Surveyor. The City of North Bay cannot accept responsibility for any errors or omissions on any information shown herein. Field verification, land surveys or excavation (with City approvals) may be required to determine actual location of any and all utilities or property lines.

1.	NEW DRAWING	APR. 79	J.d.m.
2.	AS CONST'D 6" WATERMAIN FROM INSPECTOR'S DIARY	MAR. 82	T.M.
3.	NEW STORM SEWER-STOCKDALE-SPENCER	JAN. 92	RT
4.	REGISTERED PLANS WM AND HOUSE #'S ADDED.	FEB. 09	R.J.O.
No.	REVISION	DATE	INITIAL

APPROVED

SPENCER AVENUE	
ALGONQUIN AVE to STOCKDALE RD.	
REG'D PLAN N ^o : M-176	
36R-2591	

CITY OF NORTH BAY

ENGINEERING DEPARTMENT

SCALE: AS SHOWN	DATE: APRIL 1979
DRAWN BY: J.M.	FIELD BOOK No. 252
CHKD. BY:	DRAWING No. S-626
	REV.