

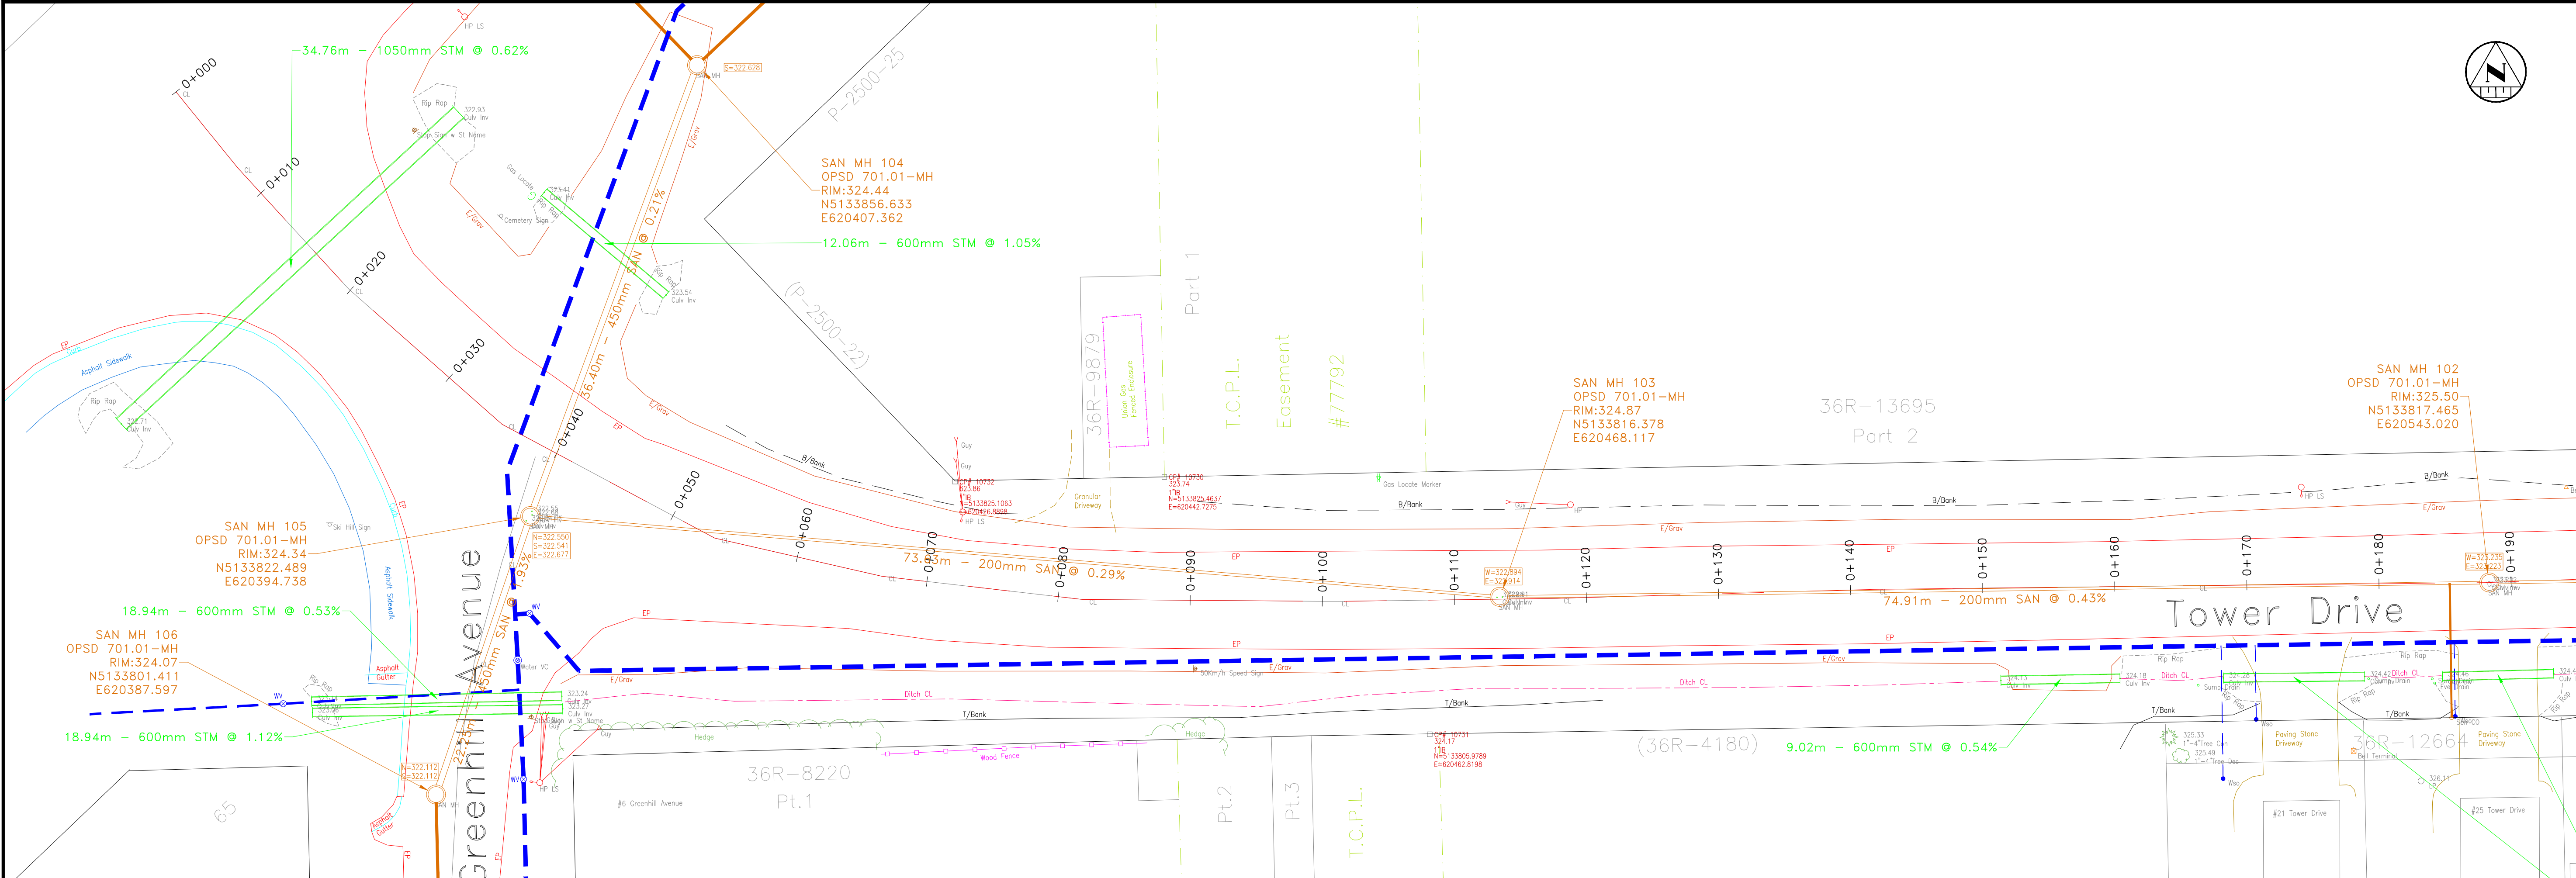


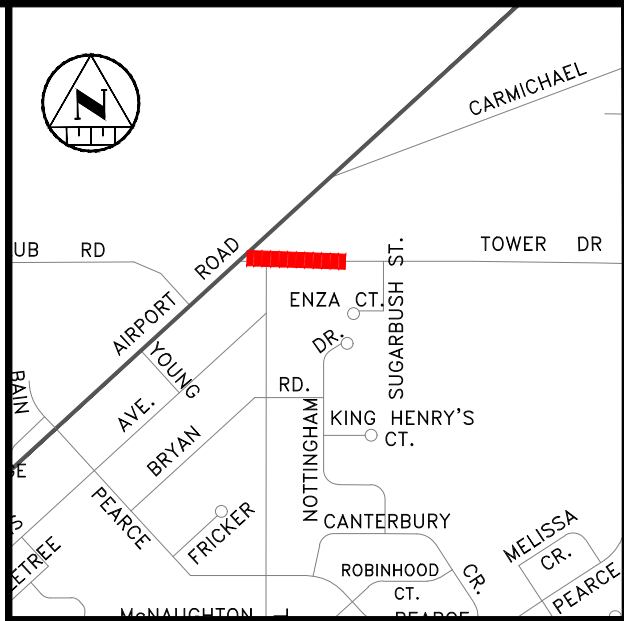

Tower Drive CL PROFILE

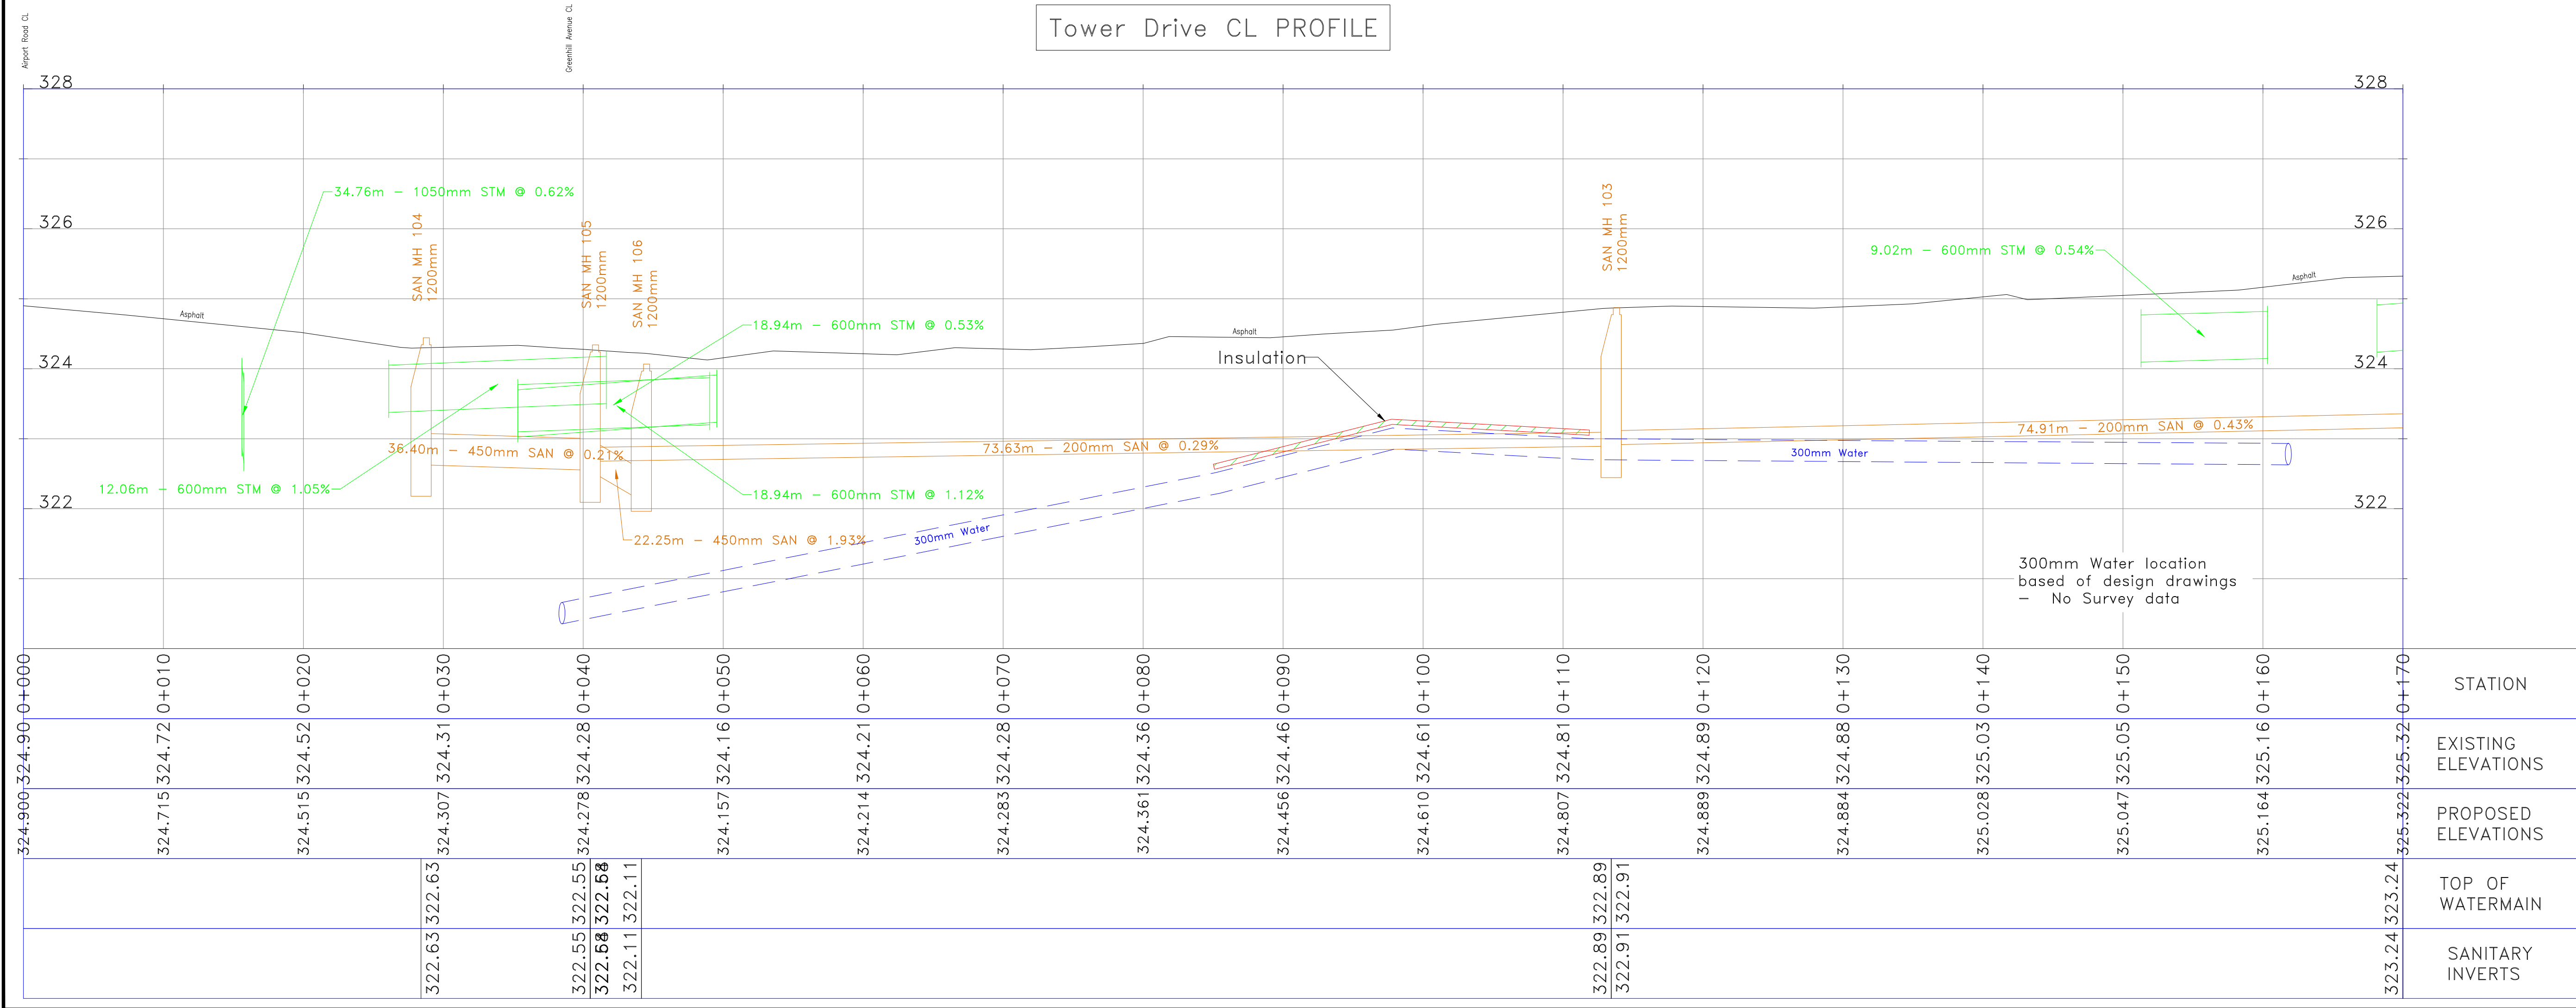

KEY PLAN  
LEGEND

REVISIONS

| no. | date       | by | description |
|-----|------------|----|-------------|
| 1.  | 8 Jun 2015 |    | As-Built    |
|     |            |    |             |
|     |            |    |             |
|     |            |    |             |
|     |            |    |             |

**Disclaimer**  
The information contained on this drawing may be based upon data provided by others and may not have been verified by either as-constructed drawings or an Ontario Land Surveyor. The City of North Bay cannot accept responsibility for any errors or omissions on any information shown herein. Field verification, land surveys or excavation (with city approval) may be required to determine actual location of any and all utilities or property lines.



**From Airport Rd.  
To #25 Tower Dr.**

**AS-BUILT**

**TOWER\_DRIVE**

|                            |                         |
|----------------------------|-------------------------|
| STA. 0+000 to 0+170        |                         |
| designer                   | drawn by:<br>G.W.C.     |
| checked by:                | approved by:            |
| scale<br>H:1:250<br>V:1:50 | drawing number<br>T-351 |
| date<br>8/06/2015          |                         |